

# Brown Branch Stream Restoration

(Anita Alta 4-H Camp)

## 2004 Annual Monitoring Report



Delivered to: NCDENR/Ecosystem Enhancement Program  
1619 Mail Service Center  
Raleigh, NC 27699-1619

Prepared by: Biological & Agricultural Engineering  
Water Resources Research Institute  
North Carolina State University  
Campus Box 7625  
Raleigh, NC 27695

February, 2005



**NC STATE UNIVERSITY**

## **2004 Brown Branch Monitoring Abstract**

Brown Branch was restored through the North Carolina Wetlands Restoration Program (NCWRP). The objectives of the project are to:

- 1.) Establish an stable dimension, pattern and profile on 5100 feet of Brown Branch
- 2.) Improve habitat within Brown Branch
- 3.) Reduce bank erosion along Brown Branch
- 4.) Improve water quality in Brown Branch
- 5.) Establish an riparian buffer along Brown Branch
- 6.) Incorporate this project into a watershed wide management plan

This is the 2<sup>nd</sup> year of the 5-year monitoring plan for Brown Branch.

**Table 1A. Background Information**

|                                   |  |
|-----------------------------------|--|
| <b>Project Name</b>               | Brown Branch   |
| <b>Designer's Name</b>            | Biohabitats Inc.<br>15 West Aylesbury Road<br>Timonium, MD 21093   |
| <b>Contractor's Name</b>          | Shamrock Environmental   |
| <b>Project County</b>             | Caldwell, North Carolina   |
| <b>Directions to Project Site</b> | From US-321 ALT/N MAIN ST in Lenoir NC, turn LEFT 1.4 miles north of Lenoir onto NC-90/VALWAY RD NW. Continue on NC-90/VALWAY RD NW 1.3 miles and turn left onto NC-90/COLLETTSVILLE RD. Continue on NC-90/COLLETTSVILLE RD 4.0 miles and turn right onto MULBERRY CREEK RD. Continue on MULBERRY CREEK RD 3.5 miles and turn right into Anita Alta 4-H Camp and the location of Brown Branch restoration. |
| <b>Drainage Area</b>              | 1.1 sq. mi.  |
| <b>USGS Hydro Unit</b>            | 03050101   |
| <b>NCDWQ Subbasin</b>             | 11-38-32-13 Upper Catawba River Basin  |
| <b>Project Length</b>             | 5,100 Linear feet  |
| <b>Restoration Approach</b>       | 5,100 ft of priority 1 Natural Channel Design (dimension, pattern, and profile)  |
| <b>Date of Completion</b>         | September, 2003  |
| <b>Monitoring Dates</b>           | October, 2003; June 2004   |

### **Results and Discussion**

Overall, while the majority of the stream is functioning well and holding grade, the stream has areas of concern and areas of immediate need. Table 2 shows a summary of monitoring measurement results. The stream classifies as a C4 but has areas of severe bank erosion with an entrenchment ratio between 2 and 3 for much of the reach. Channel dimension and pattern are

similar to as-built conditions with the exceptions of some limited areas of bank erosion. The channel profile shows that the stream is down cutting on the upstream reach and aggrading with fines on the downstream reach. With the exception of scour pools below cross vanes most of the pools have filled in this sediment resulting in longer runs and smaller and shallower pools. The channel planform is very similar to the as built condition with the exception of bank erosion. The general trend of the bank erosion on this reach occurs downstream on the outside of a meander bend and behind root wads. In two location the bank erosion migrated to the head of a riffle downstream and resulted in a over wide riffle that was not able to transport it's sediment creating a mid channel bar. The existing mid channel bars are producing more bank erosion by concentrating the flow paths near the toe of the bank slopes. The root wads the seem to be causing bank erosion are all located at a high elevation relative to the stream bed, in some areas the root wads were installed too high and in other areas the streambed has down-cut surrounding the root wad. Vegetation is not succeeding to levels required for mitigation credit. Placed structures are holding grade and functioning well, with the exception of some localized erosion on cross vane arms.

Table 2. Summary of Channel Conditions

| DIMENSION                     | Brown Branch Cross-section #1 Riffle |      |      | Brown Branch Cross-section #2 Pool |      |      | Brown Branch Cross-section #3 Riffle |      |      | Brown Branch Cross-section #4 Pool |      |      | Brown Branch Cross-section #5 Riffle |       |      | Brown Branch Cross-section #6 Pool |      |       |      |
|-------------------------------|--------------------------------------|------|------|------------------------------------|------|------|--------------------------------------|------|------|------------------------------------|------|------|--------------------------------------|-------|------|------------------------------------|------|-------|------|
|                               | AS-BUILT                             | 2003 | 2004 | AS-BUILT                           | 2003 | 2004 | AS-BUILT                             | 2003 | 2004 | AS-BUILT                           | 2003 | 2004 | AS-BUILT                             | 2003  | 2004 | AS-BUILT                           | 2003 | 2004  |      |
| Monitoring Year               |                                      |      |      |                                    |      |      |                                      |      |      |                                    |      |      |                                      |       |      |                                    |      |       |      |
| Bankfull Cross-sectional Area | 11.4                                 | 22.7 | 19.8 |                                    | 13.3 | 12.2 | 9.5                                  | 15.4 | 16.6 | 15.1                               | 21.9 | 22.5 | 23.2                                 | 11.67 | 14.8 | 15.1                               | 29.9 | 24.92 | 21.7 |
| Bankfull Width                | 10.0                                 | 14.1 | 15.2 |                                    | 21.9 | 22.5 | 23.1                                 | 16.8 | 14.9 | 14.9                               | 20.0 | 22.9 | 24.7                                 | 16.00 | 14.6 | 15.3                               | 18.0 | 21.60 | 21.3 |
| Bankfull Mean Depth           | 1.1                                  | 1.6  | 1.3  |                                    | 0.6  | 0.5  | 0.4                                  | 0.9  | 1.1  | 1.0                                | 1.1  | 1.0  | 0.9                                  | 0.73  | 1.0  | 1.0                                | 1.7  | 1.15  | 1.0  |
| Bankfull Max Depth            | 1.8                                  | 2.3  | 2.1  |                                    | 1.8  | 1.5  | 1.6                                  | 1.7  | 1.7  | 1.8                                | 1.9  | 2.1  | 1.9                                  | 0.94  | 1.5  | 1.4                                | 2.5  | 1.83  | 1.8  |

| PATTERN                       | Brown Branch Design |         |        | Brown Branch As-built 2002 |         |        | Brown Branch 2004 |         |        |
|-------------------------------|---------------------|---------|--------|----------------------------|---------|--------|-------------------|---------|--------|
|                               | Minimum             | Maximum | Median | Minimum                    | Maximum | Median | Minimum           | Maximum | Median |
| Meander Wave Length           | Not Reported        |         |        | Not Reported               |         |        | 83                | 104     | 100    |
| Radius of Curvature Beltwidth | Not Reported        |         |        | Not Reported               |         |        | 28                | 87      | 66     |
|                               | Not Reported        |         |        | Not Reported               |         |        | 24                | 56      | 33     |

| PROFILE              | Brown Branch Design |         |        | Brown Branch As-built 2002 |         |        | Brown Branch 2004 |         |        |
|----------------------|---------------------|---------|--------|----------------------------|---------|--------|-------------------|---------|--------|
|                      | Minimum             | Maximum | Median | Minimum                    | Maximum | Median | Minimum           | Maximum | Median |
| Riffle Length        | Not Reported        |         |        | Not Reported               |         |        | 22                | 71      | 31     |
| Riffle Slope         | Not Reported        |         |        | Not Reported               |         |        | 0.62%             | 4.53%   | 1.49%  |
| Pool Length          | Not Reported        |         |        | Not Reported               |         |        | 9                 | 62      | 18     |
| Pool to Pool Spacing | Not Reported        |         |        | Not Reported               |         |        | 35                | 65      | 61     |
| Valley (TOB) Slope   | Not Reported        |         |        | Not Reported               |         |        | 1.1%              |         |        |
| Bankfull Slope       | Not Reported        |         |        | Not Reported               |         |        | 0.8%              | 1.4%    | 0.9%   |

| SUBSTRATE | Brown Branch Cross-section #1 Riffle |       |      | Brown Branch Cross-section #2 Pool |      |       | Brown Branch Cross-section #3 Riffle |       |      | Brown Branch Cross-section #4 Pool |      |       | Brown Branch Cross-section #5 Riffle |       |      | Brown Branch Cross-section #6 Pool |      |      |
|-----------|--------------------------------------|-------|------|------------------------------------|------|-------|--------------------------------------|-------|------|------------------------------------|------|-------|--------------------------------------|-------|------|------------------------------------|------|------|
|           | 2002                                 | 2004  | 2002 | 2004                               | 2002 | 2004  | 2002                                 | 2004  | 2002 | 2004                               | 2002 | 2004  | 2002                                 | 2004  | 2002 | 2004                               | 2002 | 2004 |
| d50       | N/A                                  | 14.50 | N/A  | 0.25                               | N/A  | 11.12 | N/A                                  | 42.19 | N/A  | 16.22                              | N/A  | 43.83 | N/A                                  | 12.15 | N/A  | 38.50                              |      |      |
| d84       | N/A                                  | 48.88 | N/A  |                                    |      |       |                                      |       |      |                                    |      |       |                                      |       |      |                                    |      |      |

| VEGETATION 2004 Monitoring | Quad 1 - Brown Observed |          |          | Quad 2 - Brown Observed |          |          | Quad 3 - Brown Observed |          |          | Quad 4 - Brown Observed |          |          | Quad 4 - Brown Planted* |          |          |          |
|----------------------------|-------------------------|----------|----------|-------------------------|----------|----------|-------------------------|----------|----------|-------------------------|----------|----------|-------------------------|----------|----------|----------|
|                            | Planted*                | Planted* | Planted* | Observed                | Planted* | Observed | Planted* |
| Tree Stratum (stems/acre)  | 680                     | 160      | 1120     | 240                     | 680      | 200      | 4760                    | 400      | 3000     | 200                     | n/a      | n/a      | 0                       | n/a      | 0        | n/a      |
| Shrub Stratum (% cover)    | 3                       | n/a      | 0        | n/a                     | 0        | 0        | n/a                     | 0        | n/a      | 107                     | n/a      | 52       | n/a                     | 52       | n/a      | n/a      |
| Herb Stratum (% cover)     | 46                      | n/a      | 90       | n/a                     | 105      | n/a      | n/a                     | n/a      | n/a      | n/a                     | n/a      | n/a      | n/a                     | n/a      | n/a      | n/a      |

\* Planted value represents number of stems observed alive that were planted.

The following areas of concern should be monitored closely and considered for repair as suggested:

### Brown Branch

- Areas with bank erosion
  - Bank erosion has been noted at fourteen locations on the restored reach of this stream
  - There are two areas of major bank erosion due to the in-channel shearing forces of stream at station 4+40 and station at 7+00
    - At station 4+20 to 4+60 there is a 40 ft long area of severe bank erosion on the right bank the bank has an extreme BEHI and is actively eroding. This erosion is captured by the surveyed cross-section #1 and is photo documented. The actively eroding bank height is 4.2 ft with a vertical non-protected bank.
    - At station 6+80 to 7+20 there is a 40 ft long area of severe bank erosion on the left bank the bank has an extreme BEHI and is actively eroding. The actively eroding bank height is 6.5 ft with a vertical non-protected bank.
  - The remainder of the bank erosion issues could be described as being caused by circulations behind a root wad or as occurring downstream on the outside of a meander bend
  - There are two areas of bank erosion due to overland seepage or flow at station 20+00 on the right bank and at station at 29+50 on the right bank
  - There are three areas with an active mid-channel bar at station 40+10, at station 43+25 and at station at 44+50
    - At station 40+20 to 40+50 there is a 30 ft long mid channel bar.
    - At station 43+10 to 43+60 there is a 50 ft long mid channel bar that. This mid-channel bar is captured by the surveyed cross-section #5 and is photo documented.
    - At station 44+45 to 40+50 there is a 5 ft long mid channel bar that
- Stream Profile
  - The stream is showing signs of down-cutting from station 0+00 to 9+00 the average slope for this reach is 1.4%
    - The this reach has down-cut in some areas as much as 6 inches but the reach is maintaining well defined riffles and riffle slopes that are close to the as-built riffle slopes.
  - From station 10+00 to 51+00 the average slope for this reach is 1.0% and pools are filling with sediment and loosing capacity
    - This reach has not significantly aggraded but the riffle are becoming shorter and generating steeper riffle slopes.
    - Pools are still generally located in the outside of the meander bends but the pool length and depth have decreased.
- Vegetation
  - Replanting trees should occur to obtain mitigation requirements
  - The site could benefit from larger containerized trees both for bank stability and aesthetics, although mitigation requirements are currently being met.

- It is recommended to stake in areas where erosion is problematic, particularly on outside meander bends.

## Photos

The following are photographs of typical sections and areas of concern throughout the project.



**Typical Pool**



**Typical Riffle**



**Issue Photo 1. Bank Erosion Left Bank  
STA: 6+75**



**Issue Photo 2. Mid-Channel Bar  
STA: 40+20**



**Issue Photo 3 Pool Filling with Sediment  
At STA: 44+50**



**Issue Photo 4 Bank Erosion at  
STA: 38+50**

\*There are more issue photos in the photo log of this report

# Table of Contents

|  |      |
|--|------|
| <b>2004 Brown Branch Monitoring Abstract .....</b> | i    |
| <b>Table of Contents .....</b>                     | viii |
| <b>Tables and Figures .....</b>                    | viii |
| <br>   |      |
| <b>1.0 BACKGROUND INFORMATION .....</b>            | 1    |
| 1.1 Goals and Objective .....                      | 1    |
| 1.2 Project Location.....                          | 1    |
| 1.3 Project Description .....                      | 2    |
| <b>2.0 YEAR 2004 RESULTS AND DISCUSSION .....</b>  | 7    |
| 2.1 Vegetation.....                                | 7    |
| 2.1.1 Results and Discussion.....                  | 7    |
| 2.2 Morphology .....                               | 8    |
| 2.2.1 Results and Discussion.....                  | 8    |
| 2.3 Biological and Ecological.....                 | 8    |
| 2.3.1 Results and Discussion.....                  | 8    |
| 2.3 Areas of Concern.....                          | 13   |

# Tables and Figures

|   |    |
|---|----|
| Figure 1. Project Location.....                       | 3  |
| Figure 2. Watershed Ortho-photo .....                 | 4  |
| Figure 3. Plan view of As-built conditions .....      | 5  |
| Figure 4. Plan view of 2004 overlain on As-built..... | 6  |
| Table 1. Summary of Results.....                      | 9  |
| Figure 5. Brown BranchProfile.....                    | 12 |

## **1.0 BACKGROUND INFORMATION**

Project planning was initiated for the Brown Branch Stream Restoration in 2002 for the implementation of a stream restoration project in Mulberry, North Carolina Located in Caldwell Co. (Figure 1).

The project consisted of the analysis of the 1.1 square mile portion of the Brown Branch watershed (located within USGS Hydrologic Unit Code 03050101, NCDWQ Sub-basin 11-38-32-13 Upper Catawba River Basin) that contributes drainage to the project site. The watershed analysis, including the assessment of stream channel, was conducted for the purpose of developing a clear understanding of existing system characteristics. The resulting Restoration Plan identified opportunities to improve water quality and overall system functions including targeted strategies such as wetland/riparian buffer preservation, stream restoration, and community education.

Following coordination with local leaders, the Wetlands Restoration Program and citizens groups, the project was initiated and focused on the restoration of approximately 5100 linear feet of degraded stream within the Anita Alta 4-H Camp. Detailed environmental assessments and engineering studies were conducted and design plans and documents were prepared to facilitate the stream and riparian buffer restoration. Implementation of the project was completed by September 2003.

The restoration of this portion of Brown Branch, located within the Anita Alta 4-H Camp, was conducted to correct identified system deficiencies including severe bank erosion, channel widening, and the loss of aquatic habitat resulting from stream channelization, the loss of riparian vegetation, and watershed development. The goal of the project was to develop a stable stream channel with reduced bank erosion, efficient sediment transport, enhanced warm water fisheries, and improved overall stream habitat and site aesthetics. Implementation of the project was completed by September 2003.

### **1.1 Goals and Objective**

The goals and objectives of this project are as follows:

- 1.) Restore 5,100-linear feet of Brown Branch through a priority 1 natural channel design approach.
- 2.) Establish a riparian zone surrounding restored section of Brown Branch.
- 3.) Improve the habitat within the channel and the riparian zone.
- 4.) Incorporate this project into a watershed wide management plan.

### **1.2 Project Location**

This project is located north the city limits of Lenoir, North Carolina in Caldwell County. From US-321 ALT/N MAIN ST in Lenoir NC, turn LEFT 1.4 miles north of Lenoir onto NC-90/VALWAY RD NW. Continue on NC-90/VALWAY RD NW 1.3 miles and turn left onto NC-90/COLLETTSVILLE RD. Continue on NC-90/COLLETTSVILLE RD

**Table 1. Background information**

|                                   |  |
|-----------------------------------|--|
| <b>Project Name</b>               | Brown Branch   |
| <b>Designer's Name</b>            | Biohabitats Inc.<br>15 West Aylesbury Road<br>Timonium, MD 21093   |
| <b>Contractor's Name</b>          | Shamrock Environmental   |
| <b>Project County</b>             | Caldwell, North Carolina   |
| <b>Directions to Project Site</b> | From US-321 ALT/N MAIN ST in Lenoir NC, turn LEFT 1.4 miles north of Lenoir onto NC-90/VALWAY RD NW. Continue on NC-90/VALWAY RD NW 1.3 miles and turn left onto NC-90/COLLETTSVILLE RD. Continue on NC-90/COLLETTSVILLE RD 4.0 miles and turn right onto MULBERRY CREEK RD. Continue on MULBERRY CREEK RD 3.5 miles and turn right into Anita Alta 4-H Camp and the location of Brown Branch restoration. |
| <b>Drainage Area</b>              | 1.1 sq. mi.  |
| <b>USGS Hydro Unit</b>            | 03050101   |
| <b>NCDWQ Subbasin</b>             | 11-38-32-13 Upper Catawba River Basin  |
| <b>Project Length</b>             | 5,100 Linear feet  |
| <b>Restoration Approach</b>       | 5,100 ft of priority 1 Natural Channel Design (dimension, pattern, and profile)  |
| <b>Date of Completion</b>         | September, 2003  |
| <b>Monitoring Dates</b>           | October, 2003; June 2004   |


4.0 miles and turn right onto MULBERRY CREEK RD. Continue on MULBERRY CREEK RD 3.5 miles and turn right into Anita Alta 4-H Camp and the location of Brown Branch restoration.

### **1.3 Project Description**

A previously straight and incised channel through the Anita Alta 4-H Camp, Brown Branch was restored using channel dimension, pattern, and profile modifications and the establishment of riparian zone adjacent to the creek. Channel profile is maintained through the use of rock cross vanes. Channel pattern is maintained through the use of single vanes and vegetation along the channel banks.

In September 2003 a stream restoration design and construction project using natural stream channel geometry design parameters was completed on Brown Branch, a tributary to Mulberry Creek in Caldwell County, North Carolina near Lenoir. The study reach begins at the confluence of two 1st-order tributaries and follows the 2nd-order channel downstream for a mile through an alluvial valley. The project was undertaken by the Wetlands Restoration Program (WRP) of the North Carolina Department of Environment and Natural Resources.

The stream restoration was motivated by an unstable channel configuration that was causing poor water quality, a featureless bed, a lack of riparian cover, and poor habitat. The overarching goal of the project was to establish a stable planform, cross-sectional, and profile pattern that would improve water quality, enhance in-stream habitat, and improve the functional and aesthetic value of the riparian corridor. Brown Branch is believed to have supported a trout population historically. By creating a range of aquatic niches, the project is also intended to provide in-stream habitat that could support trout populations in the future. Brown Branch was classified in 1990 as a high quality waters by the state of North Carolina.

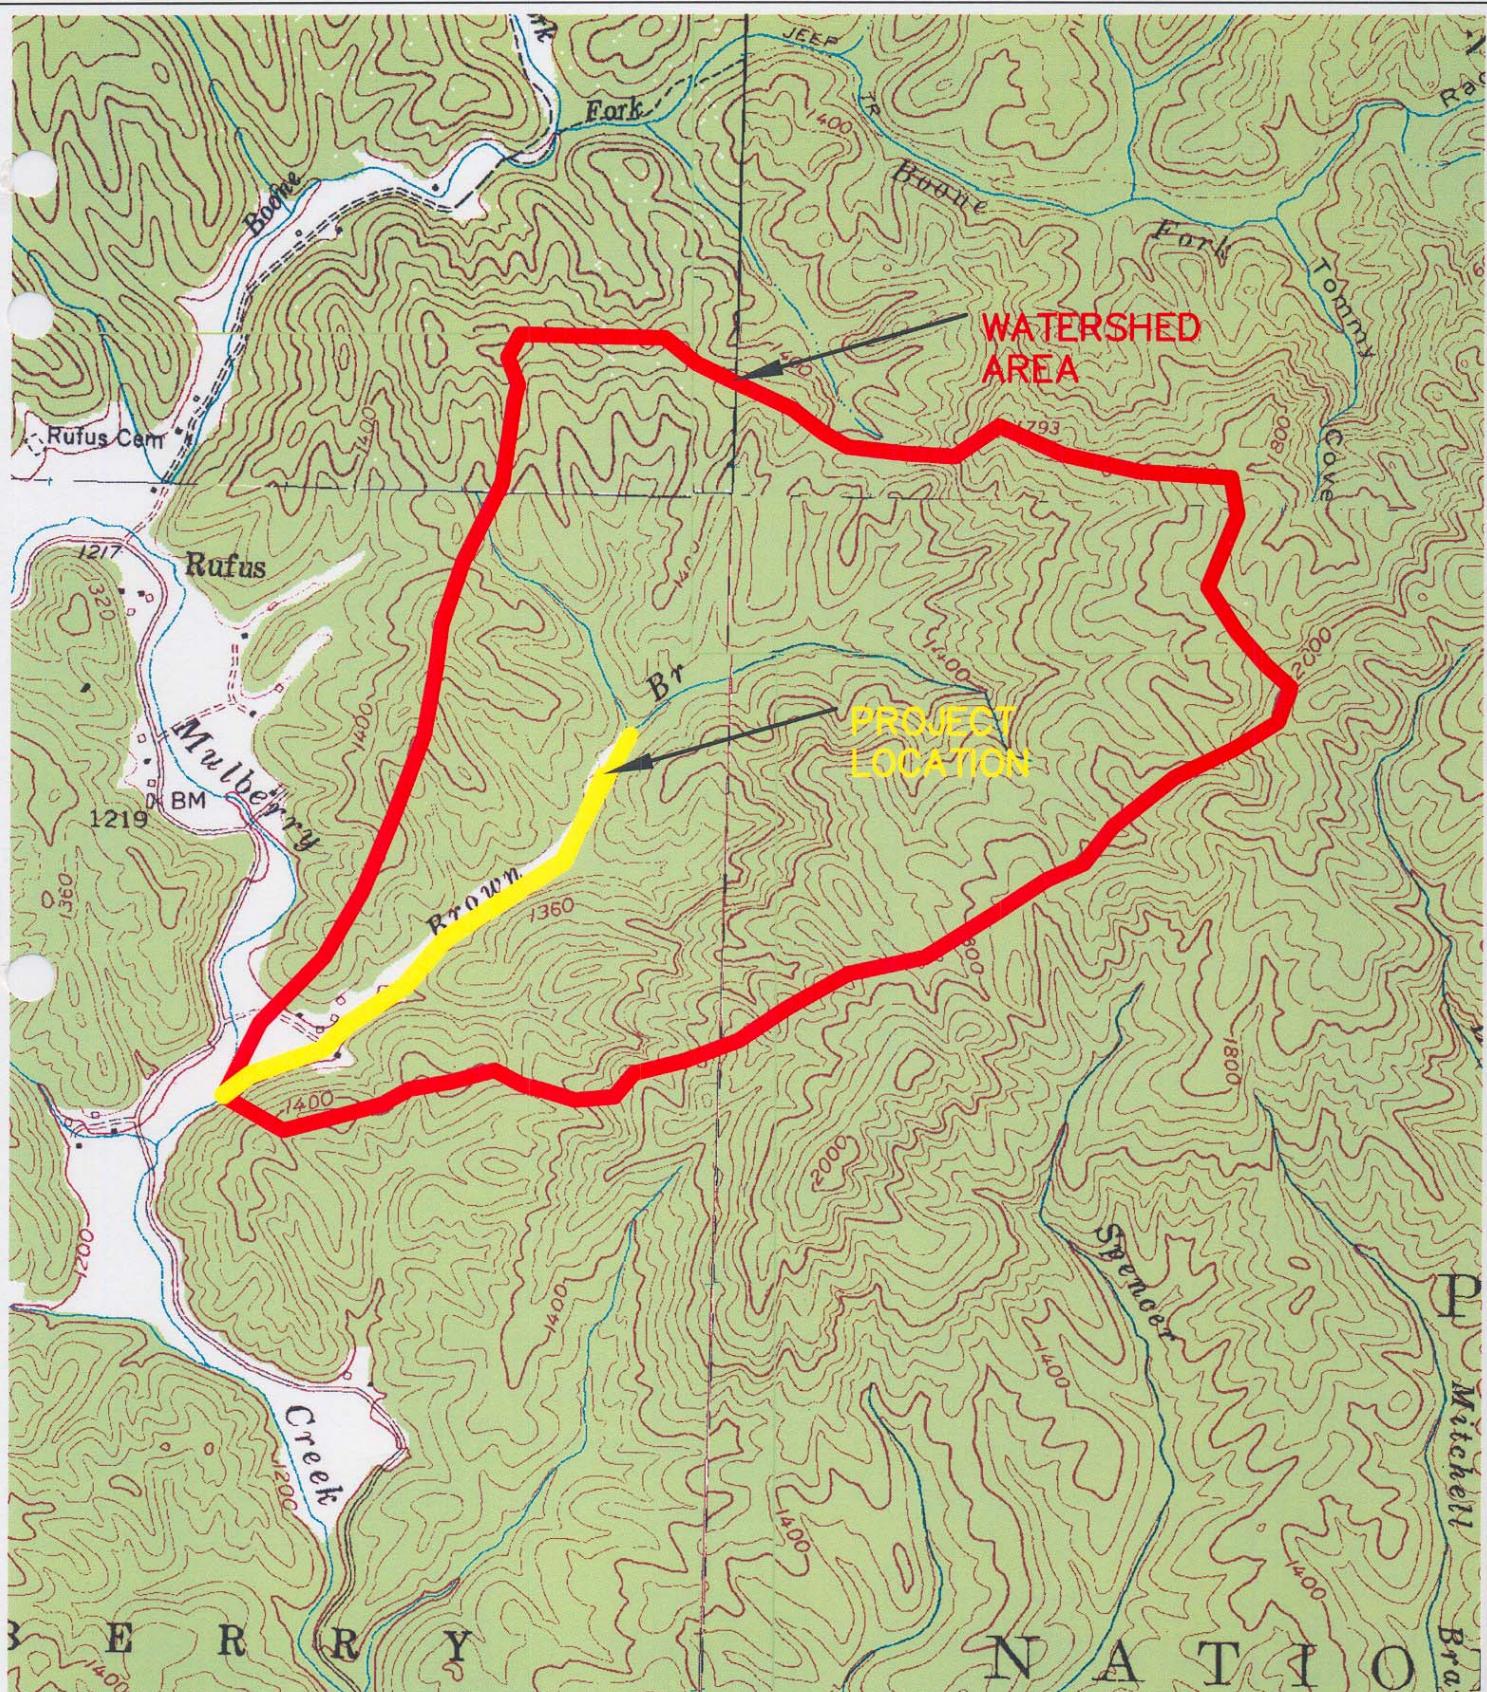


750 0 750 1500



SCALE 1" = 1500'

|  |                  |  |                  |           |     |              |
|--|------------------|--|------------------|-----------|-----|--------------|
| BROWN BRANCH<br>ANITA ALTA 4-H CAMP<br>CALDWELL COUNTY, N.C. |                  | <b>NC STATE UNIVERSITY</b>   | 1 INITIAL DESIGN | DAB       | DRC | 02/26/05     |
| DATE   | 02/25/2005       | BIOLOGICAL & AGRICULTURAL ENGINEERING<br>Weaver Labs Campus Box 7825<br>North Carolina State University<br>Raleigh, NC 27695 |                  |           |     |              |
| PROJECT NO.  |                  |  |                  |           |     |              |
| FILENAME   | Brown Branch.DWG |  |                  |           |     |              |
| SHEET NO.  | Pt. - 1          |  | NO.              | REVISIONS |     | DRN CHK DATE |
| DRAWING NO.  |                  |  |                  |           |     |              |

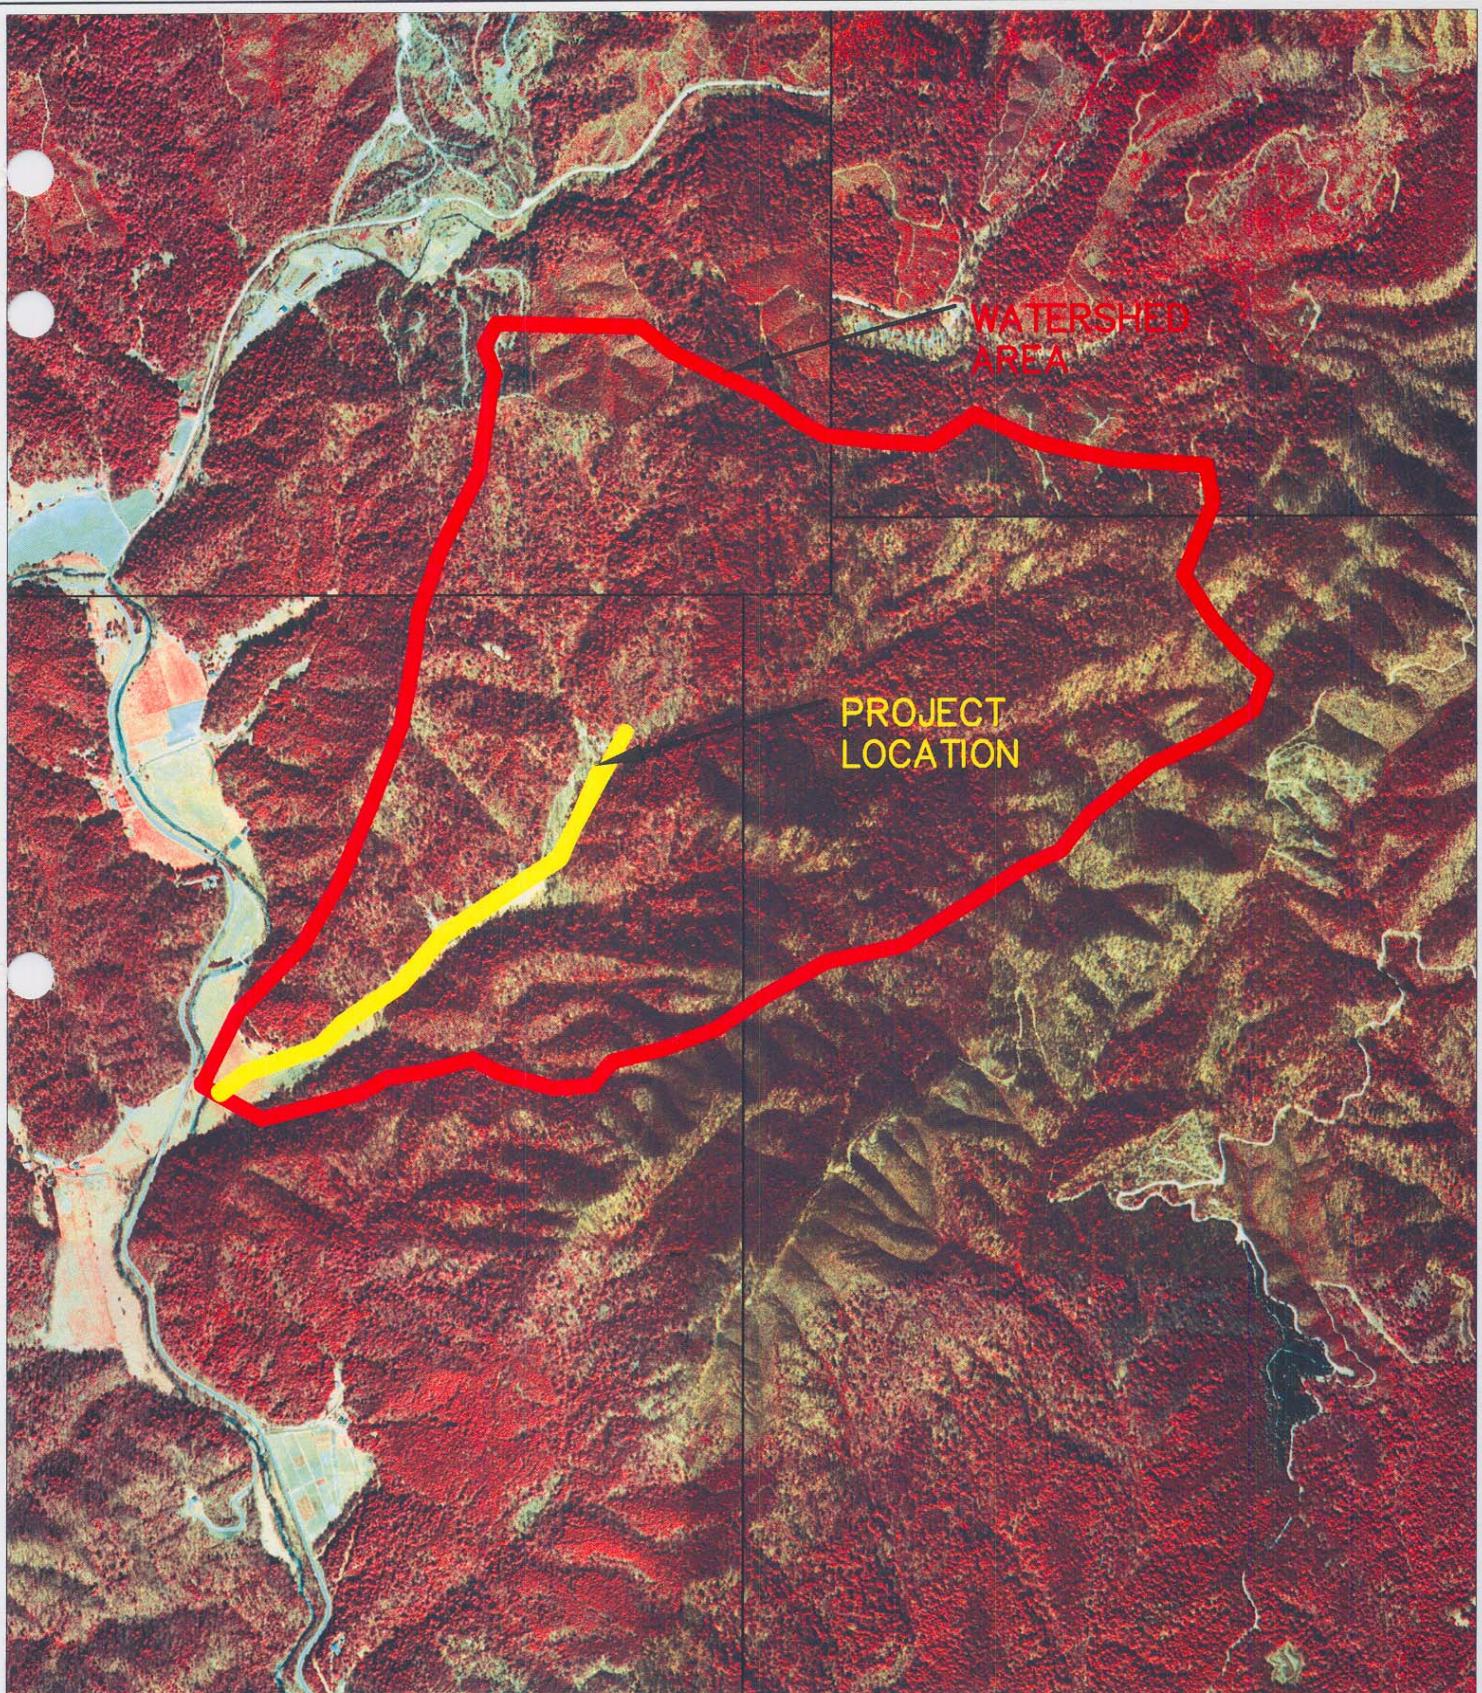

750 0 750 1500



SCALE 1" = 1500'

BROWN BRANCH  
ANITA ALTA 4-H CAMP  
CALDWELL COUNTY, N.C.

**NC STATE UNIVERSITY**

BIOLOGICAL & AGRICULTURAL ENGINEERING  
Weaver Labs Campus Box 7625  
North Carolina State University  
Raleigh, NC 27695

|  |        |      |          |             |           |                  |                  |           |     |          |      |
|--|--------|------|----------|-------------|-----------|------------------|------------------|-----------|-----|----------|------|
| DRAWING NO.  | PL - 1 | DATE | 02/26/05 | PROJECT NO. | FILE NAME | Brown Branch Dmg | 1 INITIAL DESIGN | DAB       | DRC | 02/26/05 |      |
| WATERSHED AREA 1.1 SQMI<br>DIGITAL ORTHO PHOTO MAP |        |      |          |             |           |                  | NO               | REVISIONS | DRN | CHK      | DATE |

**Figure 3. Plan view of As-built conditions**

(To be attached)

showing all structures with station numbers

showing vegetation permanent plots

showing permanent cross-sections and benchmarks

showing vegetation plots

showing monitoring gauges

**Figure 4. Plan view of 2003 overlain on As-built**  
(To be attached)

## **2.0 YEAR 2004 RESULTS AND DISCUSSION**

Year 2004 monitoring results are shown for Brown Branch Monitoring.

### **2.1 Vegetation**

Using the Draft Vegetation Monitoring Plan for NCWRP Riparian Buffer and Wetland Restoration Projects, 4 vegetation monitoring plots were randomly located within the riparian buffer of the Brown Branch project. No reference area was studied; therefore no comparisons could be made to reference conditions.

#### **2.1.1 Results and Discussion**

Vegetation within the riparian buffer varied in success level. Cover throughout the site ranges from 50 to 100%. Herbaceous vegetation, both planted and naturally regenerating, is doing extremely well and contributes to the bank stability of the project. Live stakes have not succeeded in most plots. Where they have survived (plot #1), deer browse is evident. Plots 4 and 5 also showed evidence of cattle presence.

Planted trees and shrubs are doing poorly throughout the entire buffer. Success levels do not meet mitigation requirements. Plots typically had approximately 200 surviving planted trees per acre with the exception of plot 4, which had 400 surviving planted trees per acre. Deer browse appears to be the major contributor to vegetation failure. Extrapolation from the plots resulted in an overall average of approximately 240 surviving planted trees per acre for this restoration site.

Natural regeneration of woody stems dominated the plots, especially nearest the stream. Tulip poplar (*Liriodendron tulipifera*) and sycamore (*Platanus occidentalis*) dominated the trees species reproducing through natural regeneration. Overall, the area appeared to be in an early successional state.

Recommendations include replanting trees to obtain mitigation requirements, and adding live stakes to streambanks where erosion or scour are evident. Invasive vegetation is not a major issue on this project site but smartweed (*Polygonum spp.*), Japanese stilt grass (*Microstegium vimineum*), Japanese honeysuckle (*Lonicera japonica*), and fescue (*Festuca spp.*) were identified in locations throughout the site. These should be monitored, and may need control so more diverse herbaceous vegetation can develop.

## **2.2 Morphology**

Restored channel dimension, pattern, profile and substrate were examined during the 2004 monitoring.

### **2.2.1 Results and Discussion**

Bank erosion has been noted at fourteen locations on the restored reach of this stream. There are two areas of major bank erosion due to the in-channel shearing forces on the stream at station 4+40 and station at 7+00. The first area or major bank erosion occurred at station 4+20 to 4+60 there is a 40 ft long area of severe bank erosion on the right bank the bank has an extreme BEHI and is actively eroding. This erosion is captured by the surveyed cross-section #1 and is photo documented. The actively eroding bank height is 4.2 ft with a vertical non-protected bank. The second area of severe bank erosion occurred at station 6+80 to 7+20 there is a 40 ft long area of severe bank erosion on the left bank the bank has an extreme BEHI and is actively eroding. The actively eroding bank height is 6.5 ft with a vertical non-protected bank. The remainder of the bank erosion issues could be described as being caused by circulations behind a root wad or as occurring downstream on the outside of a meander bend. These causes or bank erosion will be investigated with future surveys and research. There are two areas of bank erosion due to overland seepage or flow at station 20+00 on the right bank and at station at 29+50 on the right bank. There are also three areas with an active mid-channel bar at station 40+10, at station 43+25 and at station at 44+50. At station 40+20 to 40+50 there is a 30 ft long mid channel bar. At station 43+10 to 43+60 there is a 50 ft long mid channel bar that. This mid-channel bar is captured by the surveyed cross-section #5 and is photo documented. At station 44+45 to 40+50 there is a 5 ft long mid channel bar that. These mid-channel bars will lead to future bank erosion and high near bank stress.

The stream is showing signs of down-cutting from station 0+00 to 9+00 the average slope for this reach is 1.4%. This upper reach has down-cut in some areas as much as 6 inches but the reach is maintaining well defined riffles and riffle slopes that are close to the as-built riffle slopes. From station 10+00 to 51+00 the average slope for this reach is 0.8% and pools are filling with sediment and loosing capacity. This reach has not significantly aggraded but the riffle are becoming shorter and generating steeper riffle slopes. Pools are still generally located in the outside of the meander bends but the pool length and depth have decreased. The pool to pool spacing has not decreased on either reach. The overall planform of the entire reach has also remained similar to the as-built conditions with no significant change in radius of curvature, belt width or wave length.

Cross sections number 2, 3 and 4 have remained stable with similar cross sectional areas, no major signs of erosion and similar substrate. Cross section #1 is a riffle located at STA 4+30 that has down cut 6 inches with major bank erosion on the right bank. The cross sectional area has increased 90% to 20 sqft from 11.5 sqft. Cross section #5 is a riffle located at STA 43+20 that has down cut 3 inches and has formed a mid-channel bar with bank erosion on the right bank. The cross sectional area has increased 35% to 15 sqft from 11.7 sqft. Cross section #6 is a pool located at STA 43+40 that has aggraded 12. The cross sectional area has decreased 35% to 20 sqft from 30 sqft.

Table 1. Summary of Channel Conditions

| DIMENSION                     | Brown Branch<br>Cross-section #1<br>Riffle | Brown Branch<br>Cross-section #2<br>Pool | Brown Branch<br>Cross-section #3<br>Riffle | Brown Branch<br>Cross-section #4<br>Pool | Brown Branch<br>Cross-section #5<br>Riffle | Brown Branch<br>Cross-section #6<br>Pool |
|-------------------------------|--|--|--|--|--|--|
| Monitoring Year               | AS-BUILT<br>2003                           | 2004                                     | AS-BUILT<br>2003                           | 2004                                     | AS-BUILT<br>2003                           | 2004                                     |
| Bankfull Cross-sectional Area | 11.4<br>22.7                               | 19.8<br>13.3                             | 12.2<br>9.5                                | 15.4<br>16.6                             | 15.1<br>21.9                               | 14.8<br>11.67                            |
| Bankfull Width                | 10.0<br>14.1                               | 15.2<br>21.9                             | 22.5<br>23.1                               | 16.8<br>14.9                             | 20.0<br>14.6                               | 24.7<br>16.00                            |
| Bankfull Mean Depth           | 1.1<br>2.3                                 | 1.6<br>2.1                               | 0.6<br>1.8                                 | 0.5<br>1.5                               | 0.4<br>1.6                                 | 1.1<br>1.0                               |
| Bankfull Max Depth            | 1.8<br>2.3                                 |  |  |  | 1.8<br>1.7                                 | 1.9<br>1.7                               |

| PATTERN             | Brown Branch<br>Design | Brown Branch<br>As-built 2002 | Brown Branch<br>2004 |
|---------------------|------------------------|-------------------------------|----------------------|
|                     | Minimum                | Maximum                       | Median               |
| Meander Wave Length | Not Reported           | Not Reported                  | 83                   |
| Radius of Curvature | Not Reported           | Not Reported                  | 104                  |
| Beltwidth           | Not Reported           | Not Reported                  | 100                  |

| PROFILE              | Brown Branch<br>Design | Brown Branch<br>As-built 2002 | Brown Branch<br>2004 |
|----------------------|------------------------|-------------------------------|----------------------|
|                      | Minimum                | Maximum                       | Median               |
| Riffle Length        | Not Reported           | Not Reported                  | 22                   |
| Riffle Slope         | Not Reported           | Not Reported                  | 0.62%                |
| Pool Length          | Not Reported           | Not Reported                  | 9                    |
| Pool to Pool Spacing | Not Reported           | Not Reported                  | 62                   |
| Valley (TOB) Slope   | Not Reported           | Not Reported                  | 18                   |
| Bankfull Slope       | Not Reported           | Not Reported                  | 61                   |

| SUBSTRATE       | Brown Branch<br>Cross-section #1<br>Riffle | Brown Branch<br>Cross-section #2<br>Pool | Brown Branch<br>Cross-section #3<br>Riffle | Brown Branch<br>Cross-section #4<br>Pool | Brown Branch<br>Cross-section #5<br>Riffle | Brown Branch<br>Cross-section #6<br>Pool |
|-----------------|--|--|--|--|--|--|
| Monitoring Year | 2002<br>N/A                                | 2004<br>N/A                              | 2002<br>N/A                                | 2004<br>N/A                              | 2002<br>N/A                                | 2004<br>N/A                              |
| d50             | 14.50<br>N/A                               | 48.88<br>N/A                             | 0.25<br>11.12                              | N/A<br>N/A                               | 17.69<br>42.19                             | N/A<br>N/A                               |
| d84             | N/A  | N/A                                      |  |  | 16.22<br>43.83                             | N/A<br>N/A                               |

| VEGETATION 2004 Monitoring | Quad 1 - Brown<br>Observed | Quad 1 - Brown<br>Planted* | Quad 2 - Brown Branch<br>Observed | Quad 2 - Brown Branch<br>Planted* | Quad 3 - Brown Branch<br>Observed | Quad 3 - Brown Branch<br>Planted* | Quad 4 - Brown Branch<br>Observed | Quad 4 - Brown Branch<br>Planted* |
|----------------------------|----------------------------|----------------------------|-----------------------------------|-----------------------------------|-----------------------------------|-----------------------------------|-----------------------------------|-----------------------------------|
| Tree Stratum (stems/acre)  | 680<br>3                   | 160<br>0                   | 1,120<br>0                        | 240<br>0                          | 680<br>0                          | 200<br>0                          | 4760<br>0                         | 3000<br>0                         |
| Shrub Stratum (% cover)    |                            |                            |                                   |                                   |                                   |                                   | n/a<br>0                          | n/a<br>0                          |
| Herb Stratum (% cover)     | 46                         | n/a<br>90                  | n/a<br>105                        | n/a<br>107                        | n/a<br>1.7                        | n/a<br>1.4                        | 52<br>2.5                         | n/a<br>1.8                        |

\* Planted value represents number of stems observed alive that were planted.

## 2.3 Biological and Ecological

Samples were collected from three locations on Brown Branch. A stable reference reach was selected above the restored reach. This site (site #1) was located above the project start point (52 + 87) but below the confluence of a small tributary. Sedimentation is apparent within this reach since most of the pools are at least partially filled in with sand. However, there is a good riparian canopy and lots of large woody debris (LWD). The LWD offers substantial habitat for aquatic insects, as many Limnephilid caddisflies were very abundant during the pre-construction investigation. These taxa include Pycnopsyche (2 or 3 species), Heteroplectron and Anisocentropus. Interestingly there were very few mayflies were collected from this reach. This includes Heptageniids (including Epeorus) or Ephemeralids. This may due to the sedimentation or pH may be chronically low.

The next downstream site was located immediately below a farm pond on the property. Brown Branch at this point is much different than at station 1. The width/depth ratio appears to have increased substantially prior to construction and most of the canopy has been eliminated. In addition LWD was scarce, as was fine organic matter in the substrate. This physical change in the structure of Brown Branch has impacted the benthic fauna. Many fewer Limnephilids were collected and we started to see Ephemeralids and Heptageniids. Embeddedness also has increased significantly between these two locations.

Station 3 (the most downstream location) was located near the confluence with Mulberry Creek. The site is directly across the pasture from the owner's home. The stream at this point appears to have incised some and there is evidence of enrichment. Macrophytes are common and cattle have direct access to the stream. EPT abundance values appear to have increased from site 2. Another interesting observation is the shift in the structure of the snail population. The upstream location was dominated by Elimia, but as soon as the canopy opened up, the number of Elimia dropped off and they were replaced by some Physella and Planorbula at the downstream locations. Data from both surveys are listed in table 15.

Table 15. Summary statistics from the stream restoration project at Brown Branch (Caldwell County).


| Metric/Survey                | Upstream Ref, site1 |           | Site 2   |           | Site 3   |           |
|------------------------------|---------------------|-----------|----------|-----------|----------|-----------|
|                              | Apr 2002            | June 2004 | Apr 2002 | June 2004 | Apr 2002 | June 2004 |
| Total Taxa Richness          | 57                  | 50        | 57       | 59        | 67       | 59        |
| EPT Taxa Richness            | 33                  | 23        | 31       | 32        | 33       | 32        |
| EPT Abundance                | 133                 | 111       | 87       | 142       | 119      | 167       |
| Dominant in Common Index (%) | -                   | -         | 39%      | 63%       | 33%      | 44%       |
| # Keystone Species           | 23                  | <b>16</b> | 13       | 12        | 14       | 10        |

Much lower EPT taxa richness values were recorded at site 1 in 2004 during the first post-construction survey. Much of this difference is due to lower caddisfly and stonefly numbers in 2004. For example 11 stonefly taxa were collected in the April 2002 survey, while only 5 stonefly taxa were collected during the 2004 survey. These differences are a result of seasonal variability in the data as the 2004 data were collected in June. Note also the much lower number of keystone taxa collected during the 2004 survey at the reference site (in bold). Dominant in Common numbers were much lower during the 2002 pre-construction survey than during the first post-construction survey, suggesting that there is some recovery and improvement occurring in these restored reaches. However, seasonal variability in the data will make direct comparisons between surveys difficult. In addition slightly lower number of keystone taxa were collected at the restored reaches following restoration. April surveys will be conducted at this project in 2005 to corroborate data that suggests improvements following restoration..


### 2.3.1 Results and Discussion

Direct comparison between pre and post-construction community structure is difficult due to seasonal variability in the data (the pre-construction survey was conducted in April 2002 and the first post-construction survey was conducted in June 2004). Whereas significant decreases in all metrics were noted at the reference reach during the post-construction survey, very subtle differences were noted in taxa richness at the two restored reaches between surveys; in fact, increases were noted for EPT abundance and the Dominant in Common index following construction. These data suggest the biological integrity of this feature improved following construction above those recorded prior to construction; however, seasonal variability in the data makes direct comparison difficult.


BROWN BRANCH  
LONG PROFILE  
2004 MONITORING

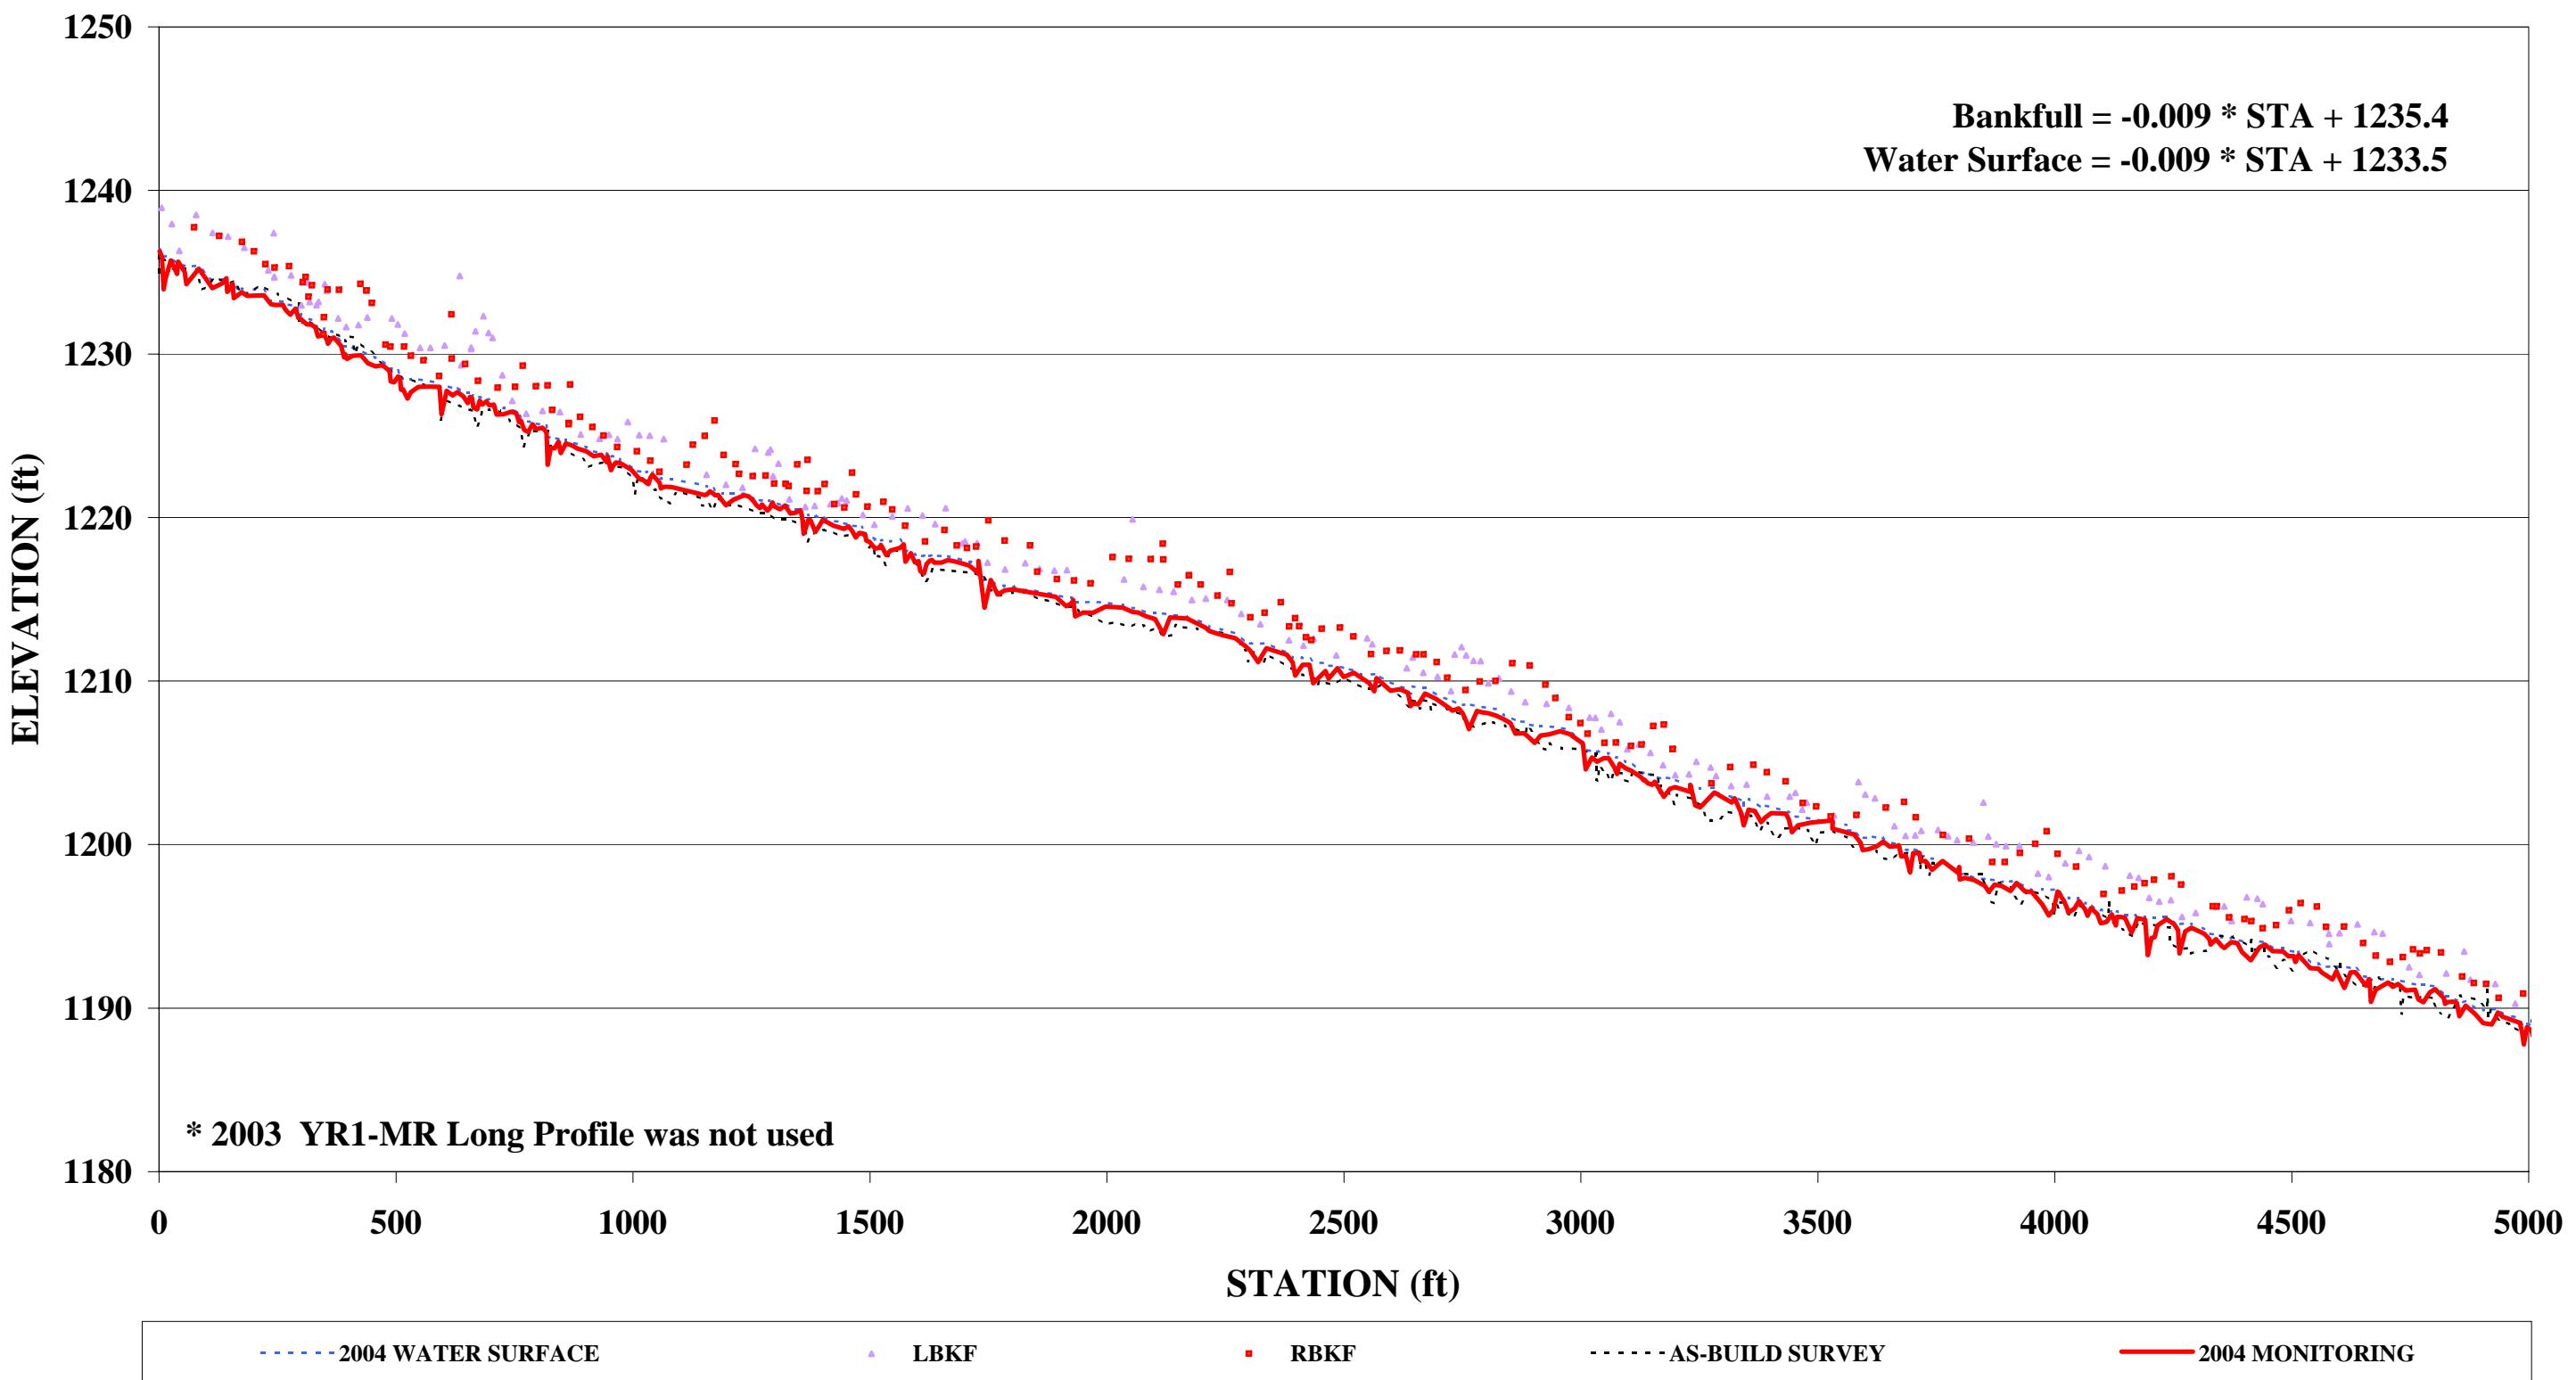


BROWN BRANCH  
LONG PROFILE  
2004 MONITORING

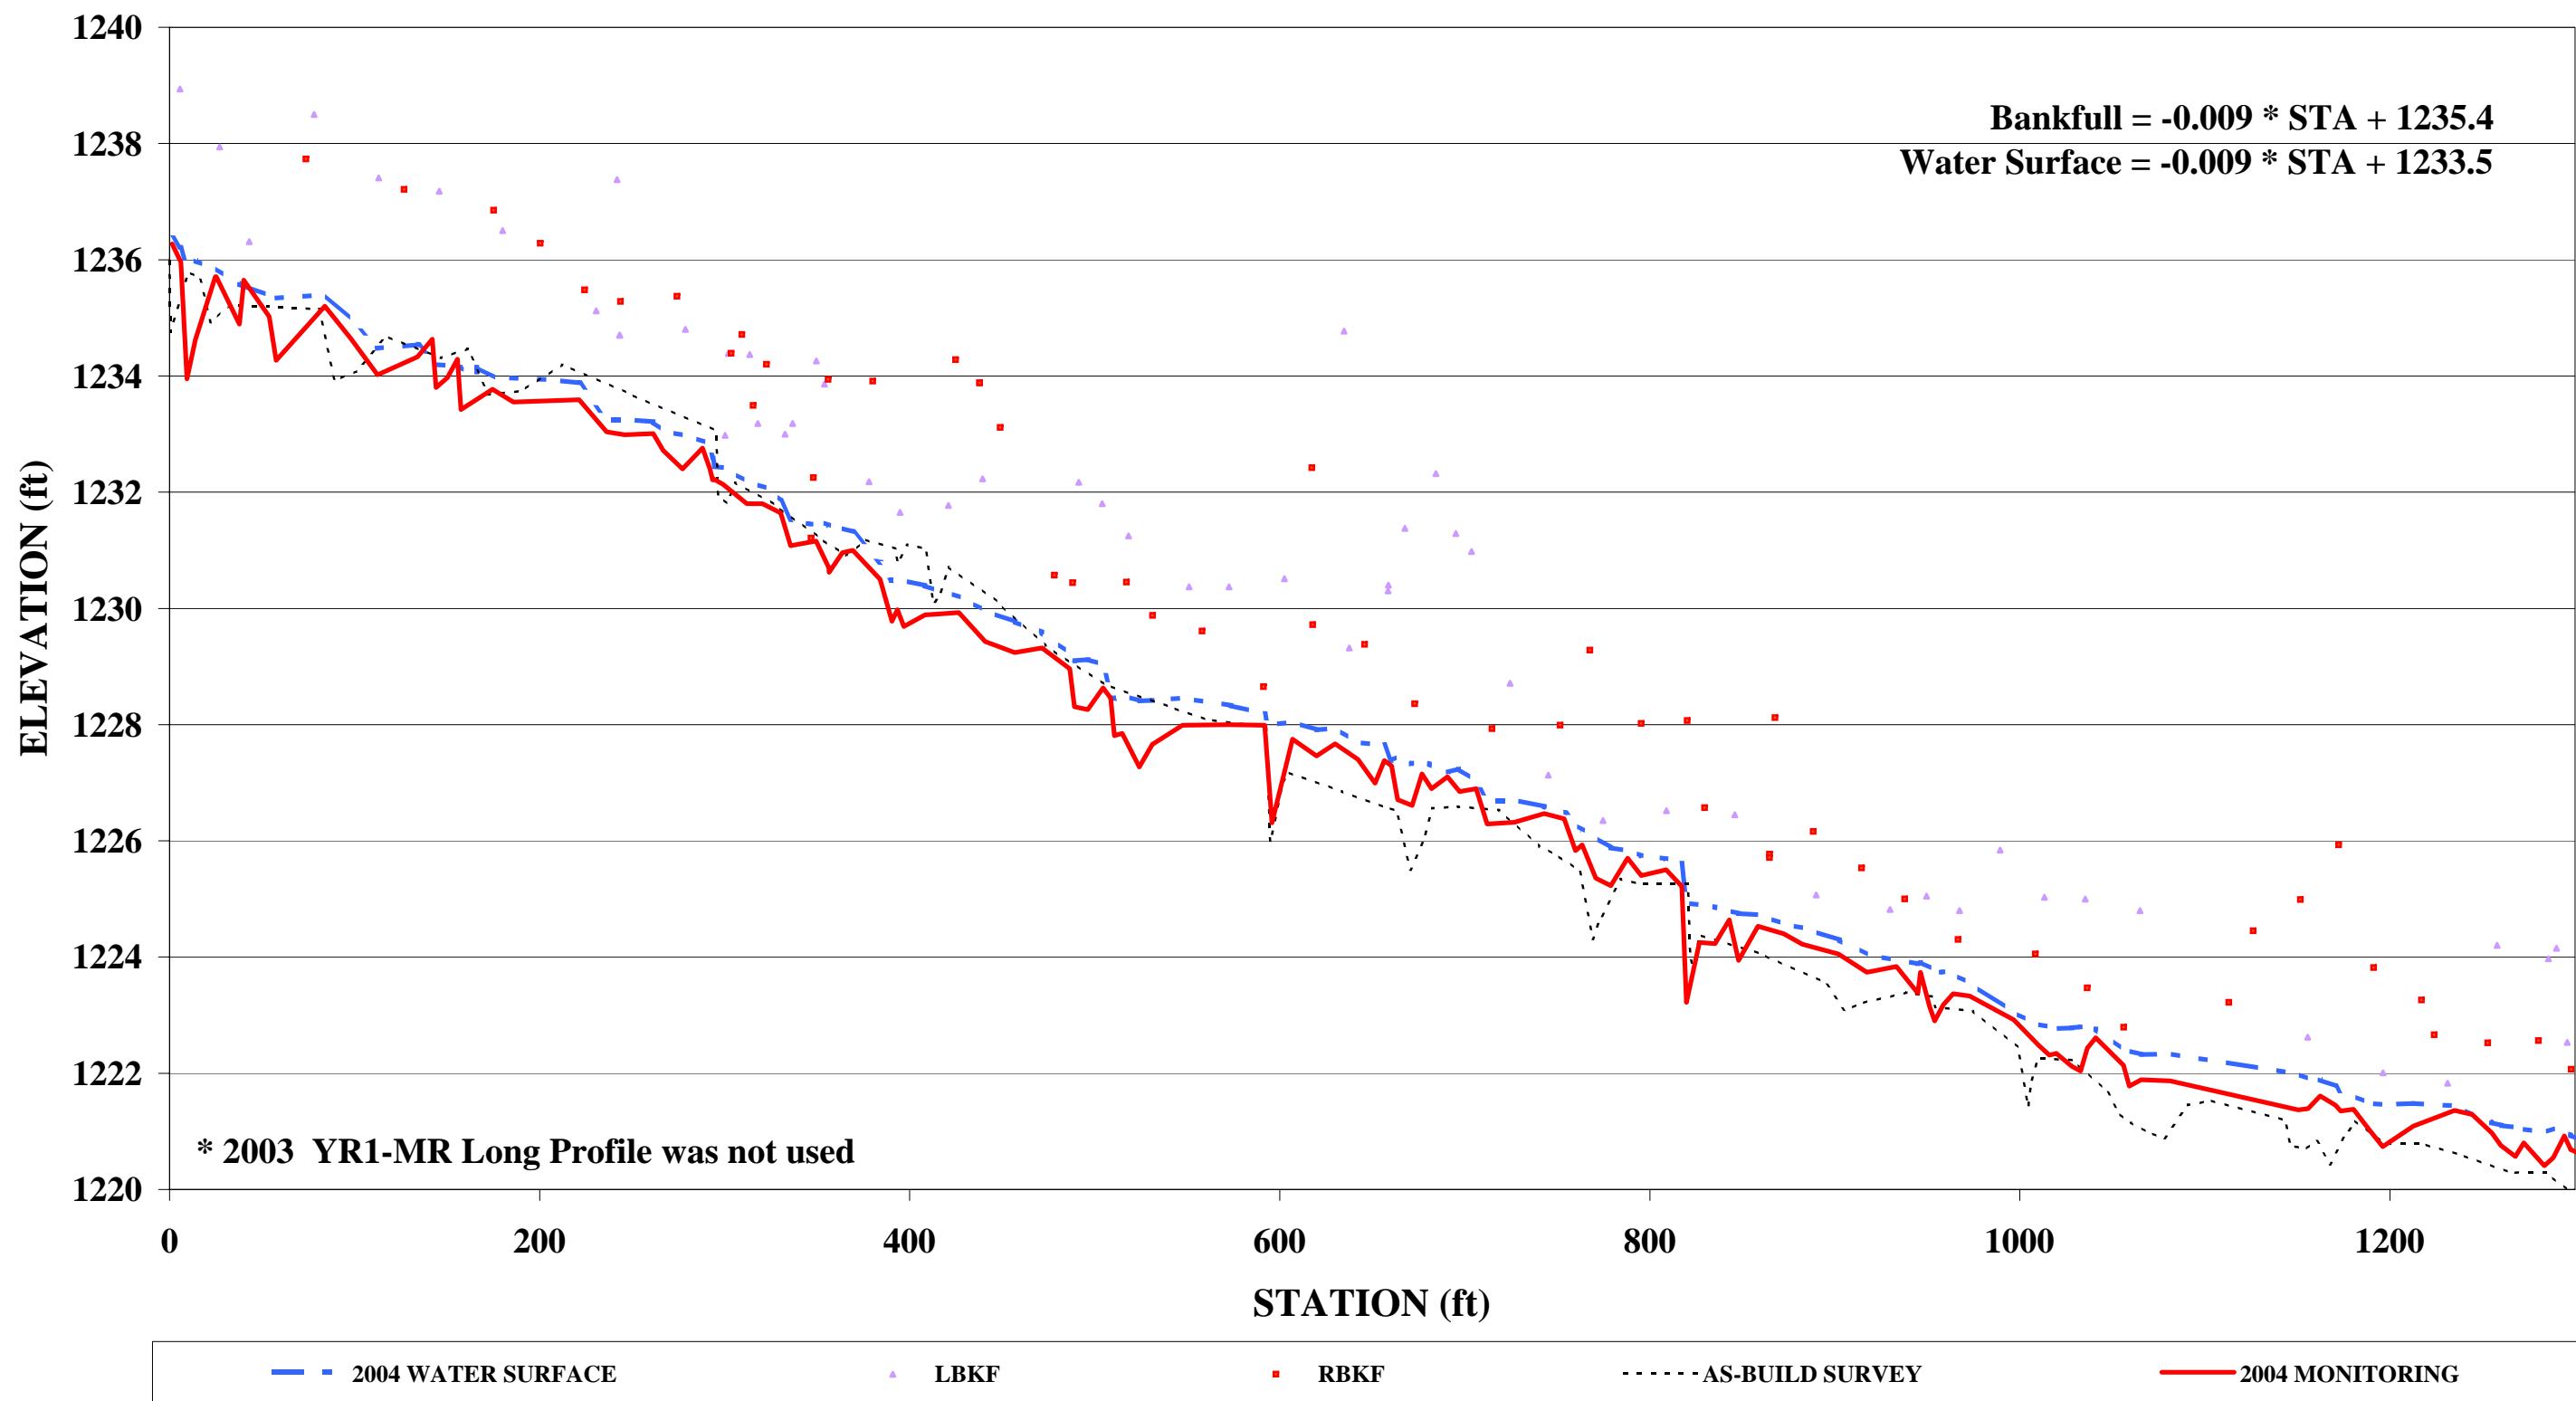


BROWN BRANCH  
LONG PROFILE  
2004 MONITORING

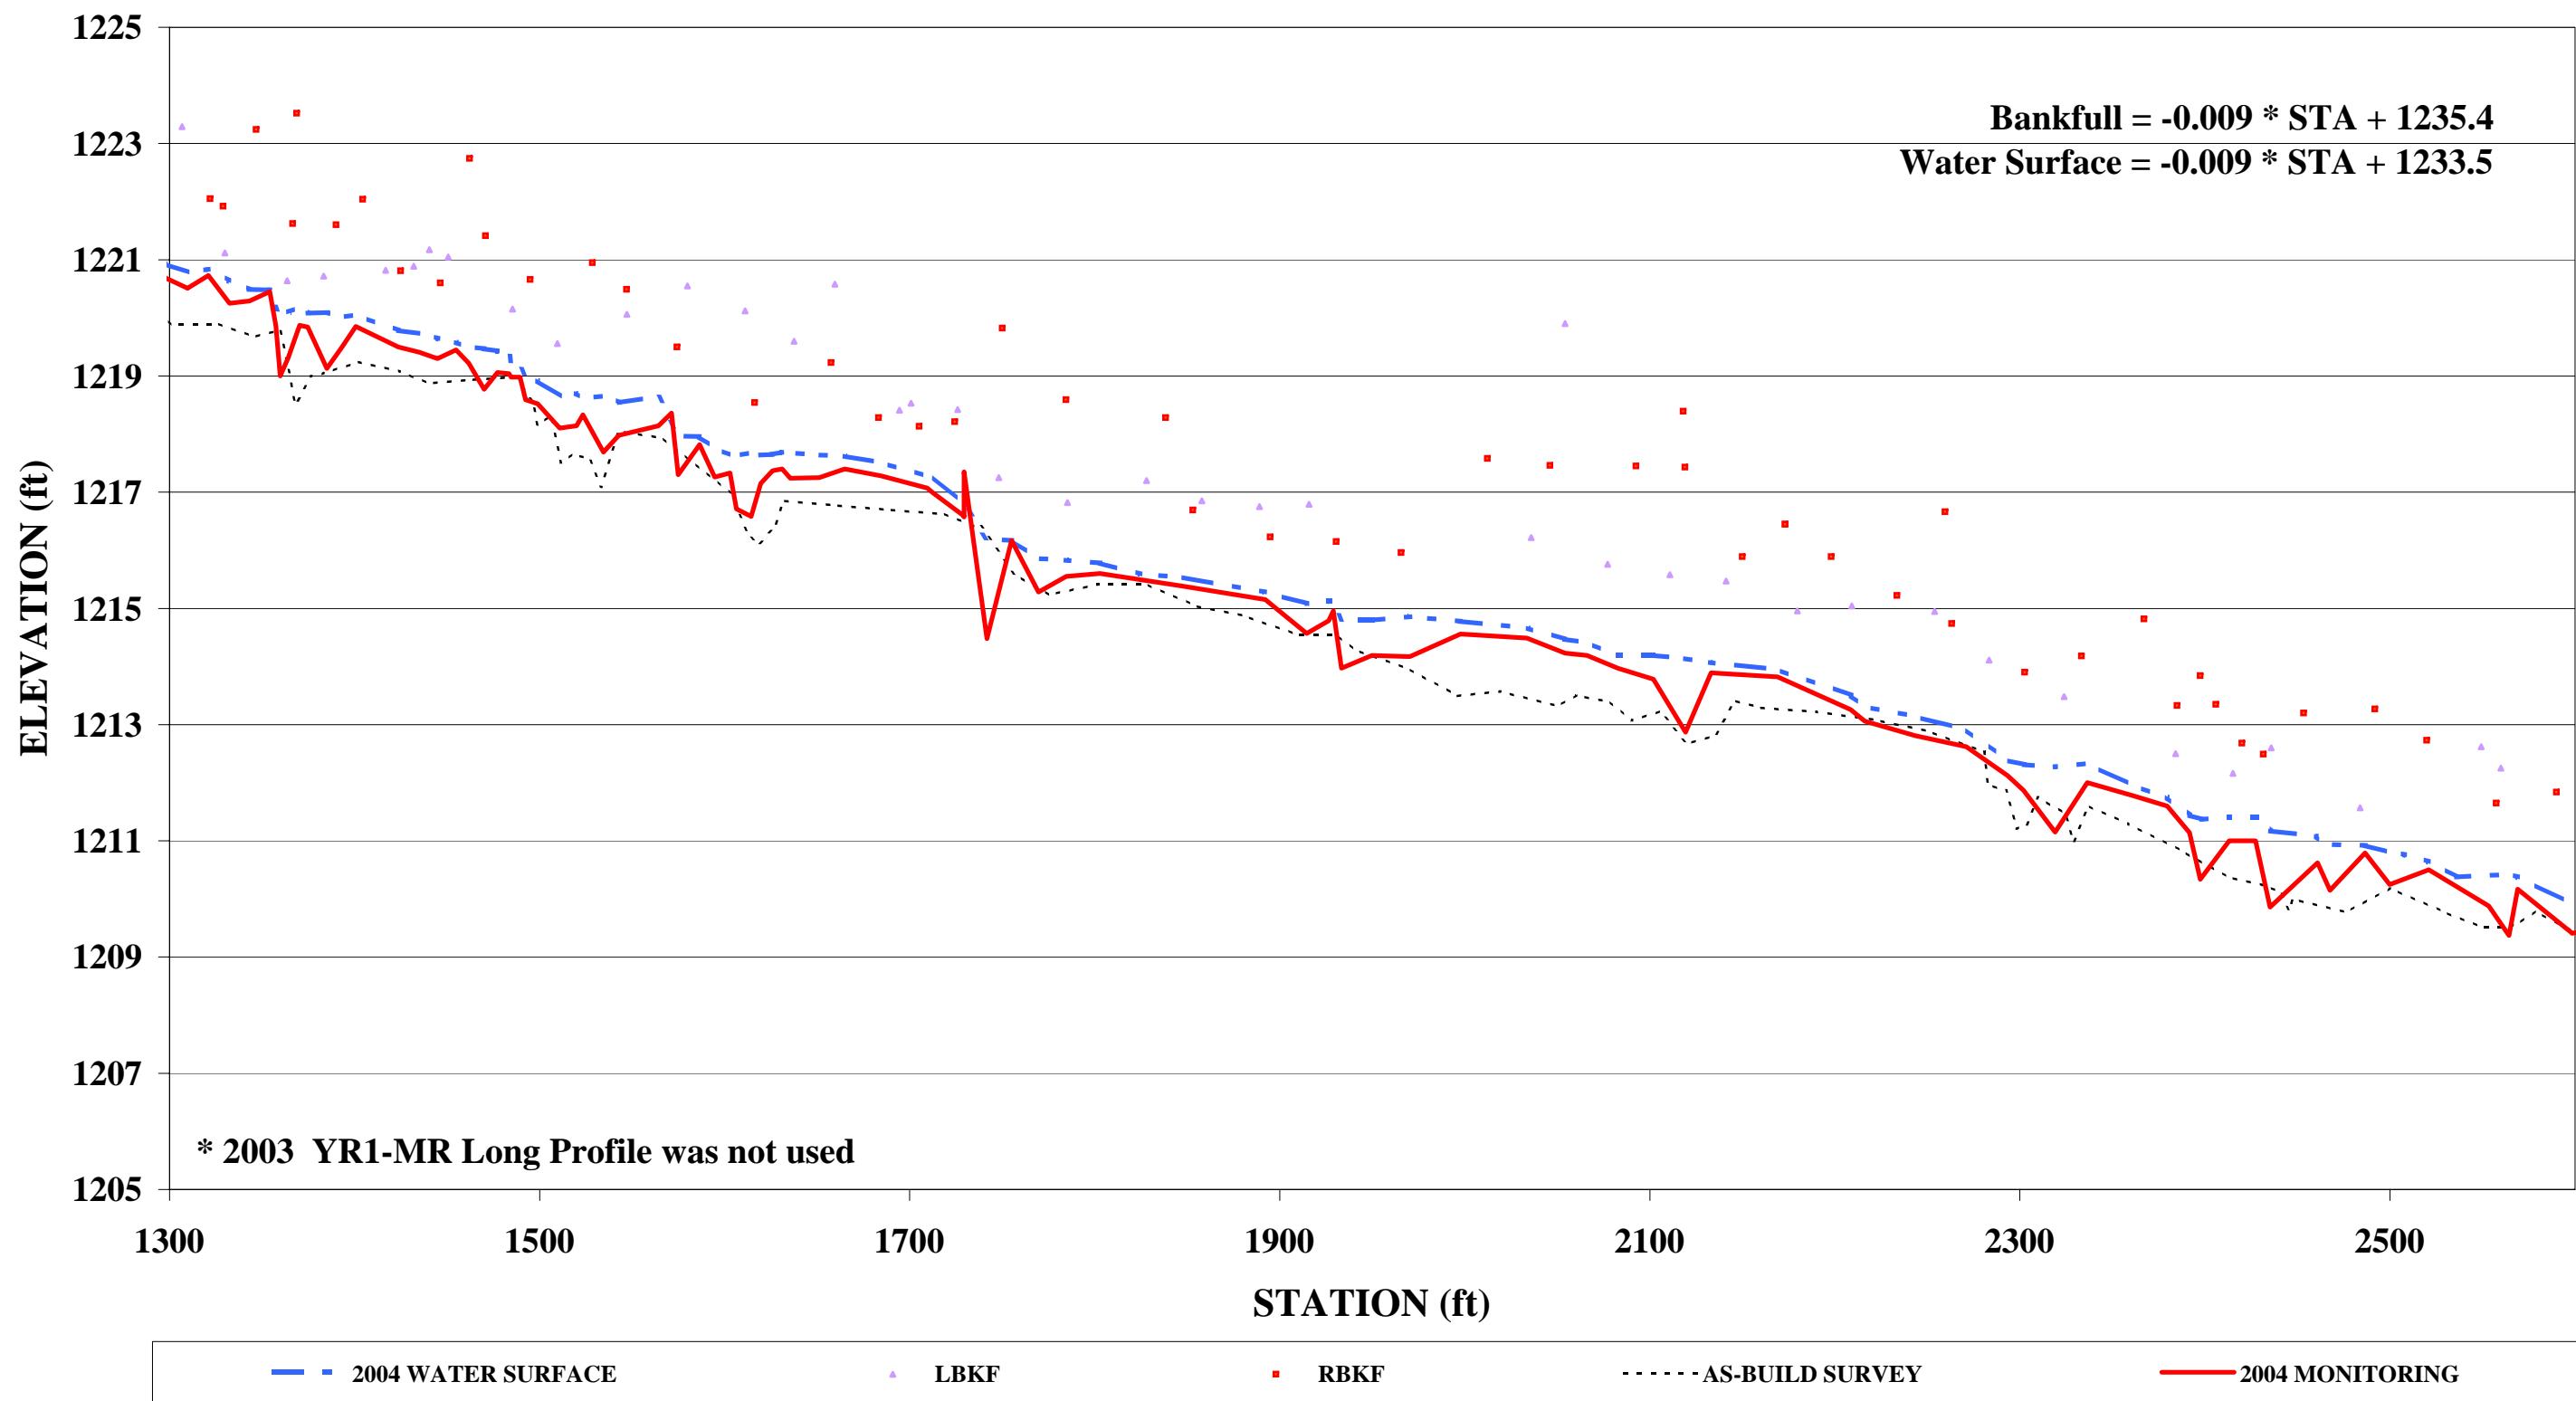

BROWN BRANCH  
LONG PROFILE  
2004 MONITORING

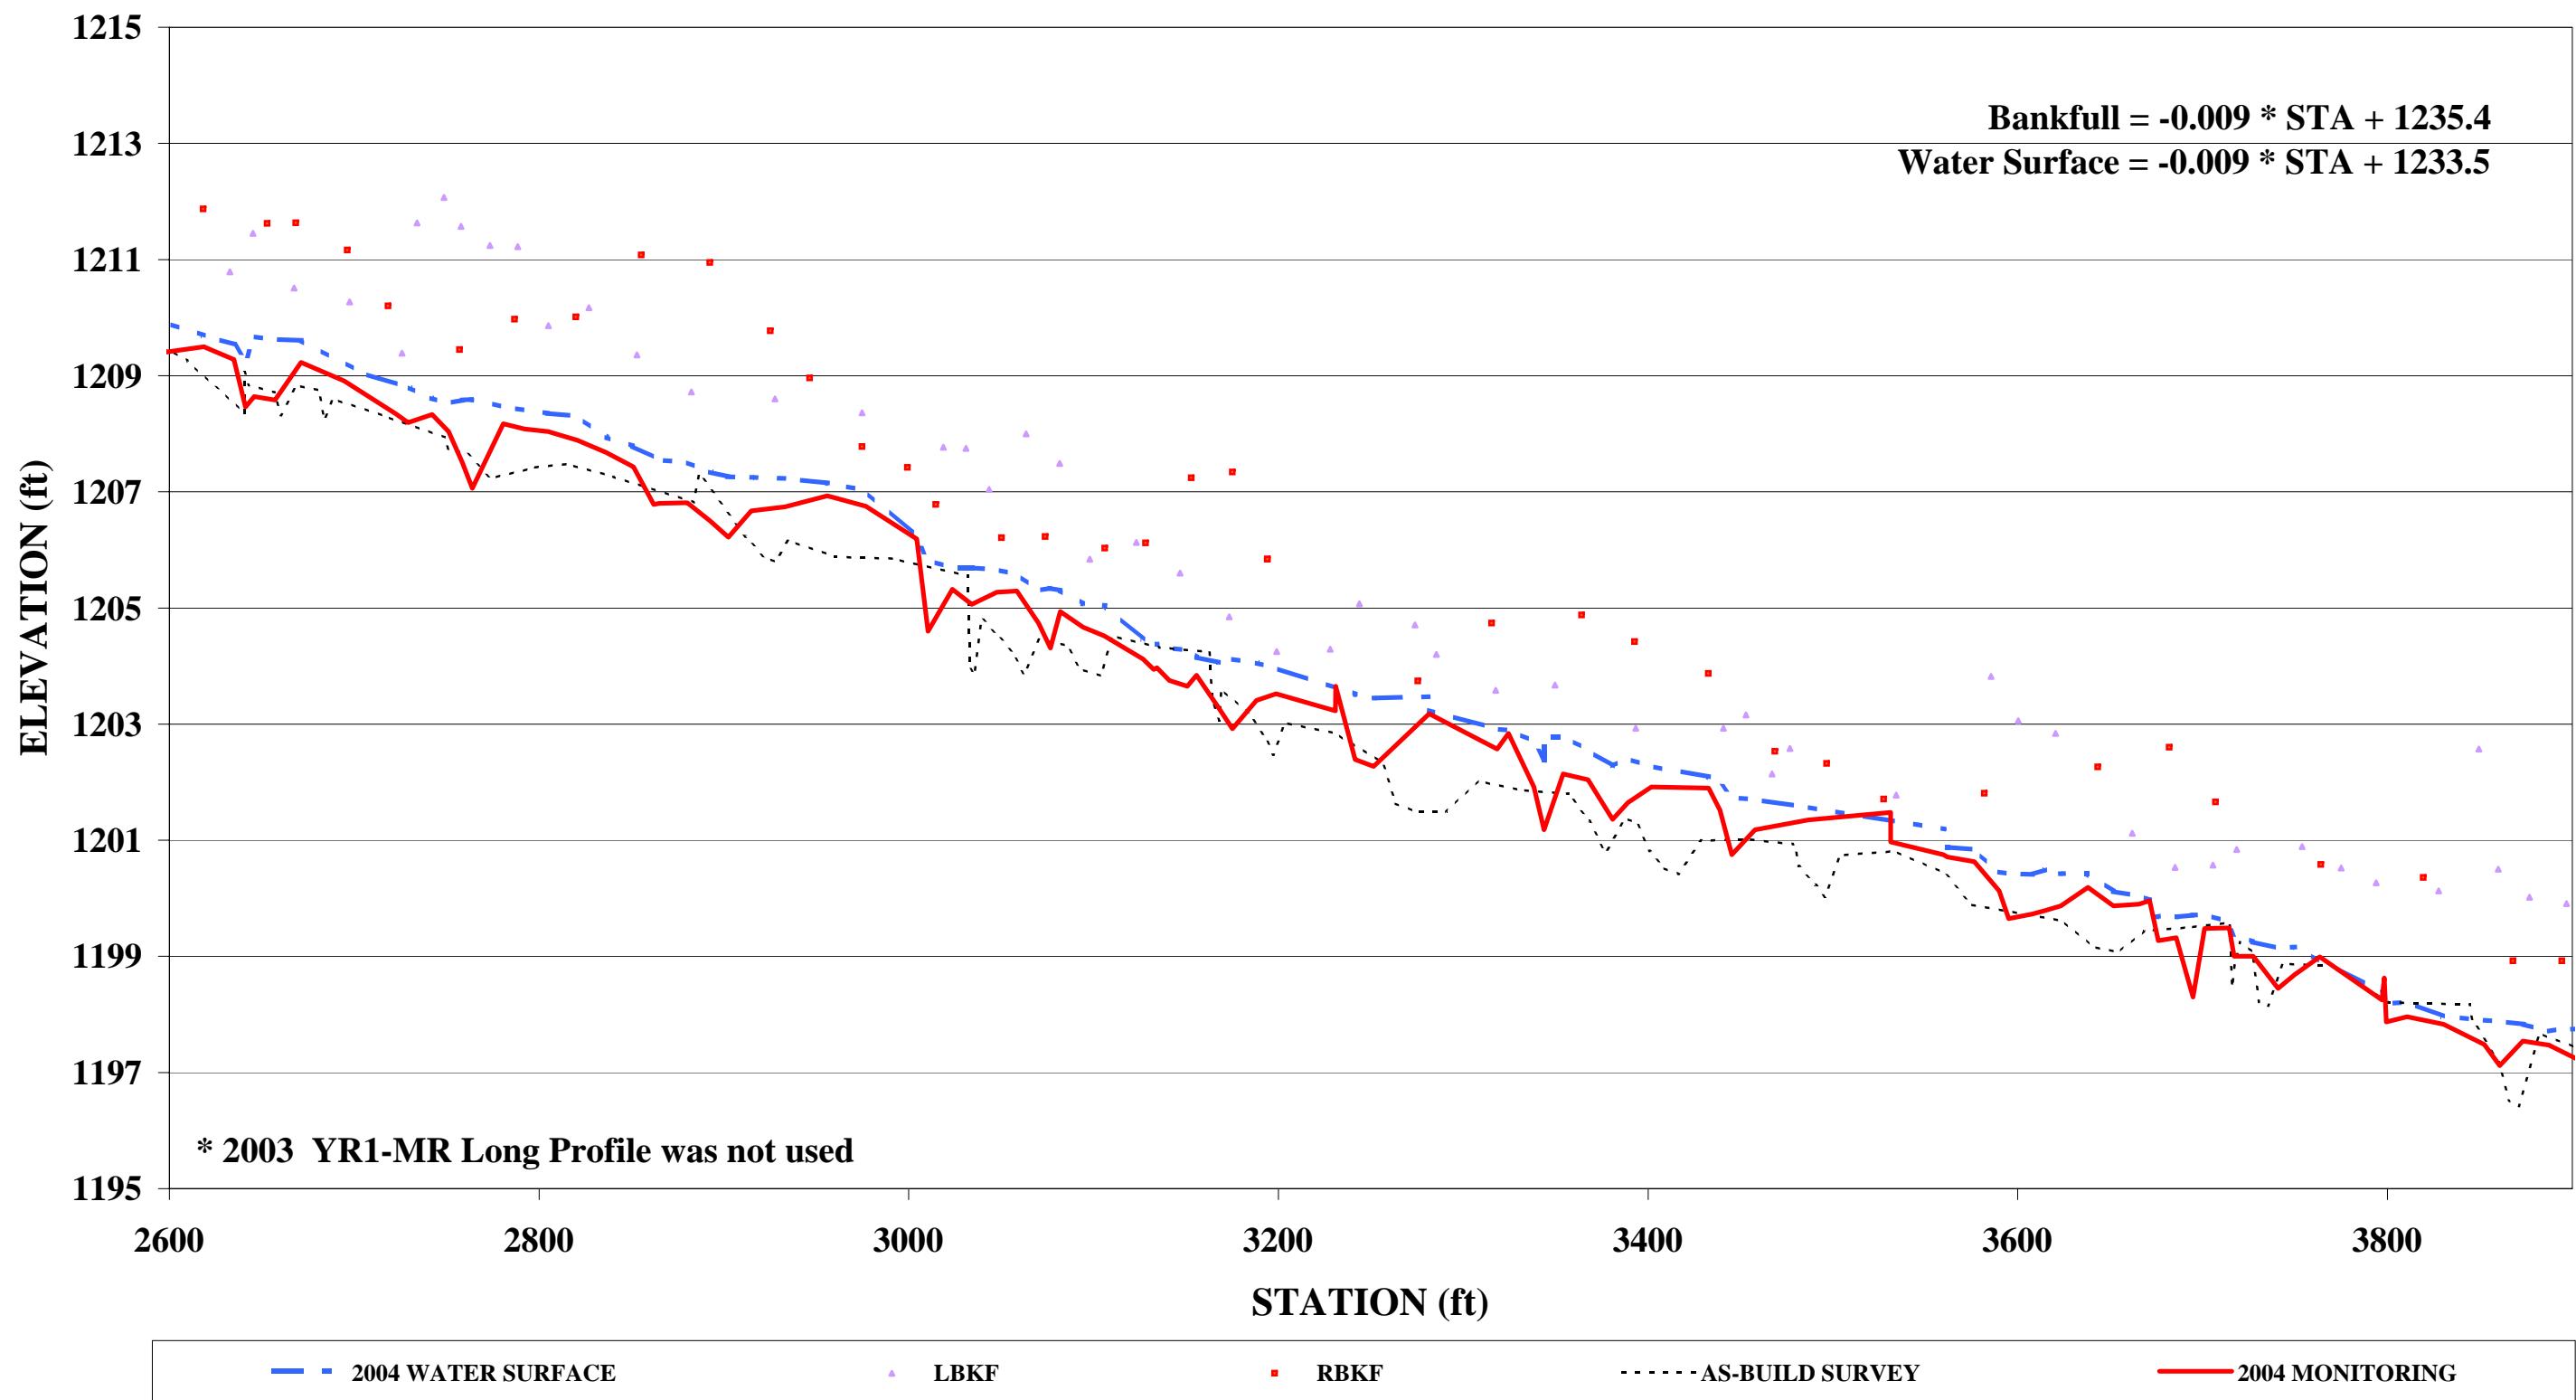

BROWN BRANCH  
LONG PROFILE  
2004 MONITORING

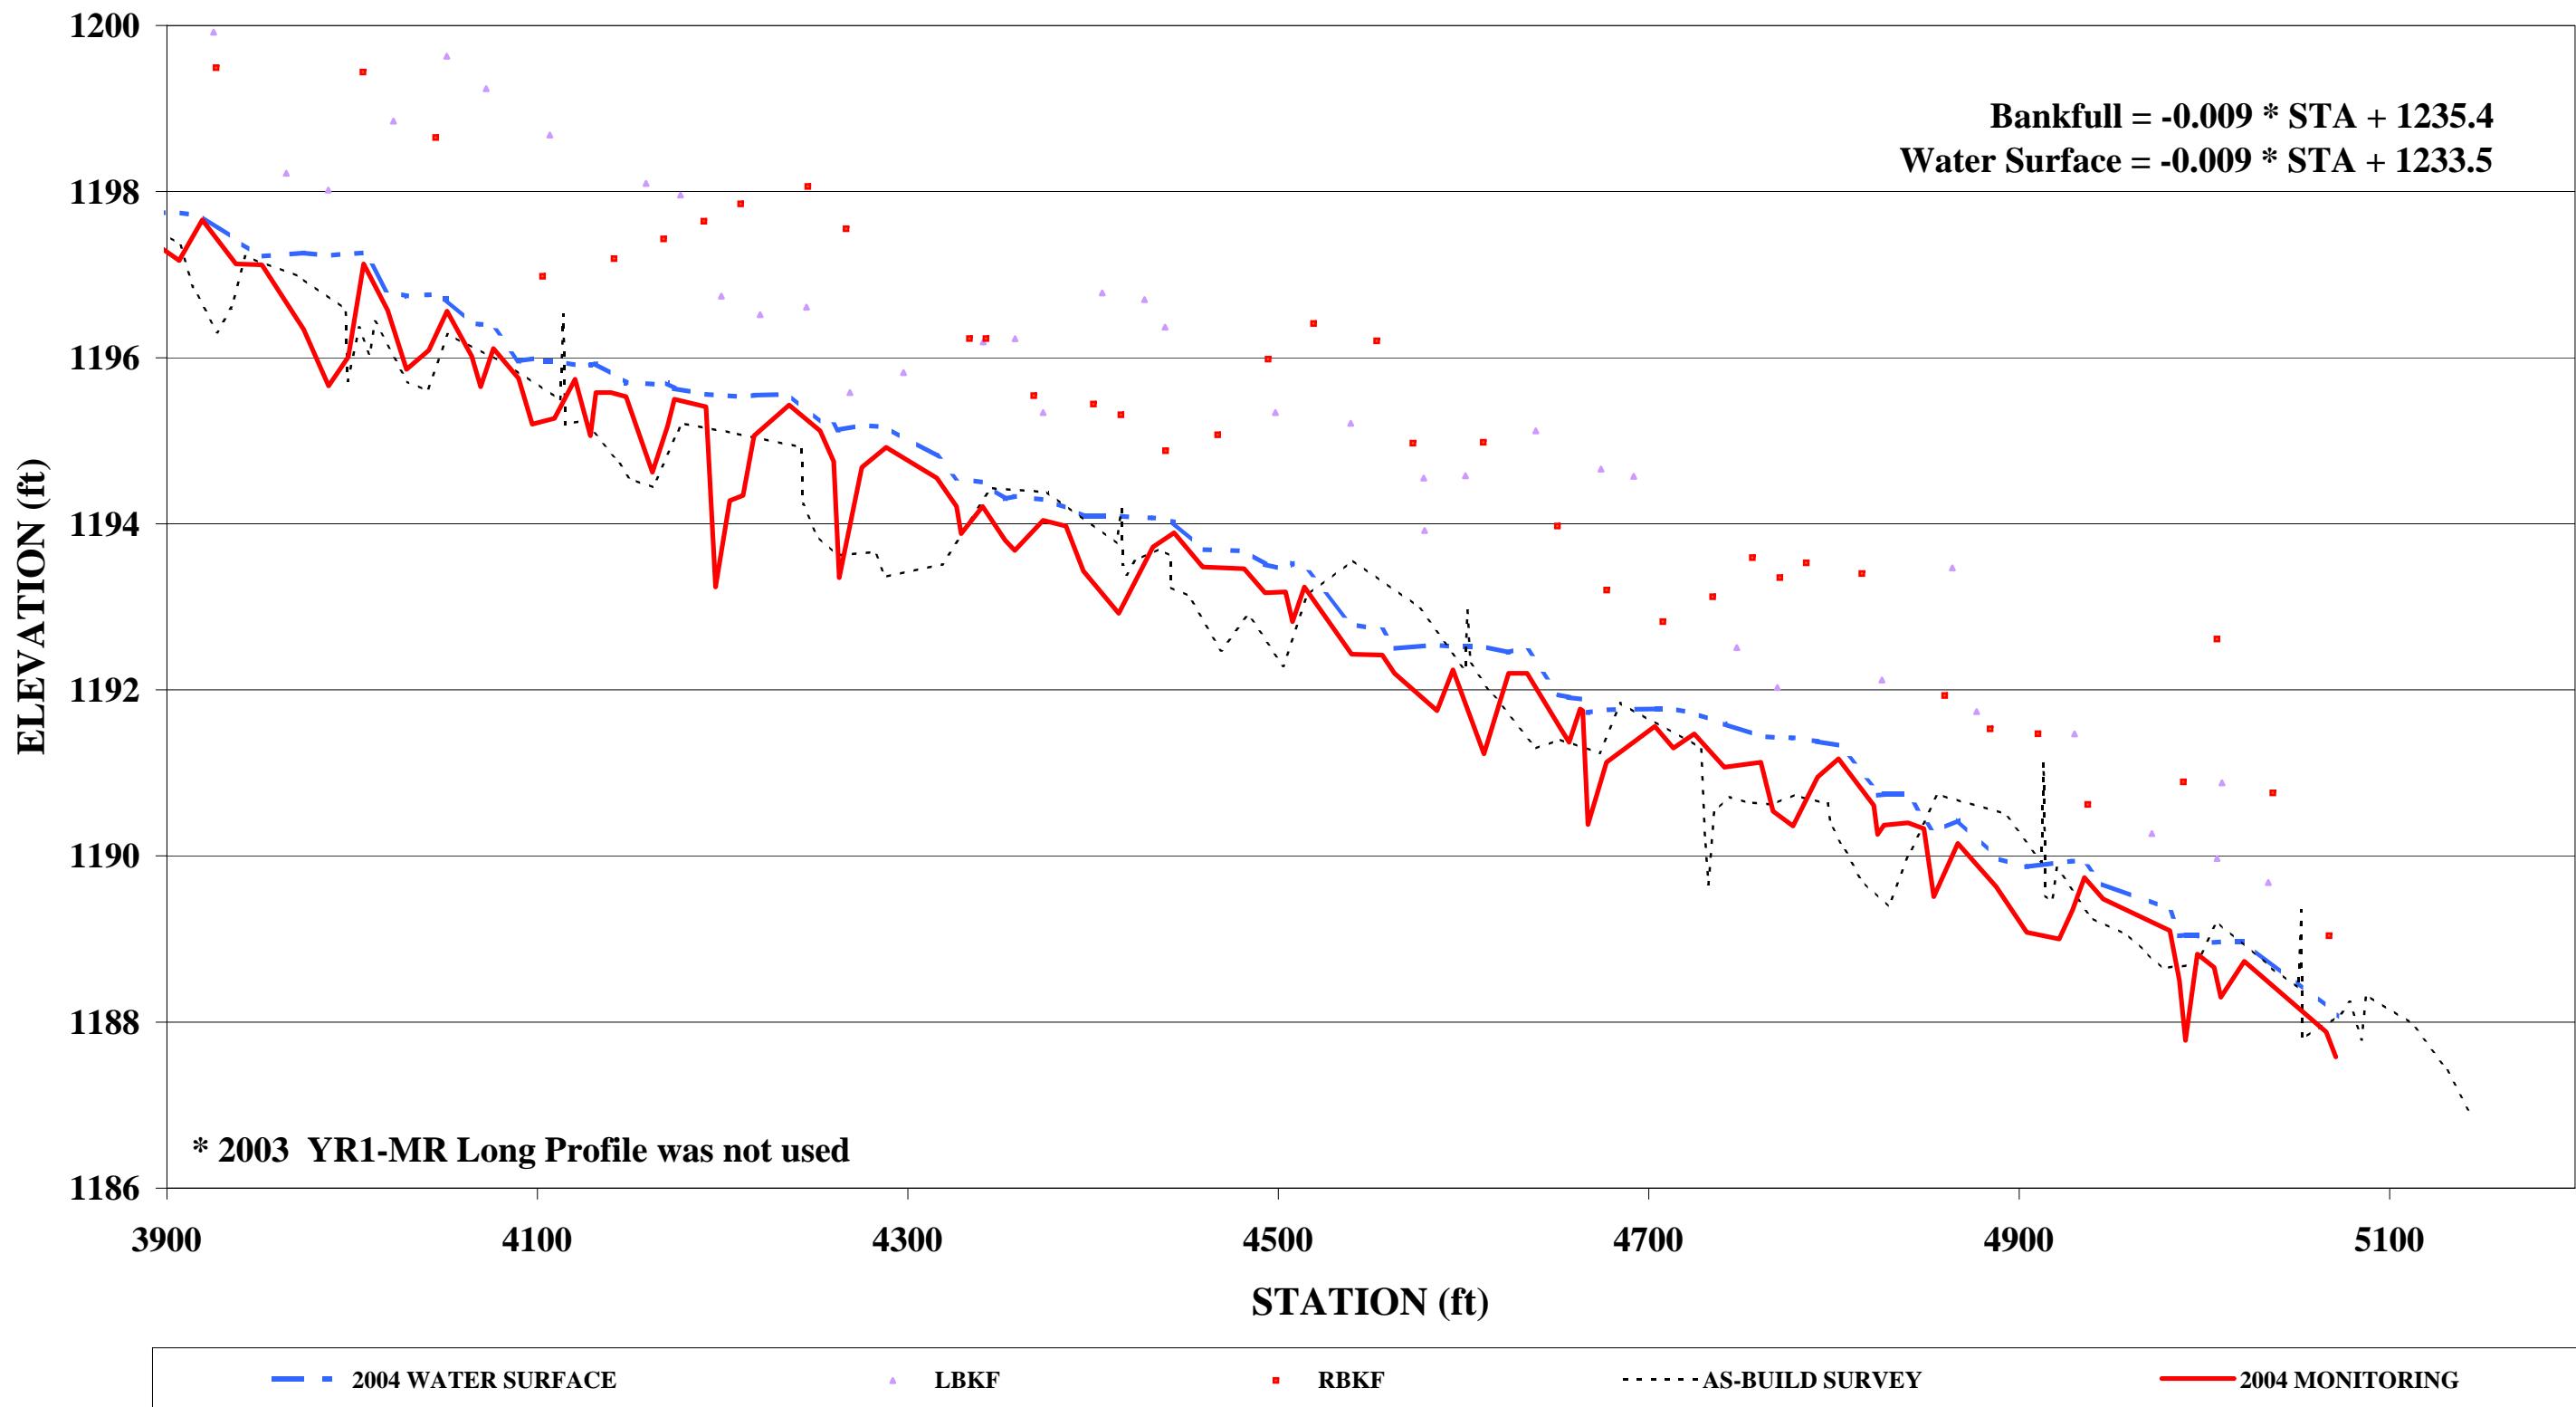

## **2.3 Areas of Concern**

The following areas of concern should be monitored closely and considered for repair as suggested:

### **Brown Branch**

- Areas with bank erosion
  - Bank erosion has been noted at fourteen locations on the restored reach of this stream
  - There are two areas of major bank erosion due to the in-channel shearing forces of stream at station 4+40 and station at 7+00
    - At station 4+20 to 4+60 there is a 40 ft long area of severe bank erosion on the right bank the bank has an extreme BEHI and is actively eroding. This erosion is captured by the surveyed cross-section #1 and is photo documented. The actively eroding bank height is 4.2 ft with a vertical non-protected bank.
    - At station 6+80 to 7+20 there is a 40 ft long area of severe bank erosion on the left bank the bank has an extreme BEHI and is actively eroding. The actively eroding bank height is 6.5 ft with a vertical non-protected bank.
  - The remainder of the bank erosion issues could be described as being caused by circulations behind a root wad or as occurring downstream on the outside of a meander bend
  - There are two areas of bank erosion due to overland seepage or flow at station 20+00 on the right bank and at station at 29+50 on the right bank
  - There are three areas with an active mid-channel bar at station 40+10, at station 43+25 and at station at 44+50
    - At station 40+20 to 40+50 there is a 30 ft long mid channel bar.
    - At station 43+10 to 43+60 there is a 50 ft long mid channel bar that. This mid-channel bar is captured by the surveyed cross-section #5 and is photo documented.
    - At station 44+45 to 40+50 there is a 5 ft long mid channel bar that
- Stream Profile
  - The stream is showing signs of down-cutting from station 0+00 to 9+00 the average slope for this reach is 1.4%
    - The this reach has down-cut in some areas as much as 6 inches but the reach is maintaining well defined riffles and riffle slopes that are close to the as-built riffle slopes.
  - From station 10+00 to 51+00 the average slope for this reach is 1.0% and pools are filling with sediment and loosing capacity
    - This reach has not significantly aggrated but the riffle are becoming shorter and generating steeper riffle slopes.
    - Pools are still generally located in the outside of the meander bends but the pool length and depth have decreased.
- Vegetation
  - Replanting trees should occur to obtain mitigation requirements

- The site could benefit from larger containerized trees both for bank stability and aesthetics, although mitigation requirements are currently being met.
- It is recommended to stake in areas where erosion is problematic, particularly on outside meander bends.



PS #1 Looking Downstream from STA 0+05



PS #2 Looking Downstream from STA 1+70



PS #3 Looking Downstream from STA 3+10



PS #4 Looking Downstream from STA 7+10



PS#5 Looking Downstream from STA 9+90



PS#6 Looking Downstream from STA 13+00



PS #7 Looking Downstream from STA 14+90



PS #8 Looking Downstream from STA 15+80



PS #9 Looking Downstream from STA 19+90



PS #10 Looking Downstream from STA 23+10



PS #11 Looking Downstream from STA 25+40



PS #12 Looking Downstream from STA 26+50



PS #13 Looking Downstream from STA 28+90



PS #14 Looking Downstream from STA 30+40



PS #15 Looking Downstream from STA 33+25



PS #16 Looking Downstream from STA 36+65



PS #17 Looking Downstream from STA 38+50



PS #18 Looking Downstream from STA 41+00



PS #19 Looking Downstream from STA 42+50



PS #20 Looking Downstream from STA 45+80



PS #21 Looking Downstream from STA 47+50



PS #22 Looking Downstream from STA 49+40



PS#1 Looking Downstream from STA 0+05



~Station 2




PS#2 Looking Downstream from STA 1+70



~ Station 3




PS#3 Looking Downstream from STA 3+10

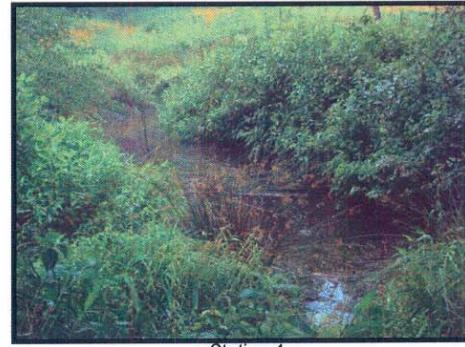

~ Station 4



PS#4 Looking Downstream from STA 7+10

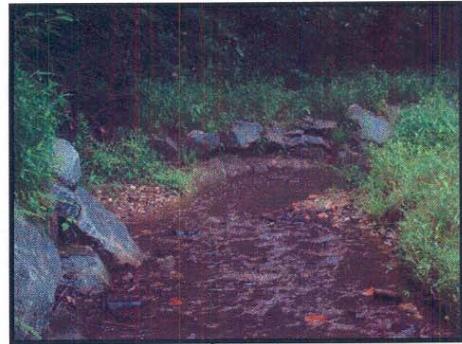

~ Station 5



PS#5 Looking Downstream from STA 9+90



~ Station 6



PS#6 Looking Downstream from STA 13+00



~ Station 7



PS#7 Looking Downstream from STA 14+90



PS#8 Looking Downstream from STA 15+80



~ Station 9



PS#9 Looking Downstream from STA 19+90



PS#10 Looking Downstream from STA 23+10



~ Station 11




PS#11 Looking Downstream from STA 25+40



~ Station 12




PS#12 Looking Downstream from STA 26+50

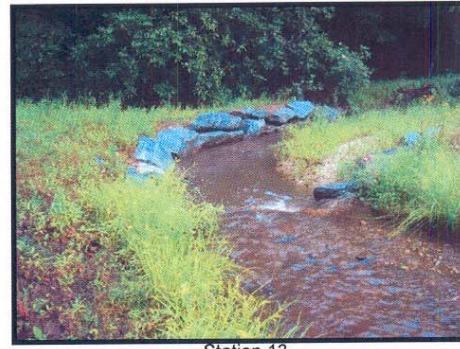

~ Station 13



PS #13 Looking Downstream from STA 28+90

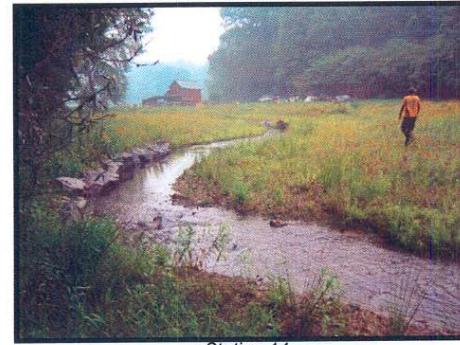


~ Station 14



PS #14 Looking Downstream from STA 30+40



~ Station 15

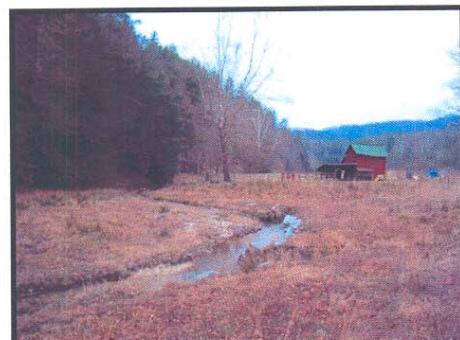

PS #15 Looking Downstream from STA 33+25



PS #16 Looking Downstream from STA 36+65



~ Station 17



PS #17 Looking Downstream from STA 38+50



~ Station 18



PS #18 Looking Downstream from STA 41+00



~ Station 19



PS #19 Looking Downstream from STA 42+50



~ Station 20



PS #20 Looking Downstream from STA 45+80



- Station 21



PS #21 Looking Downstream from STA 47+50




- Station 22



PS #22 Looking Downstream from STA 49+40

**Photographs from Monumented Locations**  
**Brown Branch Stream Restoration 2003**  
*Stationing starts downstream and ascending upstream*

---

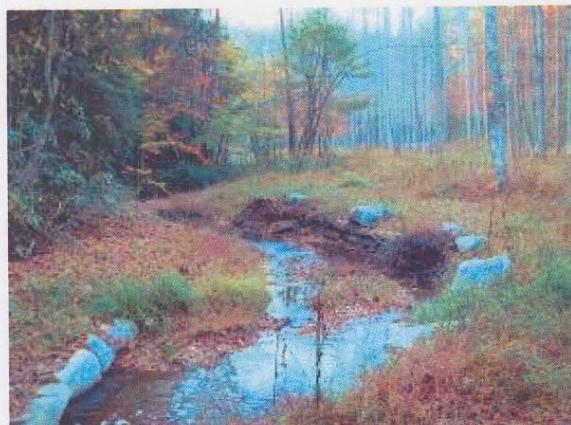

**Photo Station #1.** Looking downstream from as-built Station ~51+00.



**Photo Station #2.** Looking downstream from as-built Station ~49+30.



**Photo Station #3.** Looking downstream from as-built Station ~47+90.



**Photo Station #4.** Looking downstream from as-built Station ~44+00. Oxbow wetland in foreground.



**Photo Station #5.** Looking downstream at channel plug protection from as-built Station ~41+25.




**Photo Station #6.** Looking downstream from as-built Station ~38+00.

**Photographs from Monumented Locations**  
**Brown Branch Stream Restoration 2003**  
*Stationing starts downstream and ascending upstream*

---



**Photo Station #7.** Looking downstream from as-built Station ~36+10.

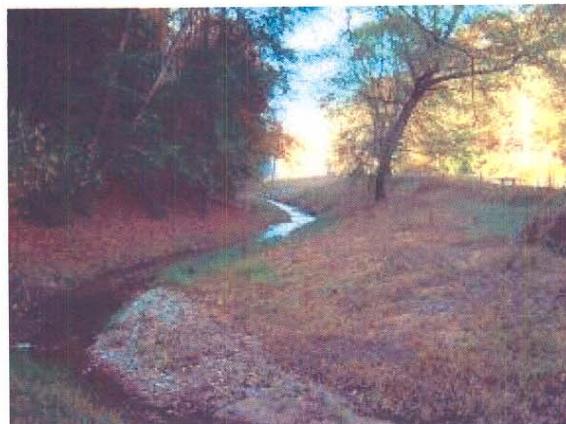

**Photo Station #8.** Looking downstream from as-built Station ~35+15.



**Photo Station #9.** Looking downstream from as-built Station ~31+10 near gravel roadway.



**Photo Station #10.** Looking downstream from as-built Station ~28+25.



**Photo Station #11.** Looking downstream from as-built Station ~25+85.




**Photo Station #12.** Looking downstream from as-built Station ~24+50.

**Photographs from Monumented Locations**  
**Brown Branch Stream Restoration 2003**  
*Stationing starts downstream and ascending upstream*

---



**Photo Station #13.** Looking downstream from as-built Station ~22+20.

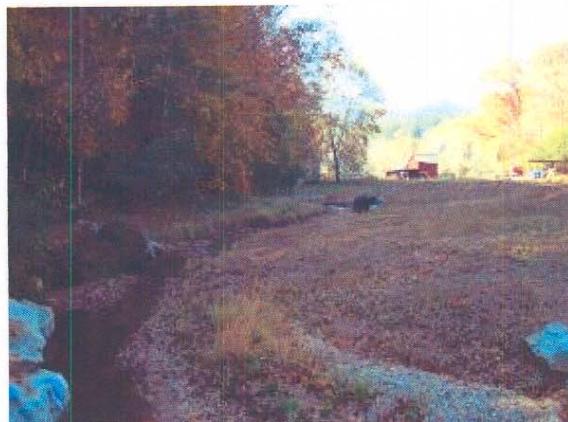


**Photo Station #14.** Looking downstream from as-built Station ~20+70. Small tributary confluence to left.




**Photo Station #15.** Looking downstream from as-built Station ~17+75.



**Photo Station #16.** Looking downstream from as-built Station ~14+25.

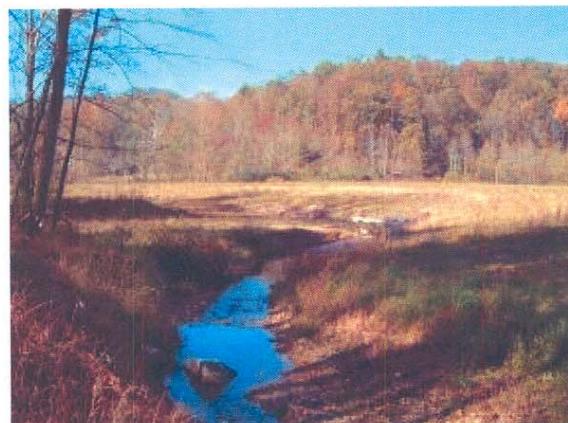

**Photo Station #17.** Looking downstream from as-built Station ~12+50. Tributary confluence to left. Rock has rolled from bank into channel from left.

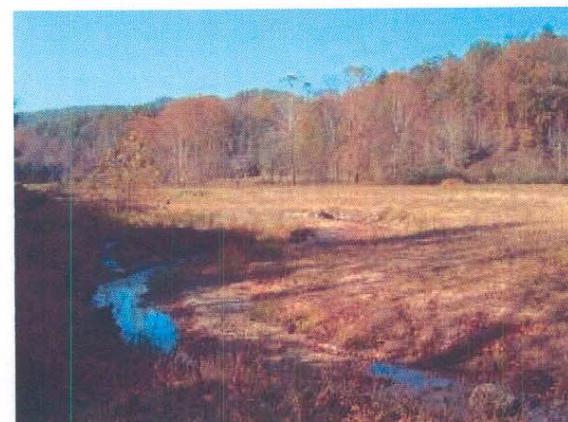

**Photo Station #18.** Looking downstream from as-built Station ~10+05.

**Photographs from Monumented Locations**  
**Brown Branch Stream Restoration 2003**  
*Stationing starts downstream and ascending upstream*

---



**Photo Station #19.** Looking downstream from as-built Station ~8+30.



**Photo Station #20.** Looking downstream from as-built Station ~5+05.



**Photo Station #21.** Looking downstream from as-built Station ~3+25.



**Photo Station #22.** Looking downstream from as-built Station 1+60.


|               |                                  |
|---------------|----------------------------------|
| Project Name  | Anita Alta 4-H Camp Brown Branch |
| Cross Section | #1                               |
| Feature       | Riffle                           |
| Date          | 6/14/04                          |
| Crew          | Bidelspach, Clinton              |



| Station | 2004 Survey |           |         | 2003 Survey |          |         | AS-BUILT Survey |           |  |
|---------|-------------|-----------|---------|-------------|----------|---------|-----------------|-----------|--|
|         | Elevation   | Notes     | Station | Elevation   | Notes    | Station | Elevation       | Notes     |  |
| 0.0     | 1233.73     | Left Pin  | 0.0     | 1233.69     | Left Pin | 0.0     | 1233.69         | Left Pin  |  |
| 0.3     | 1233.26     |           | 0.0     | 1233.19     |          | 0.0     | 1233.18         |           |  |
| 7.4     | 1232.78     |           | 2.5     | 1233.04     |          | 2.8     | 1233.09         |           |  |
| 15.5    | 1231.95     | BKF       | 5.5     | 1232.82     |          | 5.8     | 1232.92         |           |  |
| 17.7    | 1230.69     |           | 8.5     | 1232.58     |          | 8.8     | 1232.62         |           |  |
| 21.7    | 1230.22     |           | 11.5    | 1232.36     |          | 11.8    | 1232.37         |           |  |
| 23.5    | 1229.99     |           | 13.5    | 1232.17     |          | 14.8    | 1232.10         | BKF       |  |
| 25.3    | 1229.90     |           | 14.5    | 1232.09     | BKF      | 17.1    | 1231.33         |           |  |
| 27.0    | 1229.92     |           | 15.9    | 1231.74     |          | 18.5    | 1230.83         |           |  |
| 27.7    | 1229.98     |           | 16.0    | 1231.11     |          | 21.3    | 1230.65         |           |  |
| 28.1    | 1230.31     |           | 17.2    | 1230.60     |          | 23.4    | 1230.28         |           |  |
| 30.1    | 1230.92     |           | 20.5    | 1230.31     |          | 25.3    | 1230.54         |           |  |
| 30.7    | 1232.00     |           | 23.5    | 1230.02     |          | 25.6    | 1230.84         |           |  |
| 32.1    | 1234.18     |           | 25.6    | 1229.77     |          | 27.0    | 1232.10         |           |  |
| 40.6    | 1234.51     |           | 27.9    | 1230.04     |          | 27.9    | 1232.77         |           |  |
| 51.6    | 1234.51     |           | 29.7    | 1230.60     |          | 31.7    | 1234.15         |           |  |
| 51.6    | 1234.9      | Right Pin | 30.0    | 1232.00     |          | 34.8    | 1234.50         |           |  |
|         |             |           | 31.3    | 1234.12     |          | 37.8    | 1234.57         |           |  |
|         |             |           | 34.3    | 1234.41     |          | 40.8    | 1234.40         |           |  |
|         |             |           | 37.5    | 1234.60     |          | 43.8    | 1234.43         |           |  |
|         |             |           | 40.45   | 1234.45     |          | 46.75   | 1234.83         |           |  |
|         |             |           | 43.45   | 1234.46     |          | 49.75   | 1234.63         |           |  |
|         |             |           | 46.45   | 1234.77     |          | 51.3    | 1234.68         |           |  |
|         |             |           | 49.45   | 1234.58     |          | 51.3    | 1234.91         | Right Pin |  |

Photo of Cross-Section #1 - Looking Downstream @ STA 3+32


|            | 2004 | 2003 | AS-BUILT |
|------------|------|------|----------|
| Area       | 19.8 | 22.7 | 11.4     |
| Width      | 15.2 | 14.1 | 10.0     |
| Mean Depth | 1.3  | 1.6  | 1.1      |
| Max Depth  | 2.1  | 2.3  | 1.8      |
| W/D        | 11.6 | 8.8  | 8.7      |

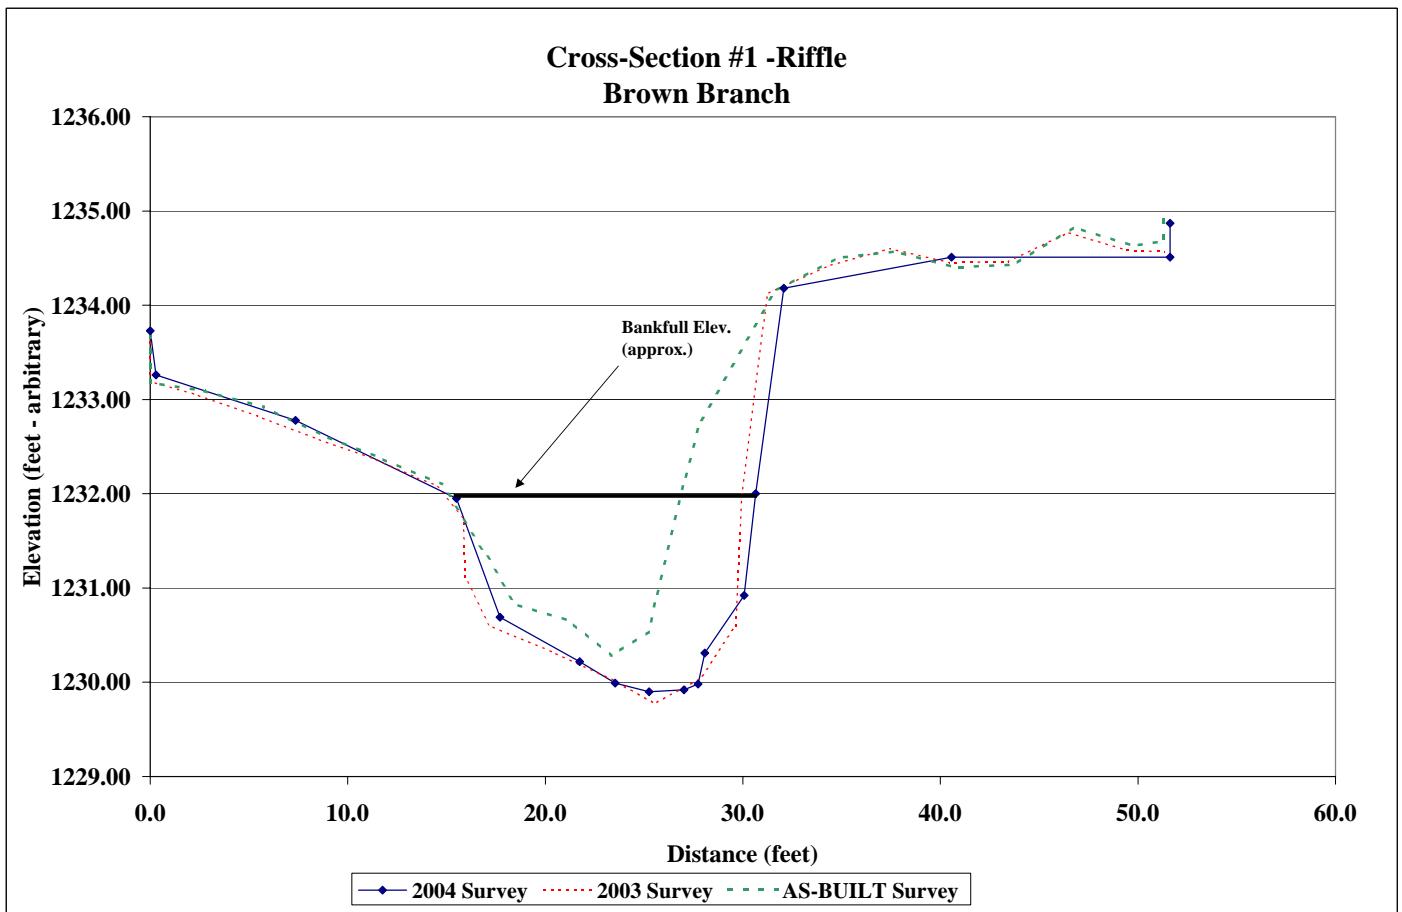

|               |                     |
|---------------|---------------------|
| Project Name  | Brown Branch        |
| Cross Section | #1                  |
| Feature       | Riffle              |
| Date          | 6/3/04              |
| Crew          | Bidelsbach, Clinton |

| Description                     | Material           | Size (mm) | As-Built     |        | 2004   |              |               |        |
|---------------------------------|--------------------|-----------|--------------|--------|--------|--------------|---------------|--------|
|                                 |                    |           | Riffle - Bed | %      | Cum %  | Riffle - Bed | Riffle - Bank | %      |
| Sand                            | Silt/Clay          | 0.061     | 2            | 1.9%   | 1.9%   | 1            | 11            | 11.9%  |
|                                 | very fine sand     | 0.062     | 2            | 1.9%   | 3.7%   | 0            | 2             | 2.0%   |
|                                 | fine sand          | 0.125     | 4            | 3.7%   | 7.5%   | 0            | 6             | 5.9%   |
|                                 | medium sand        | 0.25      | 4            | 3.7%   | 11.2%  | 1            | 2             | 3.0%   |
|                                 | course sand        | 0.50      | 4            | 3.7%   | 15.0%  | 0            | 5             | 5.0%   |
|                                 | very coarse sand   | 1.0       | 4            | 3.7%   | 18.7%  | 3            | 3             | 5.9%   |
| Gravel                          | very fine gravel   | 2.0       | 1            | 0.9%   | 19.6%  | 0            | 0             | 0.0%   |
|                                 | fine gravel        | 4.0       | 2            | 1.9%   | 21.5%  | 2            | 1             | 3.0%   |
|                                 | medium gravel      | 5.7       | 2            | 1.9%   | 23.4%  | 1            | 0             | 1.0%   |
|                                 | medium gravel      | 8.0       | 6            | 5.6%   | 29.0%  | 3            | 3             | 5.9%   |
|                                 | medium gravel      | 11.3      | 4            | 3.7%   | 32.7%  | 3            | 2             | 5.0%   |
|                                 | course gravel      | 16.0      | 15           | 14.0%  | 46.7%  | 3            | 7             | 9.9%   |
|                                 | course gravel      | 22.6      | 16           | 15.0%  | 61.7%  | 3            | 7             | 9.9%   |
|                                 | very coarse gravel | 32        | 14           | 13.1%  | 74.8%  | 4            | 6             | 9.9%   |
|                                 | very coarse gravel | 45        | 14           | 13.1%  | 87.9%  | 3            | 6             | 8.9%   |
|                                 | very coarse gravel | 64        | 1            | 0.9%   | 88.8%  | 2            | 4             | 5.9%   |
| Cobble                          | small cobble       | 90        | 6            | 5.6%   | 94.4%  | 1            | 3             | 4.0%   |
|                                 | medium cobble      | 128       | 4            | 3.7%   | 98.1%  | 1            | 1             | 2.0%   |
|                                 | large cobble       | 180       | 2            | 1.9%   | 100.0% | 0            | 1             | 1.0%   |
| Boulder                         | small boulder      | 256       | 0            | 0.0%   | 100.0% | 0            | 0             | 0.0%   |
|                                 | small boulder      | 362       | 0            | 0.0%   | 100.0% | 0            | 0             | 0.0%   |
|                                 | medium boulder     | 512       | 0            | 0.0%   | 100.0% | 0            | 0             | 0.0%   |
|                                 | large boulder      | 1024      | 0            | 0.0%   | 100.0% | 0            | 0             | 0.0%   |
|                                 | very large boulder | 2049      | 0            | 0.0%   | 100.0% | 0            | 0             | 0.0%   |
| Bedrock                         | bedrock            | 40096     | 0            | 0.0%   | 100.0% | 0            | 0             | 0.0%   |
| <b>TOTAL / % of whole count</b> |                    |           | 107          | 100.0% |        | 31           | 70            | 100.0% |

|      | d16  | d35  | d50   | d85   | d95   |
|------|------|------|-------|-------|-------|
| 2004 | 0.13 | 3.83 | 14.50 | 48.88 | 92.60 |

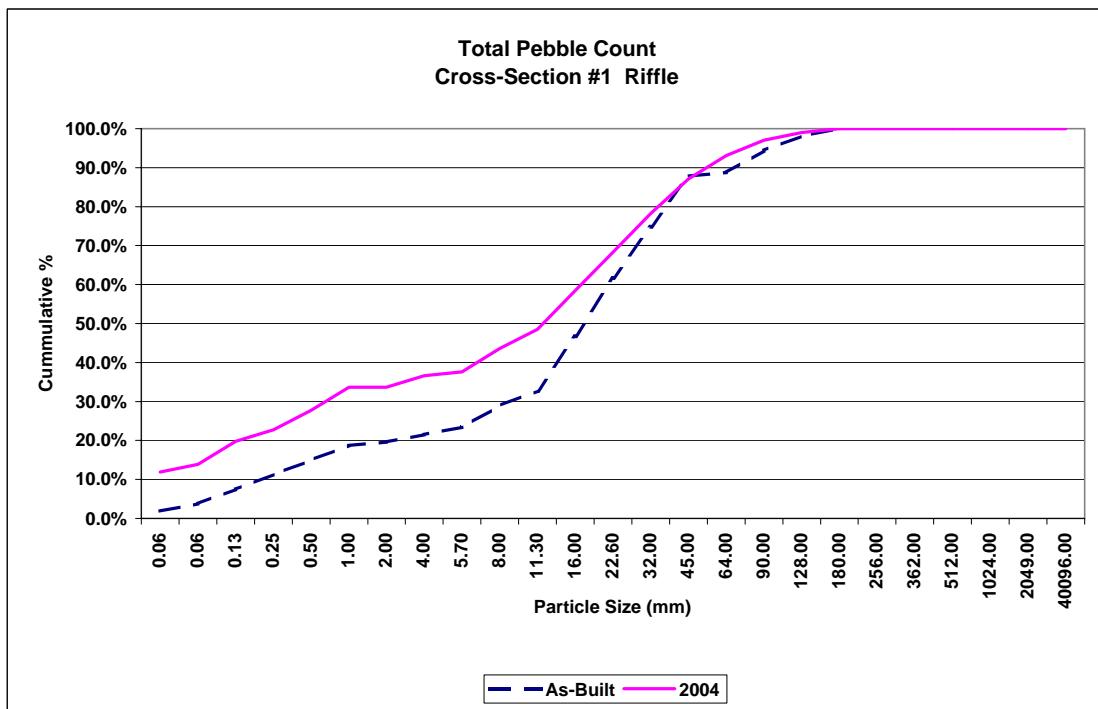


|                      |                                  |
|----------------------|----------------------------------|
| <b>Project Name</b>  | Anita Alta 4-H Camp Brown Branch |
| <b>Cross Section</b> | #2                               |
| <b>Feature</b>       | Pool                             |
| <b>Date</b>          | 6/14/04                          |
| <b>Crew</b>          | Bidelspach, Clinton              |

| 2004 Survey |           |           | 2003 Survey |           |           | AS-BUILT Survey |           |           |
|-------------|-----------|-----------|-------------|-----------|-----------|-----------------|-----------|-----------|
| Station     | Elevation | Notes     | Station     | Elevation | Notes     | Station         | Elevation | Notes     |
| 0.0         | 1225.69   | Left Pin  | 0.0         | 1225.64   | Left Pin  | 0.0             | 1225.63   | Left Pin  |
| 0.4         | 1225.28   |           | 0.0         | 1225.46   |           | 0.1             | 1225.16   |           |
| 13.6        | 1222.58   | BKF       | 2.6         | 1224.89   |           | 2.0             | 1225.05   |           |
| 24.4        | 1222.34   |           | 5.6         | 1224.34   |           | 5.4             | 1224.39   |           |
| 24.9        | 1222.18   |           | 8.6         | 1223.54   |           | 8.4             | 1223.64   |           |
| 28.6        | 1221.41   |           | 11.6        | 1222.93   |           | 11.4            | 1222.98   |           |
| 33.4        | 1221.11   |           | 14.0        | 1222.59   | BKF       | 14.4            | 1222.53   | BKF       |
| 33.9        | 1220.95   |           | 16.6        | 1222.48   |           | 17.4            | 1222.52   |           |
| 35.5        | 1221.39   |           | 19.6        | 1222.34   |           | 20.4            | 1222.31   |           |
| 36.7        | 1222.93   |           | 22.6        | 1222.30   |           | 23.4            | 1222.10   |           |
| 40.2        | 1224.58   |           | 25.2        | 1222.12   |           | 28.1            | 1221.54   |           |
| 48.0        | 1227.18   |           | 27.5        | 1221.52   |           | 30.5            | 1220.79   |           |
| 55.0        | 1227.33   |           | 30.6        | 1221.09   |           | 32.0            | 1220.77   |           |
| 55.1        | 1227.85   | Right Pin | 33.1        | 1221.22   |           | 34.2            | 1221.08   |           |
|             |           |           | 35.2        | 1221.09   |           | 35.6            | 1221.48   |           |
|             |           |           | 35.8        | 1221.50   |           | 36.3            | 1222.84   |           |
|             |           |           | 36.5        | 1222.79   |           | 40.5            | 1224.70   |           |
|             |           |           | 37.6        | 1223.17   |           | 45.1            | 1226.19   |           |
|             |           |           | 40.6        | 1224.72   |           | 48.3            | 1227.28   |           |
|             |           |           | 43.6        | 1225.74   |           | 51.4            | 1227.18   |           |
|             |           |           | 46.575      | 1226.67   |           | 55.15           | 1227.33   |           |
|             |           |           | 48.075      | 1227.17   |           | 55.15           | 1227.91   | Right Pin |
|             |           |           | 52.575      | 1227.18   |           |                 |           |           |
|             |           |           | 55.155      | 1227.29   |           |                 |           |           |
|             |           |           | 55.155      | 1227.91   | Right Pin |                 |           |           |



Photo of Cross-Section #2 - Looking Downstream @ STA 11+39


|            | 2004 | 2003 | AS-BUILT |
|------------|------|------|----------|
| Area       | 9.5  | 12.2 | 13.3     |
| Width      | 23.1 | 22.5 | 21.9     |
| Mean Depth | 0.4  | 0.5  | 0.6      |
| Max Depth  | 1.6  | 1.5  | 1.8      |
| W/D        | 55.8 | 41.4 | 36.0     |

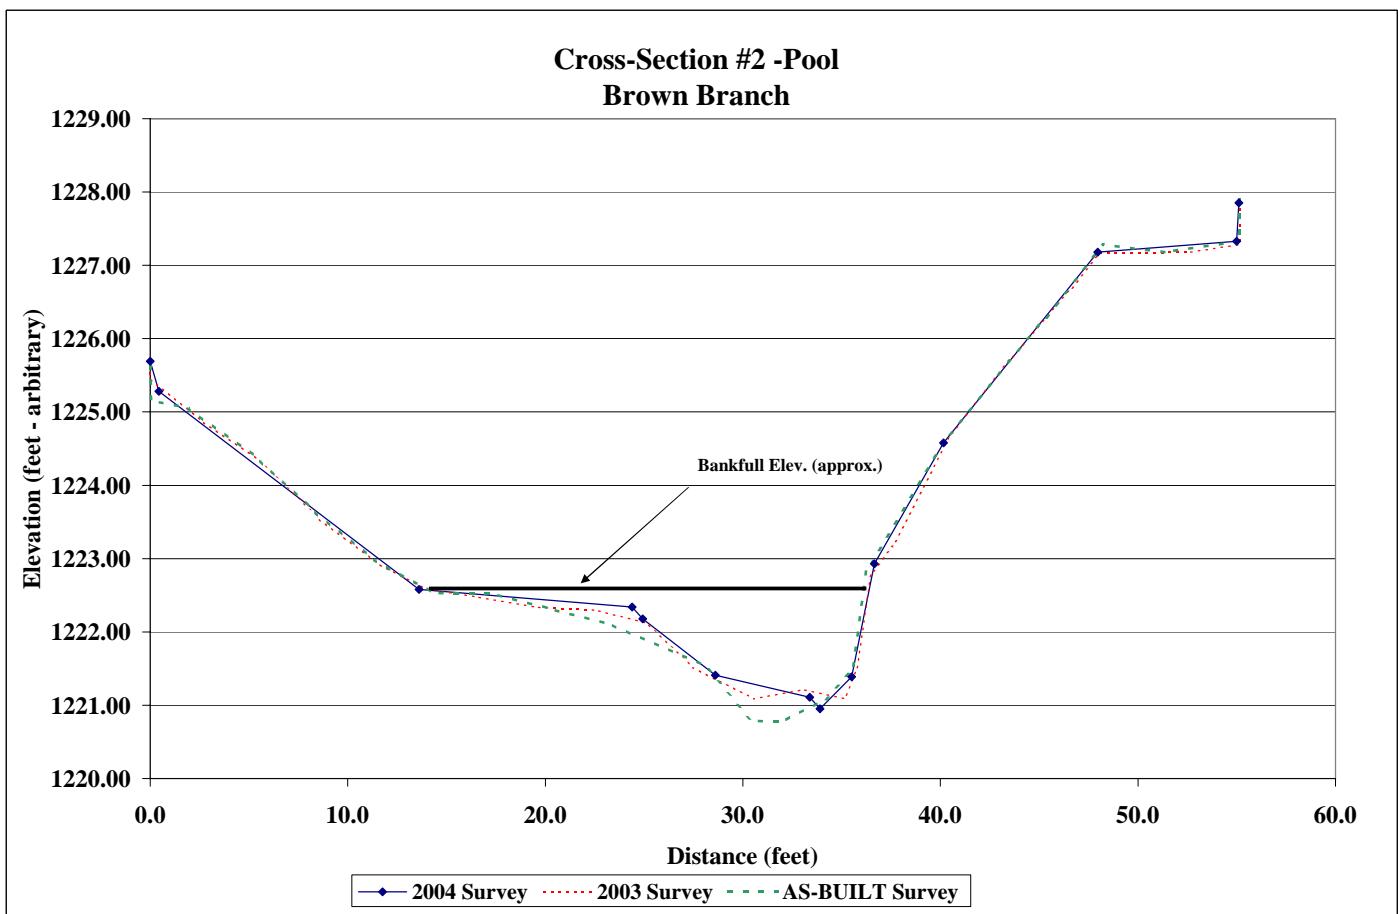

|                      |                     |
|----------------------|---------------------|
| <b>Project Name</b>  | Brown Branch        |
| <b>Cross Section</b> | #2                  |
| <b>Feature</b>       | Pool                |
| <b>Date</b>          | 6/3/04              |
| <b>Crew</b>          | Bidelspach, Clinton |

|  |                    | As-Built  |              |        |        | 2004         |               |        |        |
|--|--------------------|-----------|--------------|--------|--------|--------------|---------------|--------|--------|
| Description                            | Material           | Size (mm) | Riffle - Bed | %      | Cum %  | Riffle - Bed | Riffle - Bank | %      | Cum %  |
| Silt/Clay                              | silt/clay          | 0.061     | 2            | 1.9%   | 1.9%   | 3            | 0             | 3.0%   | 3.0%   |
| <b>Sand</b>                            | very fine sand     | 0.062     | 2            | 1.9%   | 3.7%   | 4            | 3             | 6.9%   | 9.9%   |
|  | fine sand          | 0.125     | 4            | 3.7%   | 7.5%   | 2            | 35            | 36.6%  | 46.5%  |
|  | medium sand        | 0.25      | 4            | 3.7%   | 11.2%  | 0            | 10            | 9.9%   | 56.4%  |
|  | course sand        | 0.50      | 4            | 3.7%   | 15.0%  | 1            | 5             | 5.9%   | 62.4%  |
|  | very coarse sand   | 1.0       | 4            | 3.7%   | 18.7%  | 3            | 0             | 3.0%   | 65.3%  |
|  | very fine gravel   | 2.0       | 1            | 0.9%   | 19.6%  | 0            | 0             | 0.0%   | 65.3%  |
| <b>G<br/>r<br/>a<br/>v<br/>e<br/>l</b> | fine gravel        | 4.0       | 2            | 1.9%   | 21.5%  | 5            | 1             | 5.9%   | 71.3%  |
|  | fine gravel        | 5.7       | 2            | 1.9%   | 23.4%  | 5            | 1             | 5.9%   | 77.2%  |
|  | medium gravel      | 8.0       | 6            | 5.6%   | 29.0%  | 3            | 2             | 5.0%   | 82.2%  |
|  | medium gravel      | 11.3      | 4            | 3.7%   | 32.7%  | 3            | 2             | 5.0%   | 87.1%  |
|  | course gravel      | 16.0      | 15           | 14.0%  | 46.7%  | 3            | 2             | 5.0%   | 92.1%  |
|  | course gravel      | 22.6      | 16           | 15.0%  | 61.7%  | 2            | 1             | 3.0%   | 95.0%  |
|  | very coarse gravel | 32        | 14           | 13.1%  | 74.8%  | 1            | 1             | 2.0%   | 97.0%  |
|  | very coarse gravel | 45        | 14           | 13.1%  | 87.9%  | 0            | 1             | 1.0%   | 98.0%  |
|  | small cobble       | 64        | 1            | 0.9%   | 88.8%  | 0            | 1             | 1.0%   | 99.0%  |
|  | medium cobble      | 90        | 6            | 5.6%   | 94.4%  | 0            | 1             | 1.0%   | 100.0% |
| <b>Cobble</b>                          | large cobble       | 128       | 4            | 3.7%   | 98.1%  | 0            | 0             | 0.0%   | 100.0% |
|  | very large cobble  | 180       | 2            | 1.9%   | 100.0% | 0            | 0             | 0.0%   | 100.0% |
| <b>Boulder</b>                         | small boulder      | 256       | 0            | 0.0%   | 100.0% | 0            | 0             | 0.0%   | 100.0% |
|  | small boulder      | 362       | 0            | 0.0%   | 100.0% | 0            | 0             | 0.0%   | 100.0% |
|  | medium boulder     | 512       | 0            | 0.0%   | 100.0% | 0            | 0             | 0.0%   | 100.0% |
|  | large boulder      | 1024      | 0            | 0.0%   | 100.0% | 0            | 0             | 0.0%   | 100.0% |
|  | very large boulder | 2049      | 0            | 0.0%   | 100.0% | 0            | 0             | 0.0%   | 100.0% |
| <b>Bedrock</b>                         | bedrock            | 40096     | 0            | 0.0%   | 100.0% | 0            | 0             | 0.0%   | 100.0% |
| <b>TOTAL / % of whole count</b>        |                    |           | 107          | 100.0% |        | 35           | 66            | 100.0% |        |

|      | d16  | d35  | d50  | d85   | d95   |
|------|------|------|------|-------|-------|
| 2004 | 0.11 | 0.16 | 0.25 | 11.12 | 27.17 |

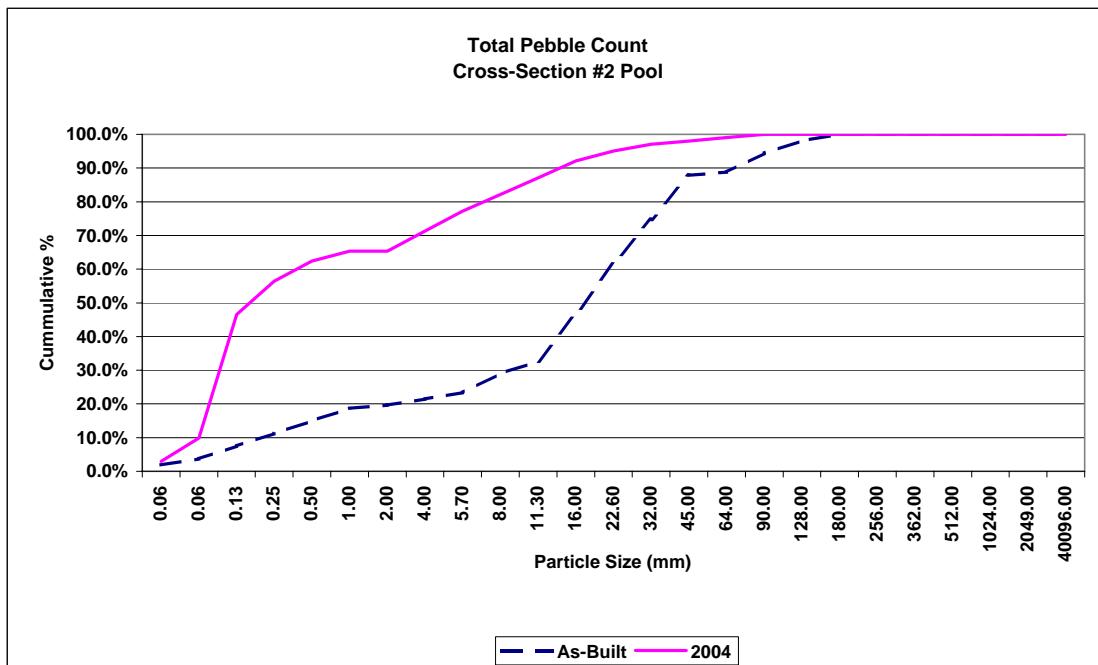


|               |                                  |
|---------------|----------------------------------|
| Project Name  | Anita Alta 4-H Camp Brown Branch |
| Cross Section | #3                               |
| Feature       | Riffle                           |
| Date          | 6/14/04                          |
| Crew          | Bidelspach, Clinton              |

| 2004 Survey |           |           | 2003 Survey |           |           | AS-BUILT Survey |           |           |
|-------------|-----------|-----------|-------------|-----------|-----------|-----------------|-----------|-----------|
| Station     | Elevation | Notes     | Station     | Elevation | Notes     | Station         | Elevation | Notes     |
| 0.0         | 1216.95   | Left Pin  | 0.0         | 1216.95   | Left Pin  | 0.0             | 1216.94   | Left Pin  |
| 0.0         | 1216.61   |           | 0.0         | 1216.61   |           | 0.0             | 1216.64   |           |
| 2.6         | 1216.94   |           | 2.6         | 1216.94   |           | 2.5             | 1216.93   |           |
| 5.6         | 1217.02   |           | 5.6         | 1217.02   |           | 5.5             | 1217.03   |           |
| 8.6         | 1217.14   |           | 8.6         | 1217.14   |           | 8.5             | 1217.12   |           |
| 11.6        | 1217.50   |           | 11.6        | 1217.50   |           | 11.5            | 1217.54   |           |
| 12.5        | 1217.54   |           | 14.1        | 1217.54   |           | 14.2            | 1217.53   |           |
| 15.7        | 1215.25   |           | 15.7        | 1214.28   |           | 15.7            | 1213.91   |           |
| 16.7        | 1214.23   |           | 15.7        | 1213.78   |           | 16.8            | 1213.74   |           |
| 17.6        | 1213.85   |           | 17.6        | 1213.85   |           | 18.4            | 1213.89   |           |
| 19.2        | 1213.57   |           | 19.2        | 1213.67   |           | 19.8            | 1213.80   |           |
| 22.3        | 1214.24   |           | 22.3        | 1214.25   |           | 21.4            | 1214.04   |           |
| 24.8        | 1214.88   |           | 24.6        | 1215.00   |           | 24.5            | 1215.18   |           |
| 27.6        | 1215.39   | BKF       | 27.6        | 1215.44   | BKF       | 27.5            | 1215.41   | BKF       |
| 30.6        | 1215.45   |           | 30.6        | 1215.45   |           | 29.5            | 1215.39   |           |
| 35.6        | 1216.69   |           | 32.6        | 1215.78   |           | 32.5            | 1215.79   |           |
| 41.3        | 1219.2    |           | 35.6        | 1216.69   |           | 35.5            | 1216.82   |           |
| 41.3        | 1219.50   | Right Pin | 38.6        | 1217.88   |           | 38.5            | 1217.87   |           |
|             |           |           | 41.3        | 1219.18   |           | 41.3            | 1219.14   |           |
|             |           |           | 41.3        | 1219.50   | Right Pin | 41.3            | 1219.49   | Right Pin |



Photo of Cross-Section #3 - Looking Downstream @ STA 20+13


|            | 2004 | 2003 | AS-BUILT |
|------------|------|------|----------|
| Area       | 15.1 | 16.6 | 15.4     |
| Width      | 14.9 | 14.9 | 16.8     |
| Mean Depth | 1.0  | 1.1  | 0.9      |
| Max Depth  | 1.8  | 1.7  | 1.7      |
| W/D        | 14.7 | 13.3 | 18.3     |

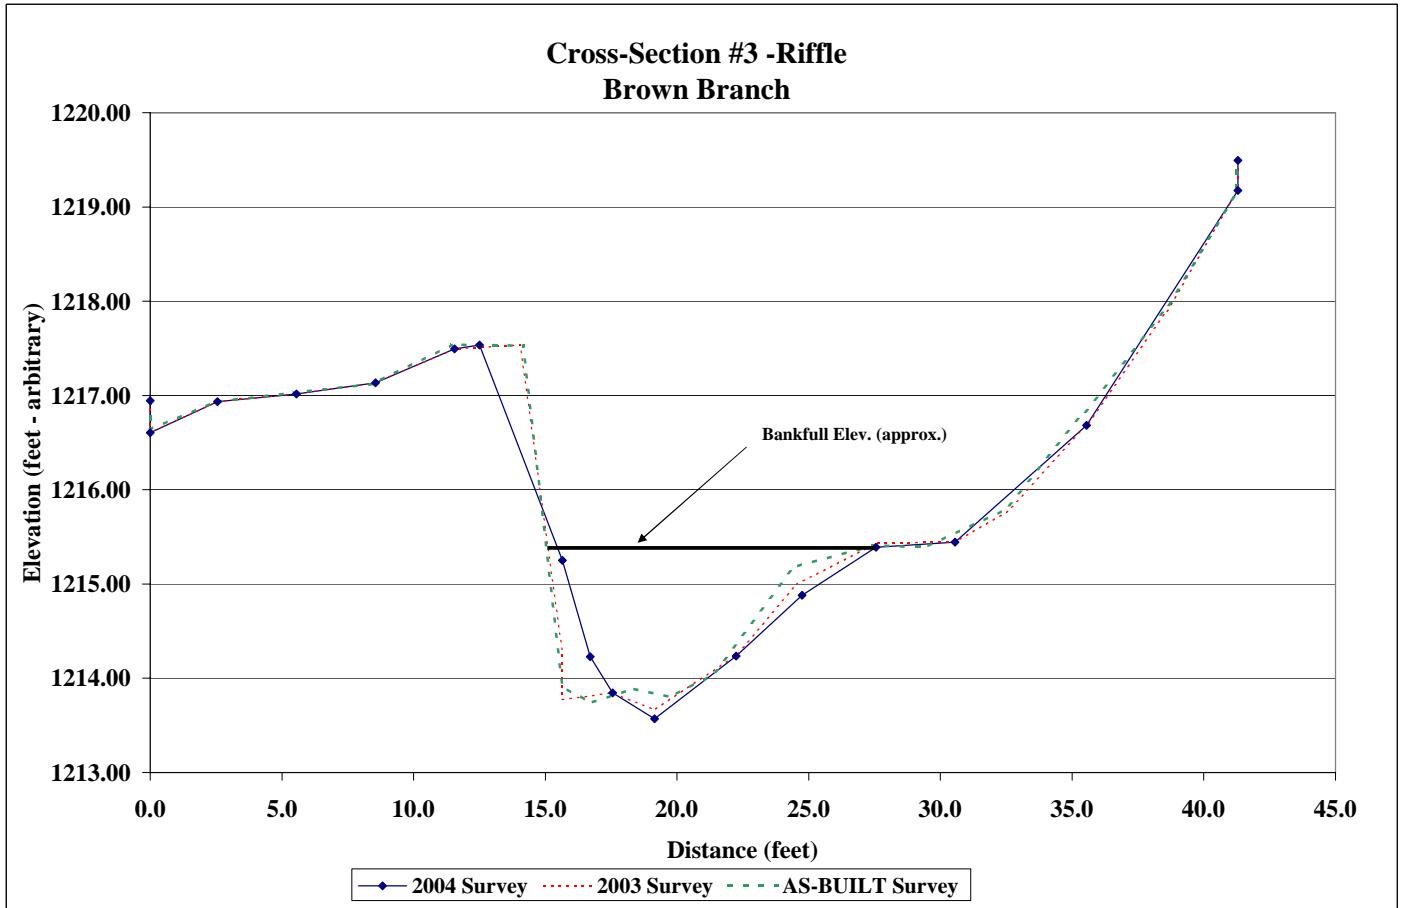

|               |                     |
|---------------|---------------------|
| Project Name  | Brown Branch        |
| Cross Section | #3                  |
| Feature       | Riffle              |
| Date          | 6/3/04              |
| Crew          | Bidelspach, Clinton |

| Description                    | Material           | Size (mm) | As-Built     |        | 2004   |              |               |
|--------------------------------|--------------------|-----------|--------------|--------|--------|--------------|---------------|
|                                |                    |           | Riffle - Bed | %      | Cum %  | Riffle - Bed | Riffle - Bank |
| Sand                           | Silt/Clay          | 0.061     | 1            | 1.0%   | 1.0%   | 0            | 0             |
|                                | very fine sand     | 0.062     | 4            | 3.9%   | 4.9%   | 0            | 0             |
|                                | fine sand          | 0.125     | 5            | 4.9%   | 9.8%   | 0            | 0             |
|                                | medium sand        | 0.25      | 5            | 4.9%   | 14.7%  | 0            | 1             |
|                                | course sand        | 0.50      | 6            | 5.9%   | 20.6%  | 0            | 1             |
|                                | very coarse sand   | 1.0       | 8            | 7.8%   | 28.4%  | 7            | 6             |
| Gravel                         | very fine gravel   | 2.0       | 5            | 4.9%   | 33.3%  | 0            | 0             |
|                                | fine gravel        | 4.0       | 5            | 4.9%   | 38.2%  | 2            | 3             |
|                                | fine gravel        | 5.7       | 4            | 3.9%   | 42.2%  | 1            | 2             |
|                                | medium gravel      | 8.0       | 7            | 6.9%   | 49.0%  | 5            | 4             |
|                                | medium gravel      | 11.3      | 3            | 2.9%   | 52.0%  | 4            | 4             |
|                                | course gravel      | 16.0      | 6            | 5.9%   | 57.8%  | 7            | 7             |
|                                | course gravel      | 22.6      | 13           | 12.7%  | 70.6%  | 6            | 7             |
|                                | very coarse gravel | 32        | 8            | 7.8%   | 78.4%  | 7            | 7             |
|                                | very coarse gravel | 45        | 9            | 8.8%   | 87.3%  | 7            | 6             |
| Cobble                         | small cobble       | 64        | 3            | 2.9%   | 90.2%  | 2            | 1             |
|                                | medium cobble      | 90        | 5            | 4.9%   | 95.1%  | 2            | 1             |
|                                | large cobble       | 128       | 2            | 2.0%   | 97.1%  | 0            | 0             |
|                                | very large cobble  | 180       | 3            | 2.9%   | 100.0% | 0            | 0             |
| Boulder                        | small boulder      | 256       | 0            | 0.0%   | 100.0% | 0            | 0             |
|                                | small boulder      | 362       | 0            | 0.0%   | 100.0% | 0            | 0             |
|                                | medium boulder     | 512       | 0            | 0.0%   | 100.0% | 0            | 0             |
|                                | large boulder      | 1024      | 0            | 0.0%   | 100.0% | 0            | 0             |
|                                | very large boulder | 2049      | 0            | 0.0%   | 100.0% | 0            | 0             |
| Bedrock                        | bedrock            | 40096     | 0            | 0.0%   | 100.0% | 0            | 0             |
| <b>TOTAL / %of whole count</b> |                    |           | 102          | 100.0% |        | 50           | 50            |
|                                |                    |           |              |        |        | 100.0%       |               |

|      | d16  | d35   | d50   | d85   | d95   |
|------|------|-------|-------|-------|-------|
| 2004 | 3.37 | 11.15 | 17.69 | 42.19 | 62.00 |

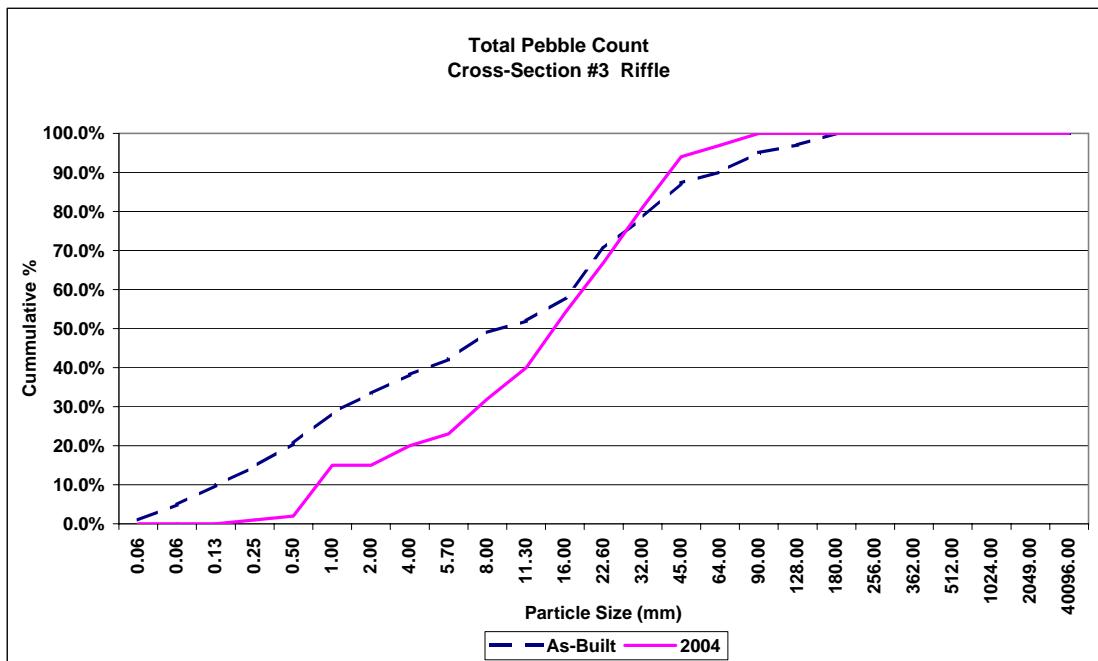


|               |                                  |
|---------------|----------------------------------|
| Project Name  | Anita Alta 4-H Camp Brown Branch |
| Cross Section | #4                               |
| Feature       | Pool                             |
| Date          | 6/14/04                          |
| Crew          | Bidelspach, Clinton              |

| 2004 Survey |           |           | 2003 Survey |           |           | AS-BUILT Survey |           |           |
|-------------|-----------|-----------|-------------|-----------|-----------|-----------------|-----------|-----------|
| Station     | Elevation | Notes     | Station     | Elevation | Notes     | Station         | Elevation | Notes     |
| 0.0         | 1213.64   | Left Pin  | 0.0         | 1213.65   | Left Pin  | 0.0             | 1213.65   | Left Pin  |
| 0.1         | 1213.74   |           | 0.0         | 1213.34   |           | 0.0             | 1213.33   |           |
| 0.2         | 1213.64   |           | 1.8         | 1213.24   |           | 1.8             | 1213.33   |           |
| 0.3         | 1213.59   |           | 5.4         | 1211.37   |           | 5.3             | 1211.57   |           |
| 0.3         | 1213.59   |           | 8.4         | 1210.25   |           | 8.1             | 1210.36   |           |
| 10.7        | 1209.60   | BKF       | 11.6        | 1209.54   | BKF       | 10.6            | 1209.66   | BKF       |
| 13.7        | 1209.20   |           | 14.4        | 1209.27   |           | 13.6            | 1209.36   |           |
| 20.3        | 1208.67   |           | 17.4        | 1208.88   |           | 16.6            | 1208.91   |           |
| 23.6        | 1207.93   |           | 20.4        | 1208.52   |           | 19.6            | 1208.53   |           |
| 25.3        | 1207.75   |           | 23.4        | 1208.03   |           | 22.2            | 1208.15   |           |
| 28.1        | 1207.69   |           | 24.8        | 1207.92   |           | 23.9            | 1207.90   |           |
| 31.2        | 1208.31   |           | 26.7        | 1207.69   |           | 26.2            | 1207.69   |           |
| 35.4        | 1210.01   |           | 28.1        | 1207.48   |           | 28.1            | 1207.67   |           |
| 43.4        | 1210.68   |           | 30.2        | 1207.92   |           | 30.0            | 1208.18   |           |
| 47.2        | 1212.22   |           | 30.5        | 1208.63   |           | 31.1            | 1208.47   |           |
| 50.6        | 1213.80   |           | 34.5        | 1209.69   |           | 33.6            | 1209.63   |           |
| 52.9        | 1214.8    |           | 37.4        | 1210.26   |           | 36.6            | 1210.17   |           |
| 52.9        | 1214.82   |           | 40.4        | 1210.43   |           | 39.6            | 1210.35   |           |
| 53.1        | 1214.86   | Right Pin | 43.1        | 1210.74   |           | 42.6            | 1210.61   |           |
|             |           |           | 46.4        | 1212.00   |           | 45.6            | 1211.60   |           |
|             |           |           | 49.4        | 1213.53   |           | 48.55           | 1213.11   |           |
|             |           |           | 52.4        | 1214.43   |           | 51.55           | 1214.29   |           |
|             |           |           | 52.9        | 1214.53   |           | 52.85           | 1214.54   |           |
|             |           |           | 52.9        | 1214.85   | Right Pin | 52.85           | 1214.85   | Right Pin |



Photo of Cross-Section #4 - Looking Downstream @ STA 26+34


|            | 2004 | 2003 | AS-BUILT |
|------------|------|------|----------|
| Area       | 23.2 | 22.5 | 21.9     |
| Width      | 24.7 | 22.9 | 20.0     |
| Mean Depth | 0.9  | 1.0  | 1.1      |
| Max Depth  | 1.9  | 2.1  | 1.9      |
| W/D        | 26.2 | 23.3 | 18.3     |

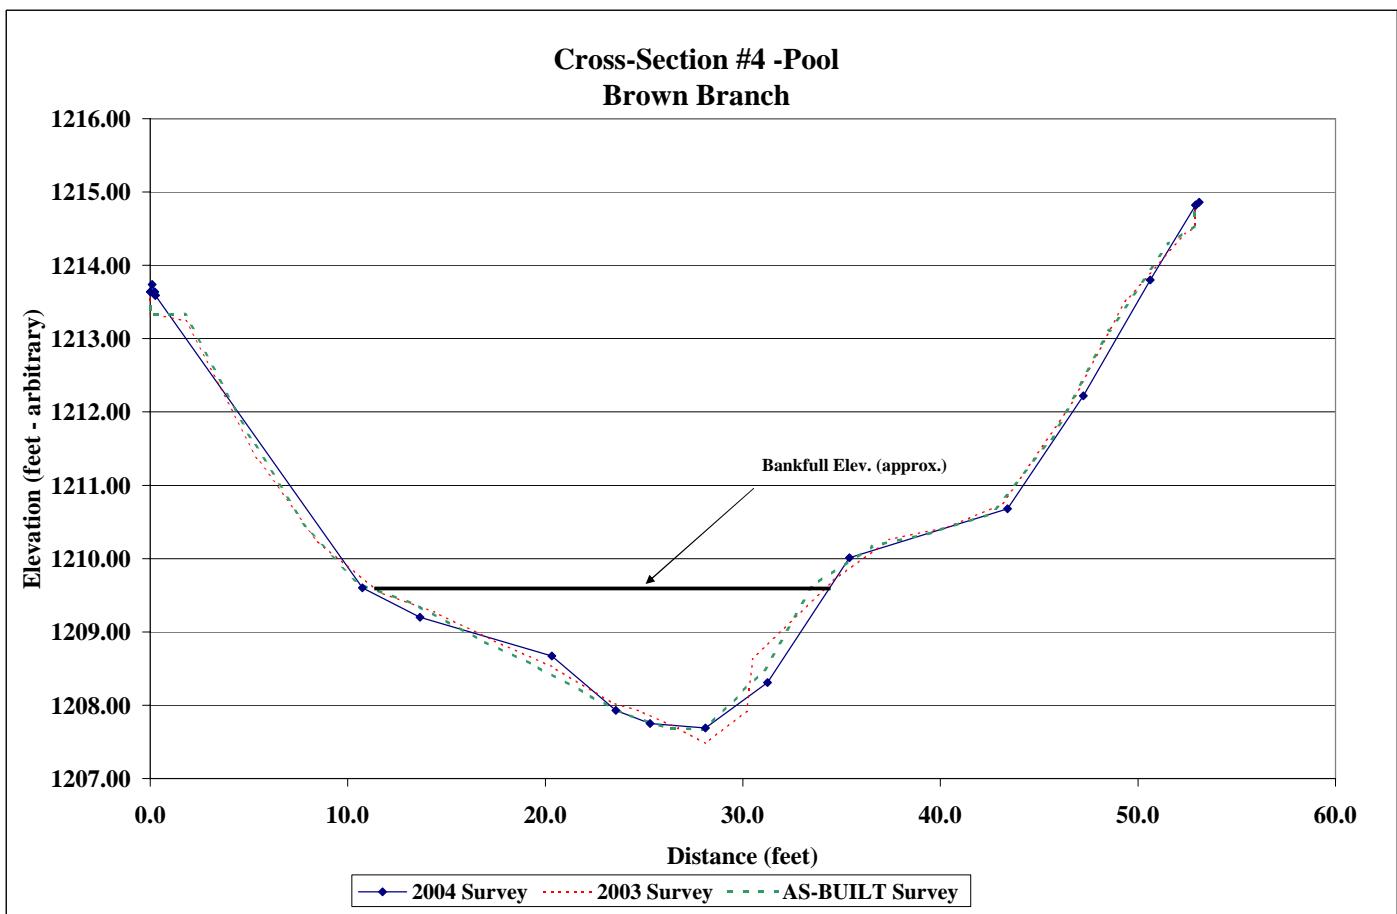

|                      |                     |
|----------------------|---------------------|
| <b>Project Name</b>  | Brown Branch        |
| <b>Cross Section</b> | #4                  |
| <b>Feature</b>       | Pool                |
| <b>Date</b>          | 6/3/04              |
| <b>Crew</b>          | Bidelspach, Clinton |

| <b>Description</b>                     | <b>Material</b>    | <b>Size (mm)</b> | <b>As-Built</b>     |          | <b>2004</b>  |                     |                      |          |
|--|--------------------|------------------|---------------------|----------|--------------|---------------------|----------------------|----------|
|  |                    |                  | <b>Riffle - Bed</b> | <b>%</b> | <b>Cum %</b> | <b>Riffle - Bed</b> | <b>Riffle - Bank</b> | <b>%</b> |
| Silt/Clay                              | silt/clay          | 0.061            | 0                   | 0.0%     | 0.0%         | 0                   | 0                    | 0.0%     |
| <b>Sand</b>                            | very fine sand     | 0.062            | 3                   | 2.4%     | 2.4%         | 0                   | 1                    | 1.0%     |
|  | fine sand          | 0.125            | 4                   | 3.3%     | 5.7%         | 0                   | 16                   | 16.0%    |
|  | medium sand        | 0.25             | 6                   | 4.9%     | 10.6%        | 0                   | 4                    | 4.0%     |
|  | course sand        | 0.50             | 6                   | 4.9%     | 15.4%        | 0                   | 3                    | 3.0%     |
|  | very coarse sand   | 1.0              | 9                   | 7.3%     | 22.8%        | 4                   | 4                    | 8.0%     |
|  | very fine gravel   | 2.0              | 4                   | 3.3%     | 26.0%        | 0                   | 0                    | 0.0%     |
| <b>G<br/>r<br/>a<br/>v<br/>e<br/>l</b> | fine gravel        | 4.0              | 4                   | 3.3%     | 29.3%        | 1                   | 1                    | 2.0%     |
|  | fine gravel        | 5.7              | 3                   | 2.4%     | 31.7%        | 0                   | 0                    | 0.0%     |
|  | medium gravel      | 8.0              | 6                   | 4.9%     | 36.6%        | 3                   | 3                    | 6.0%     |
|  | medium gravel      | 11.3             | 11                  | 8.9%     | 45.5%        | 3                   | 2                    | 5.0%     |
|  | course gravel      | 16.0             | 12                  | 9.8%     | 55.3%        | 5                   | 6                    | 11.0%    |
|  | course gravel      | 22.6             | 20                  | 16.3%    | 71.5%        | 5                   | 6                    | 11.0%    |
|  | very coarse gravel | 32               | 18                  | 14.6%    | 86.2%        | 2                   | 11                   | 13.0%    |
|  | very coarse gravel | 45               | 4                   | 3.3%     | 89.4%        | 2                   | 10                   | 12.0%    |
|  | small cobble       | 64               | 4                   | 3.3%     | 92.7%        | 0                   | 4                    | 4.0%     |
|  | medium cobble      | 90               | 5                   | 4.1%     | 96.7%        | 0                   | 4                    | 4.0%     |
| <b>Cobble</b>                          | large cobble       | 128              | 1                   | 0.8%     | 97.6%        | 0                   | 0                    | 0.0%     |
|  | very large cobble  | 180              | 2                   | 1.6%     | 99.2%        | 0                   | 0                    | 0.0%     |
|  | bedrock            | 40096            | 0                   | 0.0%     | 100.0%       | 0                   | 0                    | 0.0%     |
| <b>TOTAL / % of whole count</b>        |                    | 123              | 100.0%              |          | 25           | 75                  | 100.0%               |          |

|             | <b>d16</b> | <b>d35</b> | <b>d50</b> | <b>d85</b> | <b>d95</b> |
|-------------|------------|------------|------------|------------|------------|
| <b>2004</b> | 0.18       | 7.32       | 16.22      | 43.83      | 71.37      |

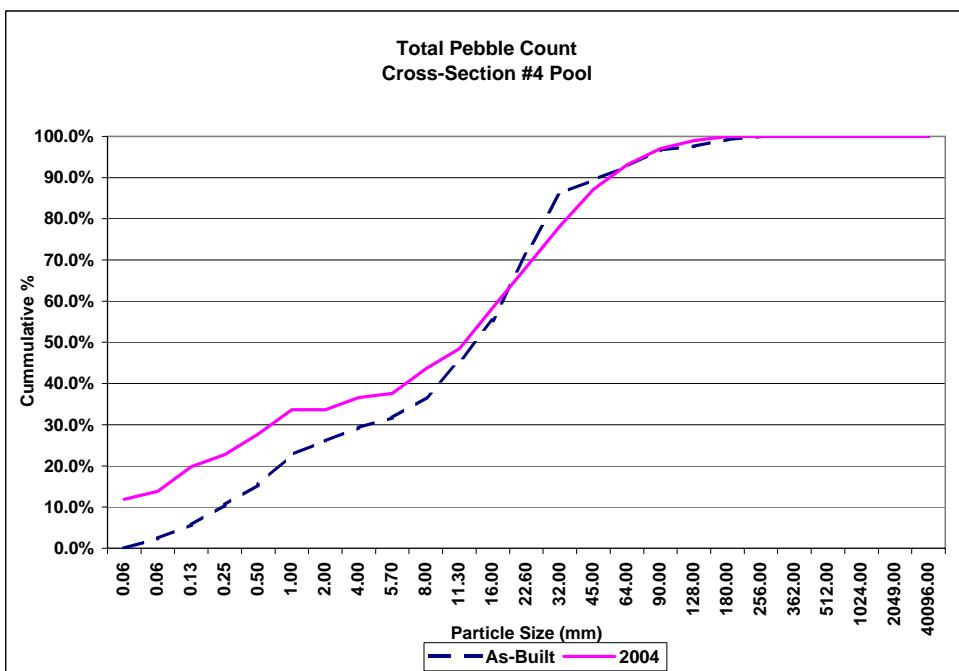


|               |                                  |
|---------------|----------------------------------|
| Project Name  | Anita Alta 4-H Camp Brown Branch |
| Cross Section | #5                               |
| Feature       | Riffle                           |
| Date          | 6/14/04                          |
| Crew          | Bidelspach, Clinton              |

| 2004 Survey |           |           | 2003 Survey |           |           | AS-BUILT Survey |           |           |
|-------------|-----------|-----------|-------------|-----------|-----------|-----------------|-----------|-----------|
| Station     | Elevation | Notes     | Station     | Elevation | Notes     | Station         | Elevation | Notes     |
| 0.0         | 1196.58   | Left Pin  | 0.0         | 1196.58   | Left Pin  | 0.0             | 1196.58   | Left Pin  |
| 0.0         | 1196.48   |           | 0.0         | 1196.03   |           | 0.0             | 1196.22   |           |
| 19.2        | 1195.60   |           | 2.5         | 1196.19   |           | 2.2             | 1196.27   |           |
| 25.2        | 1195.29   | BKF       | 5.5         | 1195.90   |           | 5.2             | 1196.04   |           |
| 29.1        | 1195.07   |           | 8.5         | 1195.67   |           | 8.2             | 1195.78   |           |
| 31.2        | 1194.27   |           | 11.5        | 1195.63   |           | 11.2            | 1195.82   |           |
| 33.9        | 1194.41   |           | 14.5        | 1195.57   |           | 14.2            | 1195.72   |           |
| 37.5        | 1194.42   |           | 17.5        | 1195.56   |           | 17.2            | 1195.57   |           |
| 39.4        | 1194.12   |           | 20.5        | 1195.54   |           | 20.2            | 1195.73   |           |
| 41.6        | 1193.86   |           | 23.5        | 1195.47   |           | 23.2            | 1195.60   |           |
| 43.7        | 1193.98   |           | 26.5        | 1195.27   |           | 26.2            | 1195.32   | BKF       |
| 45.6        | 1194.59   |           | 29.5        | 1195.29   |           | 29.2            | 1194.69   |           |
| 46.5        | 1195.72   |           | 31.2        | 1194.21   |           | 30.8            | 1194.53   |           |
| 56.0        | 1196.58   |           | 33.5        | 1194.35   |           | 32.9            | 1194.36   |           |
| 56.2        | 1196.95   | Right Pin | 36.5        | 1194.47   |           | 35.1            | 1194.42   |           |
|             |           |           | 39.2        | 1194.05   |           | 38.4            | 1194.67   |           |
|             |           |           | 41.9        | 1193.81   |           | 41.9            | 1194.58   |           |
|             |           |           | 43.5        | 1194.05   |           | 45.2            | 1195.59   |           |
|             |           |           | 45.6        | 1194.57   |           | 48.2            | 1196.00   |           |
|             |           |           | 45.8        | 1195.62   |           | 51.2            | 1196.34   |           |
|             |           |           | 48.5        | 1195.97   |           | 54.2            | 1196.47   |           |
|             |           |           | 51.5        | 1196.25   |           | 56.25           | 1196.67   |           |
|             |           |           | 54.5        | 1196.48   |           | 56.25           | 1196.94   | Right Pin |
|             |           |           | 56.3        | 1196.61   |           |                 |           |           |
|             |           |           | 56.3        | 1196.94   | Right Pin |                 |           |           |



Photo of Cross-Section #5 - Looking Downstream @ STA 43+23


|            | 2004 | 2003 | AS-BUILT |
|------------|------|------|----------|
| Area       | 15.1 | 14.8 | 11.7     |
| Width      | 15.3 | 14.6 | 16.0     |
| Mean Depth | 1.0  | 1.0  | 0.7      |
| Max Depth  | 1.4  | 1.5  | 0.9      |
| W/D        | 15.4 | 14.4 | 21.9     |

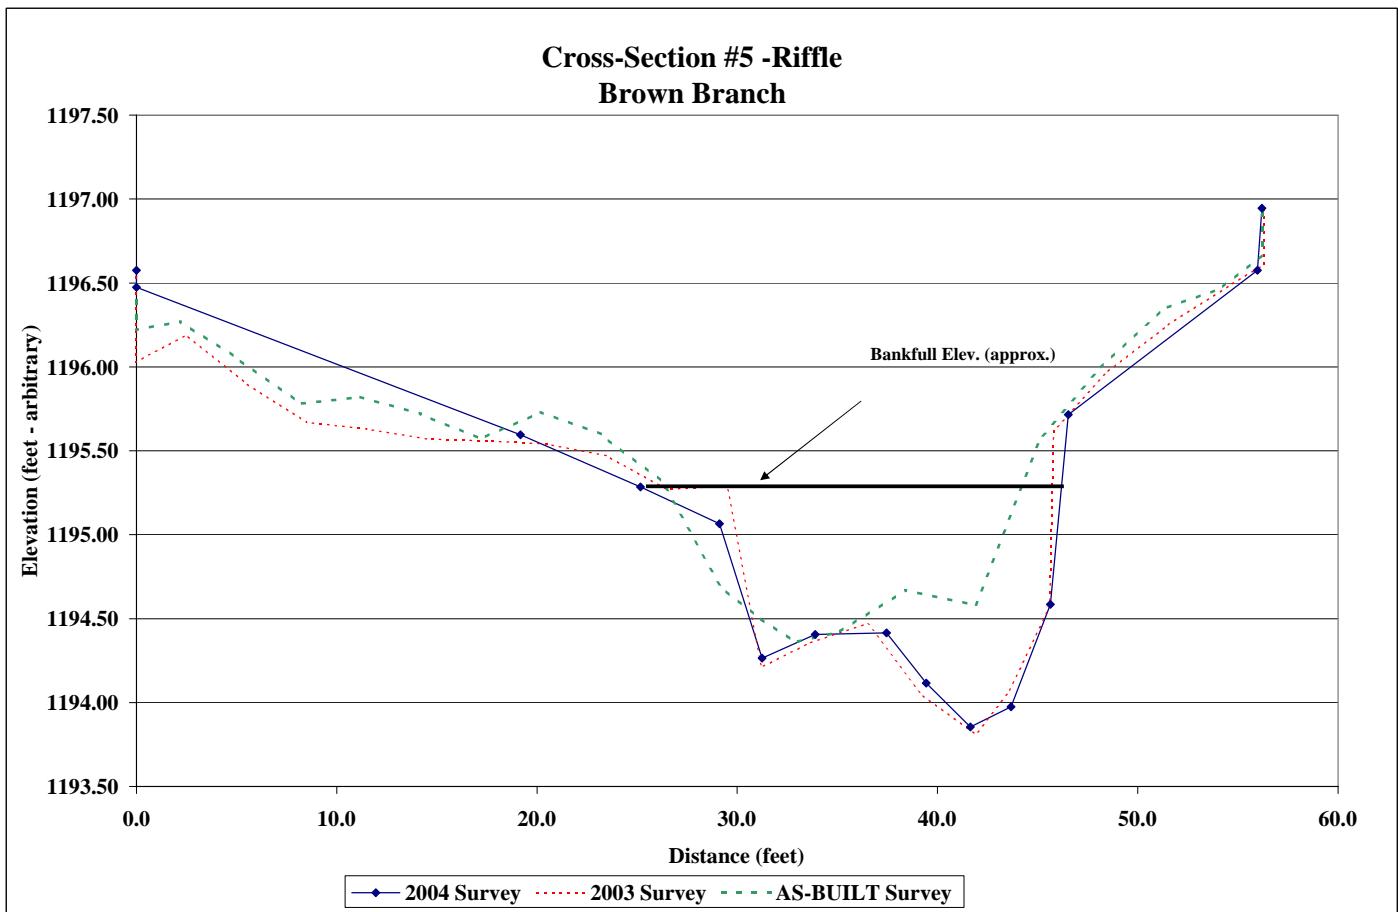

|                      |                     |
|----------------------|---------------------|
| <b>Project Name</b>  | Brown Branch        |
| <b>Cross Section</b> | #5                  |
| <b>Feature</b>       | Riffle              |
| <b>Date</b>          | 6/3/04              |
| <b>Crew</b>          | Bidelspach, Clinton |

| <b>Description</b>                     | <b>Material</b>    | <b>Size (mm)</b> | <b>As-Built</b>     |          | <b>2004</b>  |                     |                      |
|--|--------------------|------------------|---------------------|----------|--------------|---------------------|----------------------|
|  |                    |                  | <b>Riffle - Bed</b> | <b>%</b> | <b>Cum %</b> | <b>Riffle - Bed</b> | <b>Riffle - Bank</b> |
| Silt/Clay                              | silt/clay          | 0.061            | 0                   | 0.0%     | 0.0%         | 0                   | 1                    |
| <b>Sand</b>                            | very fine sand     | 0.062            | 3                   | 2.4%     | 2.4%         | 0                   | 2                    |
|  | fine sand          | 0.125            | 4                   | 3.3%     | 5.7%         | 0                   | 6                    |
|  | medium sand        | 0.25             | 6                   | 4.9%     | 10.6%        | 0                   | 24                   |
|  | course sand        | 0.50             | 6                   | 4.9%     | 15.4%        | 1                   | 5                    |
|  | very coarse sand   | 1.0              | 9                   | 7.3%     | 22.8%        | 3                   | 10                   |
|  | very fine gravel   | 2.0              | 4                   | 3.3%     | 26.0%        | 0                   | 0                    |
| <b>G<br/>r<br/>a<br/>v<br/>e<br/>l</b> | fine gravel        | 4.0              | 4                   | 3.3%     | 29.3%        | 1                   | 9                    |
|  | fine gravel        | 5.7              | 3                   | 2.4%     | 31.7%        | 0                   | 8                    |
|  | medium gravel      | 8.0              | 6                   | 4.9%     | 36.6%        | 4                   | 5                    |
|  | medium gravel      | 11.3             | 11                  | 8.9%     | 45.5%        | 3                   | 5                    |
|  | course gravel      | 16.0             | 12                  | 9.8%     | 55.3%        | 4                   | 1                    |
|  | course gravel      | 22.6             | 20                  | 16.3%    | 71.5%        | 4                   | 1                    |
|  | very coarse gravel | 32               | 18                  | 14.6%    | 86.2%        | 2                   | 1                    |
|  | very coarse gravel | 45               | 4                   | 3.3%     | 89.4%        | 2                   | 0                    |
|  | small cobble       | 64               | 4                   | 3.3%     | 92.7%        | 1                   | 0                    |
|  | medium cobble      | 90               | 5                   | 4.1%     | 96.7%        | 0                   | 0                    |
| <b>Cobble</b>                          | large cobble       | 128              | 1                   | 0.8%     | 97.6%        | 0                   | 0                    |
|  | very large cobble  | 180              | 2                   | 1.6%     | 99.2%        | 0                   | 0                    |
|  | small boulder      | 256              | 1                   | 0.8%     | 100.0%       | 0                   | 0                    |
| <b>Boulder</b>                         | small boulder      | 362              | 0                   | 0.0%     | 100.0%       | 0                   | 0                    |
|  | medium boulder     | 512              | 0                   | 0.0%     | 100.0%       | 0                   | 0                    |
|  | large boulder      | 1024             | 0                   | 0.0%     | 100.0%       | 0                   | 0                    |
|  | very large boulder | 2049             | 0                   | 0.0%     | 100.0%       | 0                   | 0                    |
| <b>Bedrock</b>                         | bedrock            | 40096            | 0                   | 0.0%     | 100.0%       | 0                   | 0                    |
| <b>TOTAL / % of whole count</b>        |                    |                  | 123                 | 100.0%   |              | 25                  | 78                   |
|  |                    |                  |                     |          |              | 103.0%              |                      |

|             | <b>d16</b> | <b>d35</b> | <b>d50</b> | <b>d85</b> | <b>d95</b> |
|-------------|------------|------------|------------|------------|------------|
| <b>2004</b> | 0.24       | 0.50       | 1.38       | 12.15      | 24.10      |

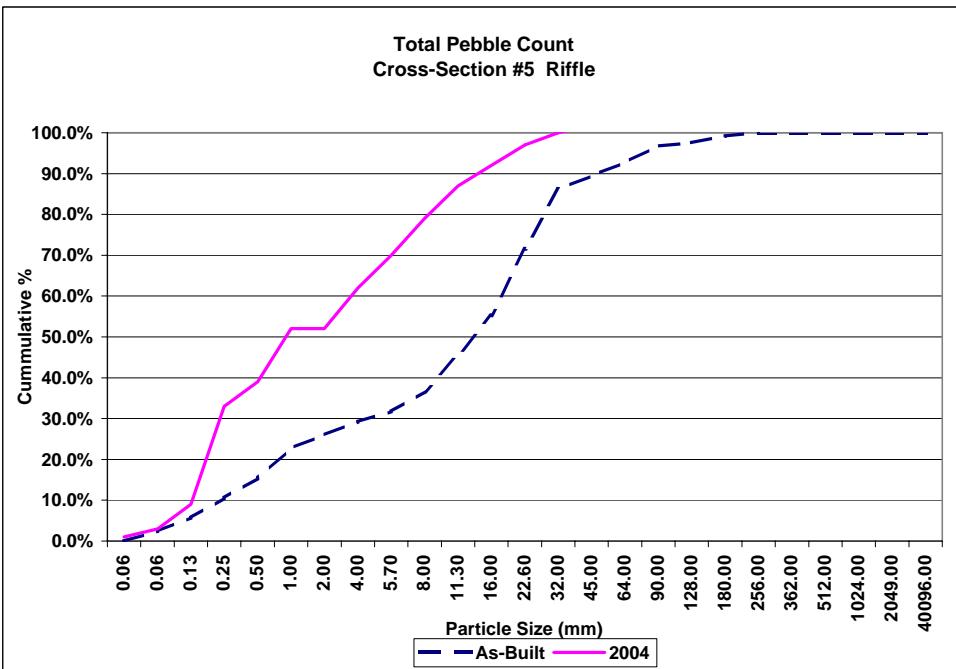


|               |                                  |
|---------------|----------------------------------|
| Project Name  | Anita Alta 4-H Camp Brown Branch |
| Cross Section | #6                               |
| Feature       | Pool                             |
| Date          | 6/14/04                          |
| Crew          | Bidelspach, Clinton              |

| 2004 Survey |           |          | 2003 Survey |           |           | AS-BUILT Survey |           |           |
|-------------|-----------|----------|-------------|-----------|-----------|-----------------|-----------|-----------|
| Station     | Elevation | Notes    | Station     | Elevation | Notes     | Station         | Elevation | Notes     |
| 0.0         | 1197.05   | Left Pin | 0.0         | 1197.04   | Left Pin  | 0.0             | 1197.06   | Left Pin  |
| 0.1         | 1196.72   |          | 0.0         | 1196.71   |           | 0.0             | 1196.80   |           |
| 11.2        | 1195.87   |          | 2.4         | 1196.47   |           | 2.3             | 1196.56   |           |
| 11.4        | 1195.88   |          | 5.4         | 1196.16   |           | 5.3             | 1196.27   |           |
| 16.3        | 1193.61   |          | 8.4         | 1196.24   |           | 8.3             | 1196.37   |           |
| 21.5        | 1193.55   |          | 10.9        | 1196.06   |           | 11.3            | 1196.04   |           |
| 25.2        | 1193.25   |          | 13.8        | 1195.03   |           | 14.1            | 1195.04   |           |
| 25.8        | 1193.39   |          | 14.8        | 1194.57   |           | 16.3            | 1194.02   |           |
| 26.1        | 1193.52   |          | 17.2        | 1193.53   |           | 18.4            | 1192.65   |           |
| 27.4        | 1193.62   |          | 20.4        | 1193.62   |           | 20.3            | 1192.54   |           |
| 29.3        | 1194.00   |          | 22.6        | 1193.51   |           | 23.6            | 1192.92   |           |
| 31.0        | 1194.38   |          | 25.7        | 1193.18   |           | 28.0            | 1193.90   |           |
| 34.4        | 1194.58   |          | 27.8        | 1193.49   |           | 31.3            | 1194.52   |           |
| 37.5        | 1194.96   | BKF      | 30.4        | 1194.10   |           | 34.3            | 1194.88   |           |
|             |           |          | 33.7        | 1194.62   |           | 37.3            | 1195.02   |           |
|             |           |          | 36.4        | 1194.84   |           | 40.3            | 1195.24   |           |
|             |           |          | 39.4        | 1195.05   | BKF       | 43.3            | 1195.62   |           |
|             |           |          | 42.4        | 1195.32   |           | 46.3            | 1195.96   |           |
|             |           |          | 45.4        | 1195.60   |           | 49.3            | 1196.00   |           |
|             |           |          | 48.4        | 1195.87   |           | 52.3            | 1196.52   |           |
|             |           |          | 51.4        | 1196.25   |           | 55.3            | 1196.96   |           |
|             |           |          | 54.4        | 1196.72   |           | 58.3            | 1197.43   |           |
|             |           |          | 57.4        | 1197.21   |           | 61.3            | 1197.75   |           |
|             |           |          | 60.4        | 1197.45   |           | 64.3            | 1198.11   |           |
|             |           |          | 63.4        | 1197.95   |           | 67.3            | 1198.20   |           |
|             |           |          | 66.4        | 1198.065  |           | 70.3            | 1198.32   |           |
|             |           |          | 69.4        | 1198.185  |           | 73.3            | 1198.37   |           |
|             |           |          | 78.4        | 1198.135  |           | 80.25           | 1198.51   |           |
|             |           |          | 80.3        | 1198.105  | Right Pin | 80.3            | 1198.485  | Right Pin |



Photo of Cross-Section #6 - Looking Downstream @ STA 44+37


|            | 2004 | 2003 | AS-BUILT |
|------------|------|------|----------|
| Area       | 21.7 | 24.9 | 29.9     |
| Width      | 21.3 | 21.6 | 18.0     |
| Mean Depth | 1.0  | 1.2  | 1.7      |
| Max Depth  | 1.8  | 1.8  | 2.5      |
| W/D        | 20.8 | 18.7 | 10.8     |

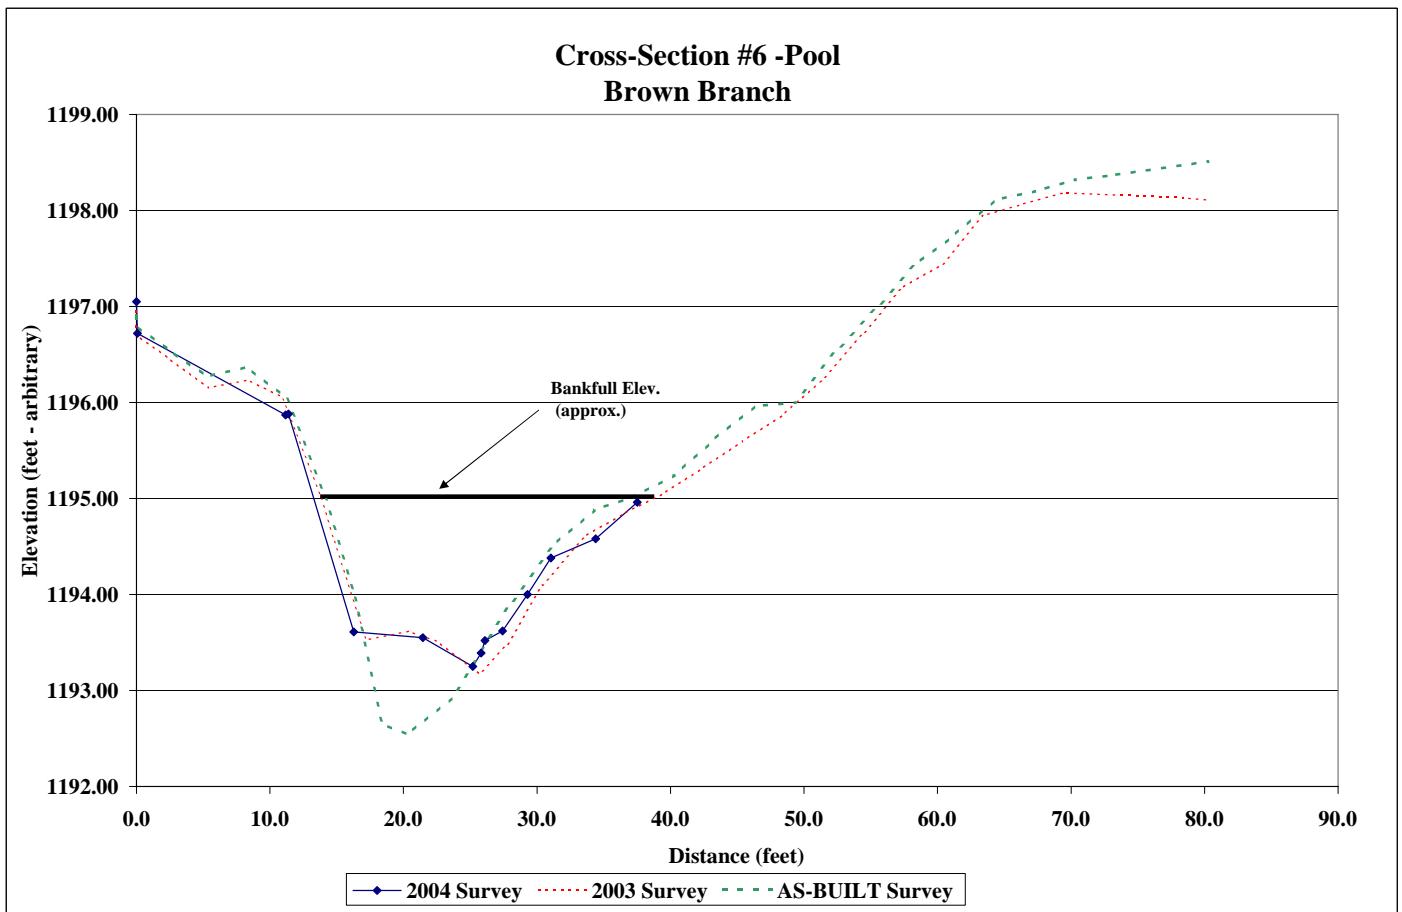

|                      |                     |
|----------------------|---------------------|
| <b>Project Name</b>  | Brown Branch        |
| <b>Cross Section</b> | #6                  |
| <b>Feature</b>       | Pool                |
| <b>Date</b>          | 6/3/04              |
| <b>Crew</b>          | Bidelspach, Clinton |

| <b>Description</b>                     | <b>Material</b>    | <b>Size (mm)</b> | <b>As-Built</b>     |          | <b>2004</b>         |                      | <b>%</b> | <b>Cum %</b> |
|--|--------------------|------------------|---------------------|----------|---------------------|----------------------|----------|--------------|
|  |                    |                  | <b>Riffle - Bed</b> | <b>%</b> | <b>Riffle - Bed</b> | <b>Riffle - Bank</b> |          |              |
| Silt/Clay                              | silt/clay          | 0.061            | 0                   | 0.0%     | 0.0%                | 0                    | 0.0%     | 0.0%         |
| <b>Sand</b>                            | very fine sand     | 0.062            | 3                   | 2.4%     | 2.4%                | 0                    | 0.0%     | 0.0%         |
|  | fine sand          | 0.125            | 4                   | 3.3%     | 5.7%                | 0                    | 1.0%     | 1.0%         |
|  | medium sand        | 0.25             | 6                   | 4.9%     | 10.6%               | 2                    | 16.0%    | 17.0%        |
|  | course sand        | 0.50             | 6                   | 4.9%     | 15.4%               | 2                    | 16.0%    | 33.0%        |
|  | very coarse sand   | 1.0              | 9                   | 7.3%     | 22.8%               | 13                   | 18.0%    | 51.0%        |
|  | very fine gravel   | 2.0              | 4                   | 3.3%     | 26.0%               | 6                    | 7.0%     | 58.0%        |
| <b>G<br/>r<br/>a<br/>v<br/>e<br/>l</b> | fine gravel        | 4.0              | 4                   | 3.3%     | 29.3%               | 4                    | 5.0%     | 63.0%        |
|  | fine gravel        | 5.7              | 3                   | 2.4%     | 31.7%               | 2                    | 2.0%     | 65.0%        |
|  | medium gravel      | 8.0              | 6                   | 4.9%     | 36.6%               | 3                    | 4.0%     | 69.0%        |
|  | medium gravel      | 11.3             | 11                  | 8.9%     | 45.5%               | 2                    | 7.0%     | 76.0%        |
|  | course gravel      | 16.0             | 12                  | 9.8%     | 55.3%               | 2                    | 3.0%     | 79.0%        |
|  | course gravel      | 22.6             | 20                  | 16.3%    | 71.5%               | 0                    | 2.0%     | 81.0%        |
|  | very coarse gravel | 32               | 18                  | 14.6%    | 86.2%               | 1                    | 3.0%     | 84.0%        |
|  | very coarse gravel | 45               | 4                   | 3.3%     | 89.4%               | 1                    | 2.0%     | 87.0%        |
|  | small cobble       | 64               | 4                   | 3.3%     | 92.7%               | 2                    | 3.0%     | 90.0%        |
|  | medium cobble      | 90               | 5                   | 4.1%     | 96.7%               | 3                    | 3.0%     | 93.0%        |
| <b>Cobble</b>                          | large cobble       | 128              | 1                   | 0.8%     | 97.6%               | 3                    | 3.0%     | 96.0%        |
|  | very large cobble  | 180              | 2                   | 1.6%     | 99.2%               | 4                    | 4.0%     | 100.0%       |
| <b>Boulder</b>                         | small boulder      | 256              | 1                   | 0.8%     | 100.0%              | 0                    | 0.0%     | 100.0%       |
| <b>Boulder</b>                         | small boulder      | 362              | 0                   | 0.0%     | 100.0%              | 0                    | 0.0%     | 100.0%       |
|  | medium boulder     | 512              | 0                   | 0.0%     | 100.0%              | 0                    | 0.0%     | 100.0%       |
|  | large boulder      | 1024             | 0                   | 0.0%     | 100.0%              | 0                    | 0.0%     | 100.0%       |
|  | very large boulder | 2049             | 0                   | 0.0%     | 100.0%              | 0                    | 0.0%     | 100.0%       |
| <b>Bedrock</b>                         | bedrock            | 40096            | 0                   | 0.0%     | 100.0%              | 0                    | 0.0%     | 100.0%       |
| <b>TOTAL / % of whole count</b>        |                    | 123              | 100.0%              |          | 50                  | 50                   | 100.0%   |              |

|             | <b>d16</b> | <b>d35</b> | <b>d50</b> | <b>d85</b> | <b>d95</b> |
|-------------|------------|------------|------------|------------|------------|
| <b>2004</b> | 0.36       | 0.83       | 1.46       | 38.50      | 139.00     |

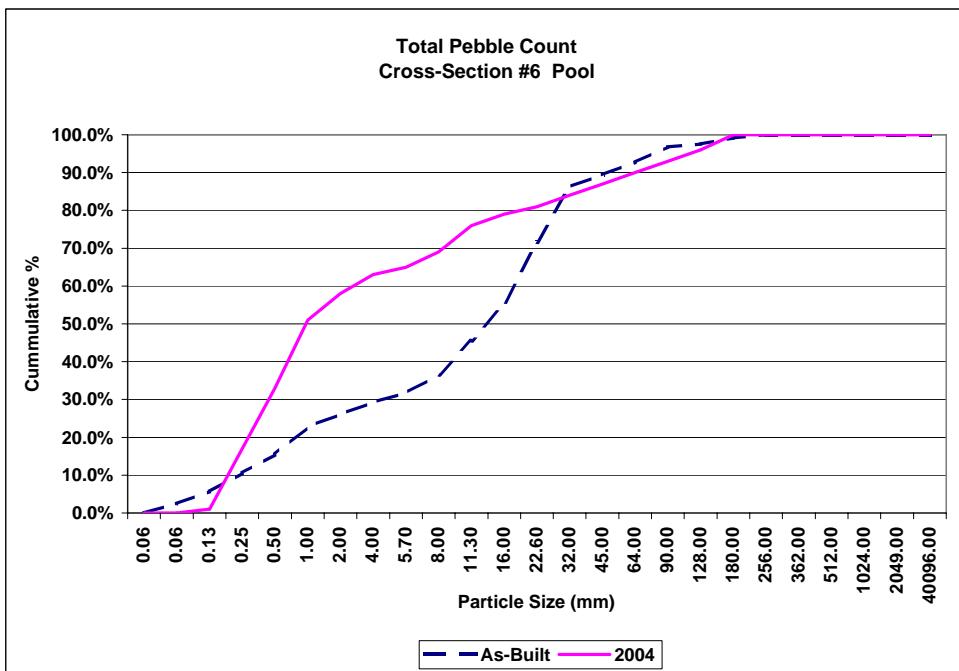



STA 0+25 Looking Upstream at Beginning of Project



STA 0+30 Bank Erosion Right Bank Looking Downstream



STA 1+25 Down-cut Streambed at a Single Vane Looking Downstream



STA 2+00 Bank Erosion Looking Downstream



STA 2+90 Bank Blowout and Forming Bench Looking Downstream



STA 4+00 Bank Erosion Right Bank Looking Downstream



STA 6+75 Bank Erosion Left Bank Looking Downstream



STA 7+70 Point Bar and Bank Erosion Looking Upstream



STA 8+20 Riffle Looking Downstream



STA 9+70 Down-cut Log Sill Looking Downstream



STA 14+75 Looking Downstream @BankErosion



STA 16+50 Looking Downstream @ Single Log Vane and Bank Scour



STA 18+50 Looking Downstream @Failing Boulder Wall



STA 20+50 Looking Downstream @ Wide Meander Bend with Exposed Toe Log



STA 20+70 Looking Downstream @Exposed Toe Log



STA 21+30 Looking Downstream @ Bank Erosion Tight Radius of Curvature



STA 23+10 Looking Downstream @A Good Point Bar



STA 25+90 Looking Downstream @Failing Boulder Wall




STA 28+50 Looking Downstream @ Bank Erosion Tight Radius of Curvature



STA 29+00 Looking Downstream @Bank Erosion




STA 30+20 Looking @ Left Bank Rill and Gully Erosion

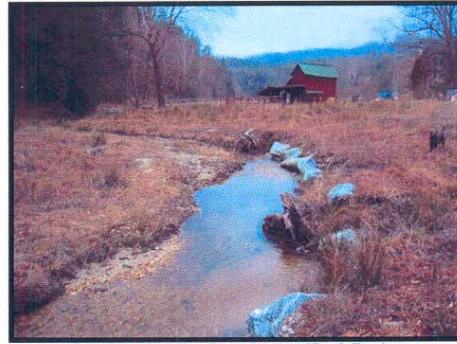

STA 33+25 Looking Downstream @Bank Erosion



STA 35+10 Looking Downstream @Bank Erosion

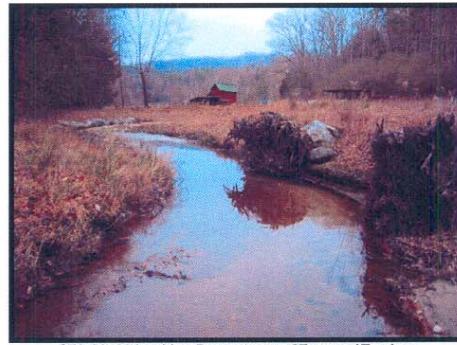

STA 36+80 Looking Downstream @Exposed Toe Log



STA 36+90 Downstream @ Bank Erosion



STA 37+40 Downstream @ Down-cut Log Vane



STA 38+50 Looking Downstream @ Valley Bank Erosion



STA 39+70 Downstream @ Mid-Channel and Bank Erosion



STA 39+90 Downstream @ Mid-Channel and Bank Erosion



STA 39+90 Downstream Erosion



STA 41+50 Looking Downstream @Lateral Channel Bar



STA 42+10 Looking Downstream @Root Wad Scour



STA 43+10 Looking Downstream @Severe Mid-Channel Bar



STA 44+00 Looking Downstream @High Root Wad and MCB



STA 45+40 Looking Downstream @J-Hook and Boulder toe



STA 46+20 Looking Downstream @Failing Root Wad



STA 50+60 Looking Downstream @ Confluence with Mulberry Creek

| <b>OLD Station</b> | <b>Station</b> | <b>Elevation</b> | <b>Description</b>                                |
|--------------------|----------------|------------------|---|
| 0                  | 5142.5         | 1186.95          | confluence with Mulberry Creek                    |
| 12.6               | 5129.9         | 1187.46          | BOR   |
| 31                 | 5111.5         | 1187.99          | MOR   |
| 55.2               | 5087.3         | 1188.33          | TOR   |
| 57.8               | 5084.7         | 1187.79          | pool D/S of rock vane                             |
| 64                 | 5078.5         | 1188.24          | rock vane (but doesn't extend into flow this far) |
| 69.8               | 5072.7         | 1188.08          | along RW, no pool                                 |
| 89.8               | 5052.7         | 1187.80          | D/S of J-vane rock                                |
| 90.3               | 5052.2         | 1189.34          | top of J-vane rock                                |
| 91.8               | 5050.7         | 1188.41          | U/S end J-vane, BOR                               |
| 107.2              | 5035.3         | 1188.67          | MOR   |
| 135.8              | 5006.7         | 1189.21          | TOR   |
| 147                | 4995.5         | 1188.69          | in pool   |
| 165.4              | 4977.1         | 1188.65          | in pool   |
| 174.5              | 4968           | 1188.85          | in pool   |
| 183.3              | 4959.2         | 1189.04          | extended run                                      |
| 203.4              | 4939.1         | 1189.25          | BOR, in bend                                      |
| 222.3              | 4920.2         | 1189.85          | TOR, in bend                                      |
| 224.8              | 4917.7         | 1189.46          | in pool   |
| 228.3              | 4914.2         | 1189.52          | just D/S of J-vane                                |
| 229.4              | 4913.1         | 1191.11          | top of middle J-vane rock                         |
| 230.5              | 4912           | 1189.93          | BOR, U/S of J-vane                                |
| 250.5              | 4892           | 1190.51          | MOR   |
| 286.6              | 4855.9         | 1190.74          | TOR   |
| 302.7              | 4839.8         | 1189.98          | on rock vane, buried?                             |
| 313.1              | 4829.4         | 1189.39          | in pool along RW                                  |
| 327.7              | 4814.8         | 1189.71          | in pool   |
| 338.7              | 4803.8         | 1190.15          | in pool   |
| 344.2              | 4798.3         | 1190.37          | D/S side J-vane                                   |
| 345.9              | 4796.6         | 1190.63          | top of J-vane, BOR                                |
| 364.3              | 4778.2         | 1190.73          | TOR   |
| 376                | 4766.5         | 1190.62          | in pool   |
| 390.4              | 4752.1         | 1190.65          | in pool by RW                                     |
| 398.7              | 4743.8         | 1190.71          | D/S end little bar                                |
| 407.2              | 4735.3         | 1190.54          | U/S end little bar                                |
| 410.4              | 4732.1         | 1189.66          | pool, deep part                                   |
| 412.2              | 4730.3         | 1190.24          | bottom edge cross vane                            |
| 414.3              | 4728.2         | 1191.30          | cross vane, BOR                                   |
| 457.7              | 4684.8         | 1191.84          | TOR   |
| 469.2              | 4673.3         | 1191.24          | in pool at RW #2 of 2                             |
| 490.2              | 4652.3         | 1191.40          | in pool along LBP                                 |
| 503.2              | 4639.3         | 1191.30          | pool at RW #1 of 2                                |
| 527.4              | 4615.1         | 1191.95          | BOR   |
| 538.7              | 4603.8         | 1192.31          | D/S side J-vane, no pool, still riffley           |
| 540.4              | 4602.1         | 1192.95          | top J-vane rock                                   |
| 541.7              | 4600.8         | 1192.24          | U/S side J-vane                                   |
| 567.2              | 4575.3         | 1193.00          | MOR   |
| 602.2              | 4540.3         | 1193.56          | TOR, much loose sediment                          |

|        |        |         |  |
|--------|--------|---------|--|
| 626.9  | 4515.6 | 1193.14 | rock vane, buried?, much loose sediment            |
| 639.9  | 4502.6 | 1192.29 | RW #3 of 3, pool                                   |
| 658.8  | 4483.7 | 1192.90 | RW #2 of 3, pool                                   |
| 673.5  | 4469   | 1192.48 | RW #1 of 3, pool                                   |
| 691.5  | 4451   | 1193.14 | pool   |
| 700.4  | 4442.1 | 1193.23 | D/S edge rock J-vane                               |
| 700.9  | 4441.6 | 1193.62 | rock J-vane  |
| 707.2  | 4435.3 | 1193.69 | bottom of bar                                      |
| 719.7  | 4422.8 | 1193.56 | on U/S end small bar                               |
| 724.4  | 4418.1 | 1193.39 | in pool  |
| 726.5  | 4416   | 1193.51 | D/S side log vane                                  |
| 727.2  | 4415.3 | 1194.18 | on log vane  |
| 730    | 4412.5 | 1193.77 | BOR  |
| 767.2  | 4375.3 | 1194.38 | MOR  |
| 797.5  | 4345   | 1194.43 | TOR  |
| 824.2  | 4318.3 | 1193.51 | in pool, next to RW 3 of 3                         |
| 854.8  | 4287.7 | 1193.36 | in pool  |
| 860.2  | 4282.3 | 1193.66 | in pool  |
| 880.7  | 4261.8 | 1193.62 | in pool, next to RW 1 of 3                         |
| 891.8  | 4250.7 | 1193.86 | in pool  |
| 899.2  | 4243.3 | 1194.24 | D/S side cross vane                                |
| 899.8  | 4242.7 | 1194.92 | cross vane, BOR                                    |
| 934.2  | 4208.3 | 1195.08 | MOR  |
| 964.7  | 4177.8 | 1195.21 | D/S side rock vane, TOR                            |
| 967.2  | 4175.3 | 1195.08 | rock vane  |
| 980.2  | 4162.3 | 1194.44 | in pool  |
| 992.5  | 4150   | 1194.54 | in pool  |
| 1000.3 | 4142.2 | 1194.79 | pool at RW   |
| 1017.4 | 4125.1 | 1195.24 | BOR  |
| 1027.5 | 4115   | 1195.20 | D/S J-vane   |
| 1028.4 | 4114.1 | 1196.52 | on J-vane rock                                     |
| 1030.1 | 4112.4 | 1195.49 | U/S J-vane   |
| 1057.6 | 4084.9 | 1195.90 | MOR  |
| 1090.9 | 4051.6 | 1196.28 | TOR  |
| 1101.9 | 4040.6 | 1195.60 | in pool  |
| 1112.5 | 4030   | 1195.71 | in pool  |
| 1130.3 | 4012.2 | 1196.43 | bottom bar in pool                                 |
| 1133.1 | 4009.4 | 1196.03 | in pool  |
| 1138.6 | 4003.9 | 1196.36 | top bar in pool                                    |
| 1144.9 | 3997.6 | 1195.72 | D/S edge cross vane                                |
| 1146.1 | 3996.4 | 1196.58 | cross vane   |
| 1171.2 | 3971.3 | 1196.98 | MOR  |
| 1200.1 | 3942.4 | 1197.22 | TOR  |
| 1207.6 | 3934.9 | 1196.60 | in pool  |
| 1215.5 | 3927   | 1196.31 | in pool, end of LBP                                |
| 1228.5 | 3914   | 1196.85 | in pool  |
| 1235.4 | 3907.1 | 1197.37 | BOR, in bend                                       |
| 1260.2 | 3882.3 | 1197.67 | TOR, in bend                                       |
| 1271.5 | 3871   | 1196.42 | in pool  |
| 1276.6 | 3865.9 | 1196.52 | confluence with ephemeral trib below barn, in pool |
| 1282.2 | 3860.3 | 1197.18 | in pool  |
| 1296.7 | 3845.8 | 1197.91 | D/S side log vane                                  |

|        |        |         |                               |
|--------|--------|---------|-------------------------------|
| 1298.1 | 3844.4 | 1198.17 | log vane BOR                  |
| 1342.2 | 3800.3 | 1198.21 | MOR                           |
| 1372.2 | 3770.3 | 1198.84 | big rock (bedrock?), MOR      |
| 1399   | 3743.5 | 1198.87 | TOR                           |
| 1407.2 | 3735.3 | 1198.15 | in pool                       |
| 1412   | 3730.5 | 1198.22 | in pool                       |
| 1415.7 | 3726.8 | 1199.08 | BOR, local, in bend           |
| 1422.2 | 3720.3 | 1199.24 | TOR, local, in bend           |
| 1425.1 | 3717.4 | 1198.86 | in pool                       |
| 1426.6 | 3715.9 | 1198.47 | D/S side log vane             |
| 1427.9 | 3714.6 | 1199.58 | exposed log vane              |
| 1449.6 | 3692.9 | 1199.50 | MOR                           |
| 1474.1 | 3668.4 | 1199.44 | TOR                           |
| 1487.9 | 3654.6 | 1199.07 | pool                          |
| 1501.7 | 3640.8 | 1199.16 | pool                          |
| 1518.2 | 3624.3 | 1199.61 | pool                          |
| 1567.4 | 3575.1 | 1199.89 | BOR                           |
| 1582.2 | 3560.3 | 1200.43 | MOR                           |
| 1609.1 | 3533.4 | 1200.81 | MOR                           |
| 1638.6 | 3503.9 | 1200.74 | TOR                           |
| 1646.9 | 3495.6 | 1200.03 | pool                          |
| 1652   | 3490.5 | 1200.23 | pool                          |
| 1661   | 3481.5 | 1200.55 | D/S side cross vane           |
| 1662.7 | 3479.8 | 1200.83 | cross vane                    |
| 1664.3 | 3478.2 | 1200.93 | BOR                           |
| 1689   | 3453.5 | 1201.02 | MOR                           |
| 1713.6 | 3428.9 | 1200.99 | TOR                           |
| 1726.3 | 3416.2 | 1200.42 | in pool                       |
| 1733.5 | 3409   | 1200.51 | in pool                       |
| 1741.7 | 3400.8 | 1200.81 | in pool                       |
| 1748.5 | 3394   | 1201.31 | BOR, local in bend            |
| 1754.8 | 3387.7 | 1201.37 | TOR, local in bend            |
| 1765.6 | 3376.9 | 1200.79 | pool, deep part near RW #1    |
| 1774.3 | 3368.2 | 1201.33 | BOR                           |
| 1784.5 | 3358   | 1201.75 | D/S side log vane             |
| 1785.7 | 3356.8 | 1201.80 | log vane                      |
| 1812.3 | 3330.2 | 1201.87 | MOR                           |
| 1834.5 | 3308   | 1202.02 | TOR                           |
| 1851.7 | 3290.8 | 1201.49 | mid pool                      |
| 1867.9 | 3274.6 | 1201.49 | mid pool                      |
| 1879   | 3263.5 | 1201.63 | mid pool                      |
| 1886   | 3256.5 | 1202.33 | BOR                           |
| 1911.2 | 3231.3 | 1202.84 | MOR                           |
| 1938.9 | 3203.6 | 1203.02 | TOR                           |
| 1945.3 | 3197.2 | 1202.47 | pool, deep part between 2 RWs |
| 1949.2 | 3193.3 | 1202.76 | pool                          |
| 1958.9 | 3183.6 | 1203.20 | BOR (mini)                    |
| 1973.3 | 3169.2 | 1203.60 | TOR (mini)                    |
| 1974.5 | 3168   | 1203.07 | pool, deep part               |
| 1978.3 | 3164.2 | 1203.42 | D/S side log vane             |
| 1979.7 | 3162.8 | 1204.24 | exposed log vane              |
| 2006.9 | 3135.6 | 1204.32 | MOR                           |

|        |        |         |   |
|--------|--------|---------|---|
| 2032.3 | 3110.2 | 1204.52 | TOR                                       |
| 2038.7 | 3103.8 | 1203.83 | pool U/S of RW #2 in bend, deep part      |
| 2049.9 | 3092.6 | 1203.95 | pool U/S of RW #1 in bend                 |
| 2056.6 | 3085.9 | 1204.35 | tributary confluence                      |
| 2071.9 | 3070.6 | 1204.46 | end of pool                               |
| 2080.1 | 3062.4 | 1203.85 | pool, deep part                           |
| 2086.3 | 3056.2 | 1204.25 | pool                                      |
| 2095.5 | 3047   | 1204.57 | BOR, local in bend, along rock wall       |
| 2103.1 | 3039.4 | 1204.82 | TOR, local in bend, along rock wall       |
| 2107.1 | 3035.4 | 1203.85 | pool, deep part                           |
| 2109.3 | 3033.2 | 1203.97 | D/S side of cross vane                    |
| 2110.5 | 3032   | 1205.55 | cross vane                                |
| 2151.2 | 2991.3 | 1205.85 | MOR                                       |
| 2182.2 | 2960.3 | 1205.88 | MOR                                       |
| 2207.6 | 2934.9 | 1206.16 | TOR                                       |
| 2214.8 | 2927.7 | 1205.80 | pool, deep part                           |
| 2220.2 | 2922.3 | 1205.86 | pool                                      |
| 2230.7 | 2911.8 | 1206.23 | BOR                                       |
| 2255.9 | 2886.6 | 1207.31 | top of middle log J-hook rock             |
| 2258.9 | 2883.6 | 1206.82 | just U/S of log J-hook                    |
| 2302.2 | 2840.3 | 1207.26 | MOR                                       |
| 2327.2 | 2815.3 | 1207.48 | TOR                                       |
| 2345   | 2797.5 | 1207.42 | pool                                      |
| 2368.4 | 2774.1 | 1207.23 | pool, deep part                           |
| 2381.7 | 2760.8 | 1207.67 | BOR                                       |
| 2391.4 | 2751.1 | 1207.72 | D/S side of log vane                      |
| 2393.6 | 2748.9 | 1207.94 | log vane                                  |
| 2423.8 | 2718.7 | 1208.28 | MOR                                       |
| 2453.9 | 2688.6 | 1208.60 | TOR                                       |
| 2458.8 | 2683.7 | 1208.24 | pool, deep part                           |
| 2461.5 | 2681   | 1208.75 | BOR, tiny intermediate riffle between RWs |
| 2473.7 | 2668.8 | 1208.83 | TOR, tiny intermediate riffle between RWs |
| 2482.2 | 2660.3 | 1208.32 | pool in front of RW                       |
| 2485.7 | 2656.8 | 1208.71 | in pool                                   |
| 2499.4 | 2643.1 | 1208.84 | D/S edge log vane, BOR                    |
| 2501.8 | 2640.7 | 1209.06 | log vane                                  |
| 2501.8 | 2640.7 | 1208.35 | pool, deep part                           |
| 2532.7 | 2609.8 | 1209.26 | MOR                                       |
| 2564   | 2578.5 | 1209.79 | TOR                                       |
| 2572.9 | 2569.6 | 1209.58 | in pool                                   |
| 2578.1 | 2564.4 | 1209.52 | top pool, begin channel plug protection   |
| 2593.2 | 2549.3 | 1209.52 | glide-ish, irregular section              |
| 2615.2 | 2527.3 | 1209.80 | glide-ish, irregular section              |
| 2642.5 | 2500   | 1210.19 | TOR, irregular section                    |
| 2666.1 | 2476.4 | 1209.77 | in glide, irregular section               |
| 2694.9 | 2447.6 | 1210.00 | begin glide, irregular section            |
| 2697   | 2445.5 | 1209.80 | in small pool along RW                    |
| 2701.5 | 2441   | 1210.12 | extended run                              |
| 2711.2 | 2431.3 | 1210.24 | extended run                              |
| 2730.2 | 2412.3 | 1210.38 | BOR                                       |
| 2752.7 | 2389.8 | 1210.79 | MOR                                       |
| 2783.9 | 2358.6 | 1211.29 | MOR                                       |

|        |        |         |                                 |
|--------|--------|---------|---------------------------------|
| 2805.4 | 2337.1 | 1211.60 | TOR                             |
| 2813.5 | 2329   | 1210.98 | in pool                         |
| 2818   | 2324.5 | 1211.47 | BOR, mini riffle                |
| 2832.5 | 2310   | 1211.75 | TOR, mini riffle                |
| 2839   | 2303.5 | 1211.27 | in pool                         |
| 2844.1 | 2298.4 | 1211.21 | in pool                         |
| 2850   | 2292.5 | 1211.87 | BOR                             |
| 2859.8 | 2282.7 | 1211.96 | D/S of log vane                 |
| 2861.9 | 2280.6 | 1212.53 | on log vane                     |
| 2892.2 | 2250.3 | 1212.89 | MOR                             |
| 2922.2 | 2220.3 | 1213.09 | MOR                             |
| 2952.4 | 2190.1 | 1213.22 | MOR                             |
| 2982.2 | 2160.3 | 1213.29 | MOR                             |
| 2996.4 | 2146.1 | 1213.41 | TOR                             |
| 3007.2 | 2135.3 | 1212.81 | in pool                         |
| 3022.2 | 2120.3 | 1212.67 | in pool                         |
| 3037.2 | 2105.3 | 1213.23 | in pool                         |
| 3052.2 | 2090.3 | 1213.07 | in pool                         |
| 3063.7 | 2078.8 | 1213.39 | BOR                             |
| 3082.2 | 2060.3 | 1213.50 | MOR                             |
| 3092.2 | 2050.3 | 1213.32 | MOR                             |
| 3123.2 | 2019.3 | 1213.57 | MOR                             |
| 3146.2 | 1996.3 | 1213.49 | MOR                             |
| 3172.2 | 1970.3 | 1213.95 | MOR                             |
| 3202.1 | 1940.4 | 1214.29 | MOR                             |
| 3211.2 | 1931.3 | 1214.54 | MOR                             |
| 3232.2 | 1910.3 | 1214.54 | MOR                             |
| 3262.2 | 1880.3 | 1214.88 | MOR                             |
| 3287.2 | 1855.3 | 1215.03 | MOR                             |
| 3314.2 | 1828.3 | 1215.41 | TOR                             |
| 3341.2 | 1801.3 | 1215.41 |                                 |
| 3367.2 | 1775.3 | 1215.23 | in elongate pool/run along pond |
| 3385.7 | 1756.8 | 1215.59 | BOR                             |
| 3404.1 | 1738.4 | 1216.41 | on buried log vane              |
| 3407.9 | 1734.6 | 1216.42 | on bedrock, MOR                 |
| 3423.4 | 1719.1 | 1216.62 | MOR, along pond                 |
| 3452.2 | 1690.3 | 1216.69 | MOR, along pond                 |
| 3482.2 | 1660.3 | 1216.77 | MOR, along pond                 |
| 3510.6 | 1631.9 | 1216.85 | TOR                             |
| 3515.5 | 1627   | 1216.39 | in pool                         |
| 3524.6 | 1617.9 | 1216.10 | pool, deep part                 |
| 3529.3 | 1613.2 | 1216.25 | in pool                         |
| 3539.6 | 1602.9 | 1216.99 | BOR                             |
| 3575.6 | 1566.9 | 1217.93 | on bedrock, MOR                 |
| 3599.7 | 1542.8 | 1218.05 | TOR                             |
| 3609.3 | 1533.2 | 1217.09 | in pool                         |
| 3615.5 | 1527   | 1217.58 | in pool                         |
| 3625.2 | 1517.3 | 1217.65 | in pool                         |
| 3630.8 | 1511.7 | 1217.51 | in pool, deep part              |
| 3636.4 | 1506.1 | 1218.32 | end of riffle                   |
| 3643.7 | 1498.8 | 1218.16 | D/S of log vane                 |
| 3646   | 1496.5 | 1218.57 | on log vane                     |

|        |        |         |   |
|--------|--------|---------|---|
| 3656   | 1486.5 | 1218.98 | bedrock, MOR                              |
| 3682.2 | 1460.3 | 1218.93 | MOR                                       |
| 3702.4 | 1440.1 | 1218.87 | MOR                                       |
| 3718   | 1424.5 | 1219.08 | MOR                                       |
| 3740.2 | 1402.3 | 1219.24 | MOR                                       |
| 3759.3 | 1383.2 | 1219.05 | TOR                                       |
| 3766   | 1376.5 | 1218.99 | in pool                                   |
| 3774.6 | 1367.9 | 1218.51 | pool, deep part                           |
| 3779.3 | 1363.2 | 1219.29 | D/S edge log vane                         |
| 3782.7 | 1359.8 | 1219.79 | log vane, BOR                             |
| 3796.7 | 1345.8 | 1219.67 | MOR                                       |
| 3815.8 | 1326.7 | 1219.89 | TOR                                       |
| 3842.1 | 1300.4 | 1219.89 | on bedrock, long run, through slight bend |
| 3858.7 | 1283.8 | 1220.30 | long run, through slight bend             |
| 3877.4 | 1265.1 | 1220.29 | BOR                                       |
| 3902.3 | 1240.2 | 1220.58 | on bedrock, MOR                           |
| 3925.6 | 1216.9 | 1220.79 | MOR                                       |
| 3945.7 | 1196.8 | 1220.79 | MOR                                       |
| 3961.2 | 1181.3 | 1221.18 | TOR, on bedrock                           |
| 3966.9 | 1175.6 | 1220.91 | in pool                                   |
| 3974.9 | 1167.6 | 1220.44 | in pool                                   |
| 3982.2 | 1160.3 | 1220.83 | in pool                                   |
| 3987.5 | 1155   | 1220.71 | in pool                                   |
| 3996.2 | 1146.3 | 1220.75 | below rock vane                           |
| 3999.1 | 1143.4 | 1221.19 | rock vane                                 |
| 4039   | 1103.5 | 1221.53 | TOR                                       |
| 4051.7 | 1090.8 | 1221.45 | glide                                     |
| 4064.6 | 1077.9 | 1220.88 | in pool                                   |
| 4073.8 | 1068.7 | 1220.99 | in pool                                   |
| 4082.5 | 1060   | 1221.15 | in pool                                   |
| 4088.6 | 1053.9 | 1221.30 | in pool                                   |
| 4095.5 | 1047   | 1221.69 | BOR                                       |
| 4113.8 | 1028.7 | 1222.23 | MOR, bedrock                              |
| 4132.6 | 1009.9 | 1222.26 | TOR                                       |
| 4136.3 | 1006.2 | 1221.88 | confluence with creek                     |
| 4138   | 1004.5 | 1221.42 | pool, deep part                           |
| 4143.7 | 998.8  | 1222.45 | BOR                                       |
| 4167.7 | 974.8  | 1223.07 | MOR                                       |
| 4188.2 | 954.3  | 1223.14 | bottom log vane                           |
| 4190.2 | 952.3  | 1223.32 | top log vane                              |
| 4203.7 | 938.8  | 1223.39 | TOR                                       |
| 4227.4 | 915.1  | 1223.21 | in pool                                   |
| 4237.3 | 905.2  | 1223.09 | pool, deep part                           |
| 4247.8 | 894.7  | 1223.56 | BOR                                       |
| 4282.2 | 860.3  | 1224.05 | MOR                                       |
| 4315.7 | 826.8  | 1224.38 | TOR                                       |
| 4318.8 | 823.7  | 1223.75 | pool, deep part                           |
| 4320.7 | 821.8  | 1224.03 | bottom of structure                       |
| 4321.9 | 820.6  | 1225.26 | top of cross vane, BOR                    |
| 4349.5 | 793    | 1225.27 | TOR                                       |
| 4358.1 | 784.4  | 1225.34 | in glide                                  |
| 4369.7 | 772.8  | 1224.63 | in pool                                   |

|        |       |         |   |
|--------|-------|---------|---|
| 4373.3 | 769.2 | 1224.31 | in pool, deep                           |
| 4380.4 | 762.1 | 1225.48 | BOR                                     |
| 4391.9 | 750.6 | 1225.74 | confluence with inflowing wetland oxbow |
| 4402.2 | 740.3 | 1225.91 | MOR                                     |
| 4423.9 | 718.6 | 1226.53 | MOR                                     |
| 4446.3 | 696.2 | 1226.59 | TOR                                     |
| 4460   | 682.5 | 1226.56 | in glide                                |
| 4465.2 | 677.3 | 1225.96 | in pool                                 |
| 4471.9 | 670.6 | 1225.50 | deep part of pool                       |
| 4479.4 | 663.1 | 1226.52 | top of pool, lots of sediment           |
| 4486.9 | 655.6 | 1226.59 | BOR, lots of sediment                   |
| 4508.9 | 633.6 | 1226.85 | MOR                                     |
| 4537.3 | 605.2 | 1227.17 | TOR                                     |
| 4540.4 | 602.1 | 1227.04 | end pool                                |
| 4547.6 | 594.9 | 1225.98 | bottom of cross vane D/S                |
| 4549.8 | 592.7 | 1227.96 | top of cross vane                       |
| 4582.2 | 560.3 | 1228.09 | MOR                                     |
| 4602.9 | 539.6 | 1228.32 | MOR                                     |
| 4637.2 | 505.3 | 1228.69 | bedrock outcrop                         |
| 4669   | 473.5 | 1229.36 | MOR at large rock, placed along L/B     |
| 4695.8 | 446.7 | 1230.13 | MOR                                     |
| 4721.3 | 421.2 | 1230.71 | TOR                                     |
| 4726.5 | 416   | 1230.22 | in pool, along RW                       |
| 4729.8 | 412.7 | 1230.08 | in pool, along RW                       |
| 4733.8 | 408.7 | 1231.03 | bottom bar (in pool zone)               |
| 4743.7 | 398.8 | 1231.09 | top bar (in pool zone)                  |
| 4748.9 | 393.6 | 1230.78 | D/S edge log vane                       |
| 4750.3 | 392.2 | 1231.03 | log vane, BOR                           |
| 4766.1 | 376.4 | 1231.18 | TOR                                     |
| 4776.7 | 365.8 | 1230.91 | deep part, short pool                   |
| 4789.5 | 353   | 1231.18 | BOR                                     |
| 4816.2 | 326.3 | 1231.80 | MOR                                     |
| 4836.6 | 305.9 | 1232.16 | TOR                                     |
| 4841.4 | 301.1 | 1231.81 | in short pool                           |
| 4846   | 296.5 | 1231.93 | drop D/S of log vane                    |
| 4847.1 | 295.4 | 1233.06 | on log vane                             |
| 4891.6 | 250.9 | 1233.66 | MOR                                     |
| 4930.2 | 212.3 | 1234.20 | TOR                                     |
| 4952.2 | 190.3 | 1233.74 | mid pool                                |
| 4970.2 | 172.3 | 1233.68 | pool, deep part                         |
| 4981.2 | 161.3 | 1234.47 | BOR                                     |
| 4995.9 | 146.6 | 1234.31 | buried log vane                         |
| 5025.2 | 117.3 | 1234.68 | TOR                                     |
| 5041.7 | 100.8 | 1234.08 | mid pool                                |
| 5053.2 | 89.3  | 1233.92 | pool, deep part                         |
| 5061.8 | 80.7  | 1235.15 | BOR                                     |
| 5089.2 | 53.3  | 1235.19 | TOR                                     |
| 5110.2 | 32.3  | 1235.22 | mid pool                                |
| 5120.2 | 22.3  | 1234.92 | in pool, deep part                      |
| 5126.2 | 16.3  | 1235.70 | bottom of small bar in pool             |
| 5132.2 | 10.3  | 1235.78 | top of small bar in pool                |
| 5142.2 | 0.3   | 1234.76 | pool, deep part                         |

5142.5      0 1236.01 cross vane

| Point | Station | Elevation | Description | Point | Station | Elevation | Description | Point | Station | Elevation | Description |
|-------|---------|-----------|-------------|-------|---------|-----------|-------------|-------|---------|-----------|-------------|
| 5     | 1.47    | 1236.27   | (R)         | 10    | 1.62    | 1236.37   | Water       | 6     | 5.61    | 1238.94   | LBKF        |
| 7     | 6.06    | 1235.96   | (V)         | 11    | 5.91    | 1236.21   | Water       | 8     | 27.02   | 1237.94   | LBKF        |
| 9     | 9.4     | 1233.95   | (P)         | 12    | 8.76    | 1235.96   | Water       | 21    | 42.99   | 1236.31   | LBKF        |
| 13    | 13.86   | 1234.62   | (G)         | 16    | 14.3    | 1235.98   | Water       | 27    | 78.07   | 1238.5    | LBKF        |
| 17    | 24.76   | 1235.71   | (R)         | 18    | 24.68   | 1235.86   | Water       | 36    | 113.01  | 1237.41   | LBKF        |
| 14    | 25.16   | 1235.71   | (R)         | 22    | 37.91   | 1235.58   | Water       | 44    | 145.79  | 1237.18   | LBKF        |
| 20    | 37.79   | 1234.89   | (P)         | 26    | 53.97   | 1235.38   | Water       | 47    | 180.02  | 1236.5    | LBKF        |
| 23    | 39.79   | 1235.51   | (R)         | 29    | 57.59   | 1235.34   | Water       | 57    | 230.53  | 1235.12   | LBKF        |
| 24    | 40.1    | 1235.65   | (R)         | 32    | 84.17   | 1235.4    | Water       | 4267  | 241.81  | 1237.38   | LBKF        |
| 25    | 53.9    | 1235.02   | (T)         | 35    | 98.33   | 1234.96   | Water       | 4264  | 243.31  | 1234.7    | LBKF        |
| 28    | 57.56   | 1234.27   | (M)         | 39    | 112.22  | 1234.48   | Water       | 4265  | 243.31  | 1234.7    | LBKF        |
| 31    | 83.91   | 1235.2    | (R)         | 41    | 134.22  | 1234.54   | Water       | 4269  | 278.8   | 1234.8    | LBKF        |
| 34    | 97.95   | 1234.64   | (T)         | 43    | 144.07  | 1234.2    | Water       | 2354  | 300.27  | 1232.98   | LBKF        |
| 38    | 112.36  | 1234.02   | (T)         | 46    | 150.37  | 1234.18   | Water       | 4271  | 301.96  | 1234.39   | LBKF        |
| 40    | 134     | 1234.33   | (R)         | 49    | 157.09  | 1234.15   | Water       | 4272  | 313.55  | 1234.37   | LBKF        |
| 63    | 141.99  | 1234.63   | (LV)        | 51    | 165.96  | 1234.02   | Water       | 2353  | 317.85  | 1233.18   | LBKF        |
| 42    | 144.01  | 1233.8    | (P)         | 54    | 166.01  | 1234.15   | Water       | 4274  | 332.61  | 1233      | LBKF        |
| 45    | 150.16  | 1233.97   | (T)         | 59    | 174.88  | 1233.98   | Water       | 2351  | 336.77  | 1233.18   | LBKF        |
| 62    | 155.57  | 1234.29   | (LV)        | 61    | 202.83  | 1233.94   | Water       | 2348  | 349.53  | 1234.26   | LBKF        |
| 48    | 157.46  | 1233.42   | (P)         | 4302  | 221.35  | 1233.88   | Water       | 4276  | 353.95  | 1233.86   | LBKF        |
| 58    | 174.6   | 1233.77   | (T)         | 4300  | 236.19  | 1233.24   | Water       | 2345  | 378.03  | 1232.18   | LBKF        |
| 64    | 185.88  | 1233.55   | (T)         | 4298  | 245.91  | 1233.25   | Water       | 2343  | 394.8   | 1231.65   | LBKF        |
| 4301  | 221.39  | 1233.59   | (R)         | 4294  | 261.36  | 1233.21   | Water       | 2341  | 420.89  | 1231.77   | LBKF        |
| 4299  | 236.27  | 1233.04   | (U)         | 4296  | 267.7   | 1233.04   | Water       | 2339  | 439.39  | 1232.23   | LBKF        |
| 4297  | 245.91  | 1232.99   | (T)         | 4292  | 279     | 1232.98   | Water       | 2330  | 491.4   | 1232.17   | LBKF        |
| 4293  | 261.37  | 1233.01   | (R)         | 2273  | 291.81  | 1232.84   | Water       | 2328  | 504.03  | 1231.8    | LBKF        |
| 4295  | 266.72  | 1232.72   | (U)         | 2271  | 293.72  | 1232.59   | Water       | 2999  | 518.22  | 1231.25   | LBKF        |
| 4291  | 277.18  | 1232.4    | (T)         | 4288  | 294.59  | 1232.44   | Water       | 3001  | 550.93  | 1230.37   | LBKF        |
| 4289  | 288.07  | 1232.76   | (R)         | 2275  | 299.34  | 1232.42   | Water       | 3002  | 572.63  | 1230.37   | LBKF        |
| 2272  | 291.89  | 1232.41   | (T)         | 2277  | 312.01  | 1232.18   | Water       | 3004  | 602.57  | 1230.51   | LBKF        |
| 4287  | 293.54  | 1232.21   | (LV)        | 4286  | 321.45  | 1232.08   | Water       | 3008  | 634.75  | 1234.77   | LBKF        |
| 2270  | 293.74  | 1232.23   | (LV)        | 2289  | 330.27  | 1231.85   | Water       | 3006  | 637.61  | 1229.32   | LBKF        |
| 2274  | 299.34  | 1232.13   | (T)         | 4282  | 336.49  | 1231.49   | Water       | 402   | 658.47  | 1230.3    | LBKF        |
| 2276  | 311.98  | 1231.8    | (T)         | 4278  | 346.77  | 1231.45   | Water       | 401   | 658.61  | 1230.4    | LBKF        |
| 2278  | 319.79  | 1231.8    | (R)         | 2291  | 349.41  | 1231.52   | Water       | 399   | 667.65  | 1231.38   | LBKF        |
| 4285  | 320.44  | 1231.8    | (T)         | 2294  | 356.3   | 1231.43   | Water       | 397   | 684.33  | 1232.32   | LBKF        |
| 2288  | 330.22  | 1231.64   | (T)         | 2296  | 363.57  | 1231.38   | Water       | 396   | 695.21  | 1231.29   | LBKF        |
| 4281  | 335.53  | 1231.08   | (T)         | 2298  | 369.15  | 1231.32   | Water       | 394   | 703.58  | 1230.98   | LBKF        |
| 2290  | 349.36  | 1231.16   | (T)         | 2300  | 384.15  | 1230.79   | Water       | 393   | 724.46  | 1228.71   | LBKF        |
| 4279  | 356.24  | 1230.7    | (T)         | 2302  | 390.21  | 1230.48   | Water       | 391   | 745.15  | 1227.13   | LBKF        |
| 2293  | 356.36  | 1230.62   | (T)         | 2305  | 396.57  | 1230.48   | Water       | 389   | 774.73  | 1226.35   | LBKF        |
| 2295  | 363.68  | 1230.96   | (T)         | 2307  | 408.27  | 1230.39   | Water       | 387   | 808.97  | 1226.52   | LBKF        |
| 2297  | 369.2   | 1231      | (R)         | 2309  | 426.65  | 1230.19   | Water       | 385   | 845.96  | 1226.45   | LBKF        |
| 2299  | 383.91  | 1230.5    | (T)         | 2311  | 441.01  | 1229.96   | Water       | 383   | 889.94  | 1225.07   | LBKF        |
| 2301  | 390.43  | 1229.78   | (P)         | 2313  | 457.01  | 1229.77   | Water       | 381   | 929.78  | 1224.82   | LBKF        |
| 2303  | 393.31  | 1229.98   | (LV)        | 2315  | 471.55  | 1229.59   | Water       | 379   | 949.5   | 1225.05   | LBKF        |
| 2304  | 396.77  | 1229.69   | (T)         | 2317  | 486.81  | 1229.21   | Water       | 377   | 967.41  | 1224.8    | LBKF        |
| 2306  | 408.18  | 1229.89   | (T)         | 2319  | 489.31  | 1229.1    | Water       | 375   | 989.3   | 1225.84   | LBKF        |
| 2308  | 426.54  | 1229.93   | (R)         | 2321  | 496.53  | 1229.12   | Water       | 373   | 1013.25 | 1225.03   | LBKF        |
| 2310  | 440.86  | 1229.43   | (T)         | 2323  | 504.44  | 1229.03   | Water       | 371   | 1035.27 | 1225      | LBKF        |
| 2312  | 456.82  | 1229.24   | (T)         | 2327  | 508.27  | 1228.61   | Water       | 369   | 1064.91 | 1224.8    | LBKF        |
| 2314  | 471.53  | 1229.32   | (R)         | 2325  | 510.81  | 1228.45   | Water       | 364   | 1155.47 | 1222.62   | LBKF        |
| 2316  | 486.46  | 1228.96   | (U)         | 2996  | 514.61  | 1228.5    | Water       | 363   | 1196.22 | 1222.01   | LBKF        |
| 2318  | 489.04  | 1228.31   | (T)         | 2992  | 524.41  | 1228.41   | Water       | 361   | 1231.09 | 1221.83   | LBKF        |
| 2320  | 496.18  | 1228.26   | (T)         | 2994  | 531.19  | 1228.42   | Water       | 359   | 1257.82 | 1224.2    | LBKF        |
| 2322  | 504.49  | 1228.63   | (BED)       | 2990  | 547.56  | 1228.46   | Water       | 356   | 1285.66 | 1223.97   | LBKF        |
| 2326  | 508.63  | 1228.46   | (BED)       | 2988  | 573.74  | 1228.33   | Water       | 354   | 1290.02 | 1224.15   | LBKF        |
| 2324  | 510.66  | 1227.81   | (T)         | 2986  | 591.93  | 1228.19   | Water       | 352   | 1295.8  | 1222.53   | LBKF        |
| 2995  | 514.89  | 1227.85   | (T)         | 2984  | 593.19  | 1228      | Water       | 350   | 1306.78 | 1223.29   | LBKF        |
| 2991  | 524.1   | 1227.27   | (P)         | 2982  | 607.28  | 1228.04   | Water       | 348   | 1329.87 | 1221.12   | LBKF        |
| 2993  | 531.15  | 1227.66   | (G)         | 2980  | 619.95  | 1227.91   | Water       | 346   | 1363.52 | 1220.64   | LBKF        |
| 2989  | 547.38  | 1227.99   | (T)         | 77    | 630.11  | 1227.94   | Water       | 344   | 1383.27 | 1220.72   | LBKF        |
| 2987  | 572.66  | 1228      | (T)         | 75    | 642.62  | 1227.69   | Water       | 342   | 1416.83 | 1220.82   | LBKF        |
| 2985  | 591.86  | 1227.99   | (RV)        | 80    | 651.59  | 1227.66   | Water       | 340   | 1432.01 | 1220.89   | LBKF        |
| 2983  | 595.78  | 1226.31   | (SP)        | 82    | 656.53  | 1227.65   | Water       | 338   | 1440.46 | 1221.17   | LBKF        |
| 2981  | 606.84  | 1227.75   | (T)         | 84    | 660.26  | 1227.38   | Water       | 336   | 1450.64 | 1221.05   | LBKF        |
| 2979  | 619.79  | 1227.46   | (T)         | 86    | 662.8   | 1227.44   | Water       | 334   | 1485.33 | 1220.15   | LBKF        |
| 76    | 629.94  | 1227.67   | (T)         | 88    | 671.07  | 1227.32   | Water       | 332   | 1509.58 | 1219.56   | LBKF        |
| 74    | 642.27  | 1227.4    | (R)         | 90    | 676.2   | 1227.37   | Water       | 330   | 1547.12 | 1220.06   | LBKF        |
| 79    | 651.55  | 1226.99   | (M)         | 92    | 680.99  | 1227.32   | Water       | 328   | 1579.94 | 1220.55   | LBKF        |
| 81    | 656.46  | 1227.38   | (R)         | 94    | 691.1   | 1227.18   | Water       | 326   | 1611.07 | 1220.12   | LBKF        |
| 83    | 660.46  | 1227.29   | (U)         | 96    | 696.77  | 1227.24   | Water       | 324   | 1637.51 | 1219.6    | LBKF        |
| 85    | 663.67  | 1226.71   | (M)         | 98    | 705.71  | 1227.04   | Water       | 322   | 1659.56 | 1220.58   | LBKF        |
| 87    | 671.49  | 1226.61   | (T)         | 100   | 712.44  | 1226.69   | Water       | 320   | 1694.49 | 1218.41   | LBKF        |
| 89    | 676.77  | 1227.15   | (R)         | 102   | 727.38  | 1226.7    | Water       | 1393  | 1700.8  | 1218.53   | LBKF        |

|     |         |              |     |         |               |      |         |              |
|-----|---------|--------------|-----|---------|---------------|------|---------|--------------|
| 91  | 681.95  | 1226.9 (T)   | 104 | 742.99  | 1226.59 Water | 1391 | 1725.89 | 1218.42 LBKF |
| 93  | 690.66  | 1227.1 (R)   | 106 | 754.17  | 1226.48 Water | 1389 | 1748.09 | 1217.25 LBKF |
| 95  | 697.18  | 1226.85 (T)  | 108 | 760.43  | 1226.27 Water | 1387 | 1785.24 | 1216.82 LBKF |
| 97  | 706.14  | 1226.9 (R)   | 110 | 763.7   | 1226.18 Water | 1386 | 1828.03 | 1217.2 LBKF  |
| 99  | 712.02  | 1226.29 (T)  | 113 | 778.87  | 1225.88 Water | 1381 | 1857.91 | 1216.85 LBKF |
| 101 | 726.77  | 1226.32 (T)  | 115 | 788.04  | 1225.83 Water | 1379 | 1889.02 | 1216.75 LBKF |
| 103 | 742.85  | 1226.47 (T)  | 117 | 795.34  | 1225.74 Water | 1377 | 1915.85 | 1216.79 LBKF |
| 105 | 753.78  | 1226.38 (T)  | 119 | 808.83  | 1225.69 Water | 1368 | 2035.85 | 1216.22 LBKF |
| 107 | 759.77  | 1225.83 (T)  | 121 | 817.28  | 1225.61 Water | 1366 | 2054.23 | 1219.9 LBKF  |
| 109 | 763.37  | 1225.93 (T)  | 123 | 819.75  | 1224.93 Water | 1364 | 2077.22 | 1215.76 LBKF |
| 111 | 770.69  | 1225.36 (T)  | 125 | 826.78  | 1224.9 Water  | 1361 | 2110.88 | 1215.58 LBKF |
| 112 | 778.97  | 1225.23 (M)  | 127 | 835.31  | 1224.86 Water | 1359 | 2141.15 | 1215.47 LBKF |
| 114 | 788.05  | 1225.7 (R)   | 129 | 842.93  | 1224.8 Water  | 1354 | 2179.7  | 1214.96 LBKF |
| 116 | 795.34  | 1225.4 (T)   | 131 | 847.93  | 1224.75 Water | 1350 | 2209.17 | 1215.04 LBKF |
| 118 | 808.86  | 1225.5 (R)   | 133 | 858.63  | 1224.73 Water | 1348 | 2253.92 | 1214.95 LBKF |
| 120 | 817.31  | 1225.22 (RV) | 135 | 872.32  | 1224.57 Water | 1346 | 2283.37 | 1214.11 LBKF |
| 122 | 819.76  | 1223.22 (M)  | 137 | 882.57  | 1224.5 Water  | 1342 | 2323.8  | 1213.48 LBKF |
| 124 | 826.79  | 1224.25 (T)  | 139 | 902.5   | 1224.29 Water | 1332 | 2384.07 | 1212.5 LBKF  |
| 126 | 835.3   | 1224.23 (T)  | 141 | 917.57  | 1224.04 Water | 1329 | 2415.08 | 1212.16 LBKF |
| 128 | 842.93  | 1224.64 (R)  | 144 | 944.9   | 1223.88 Water | 1327 | 2435.74 | 1212.6 LBKF  |
| 130 | 847.93  | 1223.94 (M)  | 146 | 946.46  | 1223.91 Water | 1325 | 2483.87 | 1211.57 LBKF |
| 132 | 858.44  | 1224.53 (R)  | 148 | 951.12  | 1223.82 Water | 1321 | 2549.29 | 1212.62 LBKF |
| 134 | 872.31  | 1224.4 (T)   | 152 | 953.88  | 1223.73 Water | 1319 | 2559.93 | 1212.25 LBKF |
| 136 | 882.31  | 1224.22 (T)  | 156 | 958.46  | 1223.75 Water | 1314 | 2632.65 | 1210.79 LBKF |
| 138 | 902     | 1224.05 (T)  | 154 | 963.94  | 1223.7 Water  | 3187 | 2645.21 | 1211.45 LBKF |
| 140 | 917.21  | 1223.74 (T)  | 158 | 972.9   | 1223.56 Water | 3185 | 2667.42 | 1210.51 LBKF |
| 142 | 933.18  | 1223.84 (T)  | 160 | 996.7   | 1223.05 Water | 3183 | 2697.55 | 1210.27 LBKF |
| 143 | 944.86  | 1223.38 (T)  | 162 | 1009.84 | 1222.84 Water | 3181 | 2725.84 | 1209.39 LBKF |
| 145 | 946.25  | 1223.74 (LV) | 164 | 1016.29 | 1222.8 Water  | 3179 | 2734.06 | 1211.63 LBKF |
| 147 | 951.2   | 1223.14 (T)  | 166 | 1019.77 | 1222.77 Water | 3177 | 2748.5  | 1212.07 LBKF |
| 151 | 953.92  | 1222.9 (T)   | 170 | 1028.16 | 1222.78 Water | 3175 | 2757.74 | 1211.57 LBKF |
| 155 | 958.58  | 1223.18 (G)  | 168 | 1032.64 | 1222.8 Water  | 3173 | 2773.38 | 1211.24 LBKF |
| 153 | 963.88  | 1223.37 (R)  | 172 | 1036.44 | 1222.77 Water | 3171 | 2788.54 | 1211.22 LBKF |
| 157 | 972.9   | 1223.33 (T)  | 174 | 1041.12 | 1222.76 Water | 3167 | 2805.06 | 1209.86 LBKF |
| 159 | 996.67  | 1222.92 (U)  | 176 | 1055.96 | 1222.4 Water  | 3166 | 2826.94 | 1210.17 LBKF |
| 161 | 1010.04 | 1222.48 (T)  | 178 | 1058.5  | 1222.39 Water | 3164 | 2853    | 1209.36 LBKF |
| 163 | 1015.92 | 1222.31 (T)  | 180 | 1065.67 | 1222.32 Water | 3162 | 2882.31 | 1208.72 LBKF |
| 165 | 1019.72 | 1222.34 (T)  | 182 | 1081.73 | 1222.33 Water | 3160 | 2927.69 | 1208.6 LBKF  |
| 169 | 1028.14 | 1222.12 (T)  | 190 | 1149.86 | 1221.99 Water | 3156 | 2974.68 | 1208.36 LBKF |
| 167 | 1032.76 | 1222.04 (M)  | 194 | 1155.49 | 1221.91 Water | 3152 | 3018.71 | 1207.77 LBKF |
| 171 | 1036.44 | 1222.43 (T)  | 195 | 1162.28 | 1221.89 Water | 3150 | 3030.93 | 1207.75 LBKF |
| 173 | 1041    | 1222.61 (R)  | 198 | 1170.52 | 1221.78 Water | 3148 | 3043.47 | 1207.04 LBKF |
| 175 | 1055.94 | 1222.14 (U)  | 200 | 1173.06 | 1221.7 Water  | 3146 | 3063.56 | 1208 LBKF    |
| 177 | 1059.07 | 1221.78 (T)  | 207 | 1189.01 | 1221.48 Water | 3144 | 3081.59 | 1207.49 LBKF |
| 179 | 1065.45 | 1221.89 (T)  | 204 | 1189.2  | 1221.48 Water | 3142 | 3097.88 | 1205.84 LBKF |
| 181 | 1081.21 | 1221.87 (T)  | 206 | 1196.07 | 1221.46 Water | 3138 | 3123.06 | 1206.13 LBKF |
| 189 | 1150.34 | 1221.37 (T)  | 209 | 1212.63 | 1221.48 Water | 3136 | 3146.82 | 1205.6 LBKF  |
| 193 | 1155.62 | 1221.39 (G)  | 211 | 1234.68 | 1221.44 Water | 2433 | 3173.31 | 1204.85 LBKF |
| 196 | 1162.27 | 1221.61 (R)  | 215 | 1254.94 | 1221.15 Water | 2432 | 3199.01 | 1204.25 LBKF |
| 197 | 1170.51 | 1221.45 (U)  | 217 | 1260.43 | 1221.1 Water  | 2431 | 3227.98 | 1204.29 LBKF |
| 199 | 1173.38 | 1221.35 (T)  | 221 | 1268.12 | 1221.07 Water | 2430 | 3243.78 | 1205.07 LBKF |
| 201 | 1180.18 | 1221.38 (T)  | 219 | 1272.37 | 1221.04 Water | 2428 | 3273.88 | 1204.71 LBKF |
| 203 | 1189.21 | 1221.01 (T)  | 225 | 1283.21 | 1220.98 Water | 2429 | 3285.48 | 1204.2 LBKF  |
| 205 | 1196.08 | 1220.74 (T)  | 223 | 1288.39 | 1221.05 Water | 2427 | 3317.55 | 1203.58 LBKF |
| 208 | 1212.61 | 1221.09 (T)  | 227 | 1297.58 | 1220.93 Water | 2426 | 3349.6  | 1203.67 LBKF |
| 210 | 1234.81 | 1221.36 (T)  | 232 | 1309.77 | 1220.79 Water | 2425 | 3393.33 | 1202.93 LBKF |
| 212 | 1244.37 | 1221.29 (R)  | 230 | 1320.94 | 1220.84 Water | 2423 | 3440.74 | 1202.93 LBKF |
| 214 | 1255.1  | 1220.97 (T)  | 236 | 1332.12 | 1220.64 Water | 2424 | 3453.01 | 1203.16 LBKF |
| 216 | 1259.86 | 1220.76 (U)  | 234 | 1342.99 | 1220.49 Water | 2422 | 3466.97 | 1202.14 LBKF |
| 220 | 1267.83 | 1220.57 (T)  | 238 | 1353.97 | 1220.48 Water | 2421 | 3476.68 | 1202.58 LBKF |
| 218 | 1272.34 | 1220.8 (TP)  | 240 | 1357.07 | 1220.18 Water | 2420 | 3534.21 | 1201.78 LBKF |
| 224 | 1283.37 | 1220.41 (TM) | 244 | 1359.36 | 1220.07 Water | 712  | 3585.5  | 1203.82 LBKF |
| 222 | 1288.32 | 1220.55 (TG) | 242 | 1364.36 | 1220.1 Water  | 714  | 3600.2  | 1203.06 LBKF |
| 228 | 1294.24 | 1220.92 (BR) | 248 | 1370.2  | 1220.18 Water | 716  | 3620.41 | 1202.84 LBKF |
| 226 | 1297.68 | 1220.69 (T)  | 246 | 1374.85 | 1220.08 Water | 718  | 3661.88 | 1201.12 LBKF |
| 231 | 1309.76 | 1220.51 (T)  | 252 | 1385.55 | 1220.09 Water | 720  | 3685.01 | 1200.53 LBKF |
| 229 | 1321.03 | 1220.73 (TR) | 250 | 1392.69 | 1220.01 Water | 722  | 3705.63 | 1200.57 LBKF |
| 235 | 1332.44 | 1220.25 (T)  | 254 | 1400.67 | 1220.05 Water | 724  | 3718.48 | 1200.84 LBKF |
| 233 | 1343.21 | 1220.29 (TU) | 256 | 1423.84 | 1219.78 Water | 726  | 3753.85 | 1200.89 LBKF |
| 237 | 1354.11 | 1220.45 (LV) | 258 | 1434.92 | 1219.73 Water | 727  | 3774.98 | 1200.52 LBKF |
| 239 | 1357.5  | 1219.86 (T)  | 260 | 1445.18 | 1219.64 Water | 729  | 3793.85 | 1200.27 LBKF |
| 243 | 1359.78 | 1219 (SP)    | 262 | 1454.95 | 1219.58 Water | 731  | 3827.66 | 1200.13 LBKF |
| 241 | 1364.25 | 1219.32 (T)  | 264 | 1461.96 | 1219.5 Water  | 733  | 3849.48 | 1202.57 LBKF |
| 247 | 1370.31 | 1219.87 (TR) | 268 | 1470.07 | 1219.47 Water | 735  | 3859.9  | 1200.5 LBKF  |
| 245 | 1374.73 | 1219.84 (TU) | 266 | 1477.18 | 1219.43 Water | 737  | 3876.88 | 1200.02 LBKF |
| 251 | 1384.97 | 1219.13 (TM) | 270 | 1483.73 | 1219.42 Water | 739  | 3896.81 | 1199.91 LBKF |
| 249 | 1392.92 | 1219.49 (TG) | 274 | 1484.61 | 1219.23 Water | 740  | 3925.23 | 1199.92 LBKF |
| 253 | 1400.58 | 1219.85 (TR) | 272 | 1489.46 | 1219.15 Water | 741  | 3964.48 | 1198.22 LBKF |
| 255 | 1423.65 | 1219.5 (T)   | 276 | 1492.63 | 1218.99 Water | 742  | 3987.11 | 1198.02 LBKF |

|      |         |               |      |         |                      |      |         |              |
|------|---------|---------------|------|---------|----------------------|------|---------|--------------|
| 257  | 1434.89 | 1219.41 (T)   | 278  | 1498.91 | 1218.92 Water        | 854  | 4022.3  | 1198.85 LBKF |
| 259  | 1444.87 | 1219.3 (T)    | 280  | 1511.04 | 1218.65 Water        | 853  | 4051.02 | 1199.63 LBKF |
| 261  | 1454.86 | 1219.45 (TR)  | 282  | 1519.83 | 1218.7 Water         | 852  | 4072.29 | 1199.24 LBKF |
| 263  | 1461.75 | 1219.22 (TU)  | 284  | 1523.66 | 1218.61 Water        | 851  | 4106.73 | 1198.68 LBKF |
| 267  | 1470.06 | 1218.77 (TM)  | 286  | 1535.46 | 1218.66 Water        | 850  | 4158.55 | 1198.1 LBKF  |
| 265  | 1477.26 | 1219.06 (T)   | 288  | 1543.09 | 1218.54 Water        | 849  | 4177.27 | 1197.96 LBKF |
| 269  | 1483.42 | 1219.04 (T)   | 290  | 1564.08 | 1218.65 Water        | 848  | 4199.22 | 1196.74 LBKF |
| 273  | 1484.53 | 1218.98 (T)   | 297  | 1574.97 | 1217.97 Water        | 847  | 4220.17 | 1196.52 LBKF |
| 271  | 1489.35 | 1218.98 (LV)  | 293  | 1586.23 | 1217.96 Water        | 846  | 4245.25 | 1196.61 LBKF |
| 275  | 1492.37 | 1218.59 (T)   | 295  | 1594.67 | 1217.76 Water        | 845  | 4268.73 | 1195.58 LBKF |
| 277  | 1498.96 | 1218.52 (T)   | 299  | 1602.92 | 1217.64 Water        | 844  | 4297.62 | 1195.82 LBKF |
| 279  | 1510.86 | 1218.1 (TM)   | 303  | 1606.67 | 1217.63 Water        | 843  | 4340.56 | 1196.19 LBKF |
| 281  | 1519.92 | 1218.14 (T)   | 301  | 1614.49 | 1217.68 Water        | 842  | 4357.86 | 1196.23 LBKF |
| 283  | 1523.35 | 1218.33 (T)   | 305  | 1619.55 | 1217.64 Water        | 841  | 4372.98 | 1195.34 LBKF |
| 285  | 1534.49 | 1217.69 (T)   | 307  | 1625.62 | 1217.65 Water        | 839  | 4404.95 | 1196.78 LBKF |
| 287  | 1542.78 | 1217.98 (T)   | 309  | 1630.89 | 1217.69 Water        | 838  | 4427.7  | 1196.7 LBKF  |
| 289  | 1564.28 | 1218.14 (T)   | 311  | 1635.58 | 1217.68 Water        | 827  | 4438.79 | 1196.37 LBKF |
| 291  | 1571.2  | 1218.36 (BR)  | 313  | 1651.18 | 1217.64 Water        | 823  | 4498.47 | 1195.34 LBKF |
| 296  | 1574.92 | 1217.3 (T)    | 315  | 1665.07 | 1217.62 Water        | 824  | 4539.07 | 1195.21 LBKF |
| 292  | 1586.44 | 1217.82 (TR)  | 317  | 1684.76 | 1217.51 Water        | 825  | 4578.4  | 1194.55 LBKF |
| 294  | 1594.58 | 1217.26 (T)   | 1185 | 1709.59 | 1217.27 Water        | 822  | 4578.9  | 1193.92 LBKF |
| 298  | 1602.9  | 1217.33 (TU)  | 319  | 1712.5  | 1217.27 Water        | 821  | 4600.98 | 1194.58 LBKF |
| 302  | 1606.4  | 1216.71 (TP)  | 1183 | 1729.2  | 1216.79 Water        | 820  | 4639.04 | 1195.12 LBKF |
| 300  | 1614.25 | 1216.58 (TM)  | 1187 | 1741.64 | 1216.2 Water         | 819  | 4674.14 | 1194.66 LBKF |
| 304  | 1619.52 | 1217.15 (TG)  | 1189 | 1755.22 | 1216.17 Water        | 818  | 4691.81 | 1194.57 LBKF |
| 306  | 1625.86 | 1217.37 (T)   | 1191 | 1769.61 | 1215.86 Water        | 816  | 4747.52 | 1192.51 LBKF |
| 308  | 1631    | 1217.4 (TR)   | 1193 | 1784.4  | 1215.83 Water        | 815  | 4769.39 | 1192.03 LBKF |
| 310  | 1635.51 | 1217.24 (TU)  | 1195 | 1802.87 | 1215.78 Water        | 814  | 4825.8  | 1192.12 LBKF |
| 312  | 1651.03 | 1217.25 (T)   | 1196 | 1824.51 | 1215.59 Water        | 813  | 4863.78 | 1193.47 LBKF |
| 314  | 1664.84 | 1217.4 (TR)   | 1198 | 1847.79 | 1215.53 Water        | 810  | 4877.02 | 1191.74 LBKF |
| 316  | 1684.58 | 1217.28 (T)   | 1200 | 1891.83 | 1215.28 Water        | 807  | 4929.75 | 1191.47 LBKF |
| 1184 | 1709.47 | 1217.07 (T)   | 1202 | 1914.78 | 1215.08 Water        | 806  | 4971.62 | 1190.27 LBKF |
| 318  | 1712.43 | 1216.99 (T)   | 1204 | 1926.43 | 1215.12 Water        | 804  | 5006.76 | 1189.97 LBKF |
| 1182 | 1729.14 | 1216.59 (T)   | 1208 | 1928.97 | 1215.12 Water        | 800  | 5009.34 | 1190.88 LBKF |
| 1181 | 1729.32 | 1216.57 (BED) | 1206 | 1933.59 | 1214.8 Water         | 799  | 5034.49 | 1189.68 LBKF |
| 1180 | 1729.35 | 1217.35 (BED) | 1210 | 1949.7  | 1214.8 Water         |      |         |              |
| 1186 | 1741.73 | 1214.48 (MP)  | 1212 | 1970.48 | 1214.86 Water        |      |         |              |
| 1188 | 1755.03 | 1216.17 (TR)  | 1214 | 1997.51 | 1214.78 Water        | 30   | 73.8    | 1237.73 RBKF |
| 1190 | 1769.56 | 1215.28 (T)   | 1227 | 2034.26 | 1214.66 Water        | 37   | 126.86  | 1237.21 RBKF |
| 1192 | 1784.58 | 1215.55 (T)   | 1229 | 2053.99 | 1214.47 Water        | 52   | 175.19  | 1236.85 RBKF |
| 1194 | 1802.75 | 1215.6 (T)    | 1231 | 2066.17 | 1214.41 Water        | 55   | 200.32  | 1236.28 RBKF |
| 1197 | 1847.92 | 1215.38 (TR)  | 1233 | 2082.86 | 1214.19 Water        | 56   | 224.32  | 1235.48 RBKF |
| 1199 | 1892.14 | 1215.15 (T)   | 1235 | 2101.84 | 1214.19 Water        | 4266 | 243.67  | 1235.28 RBKF |
| 1201 | 1914.58 | 1214.57 (T)   | 1237 | 2118.16 | 1214.14 Water        | 4268 | 274.27  | 1235.37 RBKF |
| 1203 | 1926.43 | 1214.79 (RV)  | 1239 | 2132.81 | 1214.07 Water        | 2352 | 303.47  | 1234.39 RBKF |
| 1207 | 1928.92 | 1214.96 (RV)  | 1241 | 2168.66 | 1213.95 Water        | 4270 | 309.34  | 1234.71 RBKF |
| 1205 | 1933.4  | 1213.97 (MP)  | 1243 | 2208.88 | 1213.5 Water         | 4273 | 315.37  | 1233.49 RBKF |
| 1209 | 1949.76 | 1214.19 (T)   | 1245 | 2216.36 | 1213.31 Water        | 2350 | 322.67  | 1234.2 RBKF  |
| 1211 | 1970.33 | 1214.17 (T)   | 1247 | 2243.52 | 1213.14 Water        | 4277 | 346.7   | 1231.21 RBKF |
| 1213 | 1997.64 | 1214.56 (TR)  | 1249 | 2271.23 | 1212.91 Water        | 4275 | 348.01  | 1232.25 RBKF |
| 1226 | 2033.54 | 1214.49 (T)   | 1251 | 2293.52 | 1212.38 Water        | 2349 | 356.02  | 1233.94 RBKF |
| 1228 | 2054.15 | 1214.23 (T)   | 1253 | 2302.37 | 1212.31 Water        | 2346 | 380.03  | 1233.91 RBKF |
| 1230 | 2066    | 1214.19 (T)   | 1255 | 2318.96 | 1212.27 Water        | 2342 | 424.85  | 1234.28 RBKF |
| 1232 | 2082.61 | 1213.97 (U)   | 1257 | 2336.46 | 1212.33 Water        | 2340 | 437.76  | 1233.88 RBKF |
| 1234 | 2101.86 | 1213.78 (P)   | 1259 | 2360.94 | 1211.95 Water        | 3391 | 437.76  | 1233.88 RBKF |
| 1236 | 2119.22 | 1212.87 (MP)  | 1261 | 2379.65 | 1211.75 Water        | 2338 | 448.99  | 1233.11 RBKF |
| 1238 | 2133.13 | 1213.89 (TR)  | 1263 | 2391.85 | 1211.44 Water        | 2332 | 478.14  | 1230.57 RBKF |
| 1240 | 2169.14 | 1213.82 (T)   | 1265 | 2398.21 | 1211.37 Water        | 2331 | 488.13  | 1230.44 RBKF |
| 1242 | 2208.53 | 1213.26 (T)   | 1267 | 2413.06 | 1211.41 Water        | 2998 | 517.19  | 1230.45 RBKF |
| 1244 | 2216.14 | 1213.06 (T)   | 1269 | 2427.77 | <b>1211.41</b> Water | 3000 | 531.34  | 1229.88 RBKF |
| 1246 | 2243.47 | 1212.81 (T)   | 1271 | 2435.44 | 1211.17 Water        | 3003 | 558.08  | 1229.61 RBKF |
| 1248 | 2270.91 | 1212.62 (LV)  | 1275 | 2460.18 | 1211.08 Water        | 3005 | 591.21  | 1228.65 RBKF |
| 1250 | 2293.39 | 1212.12 (P)   | 1277 | 2465.44 | 1210.94 Water        | 3009 | 617.35  | 1232.42 RBKF |
| 1252 | 2301.98 | 1211.87 (MP)  | 1279 | 2486.69 | 1210.92 Water        | 3007 | 617.78  | 1229.72 RBKF |
| 1254 | 2318.95 | 1211.15 (MP)  | 1281 | 2499.94 | 1210.8 Water         | 403  | 645.81  | 1229.38 RBKF |
| 1256 | 2336.44 | 1212 (TR)     | 1283 | 2507.93 | 1210.76 Water        | 400  | 673.01  | 1228.36 RBKF |
| 1258 | 2360.92 | 1211.78 (T)   | 1285 | 2520.86 | 1210.64 Water        | 398  | 714.7   | 1227.93 RBKF |
| 1260 | 2379.61 | 1211.6 (T)    | 1286 | 2536.04 | <b>1210.38</b> Water | 395  | 751.52  | 1227.99 RBKF |
| 1262 | 2391.69 | 1211.14 (P)   | 1289 | 2564.65 | 1210.42 Water        | 392  | 767.56  | 1229.28 RBKF |
| 1264 | 2397.41 | 1210.34 (MP)  | 1291 | 2569    | 1210.38 Water        | 390  | 795.38  | 1228.02 RBKF |
| 1266 | 2413.03 | 1211 (TR)     | 1293 | 2598.45 | 1209.91 Water        | 406  | 820.18  | 1228.07 RBKF |
| 1268 | 2427.28 | 1211 (P)      | 1295 | 2618.48 | 1209.69 Water        | 388  | 829.55  | 1226.57 RBKF |
| 1270 | 2435.14 | 1209.86 (MP)  | 1297 | 2634.85 | 1209.54 Water        | 384  | 864.7   | 1225.77 RBKF |
| 1274 | 2460.87 | 1210.62 (P)   | 1299 | 2641.44 | 1209.26 Water        | 386  | 864.74  | 1225.71 RBKF |
| 1276 | 2467.62 | 1210.15 (MP)  | 2880 | 2641.44 | 1209.26 Water        | 407  | 867.59  | 1228.12 RBKF |
| 1278 | 2486.57 | 1210.79 (TR)  | 3043 | 2645.41 | 1209.67 Water        | 382  | 888.37  | 1226.16 RBKF |
| 1280 | 2499.77 | 1210.25 (P)   | 3045 | 2657.05 | 1209.62 Water        | 380  | 914.41  | 1225.53 RBKF |
| 1284 | 2520.92 | 1210.5 (TR)   | 3047 | 2671.42 | 1209.61 Water        | 378  | 937.83  | 1225 RBKF    |
| 1287 | 2553.36 | 1209.88 (P)   | 3051 | 2703.77 | 1209.05 Water        | 376  | 966.66  | 1224.3 RBKF  |

|      |         |              |      |         |               |      |         |              |
|------|---------|--------------|------|---------|---------------|------|---------|--------------|
| 1288 | 2564.31 | 1209.37 (MP) | 3053 | 2722.45 | 1208.86 Water | 374  | 1008.45 | 1224.05 RBKF |
| 1290 | 2568.98 | 1210.17 (TR) | 3055 | 2730.29 | 1208.79 Water | 372  | 1036.44 | 1223.47 RBKF |
| 1292 | 2598.43 | 1209.41 (T)  | 3057 | 2742.01 | 1208.61 Water | 370  | 1056.19 | 1222.79 RBKF |
| 1294 | 2618.55 | 1209.5 (T)   | 3061 | 2751.16 | 1208.53 Water | 368  | 1112.91 | 1223.22 RBKF |
| 1296 | 2634.87 | 1209.28 (P)  | 3059 | 2758.52 | 1208.58 Water | 365  | 1126.16 | 1224.45 RBKF |
| 1298 | 2641.23 | 1208.46 (MP) | 3063 | 2763.59 | 1208.59 Water | 362  | 1151.57 | 1224.99 RBKF |
| 2879 | 2641.23 | 1208.46 (MP) | 3065 | 2780.68 | 1208.46 Water | 360  | 1172.34 | 1225.93 RBKF |
| 3042 | 2645.8  | 1208.64 (LV) | 3069 | 2804.66 | 1208.35 Water | 358  | 1191.27 | 1223.82 RBKF |
| 3044 | 2657.06 | 1208.58 (M)  | 3071 | 2820.59 | 1208.3 Water  | 357  | 1217.02 | 1223.26 RBKF |
| 3046 | 2671.21 | 1209.23 (R)  | 3073 | 2836.64 | 1207.94 Water | 426  | 1223.87 | 1222.66 RBKF |
| 3048 | 2694.5  | 1208.91 (T)  | 3075 | 2850.54 | 1207.79 Water | 355  | 1252.9  | 1222.52 RBKF |
| 3052 | 2722.5  | 1208.34 (T)  | 3077 | 2861.83 | 1207.6 Water  | 353  | 1280.23 | 1222.56 RBKF |
| 3054 | 2729.1  | 1208.19 (T)  | 3079 | 2865.05 | 1207.55 Water | 351  | 1297.95 | 1222.07 RBKF |
| 3056 | 2742.08 | 1208.33 (R)  | 3081 | 2880.04 | 1207.51 Water | 349  | 1321.94 | 1222.05 RBKF |
| 3060 | 2751.05 | 1208.04 (T)  | 3083 | 2892.74 | 1207.34 Water | 427  | 1328.95 | 1221.92 RBKF |
| 3058 | 2758.37 | 1207.51 (T)  | 3085 | 2902.08 | 1207.26 Water | 347  | 1346.82 | 1223.24 RBKF |
| 3062 | 2763.86 | 1207.06 (M)  | 3087 | 2915.09 | 1207.25 Water | 428  | 1366.58 | 1221.62 RBKF |
| 3064 | 2780.66 | 1208.17 (T)  | 3089 | 2932.61 | 1207.23 Water | 345  | 1368.66 | 1223.52 RBKF |
| 3066 | 2792.07 | 1208.08 (R)  | 3091 | 2956.09 | 1207.15 Water | 343  | 1390.08 | 1221.6 RBKF  |
| 3068 | 2804.92 | 1208.04 (T)  | 3093 | 2976.56 | 1207.02 Water | 429  | 1404.42 | 1222.04 RBKF |
| 3070 | 2820.78 | 1207.89 (T)  | 3097 | 3004.33 | 1206.23 Water | 341  | 1424.86 | 1220.81 RBKF |
| 3072 | 2836.16 | 1207.68 (T)  | 3095 | 3010.1  | 1205.82 Water | 339  | 1446.3  | 1220.6 RBKF  |
| 3074 | 2851.08 | 1207.43 (T)  | 3099 | 3023.72 | 1205.69 Water | 430  | 1462.11 | 1222.74 RBKF |
| 3076 | 2862.1  | 1206.78 (LV) | 3101 | 3034.21 | 1205.69 Water | 337  | 1470.73 | 1221.41 RBKF |
| 3078 | 2865.02 | 1206.8 (T)   | 3103 | 3047.5  | 1205.66 Water | 335  | 1494.87 | 1220.66 RBKF |
| 3080 | 2880.15 | 1206.81 (U)  | 3105 | 3058.81 | 1205.58 Water | 331  | 1528.52 | 1220.95 RBKF |
| 3082 | 2892.61 | 1206.5 (T)   | 3107 | 3070.2  | 1205.3 Water  | 329  | 1547.06 | 1220.49 RBKF |
| 3084 | 2902.36 | 1206.22 (M)  | 3111 | 3076.37 | 1205.34 Water | 327  | 1574.31 | 1219.5 RBKF  |
| 3086 | 2914.85 | 1206.67 (T)  | 3109 | 3082.02 | 1205.3 Water  | 325  | 1616.26 | 1218.54 RBKF |
| 3088 | 2933.03 | 1206.74 (T)  | 3113 | 3094.17 | 1205.07 Water | 323  | 1657.54 | 1219.23 RBKF |
| 3090 | 2956.03 | 1206.93 (R)  | 3115 | 3106.2  | 1205.04 Water | 321  | 1683.2  | 1218.28 RBKF |
| 3092 | 2976.73 | 1206.75 (T)  | 3117 | 3126.8  | 1204.46 Water | 1394 | 1705.16 | 1218.13 RBKF |
| 3096 | 3004.31 | 1206.19 (RV) | 3119 | 3132.72 | 1204.37 Water | 1392 | 1724.39 | 1218.21 RBKF |
| 3094 | 3010.39 | 1204.6 (M)   | 3121 | 3134.44 | 1204.38 Water | 1390 | 1750    | 1219.82 RBKF |
| 3098 | 3023.6  | 1205.32 (T)  | 3123 | 3141.3  | 1204.31 Water | 1388 | 1784.52 | 1218.59 RBKF |
| 3100 | 3034.14 | 1205.06 (T)  | 3125 | 3151.1  | 1204.27 Water | 1385 | 1838.34 | 1218.28 RBKF |
| 3102 | 3047.62 | 1205.27 (R)  | 3129 | 3155.84 | 1204.15 Water | 1384 | 1852.96 | 1216.69 RBKF |
| 3104 | 3058.42 | 1205.29 (T)  | 3127 | 3167.51 | 1204.06 Water | 1382 | 1894.8  | 1216.23 RBKF |
| 3106 | 3070.3  | 1204.74 (P)  | 3131 | 3174.8  | 1204.12 Water | 1380 | 1930.48 | 1216.15 RBKF |
| 3110 | 3076.59 | 1204.31 (M)  | 3133 | 3188.49 | 1204.05 Water | 1378 | 1965.57 | 1215.96 RBKF |
| 3108 | 3082.02 | 1204.94 (R)  | 2407 | 3199.19 | 1203.96 Water | 1376 | 2012.2  | 1217.58 RBKF |
| 3112 | 3094.3  | 1204.67 (T)  | 2403 | 3241.6  | 1203.51 Water | 1374 | 2046.09 | 1217.46 RBKF |
| 3114 | 3105.7  | 1204.52 (T)  | 2401 | 3251.81 | 1203.45 Water | 1371 | 2092.46 | 1217.45 RBKF |
| 3116 | 3126.78 | 1204.12 (T)  | 2399 | 3281.72 | 1203.47 Water | 1369 | 2118.08 | 1218.39 RBKF |
| 3118 | 3132.51 | 1203.94 (LV) | 2397 | 3281.74 | 1203.24 Water | 1367 | 2118.91 | 1217.43 RBKF |
| 3120 | 3134.26 | 1203.97 (T)  | 2396 | 3318.33 | 1202.91 Water | 1365 | 2150.03 | 1215.89 RBKF |
| 3122 | 3140.92 | 1203.75 (R)  | 2392 | 3324.35 | 1202.9 Water  | 1363 | 2173.15 | 1216.45 RBKF |
| 3124 | 3150.75 | 1203.65 (T)  | 2394 | 3338.22 | 1202.7 Water  | 1362 | 2173.2  | 1216.45 RBKF |
| 3128 | 3155.75 | 1203.84 (T)  | 2387 | 3343.99 | 1202.38 Water | 1360 | 2198.02 | 1215.89 RBKF |
| 3126 | 3167.23 | 1203.3 (P)   | 2388 | 3344.02 | 1202.77 Water | 1357 | 2233.57 | 1215.22 RBKF |
| 3130 | 3175.04 | 1202.92 (M)  | 2390 | 3354.59 | 1202.78 Water | 1355 | 2259.56 | 1216.66 RBKF |
| 3132 | 3188.07 | 1203.41 (T)  | 2383 | 3367.72 | 1202.55 Water | 1353 | 2263.17 | 1214.74 RBKF |
| 2406 | 3198.75 | 1203.52 (TR) | 2385 | 3380.75 | 1202.28 Water | 1349 | 2302.63 | 1213.9 RBKF  |
| 2404 | 3230.87 | 1203.23 (T)  | 2379 | 3389.14 | 1202.4 Water  | 1345 | 2333.22 | 1214.18 RBKF |
| 2405 | 3231.05 | 1203.65 (T)  | 2381 | 3401.98 | 1202.27 Water | 1340 | 2367.06 | 1214.82 RBKF |
| 2402 | 3241.41 | 1202.39 (T)  | 2375 | 3432.78 | 1202.09 Water | 1338 | 2384.96 | 1213.33 RBKF |
| 2400 | 3251.43 | 1202.27 (MP) | 2377 | 3438.79 | 1201.96 Water | 1335 | 2397.41 | 1213.84 RBKF |
| 2398 | 3281.53 | 1203.18 (R)  | 2371 | 3445.63 | 1201.74 Water | 1330 | 2405.96 | 1213.35 RBKF |
| 2395 | 3318.33 | 1202.57 (T)  | 2373 | 3457.93 | 1201.7 Water  | 1328 | 2420.03 | 1212.68 RBKF |
| 2391 | 3324.48 | 1202.84 (LV) | 2369 | 3486.6  | 1201.57 Water | 1326 | 2431.55 | 1212.49 RBKF |
| 2393 | 3338.16 | 1201.92 (T)  | 2365 | 3560.03 | 1201.19 Water | 1324 | 2453.27 | 1213.2 RBKF  |
| 2386 | 3343.76 | 1201.18 (MP) | 692  | 3561.86 | 1200.88 Water | 1323 | 2491.85 | 1213.27 RBKF |
| 2389 | 3353.96 | 1202.14 (T)  | 2096 | 3561.86 | 1200.88 Water | 1322 | 2519.87 | 1212.73 RBKF |
| 2382 | 3367.49 | 1202.04 (T)  | 696  | 3576.35 | 1200.84 Water | 1320 | 2557.39 | 1211.65 RBKF |
| 2384 | 3380.72 | 1201.36 (MP) | 2100 | 3576.35 | 1200.84 Water | 1318 | 2589.91 | 1211.84 RBKF |
| 2378 | 3389.07 | 1201.65 (G)  | 700  | 3589.91 | 1200.45 Water | 1313 | 2618.35 | 1211.87 RBKF |
| 2380 | 3401.81 | 1201.92 (TR) | 702  | 3595.03 | 1200.42 Water | 1318 | 2652.91 | 1211.62 RBKF |
| 2374 | 3432.7  | 1201.9 (T)   | 706  | 3608    | 1200.41 Water | 1317 | 2668.44 | 1211.63 RBKF |
| 2376 | 3438.79 | 1201.52 (RV) | 710  | 3614.69 | 1200.49 Water | 1316 | 2696.21 | 1211.16 RBKF |
| 2370 | 3445.31 | 1200.75 (SP) | 708  | 3623.14 | 1200.42 Water | 1314 | 2718.34 | 1210.2 RBKF  |
| 2372 | 3457.87 | 1201.18 (T)  | 704  | 3637.49 | 1200.43 Water | 1312 | 2756.96 | 1209.45 RBKF |
| 2368 | 3486.64 | 1201.35 (TR) | 698  | 3651.72 | 1200.12 Water | 1310 | 2786.8  | 1209.97 RBKF |
| 2367 | 3531.23 | 1201.48 (T)  | 694  | 3666.4  | 1200.04 Water | 1308 | 2819.9  | 1210.01 RBKF |
| 2366 | 3531.27 | 1200.97 (T)  | 686  | 3671.25 | 1199.97 Water | 1306 | 2855.25 | 1211.08 RBKF |
| 2364 | 3559.74 | 1200.75 (T)  | 690  | 3675.43 | 1199.68 Water | 1304 | 2892.33 | 1210.95 RBKF |
| 691  | 3561.93 | 1200.71 (T)  | 688  | 3677.1  | 1199.7 Water  | 1302 | 2925.06 | 1209.77 RBKF |
| 2095 | 3561.93 | 1200.71 (T)  | 684  | 3686.21 | 1199.68 Water | 1300 | 2946.4  | 1208.96 RBKF |
| 695  | 3576.43 | 1200.63 (R)  | 682  | 3694.55 | 1199.71 Water | 1298 | 2974.68 | 1207.78 RBKF |
| 2099 | 3576.43 | 1200.63 (R)  | 680  | 3700.83 | 1199.72 Water | 1296 | 2999.26 | 1207.42 RBKF |

|     |         |              |     |         |               |      |         |              |
|-----|---------|--------------|-----|---------|---------------|------|---------|--------------|
| 699 | 3589.87 | 1200.13 (R)  | 679 | 3713.47 | 1199.6 Water  | 3147 | 3014.58 | 1206.78 RBKF |
| 701 | 3595.09 | 1199.65 (M)  | 676 | 3716.86 | 1199.37 Water | 3145 | 3050.13 | 1206.21 RBKF |
| 705 | 3607.95 | 1199.73 (T)  | 674 | 3727.02 | 1199.25 Water | 3143 | 3073.89 | 1206.23 RBKF |
| 709 | 3614.78 | 1199.79 (T)  | 672 | 3740.77 | 1199.14 Water | 3139 | 3106.01 | 1206.03 RBKF |
| 707 | 3623.32 | 1199.87 (T)  | 670 | 3749.85 | 1199.16 Water | 3137 | 3128.16 | 1206.12 RBKF |
| 703 | 3638.04 | 1200.19 (R)  | 665 | 3797.02 | 1198.38 Water | 3135 | 3152.82 | 1207.24 RBKF |
| 697 | 3651.79 | 1199.87 (T)  | 667 | 3799.22 | 1198.19 Water | 2408 | 3175.07 | 1207.34 RBKF |
| 693 | 3665.55 | 1199.9 (R)   | 662 | 3811.08 | 1198.21 Water | 2409 | 3194    | 1205.84 RBKF |
| 685 | 3671.35 | 1199.96 (LV) | 660 | 3829.89 | 1197.97 Water | 3460 | 3194    | 1205.84 RBKF |
| 689 | 3675.93 | 1199.27 (T)  | 658 | 3852.51 | 1197.9 Water  | 2411 | 3275.5  | 1203.74 RBKF |
| 683 | 3685.72 | 1199.32 (T)  | 656 | 3860.29 | 1197.88 Water | 2412 | 3315.4  | 1204.74 RBKF |
| 681 | 3694.71 | 1198.3 (M)   | 654 | 3873.63 | 1197.83 Water | 2414 | 3364.05 | 1204.88 RBKF |
| 678 | 3701.09 | 1199.48 (BR) | 652 | 3887.18 | 1197.71 Water | 2415 | 3392.74 | 1204.42 RBKF |
| 677 | 3714.36 | 1199.49 (BR) | 650 | 3891.92 | 1197.74 Water | 2416 | 3432.57 | 1203.87 RBKF |
| 675 | 3716.95 | 1199 (T)     | 648 | 3906.09 | 1197.75 Water | 2417 | 3468.55 | 1202.53 RBKF |
| 673 | 3727.29 | 1199 (T)     | 646 | 3919.22 | 1197.7 Water  | 2418 | 3496.54 | 1202.32 RBKF |
| 671 | 3740.84 | 1198.45 (T)  | 644 | 3937.12 | 1197.42 Water | 2419 | 3527.45 | 1201.71 RBKF |
| 669 | 3749.88 | 1198.69 (T)  | 642 | 3951.04 | 1197.22 Water | 711  | 3581.86 | 1201.81 RBKF |
| 668 | 3763.29 | 1198.99 (R)  | 639 | 3973.76 | 1197.26 Water | 713  | 3643.33 | 1202.26 RBKF |
| 664 | 3796.93 | 1198.25 (T)  | 637 | 3987.18 | 1197.23 Water | 717  | 3681.92 | 1202.6 RBKF  |
| 663 | 3798.27 | 1198.63 (LV) | 635 | 3997.91 | 1197.25 Water | 721  | 3707.04 | 1201.66 RBKF |
| 666 | 3799.41 | 1197.87 (T)  | 633 | 4006.82 | 1197.26 Water | 725  | 3763.96 | 1200.58 RBKF |
| 661 | 3810.58 | 1197.96 (R)  | 631 | 4019.22 | 1196.79 Water | 728  | 3819.46 | 1200.36 RBKF |
| 659 | 3830.31 | 1197.83 (T)  | 629 | 4029.53 | 1196.74 Water | 730  | 3867.92 | 1198.92 RBKF |
| 657 | 3852.39 | 1197.48 (T)  | 627 | 4041.65 | 1196.76 Water | 732  | 3894.43 | 1198.92 RBKF |
| 655 | 3860.74 | 1197.12 (T)  | 623 | 4050.09 | 1196.71 Water | 734  | 3926.62 | 1199.49 RBKF |
| 653 | 3873.22 | 1197.54 (R)  | 625 | 4050.56 | 1196.71 Water | 736  | 3959.24 | 1200.04 RBKF |
| 651 | 3887.3  | 1197.47 (R)  | 622 | 4064.56 | 1196.41 Water | 738  | 3983.4  | 1200.81 RBKF |
| 647 | 3906.52 | 1197.17 (T)  | 620 | 4069.65 | 1196.4 Water  | 743  | 4005.9  | 1199.44 RBKF |
| 645 | 3919.09 | 1197.66 (R)  | 618 | 4076.33 | 1196.35 Water | 744  | 4045.12 | 1198.65 RBKF |
| 643 | 3937.16 | 1197.13 (T)  | 614 | 4090.02 | 1195.96 Water | 745  | 4102.75 | 1196.98 RBKF |
| 641 | 3951.07 | 1197.12 (RV) | 616 | 4097.65 | 1195.99 Water | 746  | 4141.48 | 1197.19 RBKF |
| 640 | 3951.42 | 1197.11 (U)  | 612 | 4104.06 | 1195.96 Water | 747  | 4168.21 | 1197.43 RBKF |
| 638 | 3973.78 | 1196.34 (T)  | 610 | 4109.2  | 1195.96 Water | 748  | 4189.94 | 1197.64 RBKF |
| 636 | 3987.21 | 1195.66 (M)  | 608 | 4120.35 | 1195.91 Water | 749  | 4209.73 | 1197.85 RBKF |
| 634 | 3997.82 | 1196.01 (M)  | 606 | 4128.8  | 1195.91 Water | 750  | 4246.08 | 1198.06 RBKF |
| 632 | 4006.24 | 1197.13 (T)  | 604 | 4131.5  | 1195.93 Water | 751  | 4266.73 | 1197.55 RBKF |
| 630 | 4019.1  | 1196.57 (U)  | 602 | 4139.7  | 1195.81 Water | 753  | 4333.34 | 1196.23 RBKF |
| 628 | 4029.35 | 1195.86 (T)  | 598 | 4147.93 | 1195.7 Water  | 768  | 4342.12 | 1196.23 RBKF |
| 626 | 4041.41 | 1196.09 (T)  | 600 | 4162.5  | 1195.68 Water | 769  | 4368    | 1195.54 RBKF |
| 624 | 4051.21 | 1196.56 (R)  | 596 | 4170.15 | 1195.69 Water | 770  | 4400.13 | 1195.44 RBKF |
| 621 | 4064.52 | 1196.02 (T)  | 594 | 4173.93 | 1195.63 Water | 771  | 4415.11 | 1195.31 RBKF |
| 619 | 4069.34 | 1195.65 (T)  | 592 | 4190.86 | 1195.56 Water | 772  | 4439.15 | 1194.88 RBKF |
| 617 | 4076.25 | 1196.11 (R)  | 590 | 4196.33 | 1195.55 Water | 773  | 4467.25 | 1195.07 RBKF |
| 613 | 4089.79 | 1195.75 (U)  | 587 | 4211.09 | 1195.53 Water | 774  | 4494.51 | 1195.98 RBKF |
| 615 | 4097.22 | 1195.2 (M)   | 585 | 4217.4  | 1195.55 Water | 775  | 4519.07 | 1196.41 RBKF |
| 609 | 4109.19 | 1195.27 (M)  | 583 | 4235.92 | 1195.56 Water | 776  | 4553.15 | 1196.2 RBKF  |
| 607 | 4120.39 | 1195.74 (R)  | 579 | 4251.94 | 1195.23 Water | 777  | 4572.64 | 1194.97 RBKF |
| 605 | 4128.58 | 1195.06 (M)  | 581 | 4259.77 | 1195.19 Water | 778  | 4610.61 | 1194.98 RBKF |
| 603 | 4131.5  | 1195.58 (T)  | 577 | 4262.41 | 1195.13 Water | 780  | 4650.62 | 1193.97 RBKF |
| 601 | 4139.63 | 1195.58 (R)  | 575 | 4275.51 | 1195.19 Water | 781  | 4677.28 | 1193.2 RBKF  |
| 597 | 4147.91 | 1195.53 (U)  | 573 | 4288.47 | 1195.16 Water | 782  | 4707.56 | 1192.82 RBKF |
| 599 | 4162.01 | 1194.62 (M)  | 571 | 4315.26 | 1194.82 Water | 783  | 4734.48 | 1193.12 RBKF |
| 595 | 4170.16 | 1195.17 (T)  | 569 | 4326.46 | 1194.55 Water | 784  | 4755.97 | 1193.59 RBKF |
| 593 | 4173.93 | 1195.5 (T)   | 566 | 4339.83 | 1194.5 Water  | 786  | 4770.84 | 1193.35 RBKF |
| 591 | 4191.05 | 1195.41 (RV) | 564 | 4352.55 | 1194.3 Water  | 785  | 4785.01 | 1193.53 RBKF |
| 589 | 4196.11 | 1193.24 (SP) | 562 | 4357.68 | 1194.33 Water | 787  | 4815.08 | 1193.4 RBKF  |
| 588 | 4203.88 | 1194.28 (T)  | 560 | 4372.96 | 1194.29 Water | 788  | 4859.78 | 1191.93 RBKF |
| 586 | 4210.93 | 1194.34 (T)  | 558 | 4385.68 | 1194.19 Water | 789  | 4884.33 | 1191.53 RBKF |
| 584 | 4217.02 | 1195.06 (G)  | 556 | 4395.01 | 1194.09 Water | 790  | 4910.06 | 1191.47 RBKF |
| 582 | 4235.8  | 1195.43 (R)  | 554 | 4414.75 | 1194.09 Water | 791  | 4936.93 | 1190.62 RBKF |
| 578 | 4252.54 | 1195.12 (R)  | 552 | 4432.69 | 1194.07 Water | 793  | 4988.59 | 1190.89 RBKF |
| 580 | 4259.88 | 1194.75 (P)  | 550 | 4443.33 | 1194.02 Water | 794  | 5006.75 | 1192.61 RBKF |
| 576 | 4262.94 | 1193.35 (P)  | 548 | 4459.33 | 1193.69 Water | 795  | 5036.88 | 1190.76 RBKF |
| 574 | 4275.11 | 1194.68 (G)  | 546 | 4481.75 | 1193.67 Water | 797  | 5067.27 | 1189.04 RBKF |
| 572 | 4288.29 | 1194.92 (T)  | 544 | 4493    | 1193.51 Water |      |         |              |
| 570 | 4315.6  | 1194.55 (R)  | 542 | 4503.9  | 1193.45 Water |      |         |              |
| 568 | 4326.23 | 1194.21 (T)  | 540 | 4507.64 | 1193.53 Water |      |         |              |
| 567 | 4328.82 | 1193.88 (M)  | 536 | 4514.09 | 1193.47 Water |      |         |              |
| 565 | 4340.3  | 1194.21 (T)  | 538 | 4539.63 | 1192.79 Water |      |         |              |
| 563 | 4352.45 | 1193.8 (U)   | 534 | 4555.98 | 1192.72 Water |      |         |              |
| 561 | 4357.62 | 1193.68 (T)  | 532 | 4562.89 | 1192.5 Water  |      |         |              |
| 559 | 4372.95 | 1194.04 (T)  | 528 | 4585.73 | 1192.54 Water |      |         |              |
| 557 | 4385.4  | 1193.97 (T)  | 524 | 4593.96 | 1192.52 Water |      |         |              |
| 555 | 4394.76 | 1193.43 (T)  | 522 | 4611.4  | 1192.52 Water |      |         |              |
| 553 | 4413.86 | 1192.92 (M)  | 520 | 4624.18 | 1192.45 Water |      |         |              |
| 551 | 4432.29 | 1193.72 (T)  | 518 | 4633.32 | 1192.51 Water |      |         |              |
| 549 | 4443.64 | 1193.89 (R)  | 516 | 4651.58 | 1191.94 Water |      |         |              |
| 547 | 4459.14 | 1193.48 (U)  | 514 | 4656.87 | 1191.91 Water |      |         |              |

|     |         |              |     |         |               |
|-----|---------|--------------|-----|---------|---------------|
| 545 | 4481.57 | 1193.46 (R)  | 511 | 4663.17 | 1191.89 Water |
| 543 | 4492.8  | 1193.17 (T)  | 509 | 4667.3  | 1191.73 Water |
| 541 | 4503.86 | 1193.18 (T)  | 507 | 4677.34 | 1191.76 Water |
| 539 | 4507.56 | 1192.82 (T)  | 505 | 4704.66 | 1191.77 Water |
| 535 | 4514.09 | 1193.24 (T)  | 503 | 4712.86 | 1191.77 Water |
| 537 | 4539.56 | 1192.43 (T)  | 501 | 4724.04 | 1191.72 Water |
| 533 | 4556.1  | 1192.42 (R)  | 499 | 4741.19 | 1191.59 Water |
| 531 | 4562.64 | 1192.2 (U)   | 497 | 4760.74 | 1191.44 Water |
| 527 | 4585.72 | 1191.75 (T)  | 495 | 4767.24 | 1191.43 Water |
| 523 | 4594.25 | 1192.24 (T)  | 493 | 4778.03 | 1191.42 Water |
| 521 | 4610.93 | 1191.23 (M)  | 491 | 4791    | 1191.38 Water |
| 519 | 4624.33 | 1192.2 (T)   | 489 | 4802.41 | 1191.33 Water |
| 517 | 4634.34 | 1192.2 (R)   | 487 | 4821.57 | 1190.85 Water |
| 515 | 4651.67 | 1191.56 (U)  | 485 | 4823.71 | 1190.73 Water |
| 513 | 4657    | 1191.37 (M)  | 483 | 4826.88 | 1190.74 Water |
| 510 | 4662.96 | 1191.77 (T)  | 481 | 4839.84 | 1190.74 Water |
| 512 | 4664.3  | 1191.75 (RV) | 479 | 4848.61 | 1190.43 Water |
| 508 | 4667.19 | 1190.38 (SP) | 477 | 4853.76 | 1190.29 Water |
| 506 | 4677.18 | 1191.13 (T)  | 475 | 4867.14 | 1190.43 Water |
| 504 | 4703.28 | 1191.56 (T)  | 473 | 4888.23 | 1189.97 Water |
| 502 | 4713.25 | 1191.3 (T)   | 471 | 4904.08 | 1189.87 Water |
| 500 | 4724.46 | 1191.47 (R)  | 467 | 4921.9  | 1189.92 Water |
| 498 | 4740.8  | 1191.07 (T)  | 469 | 4928.94 | 1189.94 Water |
| 496 | 4760.54 | 1191.13 (U)  | 465 | 4935.23 | 1189.9 Water  |
| 494 | 4766.97 | 1190.54 (P)  | 463 | 4945.32 | 1189.66 Water |
| 492 | 4777.81 | 1190.36 (M)  | 459 | 4981.08 | 1189.36 Water |
| 490 | 4791.14 | 1190.95 (T)  | 457 | 4986.61 | 1189.04 Water |
| 488 | 4802.4  | 1191.17 (R)  | 453 | 4990.32 | 1189.05 Water |
| 486 | 4821.46 | 1190.61 (T)  | 455 | 4996.13 | 1189.05 Water |
| 484 | 4823.47 | 1190.26 (M)  | 451 | 5004.99 | 1188.96 Water |
| 482 | 4826.91 | 1190.37 (T)  | 449 | 5008.9  | 1188.97 Water |
| 480 | 4839.94 | 1190.4 (T)   | 447 | 5021.13 | 1188.97 Water |
| 478 | 4848.45 | 1190.33 (T)  | 445 | 5066.11 | 1188.18 Water |
| 476 | 4853.78 | 1189.51 (M)  | 443 | 5071.54 | 1188.07 Water |
| 474 | 4866.78 | 1190.15 (R)  |     |         |               |
| 472 | 4887.48 | 1189.63 (U)  |     |         |               |
| 470 | 4903.94 | 1189.08 (P)  |     |         |               |
| 466 | 4921.55 | 1189 (M)     |     |         |               |
| 468 | 4928.7  | 1189.35 (T)  |     |         |               |
| 464 | 4935.09 | 1189.74 (R)  |     |         |               |
| 462 | 4945.23 | 1189.48 (T)  |     |         |               |
| 458 | 4981.27 | 1189.1 (R)   |     |         |               |
| 456 | 4986.36 | 1188.5 (U)   |     |         |               |
| 452 | 4989.73 | 1187.78 (M)  |     |         |               |
| 454 | 4996.16 | 1188.82 (T)  |     |         |               |
| 450 | 5005.14 | 1188.66 (M)  |     |         |               |
| 448 | 5008.8  | 1188.3 (T)   |     |         |               |
| 446 | 5021.51 | 1188.73 (R)  |     |         |               |
| 444 | 5065.74 | 1187.88 (T)  |     |         |               |
| 442 | 5070.84 | 1187.58 (LV) |     |         |               |