


**YEAR 1 of 7 (2012)**  
**ANNUAL MONITORING REPORT**  
**HERMAN DAIRY STREAM AND WETLAND RESTORATION SITE**  
Alexander County, North Carolina  
Full Delivery Contract No. 003271

Catawba River Basin  
Cataloging Unit and Targeted Local Watershed  
03050101120030



Submitted to:  
NCDENR Ecosystem Enhancement Program  
Raleigh, North Carolina

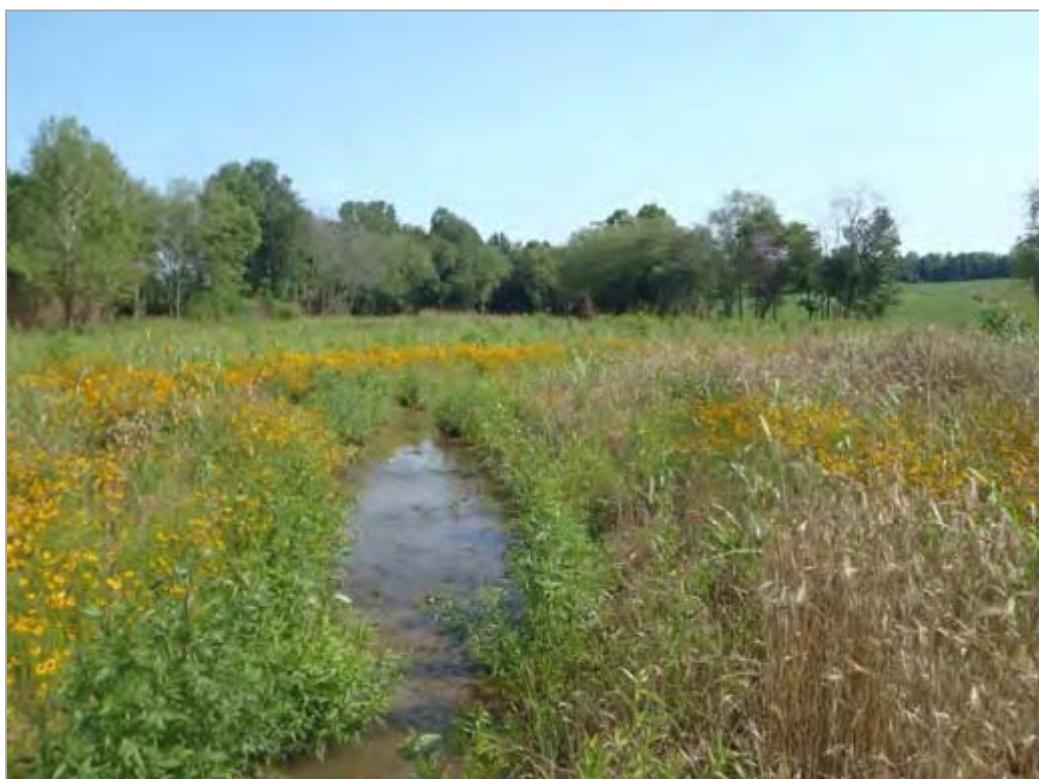

FEBRUARY 2013

**YEAR 1 of 7 (2012)**  
**ANNUAL MONITORING REPORT**  
**HERMAN DAIRY STREAM AND WETLAND RESTORATION SITE**  
Alexander County, North Carolina  
Full Delivery Contract No. 003271

Catawba River Basin  
Cataloging Unit and Targeted Local Watershed  
03050101120030



**Prepared By:**  
Restoration Systems, LLC  
1101 Haynes Street, Suite 211  
Raleigh, North Carolina 27604

and

Axiom Environmental, Inc.  
218 Snow Avenue  
Raleigh, North Carolina 27603

**Submitted to:**  
NCDENR Ecosystem Enhancement Program  
Raleigh, North Carolina



FEBRUARY 2013

## TABLE OF CONTENTS

1.0	EXECUTIVE SUMMARY .....	1
2.0	METHODOLOGY .....	3
2.1	Vegetation Assessment.....	3
2.2	Stream Assessment .....	3
2.3	Wetland Assessment .....	4
2.4	Biotic Community Changes.....	4
3.0	REFERENCES .....	5

## FIGURES

Figure 1. Site Location .....	Appendix A
Figure 2. Consolidated Current Conditions Plan View .....	Appendix A
Figure E1. Annual Climatic Data vs. 30-year Historic Data.....	Appendix E
Figure F1. Preconstruction Benthic Station Locations .....	Appendix F

## APPENDICES

### APPENDIX A. FIGURES

- Figure 1. The Site Location
- Figure 2. Monitoring Plan View

### APPENDIX B. GENERAL TABLES

- Table 1. Project Restoration Components
- Table 2. Project Activity and Reporting History
- Table 3. Project Contacts Table
- Table 4. Project Attributes Table

### APPENDIX C. VEGETATION ASSESSMENT DATA

- Table 5. Vegetation Plot Mitigation Success Summary Table
- Table 6. CVS Vegetation Metadata Table
- Table 7. CVS Stem Count Total and Planted by Plot and Species
- Vegetation Plot Photographs

### APPENDIX D. STREAM ASSESSMENT DATA

- Stream Station Photos
- Table 8a-8c. Visual Assessment Tables
- Table 9. Verification of Bankfull Events
- Tables 10a-10b. Baseline Stream Data Summary
- Tables 11a-11c. Monitoring Data-Dimensional Data Summary
- Longitudinal Profile Plots
- Cross-section Plots

## **APPENDICES (continued)**

### **APPENDIX E. HYDROLOGY DATA**

Table 12. Wetland Hydrology Criteria Attainment

2012 Groundwater Gauge Graphs

Figure E1. Annual Climatic Data vs. 30-year Historic Data

### **APPENDIX F. BENTHIC DATA**

Figure F1. Preconstruction Benthic Station Locations

Habitat Assessment Field Datasheets

## **1.0 EXECUTIVE SUMMARY**

Restoration Systems, LLC has established the Herman Dairy Stream and Wetland Mitigation Site (Site) located approximately 1.5 miles northwest of Taylorsville, in central Alexander County within 14-digit Cataloging Unit and Targeted Local Watershed 03050101120030 of the Catawba River Basin. The Site encompasses approximately 31.12 acres of land previously used for agricultural row crop production and the spray application of sludge from a lagoon associated with a dairy cattle operation. The Site was identified to assist the North Carolina Ecosystem Enhancement Program (NCEEP) in meeting its stream and wetland restoration goals. This report (compiled based on EEP's *Guidance and Content Requirements for EEP Monitoring Reports* Version 1.2.1 dated 12/1/09) serves as the Year 1 (2012) annual monitoring report.

The primary goals and objectives of this stream and wetland restoration project focused on improving water quality, enhancing flood attenuation, and restoring wildlife habitat and will be accomplished by the following.

1. Removing nonpoint sources of pollution associated with agricultural production including a) cessation of broadcasting sludge, fertilizer, pesticides, and other agricultural materials into and adjacent to Site streams/wetlands and b) restoration of a forested riparian buffer adjacent to streams and wetlands to treat surface runoff.
2. Reducing sedimentation within onsite and downstream receiving waters through a) reduction of bank erosion, vegetation maintenance, and plowing to Site streams and wetlands and b) restoration of a forested riparian buffer adjacent to Site streams and wetlands.
3. Reestablishing stream stability and the capacity to transport watershed flows and sediment loads by restoring stable dimension, pattern, and profile supported by natural in-stream habitat and grade/bank stabilization structures.
4. Promoting floodwater attenuation by a) reconnecting bankfull stream flows to the abandoned floodplain, b) restoring secondary, entrenched tributaries thereby reducing floodwater velocities within smaller catchment basins, c) restoring depressional floodplain wetlands to increase the floodwater storage capacity within the Site, and d) revegetating Site floodplains to increase frictional resistance on floodwaters crossing Site floodplains.
5. Improving aquatic habitat by enhancing stream bed variability and the use of in-stream structures.
6. Providing a terrestrial wildlife corridor and refuge in an area extensively developed for agricultural production.
7. Restoring and reestablishing natural community structure, habitat diversity, and functional continuity.
8. Enhancing and protecting the Site's full potential of stream and wetland functions and values in perpetuity.

Vegetation Success Criteria: An average density of 320 stems per acre of Characteristic Tree Species must be surviving in the first three monitoring years. Subsequently, 290 Characteristic Tree Species per acre must be surviving in year 4, 260 Characteristic Tree Species per acre in year 5, and 210 Characteristic Tree Species per acre in year 7. No single volunteer species (most notably red maple, loblolly pine, and sweet gum) will comprise more than 20 percent of the total composition at years 3, 5, or 7. If this occurs, remedial procedures/protocols outlined in the contingency plan will be implemented. During years 3, 5,

and 7, no single volunteer species, comprising over 20 percent of the total composition, may be more than twice the height of the planted trees. If this occurs, remedial procedures outlined in the contingency plan will be implemented. If, within the first 3 years, any species exhibits greater than 50 percent mortality, the species will either be replanted or an acceptable replacement species will be planted in its place as specified in the contingency plan.

**Vegetation Results:** Vegetation sampling across the Site was above the required average density with 478 planted stems per acre surviving. In addition, each individual plot exceeded success criteria and no vegetation problem areas were identified during Year 1 (2012) Monitoring.

**Stream Success Criteria:** Success criteria for stream restoration will include 1) successful classification of the reach as a functioning stream system (Rosgen 1996) and 2) channel variables indicative of a stable stream system. The channel configuration will be measured on 3000 linear feet of stream and 20 cross-sections on an annual basis in order to track changes in channel geometry, profile, or substrate. These data will be utilized to determine the success in restoring stream channel stability. Specifically, the width-to-depth ratio and bank-height ratios should be indicative of a stable or moderately unstable channel with minimal changes in cross-sectional area, channel width, and/or bank erosion along the monitoring reach. In addition, channel abandonment and/or shoot cutoffs must not occur and sinuosity values must remain relatively constant. Visual assessment of in-stream structures will be conducted to determine if failure has occurred. Failure of a structure may be indicated by collapse of the structure, undermining of the structure, abandonment of the channel around the structure, and/or stream flow beneath the structure.

**Stream Results:** As a whole, monitoring measurements indicate there have been minimal changes in both the longitudinal profile and cross-sections as compared to as-built data. The as-built channel geometry compares favorably with the emulated, stable E/C type stream reach as set forth in the detailed mitigation plan and construction plans. Current monitoring has demonstrated dimension, pattern, and profile were stable over the course of the monitoring period. No stream problem areas were noted during Year 1 (2012) monitoring.

**Hydrology Success Criteria:** According to the *Soil Survey of Alexander County*, the growing season for Alexander County as recorded in Hickory, North Carolina during the period from 1951-1984 is from March 20-November 9 (USDA 1995). Year 1 (2012) groundwater gauge installation occurred between March 30 and April 4, 2012. Given the date of groundwater gauge installation and the initiation of monitoring, Year 1 groundwater monitoring will utilize the published growing season dates from the county soil survey for success criteria. However, for future monitoring years, if soil temperatures and vegetative growth (bud burst) is documented, project gauge hydrologic success will be determined using dates from February 1-November 9 to more accurately represent the period of biological activity.

Target hydrological characteristics include saturation or inundation for 8 percent of the monitored period (March 20 1-November 9), during average climatic conditions. During years with atypical climatic conditions, groundwater gauges in reference wetlands may dictate threshold hydrology success criteria (75 percent of reference). These areas are expected to support hydrophytic vegetation. If wetland parameters are marginal as indicated by vegetation and/or hydrology monitoring, a jurisdictional determination will be performed.

**Hydrology Results:** All ten Site groundwater monitoring gauges and the reference gauge exhibited inundated/saturated within 12 inches of the surface for greater than 8 percent of the growing season. The

majority of the gauges were well above success criteria, despite being installed after the initiation of the growing season. The only gauge close to not meeting success criteria was gauge 9, which is close to an upland/wetland boundary. This gauge had two consecutive 19 day periods of wetland hydrology separated by only a few days.

**Benthics:** Although data from the certified laboratory concerning number of organisms and taxa is not available at this time, field habitat assessment forms indicate that Site restoration reaches are improving for benthic macroinvertebrates. The Habitat Assessment Field Data Sheet for UT 1 increased from a total score of 45 prior to restoration to 69 in the first annual monitoring year. Similarly, UT 2 improved from a score of 36 to 72 after the first year. Detailed data from the laboratory will be kept on file and included in future annual monitoring reports.

In summary, Site vegetation, streams, and wetland hydrology met success criteria for Year 1 (2012) monitoring. Summary information and data related to the occurrence of items such as beaver or encroachment and statistics related to performance of various project and monitoring elements can be found in tables and figures within this report's appendices. Narrative background and supporting information formerly found in these reports can be found in the Baseline Monitoring Document (formerly Mitigation Plan) and in the Mitigation Plan (formerly called the Restoration Plan) documents available on EEPs website. All raw data supporting the tables and figures in the appendices is available from EEP upon request.

## **2.0 METHODOLOGY**

Monitoring of the Site's restoration efforts will be performed until agreed upon success criteria are fulfilled. Monitoring is proposed for the stream channel, riparian vegetation, and hydrology (Figure 2, Appendix A). Stream morphology is proposed to be monitored for a period of five years. Riparian vegetation is proposed to be monitored for a period of seven years. Wetland hydrology is proposed to be monitored for a period of five years; at which time a request will be made to the IRT to discontinue groundwater hydrology monitoring. The IRT reserves the right to request additional groundwater monitoring if it deems necessary. Monitoring reports of the data collected will be submitted to the IRT no later than December of each monitoring year.

### **2.1 Vegetation Assessment**

After planting was completed, an initial evaluation was performed to verify planting methods were successful and to determine initial species composition and density. Ten sample vegetation plots (10-meter by 10-meter) were installed and measured within the Site as per guidelines established in *CVS-EEP Protocol for Recording Vegetation, Version 4.0* (Lee et al. 2006). Plots were measured in September 2012 for Year 1 monitoring. Vegetation plots are permanently monumented with 4-foot metal garden posts at each corner. In each sample plot, vegetation parameters to be monitored include species composition and species density. Visual observations of the percent cover of shrub and herbaceous species will also be documented by photograph. Vegetation plot information can be found in Appendix C.

### **2.2 Stream Assessment**

Restored stream reaches are proposed to be monitored for geometric activity for five years. Annual fall monitoring will include development of 20 channel cross-sections on riffles and pools and a water surface profile of the channel. The data will be presented in graphic and tabular format. Data to be presented will include 1) cross-sectional area, 2) bankfull width, 3) average depth, 4) maximum depth, 5) width-to-depth ratio, 6) water surface slope, and 7) sinuosity. The stream will subsequently be classified according to stream geometry and substrate (Rosgen 1996). Significant changes in channel morphology will be tracked and reported by comparing data in each successive monitoring year. Stream data can be found in Appendix D.

## **2.3 Wetland Assessment**

Ten groundwater monitoring gauges were installed within Site wetland restoration areas and one additional gauge was installed in a reference wetland to monitor groundwater hydrology (Figure 2, Appendix A). Hydrological sampling will continue for five years throughout the growing season at intervals necessary to satisfy the hydrology success criteria within each design unit (USEPA 1990). In addition, an off-site rain gauge will document rainfall data for comparison of groundwater conditions with extended drought conditions. Finally, groundwater gauges located within riverine wetlands adjacent to restored stream reaches will supplement staff gauge measurements to confirm overbank flooding events. Graphs of groundwater hydrology and precipitation from a nearby rain station are included in Appendix E.

## **2.4 Biotic Community Changes**

Changes in the biotic community are anticipated from a shift in habitat opportunities as tributaries are restored. In-stream, biological monitoring is proposed to track the changes during the monitoring period. The benthic macroinvertebrate community will be sampled using North Carolina Division of Water Quality (NCDWQ) protocols found in the Standard Operating Procedures for Benthic Macroinvertebrates (NCDWQ 2006) and Benthic Macroinvertebrate Protocols for Compensatory Stream Restoration Projects (NCDWQ 2001). Biological sampling of benthic macroinvertebrates will be used to compare preconstruction baseline data with postconstruction restored conditions.

Benthic macroinvertebrate monitoring locations were established within Site restoration reaches. Postrestoration collections occurred in approximately the same locations as prerestoration sampling; however, sampling was not possible in UT 3 due to lack of stream flow. Benthic macroinvertebrate samples were collected from UT 1 and UT 2 reaches using the Qual-4 collection method. Sampling techniques of the Qual-4 collection method consist of kick nets, sweep nets, leaf packs, and visual searches. Postproject biological sampling occurred on June 28, 2012 (data sheets are included in Appendix F); postproject monitoring will occur in June of each monitoring year.

Identification of collected organisms will be performed by personnel with NCDWQ or by a NCDWQ certified laboratory. Other data collected will include D50 values/NCDWQ habitat assessment forms. A detailed list of collected benthic macroinvertebrates is not available at this time due to delays at the certified laboratory; however, Habitat Assessment Field Data Sheets used in benthic macroinvertebrate monitoring are enclosed in Appendix F.


### **3.0 REFERENCES**

- Lee, M.T., R.K. Peet, S.D. Roberts, and T.R. Wentworth. 2006. CVS-EEP Protocol for Recording Vegetation. Version 4.0. North Carolina Department of Environment and Natural Resources, Ecosystem Enhancement Program. Raleigh, North Carolina.
- North Carolina Division of Water Quality (NCDWQ). 2001. Benthic Macroinvertebrate Monitoring Protocols for Compensatory Mitigation. 401/Wetlands Unit, Department of Environment and Natural Resources. Raleigh, North Carolina.
- North Carolina Division of Water Quality (NCDWQ). 2006. Standard Operating Procedures for Benthic Macroinvertebrates. Biological Assessment Unit, Department of Environment and Natural Resources. Raleigh, North Carolina.
- Rosgen, D.L. 1996. Applied River Morphology. Wildland Hydrology Books, Pagosa Springs, CO.
- Schafale, M.P. and A.S. Weakley. 1990. Classification of the Natural Communities of North Carolina: Third Approximation. North Carolina Natural Heritage Program, Division of Parks and Recreation, North Carolina Department of Environment, Health, and Natural Resources. Raleigh, North Carolina.
- United States Department of Agriculture (USDA). 1995. Soil Survey of Alexander County, North Carolina. Natural Resources Conservation Service, United States Department of Agriculture.
- United States Environmental Protection Agency (USEPA). 1990. Mitigation Site Type Classification (MiST). USEPA Workshop, August 13-15, 1989. EPA Region IV and Hardwood Research Cooperative, NCSU, Raleigh, North Carolina.

## **Appendix A. Figures**


Figure 1. The Site Location


Figure 2. Consolidated Current Conditions Plan View

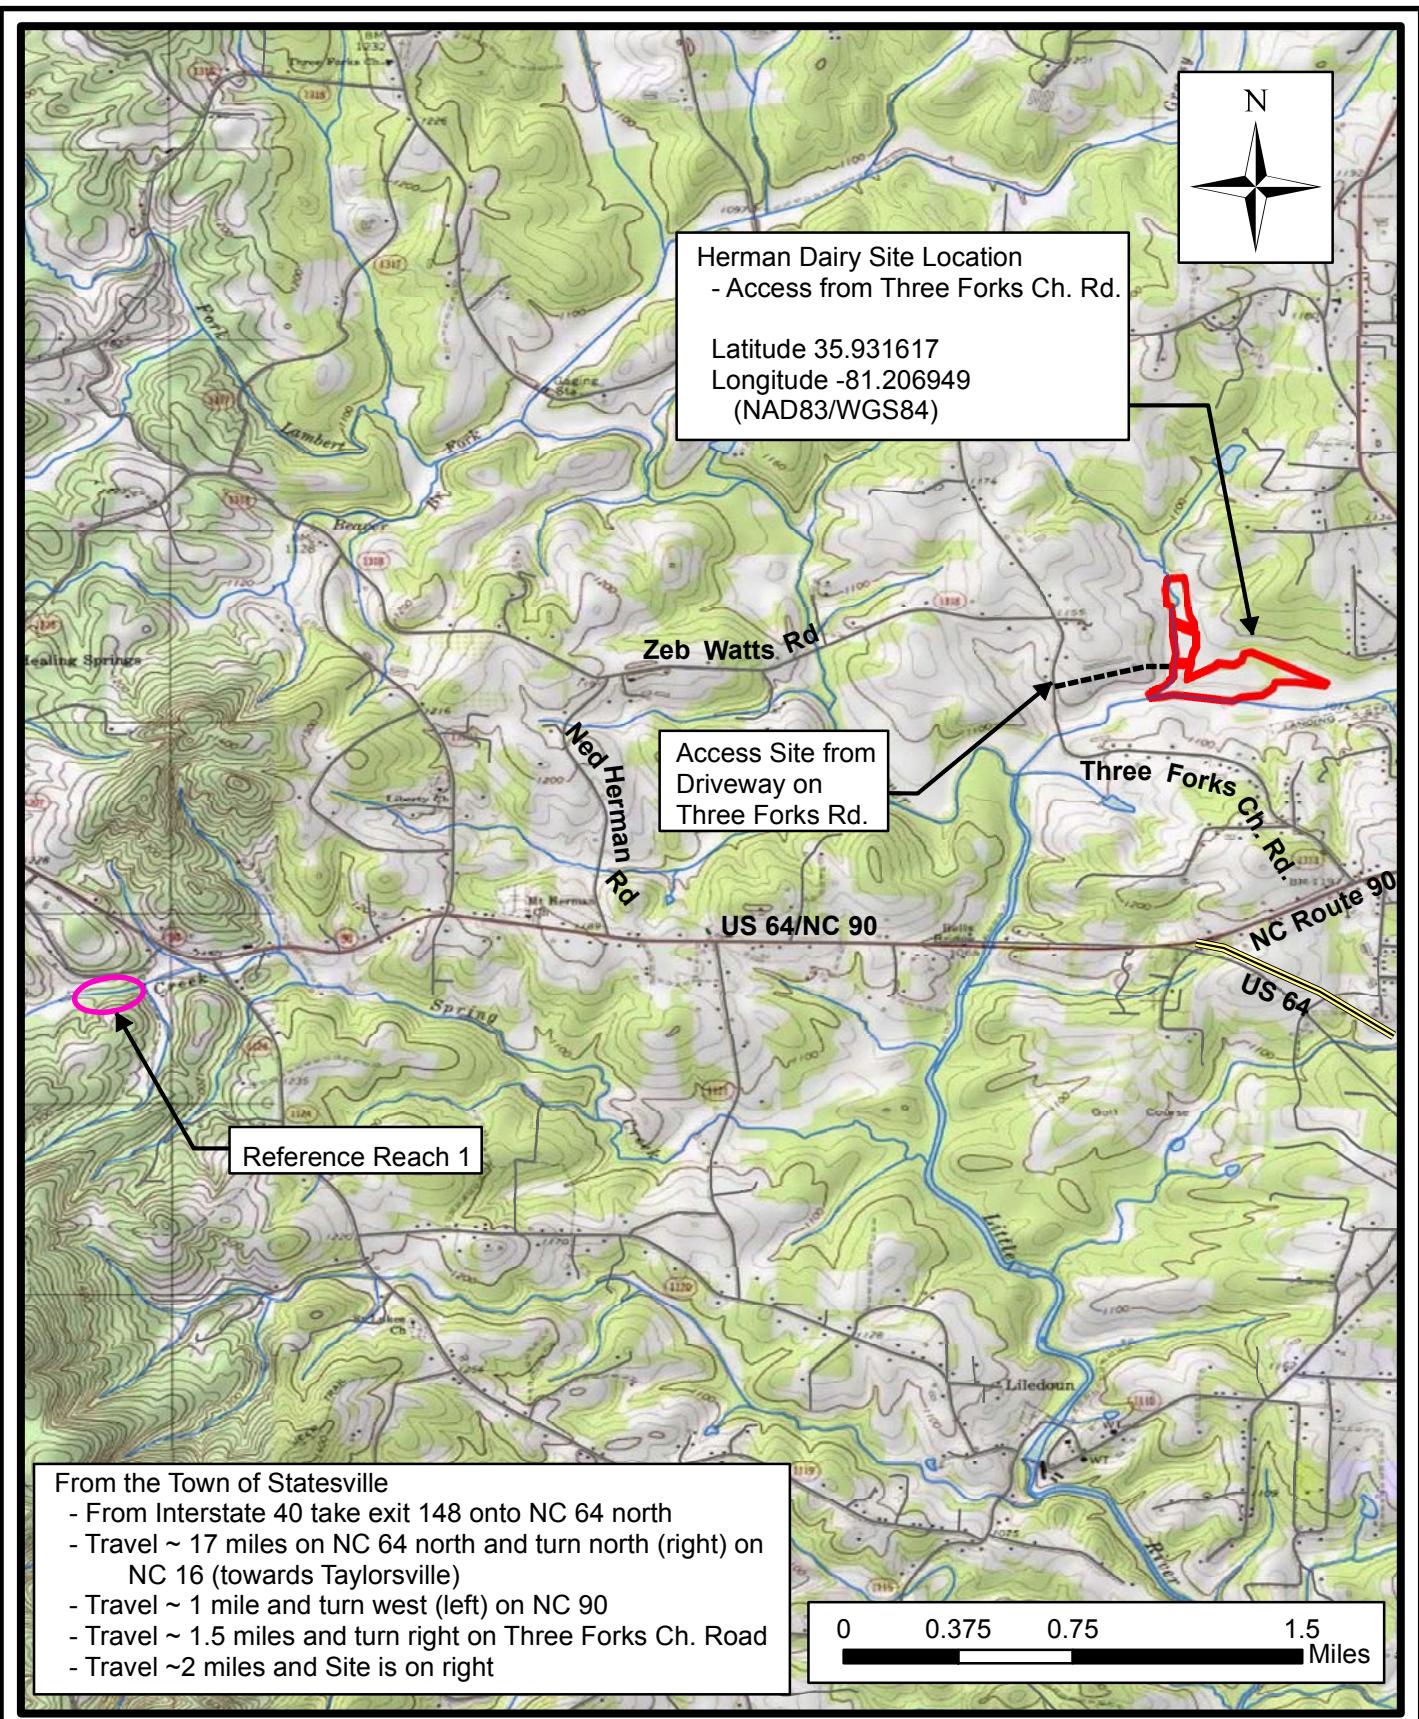


## HERMAN DAIRY STREAM AND WETLAND MITIGATION SITE THE SITE LOCATION Alexander County, North Carolina

Dwn. By: WGL/CLF	FIGURE 1
Date: May 2012	
Project: 10-016	

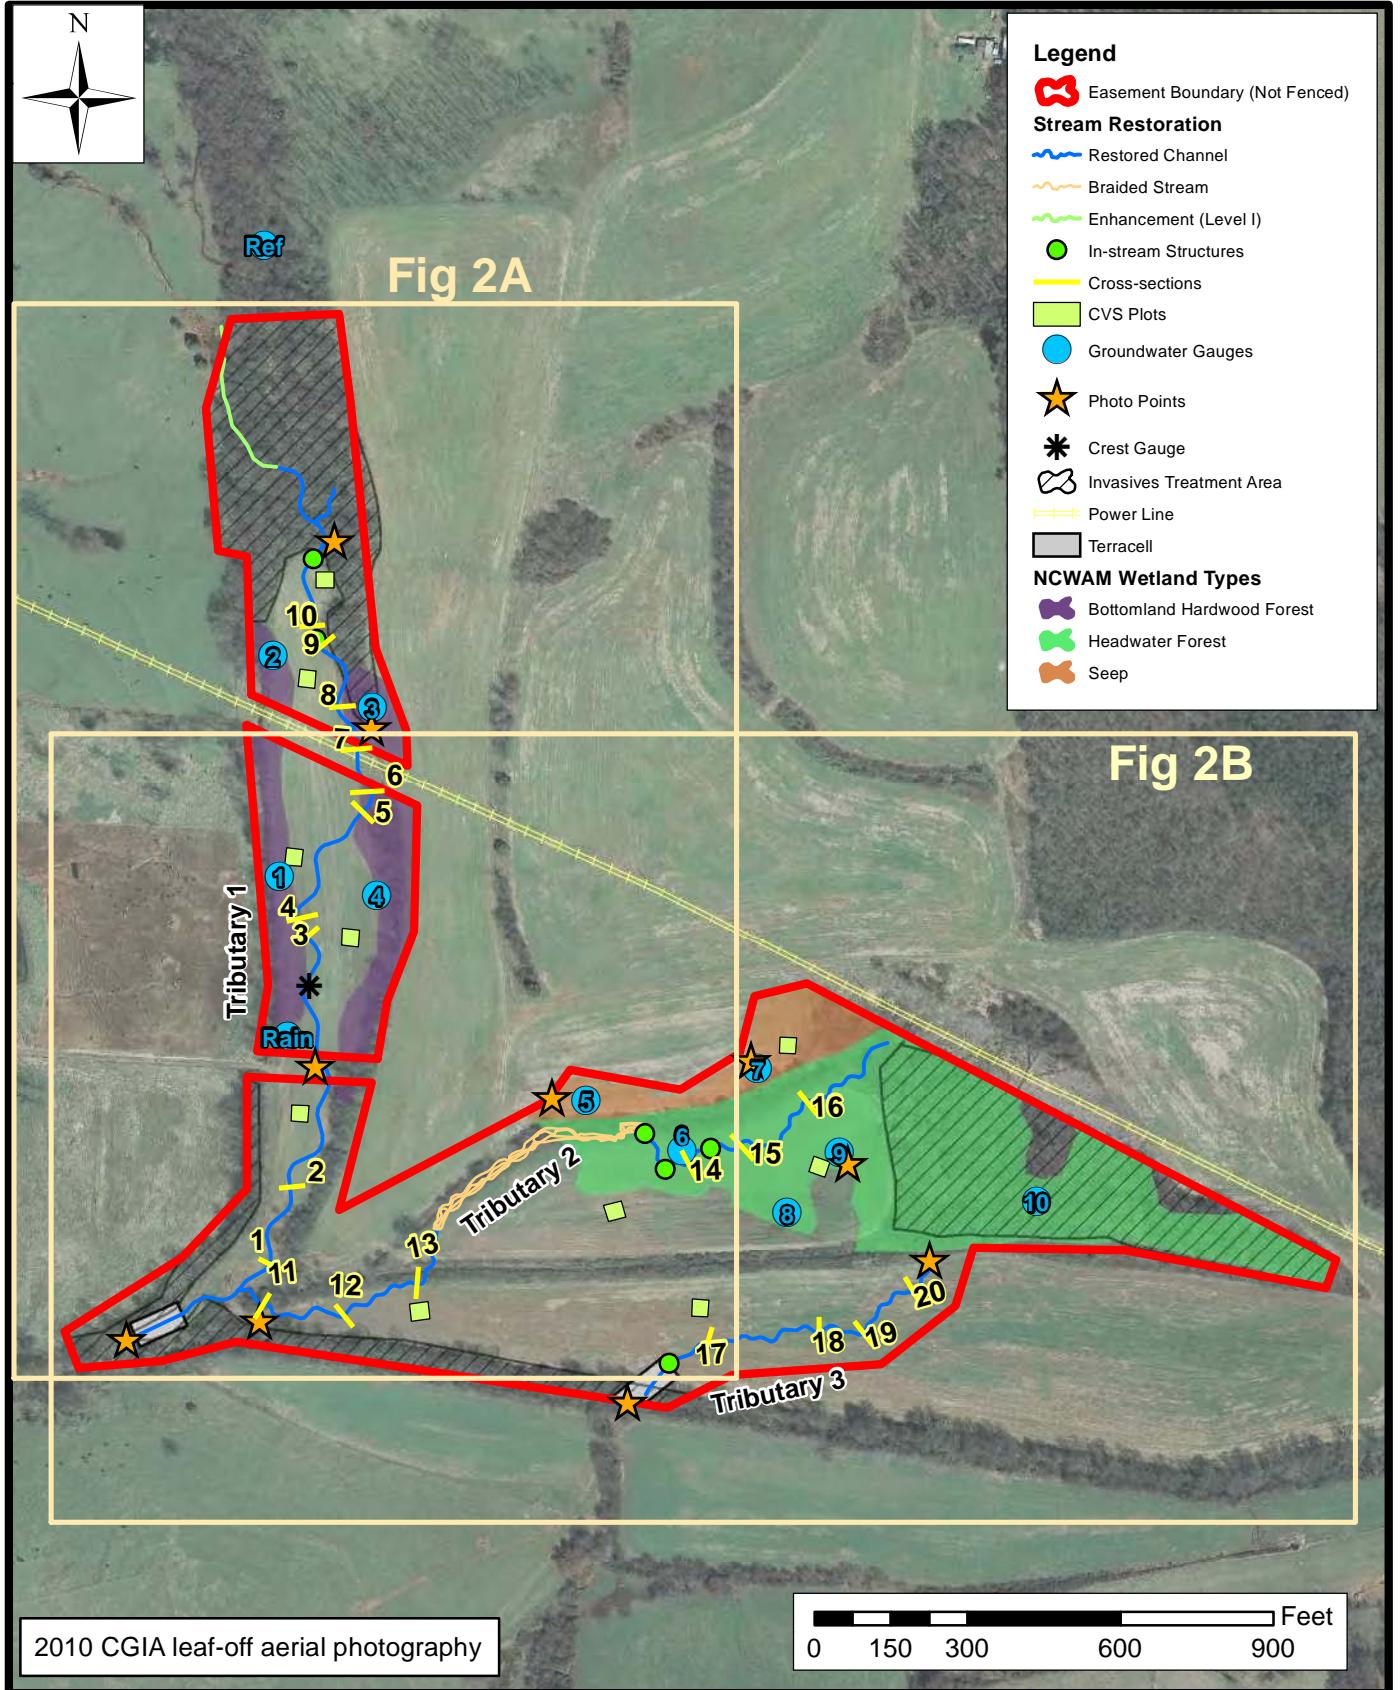

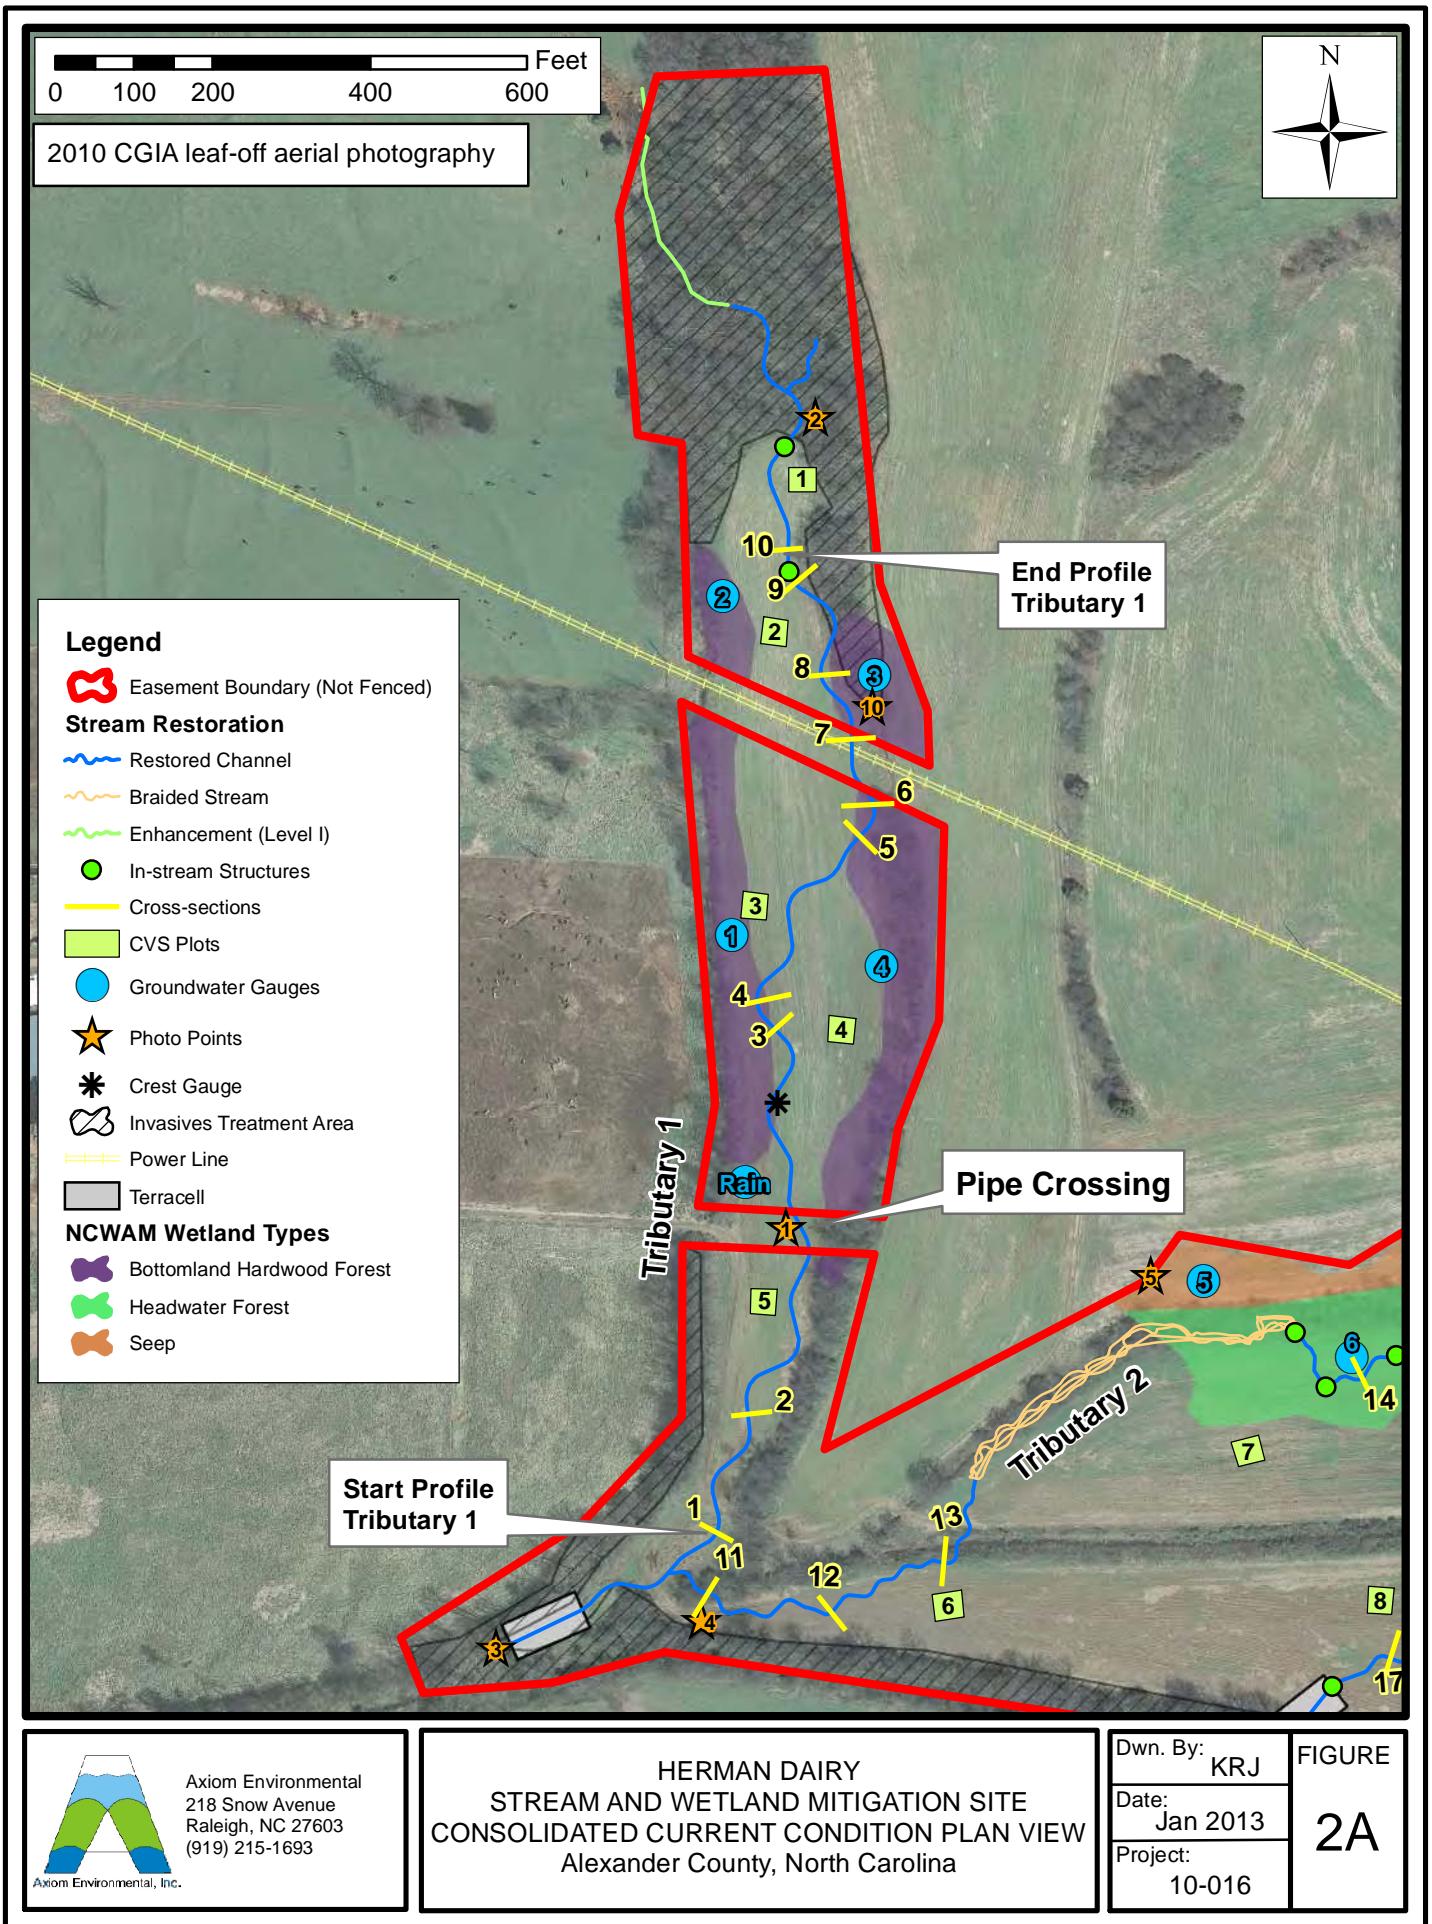

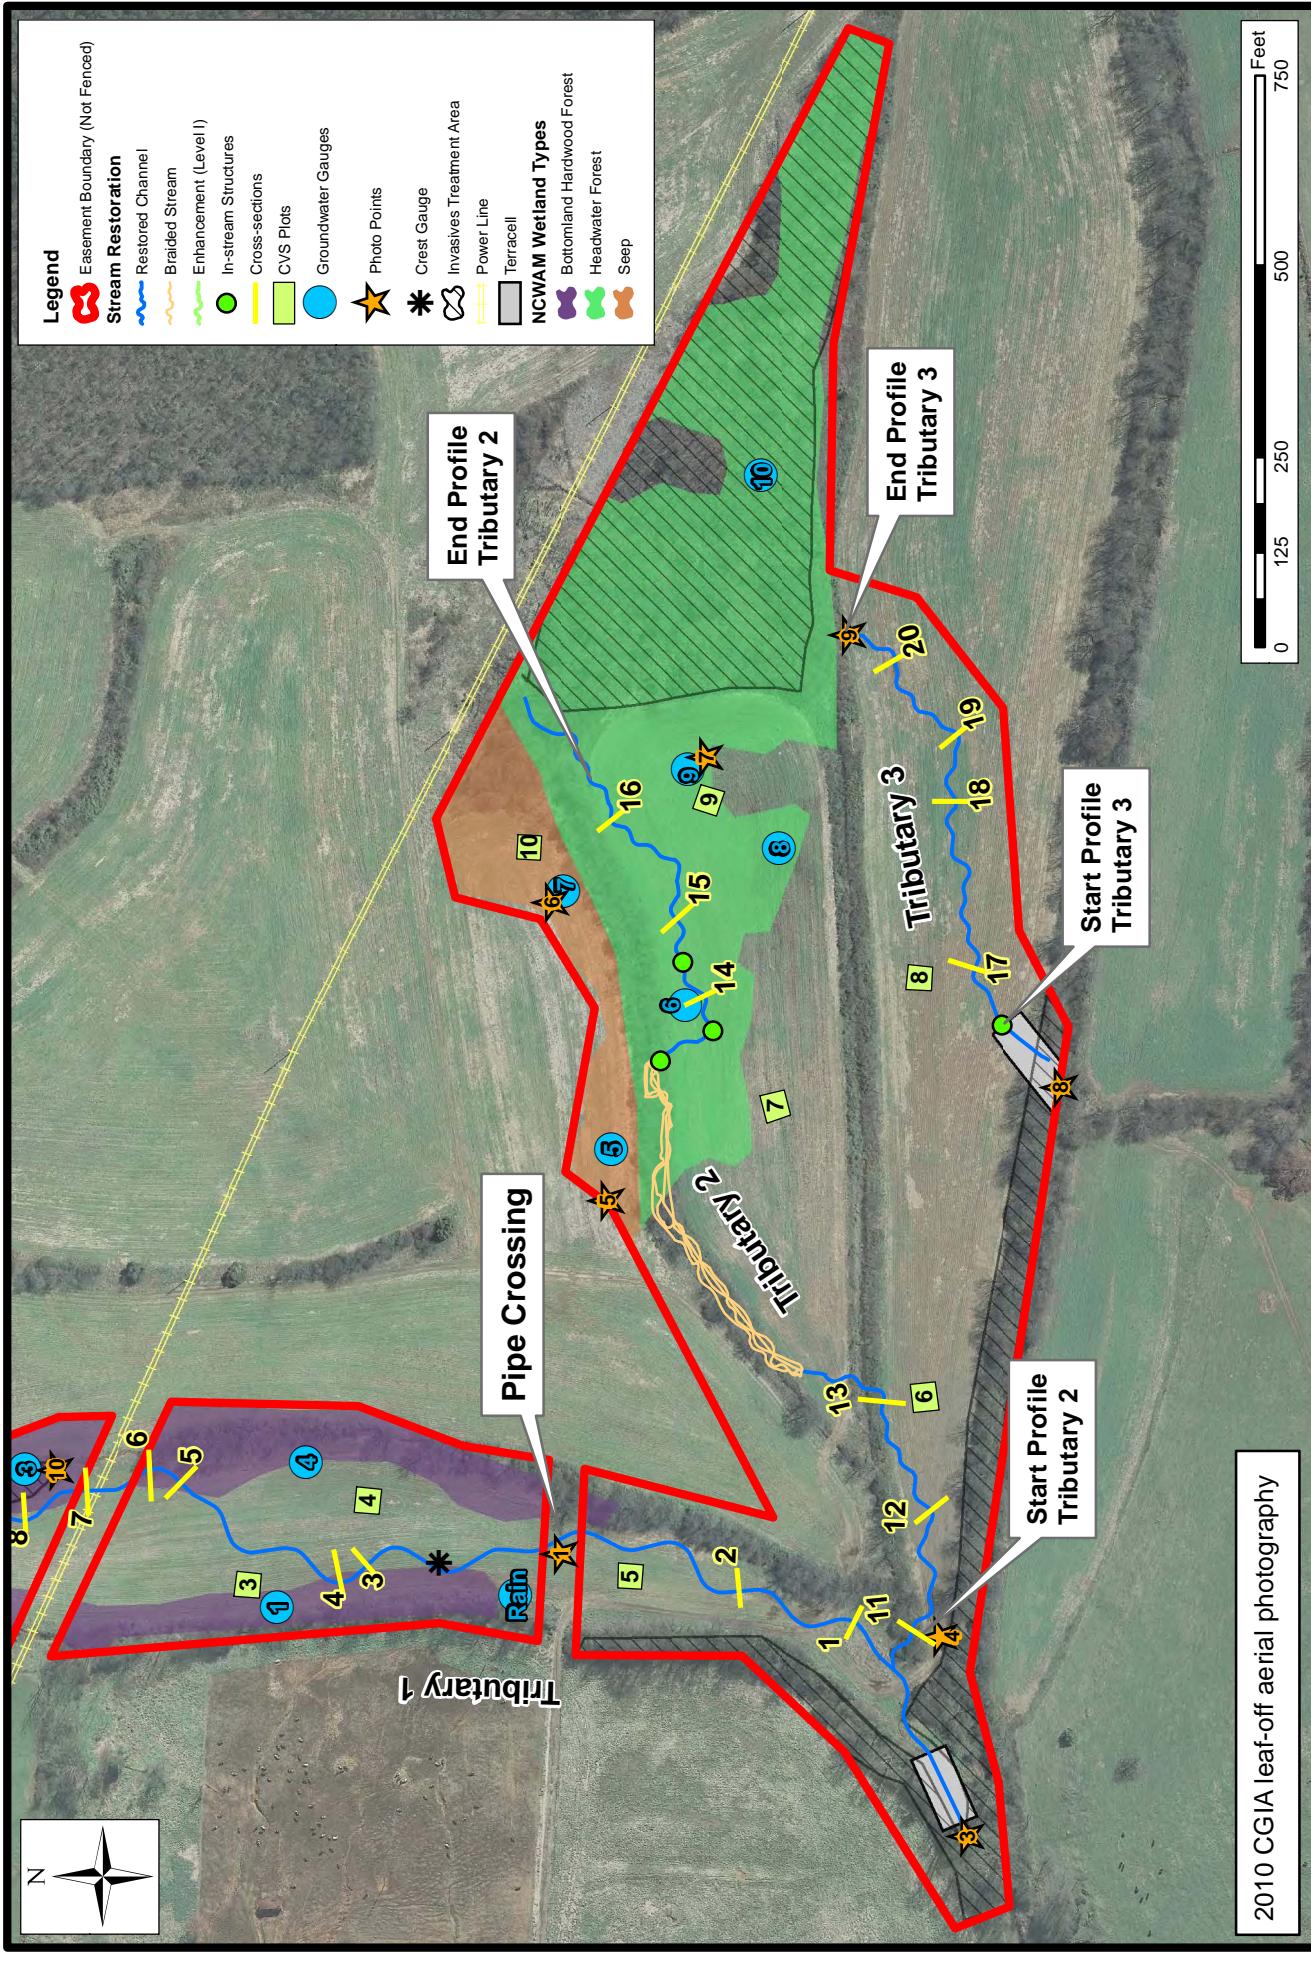

## **Appendix B. General Project Tables**

- Table 1. Project Restoration Components
- Table 2. Project Activity and Reporting History
- Table 3. Project Contacts Table
- Table 4. Project Attribute Table

**Table 1. Project Restoration Components**  
**Herman Dairy Restoration Site**

Mitigation Credits						
Stream		Riparian Wetland			Nonriparian Wetland	
Restoration	Restoration Equivalent	Restoration	Restoration Equivalent	Restoration	Restoration Equivalent	
4560	220	7.2	1.1	1.2	0.05	
Projects Components						
Station Range	Existing Linear Footage/Acreage	Priority Approach	Restoration/Restoration Equivalent	Restoration Linear Footage/Acreage	Mitigation Ratio	Comment
UT1 10+00-31+67.8* UT1A 10+00-10+85.71 UT2 10+00-16+69.04, 21+50.67-27+10.09 UT3 10+00-17+28.39	4540	I	Restoration	3997	1:1	Priority I stream restoration through construction of stable channel at the historic floodplain elevation.
UT2 16+69.04-21+50.67 UT3 upper 81.10 linear feet		--	Restoration	563	1:1	Braided stream restoration by redirecting diffuse flow across riparian wetlands. Linear footage of stream is based on a straight line valley distance.
UT1 upper 330.00 linear feet	330	Level I	Enhancement	330	1.5:1	Level I stream enhancement through cessation of current land use practices, removing invasive species, and planting with native forest vegetation.
--	0	--	Restoration	7.2	1:1	Restoration of riparian wetlands within the floodplain as the result of stream restoration activities, filling abandoned channels and ditches, removing spoil castings, and planting with native forest vegetation.
--	2.2	--	Enhancement	2.2	2:1	Enhancement of existing riparian wetlands characterized by disturbed pasture by planting with native forest vegetation.
--	0	--	Restoration	1.2	1:1	Restoration of nonriparian wetlands by removing spoil castings, filling abandoned ditches to rehydrate hydric soils along the slope, eliminating land use practices, and planting with native forest vegetation.
--	0.1	--	Enhancement	0.1	2:1	Enhancement of existing nonriparian wetlands characterized by disturbed pasture by planting with native forest vegetation.
Component Summation						
Restoration Level	Stream (linear footage)	Riparian Wetland (acreage)			Nonriparian Wetland (acreage)	
Restoration	4560	7.2			1.2	
Enhancement (Level 1)	330	--			--	
Enhancement	--	2.2			0.05	
<b>Totals</b>	<b>4890</b>	<b>9.4</b>			<b>1.25</b>	
<b>Mitigation Units</b>	<b>4780 SMUs</b>	<b>8.3 Riparian WMUs</b>			<b>1.25 Nonriparian WMUs</b>	

\*Restoration linear footage excludes 145.76 linear feet of stream located within the utility easement and 67.79 linear feet of stream located within a culverted crossing, which are both excluded from the easement.

**Table 2. Project Activity and Reporting History**  
**Herman Dairy Restoration Site**

<b>Activity or Deliverable</b>	<b>Data Collection Complete</b>	<b>Completion or Delivery</b>
Technical Proposal (RFP No. 16-002830)	--	March 2010
EEP Contract No. 003271	--	July 23, 2010
Restoration Plan	--	January 2011
Construction Plans	--	August 2011
Construction Earthwork		March 2012
As-Built Documentation		June 2012
Year 1 (2012) Annual Monitoring	September 2012	October 2012

**Table 3. Project Contacts Table**  
**Herman Dairy Restoration Site**

<b>Full Delivery Provider</b>	Restoration Systems 1101 Haynes Street, Suite 211 Raleigh, North Carolina 27604 George Howard and John Preyer 919-755-9490
<b>Designer</b>	Axiom Environmental, Inc. 218 Snow Avenue Raleigh, NC 27603 Grant Lewis 919-215-1693
<b>Construction Plans and Sediment and Erosion Control Plans</b>	Sungate Design Group, PA 915 Jones Franklin Road Raleigh, NC 27606 W. Henry Wells, Jr, PE 919-859-2243
<b>Construction and Planting Contractor</b>	Land Mechanic Designs 780 Landmark Road Willow Spring, NC 27592 Lloyd Glover 919-639-6132
<b>As-built Surveyor</b>	K2 Design Group 5688 US Highway 70 East Goldsboro, NC 27534 John Rudolph 919-751-0075
<b>Baseline Data Collection and Annual Monitoring</b>	Axiom Environmental, Inc. 218 Snow Avenue Raleigh, NC 27603 Grant Lewis 919-215-1693

**Table 4. Project Attribute Table**  
**Herman Dairy Restoration Site**

Project County	Alexander County, North Carolina		
Physiographic Region	Northern Inner Piedmont		
Ecoregion	Carolina Slate Belt		
Project River Basin	Catawba		
USGS HUC for Project (14 digit)	03050101120030		
NCDWQ Sub-basin for Project	03-08-32		
Identify planning area (LWP, RBRP, other)?	Yes – Upper Catawba River Basin Restoration Priorities 2009		
WRC Class (Warm, Cool, Cold)	Warm		
% of project easement fenced or demarcated	100		
Beaver activity observed during design phase?	Yes		
<b>Unnamed Tributaries to Muddy Fork</b>			
	<b>UT 1</b>	<b>UT 2</b>	<b>UT 3</b>
Drainage Area	1.0	0.06	0.04
Stream Order (USGS topo)	2nd	1st	1st
Restored Length (feet)	2156	1684	760
Perennial (P) or Intermittent (I)	P	P	I
Watershed Type	Rural	Rural	Rural
Watershed impervious cover	<5%	<5%	<5%
NCDWQ AU/Index number	11-69-4	11-69-4	11-69-4
NCDWQ Classification	C	C	C
303d listed?	No	No	No
Upstream of a 303d listed	Yes	Yes	Yes
Reasons for 303d listed segment	aquatic life/sediment	aquatic life/sediment	aquatic life/sediment
Total acreage of easement	31.12	31.12	31.12
Total existing vegetated acreage of easement	8	8	8
Total planted restoration acreage	31.5	31.5	31.5
Rosgen Classification of preexisting	Cd5	Fc5/6	Fc5/6
Rosgen Classification of As-built	E/C 4/5	E/C 4/5	E/C 4/5
Valley type	VIII	VIII	VIII
Valley slope	0.0066	0.0052	0.0013
Cowardin classification of proposed	R3UB1/2	R3UB1/2	R4SB3/4
Trout waters designation	NA	NA	NA
Species of concern, endangered etc.	NA	NA	NA
Dominant Soil Series	Codorus/Hatboro	Codorus/Hatboro	Codorus/Hatboro

## **Appendix C. Vegetation Assessment Data**

Table 5. Vegetation Plot Mitigation Success Summary Table

Table 6. CVS Vegetation Metadata Table

Table 7. CVS Stem Count Total and Planted by Plot and Species

Vegetation Plot Photographs

**Table 5. Vegetation Plot Mitigation Success Summary Table**

Vegetation Plot ID	Vegetation Survival Threshold Met?	Tract Mean
1	Yes	100%
2	Yes	
3	Yes	
4	Yes	
5	Yes	
6	Yes	
7	Yes	
8	Yes	
9	Yes	
10	Yes	

**Table 6. CVS Vegetation Metadata Table**

<b>Report Prepared By</b>	Corri Faquin
<b>Date Prepared</b>	9/21/2012 8:17
<b>database name</b>	RestorationSystems-2012-A.mdb
<b>database location</b>	C:\Documents and Settings\pperkinson\Desktop
<b>computer name</b>	PHILLIP-LT
<b>file size</b>	81784832
<b>DESCRIPTION OF WORKSHEETS IN THIS DOCUMENT-----</b>	
<b>Metadata</b>	Description of database file, the report worksheets, and a summary of project(s) and project data.
<b>Proj, planted</b>	Each project is listed with its PLANTED stems per acre, for each year. This excludes live stakes.
<b>Proj, total stems</b>	Each project is listed with its TOTAL stems per acre, for each year. This includes live stakes, all planted stems, and all natural/volunteer stems.
<b>Plots</b>	List of plots surveyed with location and summary data (live stems, dead stems, missing, etc.).
<b>Vigor</b>	Frequency distribution of vigor classes for stems for all plots.
<b>Vigor by Spp</b>	Frequency distribution of vigor classes listed by species.
<b>Damage</b>	List of most frequent damage classes with number of occurrences and percent of total stems impacted by each.
<b>Damage by Spp</b>	Damage values tallied by type for each species.
<b>Damage by Plot</b>	Damage values tallied by type for each plot.
<b>Planted Stems by Plot and Spp</b>	A matrix of the count of PLANTED living stems of each species for each plot; dead and missing stems are excluded.
<b>ALL Stems by Plot and spp</b>	A matrix of the count of total living stems of each species (planted and natural volunteers combined) for each plot; dead and missing stems are excluded.
<b>PROJECT SUMMARY-----</b>	
<b>Project Code</b>	Herman
<b>project Name</b>	Herman Dairy
<b>Description</b>	Stream and wetland restoration Alexander County NC
<b>River Basin</b>	Catawba
<b>Sampled Plots</b>	10

**Table 7. CVS Stem Count Total and Planted by Plot and Species**

Herman Dairy Stream and Wetland Restoration Site

Scientific Name	Common Name	Species Type	Current Plot Data (MY1 2012)														
			Herman-P-0001			Herman-P-0002			Herman-P-0003			Herman-P-0004			Herman-P-0005		
			PnoLS	P-all	T	PnoLS	P-all	T	PnoLS	P-all	T	PnoLS	P-all	T	PnoLS	P-all	T
Acer negundo	boxelder	Tree															15
Acer rubrum	red maple	Tree						1									
Betula nigra	river birch	Tree	4	4	4	4	4	4	1	1	1	1	1	1	1	1	1
Carpinus caroliniana	American hornbeam	Tree													2	2	2
Carya	hickory	Tree							1	1	1				1	1	1
Cornus amomum	silky dogwood	Shrub	1	1	1												
Fraxinus pennsylvanica	green ash	Tree	1	1	1	1	1	1	2	2	2	4	4	4	1	1	3
Liriodendron tulipifera	tuliptree	Tree	1	1	1	1	1	2				1	1	1		6	6
Nyssa	tupelo	Tree							6	6	6				5	5	5
Platanus occidentalis	American sycamore	Tree															14
Quercus	oak	Tree															
Quercus nigra	water oak	Tree													2	2	2
Quercus pagoda	cherrybark oak	Tree	2	2	2	2	2	2	2	2	2	3	3	3	2	2	3
Quercus phellos	willow oak	Tree													1	1	1
Ulmus americana	American elm	Tree															
Unknown		Shrub or Tree													1	1	1
Stem count			9	9	9	8	8	10	12	12	12	9	9	9	16	16	16
size (ares)				1			1					1			1		1
size (ACRES)			0.02		0.02		0.02		0.02		0.02		0.02		0.02		
Species count			5	5	5	4	4	5	5	5	5	4	4	4	9	9	9
Stems per ACRE			364.2	364.2	364.2	323.7	323.7	404.7	485.6	485.6	485.6	364.2	364.2	364.2	647.5	647.5	526.1

**Color for Density**

Exceeds requirements by 10%

Exceeds requirements, but by less than 10%

Fails to meet requirements, by less than 10%

Fails to meet requirements by more than 10%

**Table 7. CVS Stem Count Total and Planted by Plot and Species (continued)**

Herman Dairy Stream and Wetland Restoration Site

Scientific Name	Common Name	Species Type	Current Plot Data (MY1 2012)												Annual Means					
			Herman-P-0007			Herman-P-0008			Herman-P-0009			Herman-P-0010			MY1 (2012)			MY0 (2012)		
			PnoLS	P-all	T	PnoLS	P-all	T	PnoLS	P-all	T	PnoLS	P-all	T	PnoLS	P-all	T	PnoLS	P-all	T
Acer negundo	boxelder	Tree																15		
Acer rubrum	red maple	Tree									6							7		
Betula nigra	river birch	Tree				3	3	3	2	2	2	2	2	2	2	19	19	19	41	41
Carpinus caroliniana	American hornbeam	Tree													2	2	2	3	3	3
Carya	hickory	Tree											2	2	2	4	4	4		
Cornus amomum	silky dogwood	Shrub				1	1	1							2	2	2	2	2	2
Fraxinus pennsylvanica	green ash	Tree	4	4	4	6	6	6	9	9	9	2	2	2	33	33	33	32	32	32
Liriodendron tulipifera	tuliptree	Tree	3	3	3				4	4	4	1	1	1	17	17	18	25	25	25
Nyssa	tupelo	Tree										3	3	3	14	14	14			
Platanus occidentalis	American sycamore	Tree								32							46	1	1	1
Quercus	oak	Tree										1	1	1	1	1	1	6	6	6
Quercus nigra	water oak	Tree													2	2	2			
Quercus pagoda	cherrybark oak	Tree	2	2	2	2	2	2	1	1	1	3	3	3	22	22	22	23	23	23
Quercus phellos	willow oak	Tree													1	1	1			
Ulmus americana	American elm	Tree																2	2	2
Unknown		Shrub or Tree													1	1	1	10	10	10
Stem count			9	9	9	12	12	12	16	16	54	14	14	14	118	118	187	145	145	145
size (ares)				1			1			1			1			10			10	
size (ACRES)				0.02			0.02			0.02			0.02			0.25			0.25	
Species count			3	3	3	4	4	4	4	4	6	7	7	7	12	12	15	10	10	10
Stems per ACRE			364.2	364.2	364.2	485.6	485.6	485.6	647.5	647.5	2185	566.6	566.6	566.6	477.5	477.5	756.8	586.8	586.8	586.8

**Color for Density**

Exceeds requirements by 10%

Exceeds requirements, but by less than 10%


Fails to meet requirements, by less than 10%

Fails to meet requirements by more than 10%

**Herman Dairy**  
**2012 (Year 1) Vegetation Monitoring Photographs**  
**Taken September 2012**



**Herman Dairy**  
**2012 (Year 1) Vegetation Monitoring Photographs**  
**Taken September 2012**  
**(continued)**

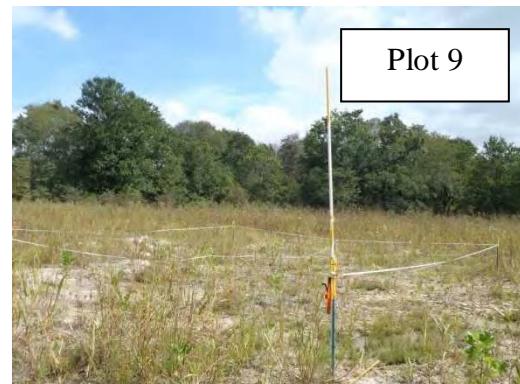

## **Appendix D. Stream Assessment Data**

### **Stream Station Photos**

Table 8a-8c. Visual Assessment Tables

Table 9. Verification of Bankfull Events

Tables 10a-10c. Baseline Stream Data Summary

Tables 11a-11e. Monitoring Data-Dimensional Data Summary

Longitudinal Profile Plots

Cross-section Plots

**Herman Dairy**  
**Fixed Station Photographs (continued)**  
**Taken September 20, 2012**


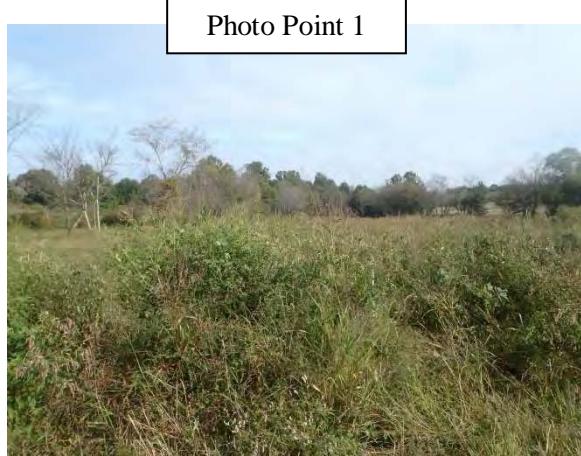


Photo Point 5

No photo available

Photo Point 6

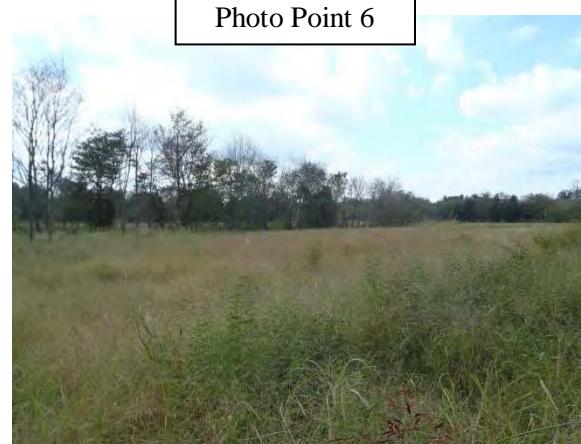

**Herman Dairy**  
**Fixed Station Photographs (continued)**  
**Taken September 20, 2012**


**Photo Point 7**



**Photo Point 8**



**Photo Point 9**

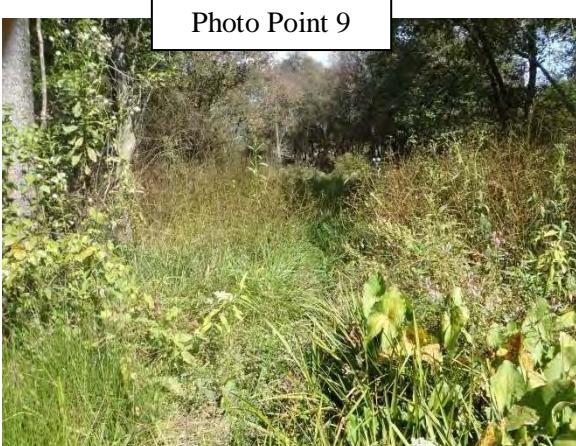

**Photo Point 10**



Table 8A  
Reach ID  
Assessed Length

Visual Stream Morphology Stability Assessment

Tributary 1  
1374

Major Channel Category	Channel Sub-Category	Metric	Number Stable, Performing as Intended	Total Number in As-built	Number of Unstable Segments	Amount of Unstable Footage	% Stable, Performing as Intended	Number with Stabilizing Woody Vegetation	Footage with Stabilizing Woody Vegetation	Adjusted % for Stabilizing Woody Vegetation
1. Bed	1. Vertical Stability (Riffle and Run units)	1. <u>Aggradation</u> - Bar formation/growth sufficient to significantly deflect flow laterally (not to include point bars)			0	0	100%			
		2. <u>Degradation</u> - Evidence of downcutting			0	0	100%			
	2. Riffle Condition	1. <u>Texture/Substrate</u> - Riffle maintains coarser substrate	19	19			100%			
		1. <u>Depth</u> Sufficient (Max Pool Depth : Mean Bankfull Depth $\geq$ 1.6)	20	20			100%			
	3. Meander Pool Condition	2. Length appropriate (>30% of centerline distance between tail of upstream riffle and head of downstream riffle)	100	100			100%			
		1. Thalweg centering at upstream of meander bend (Run)	100	100			100%			
	4. Thalweg Position	2. Thalweg centering at downstream of meander (Glide)	100	100			100%			
2. Bank	1. Scoured/Eroding	Bank lacking vegetative cover resulting simply from poor growth and/or scour and erosion			0	0	100%			100%
	2. Undercut	Banks undercut/overhanging to the extent that mass wasting appears likely. Does NOT include undercuts that are modest, appear sustainable and are providing habitat.			0	0	100%			100%
	3. Mass Wasting	Bank slumping, calving, or collapse			0	0	100%			100%
			<b>Totals</b>		0	0	100%	0	0	100%
3. Engineered Structures	1. Overall Integrity	Structures physically intact with no dislodged boulders or logs.	2	2			100%			
	2. Grade Control	Grade control structures exhibiting maintenance of grade across the sill.	2	2			100%			
	2a. Piping	Structures lacking any substantial flow underneath sills or arms.	2	2			100%			
	3. Bank Protection	Bank erosion within the structures extent of influence does <u>not</u> exceed 15%. (See guidance for this table in EEP monitoring guidance document)	2	2			100%			
	4. Habitat	Pool forming structures maintaining ~ Max Pool Depth : Mean Bankfull Depth ratio $\geq$ 1.6 Rootwads/logs providing some cover at base-flow.	2	2			100%			

Table8B  
Reach ID  
Assessed Length

Visual Stream Morphology Stability Assessment

Tributary 2  
1522

Major Channel Category	Channel Sub-Category	Metric	Number Stable, Performing as Intended	Total Number in As-built	Number of Unstable Segments	Amount of Unstable Footage	% Stable, Performing as Intended	Number with Stabilizing Woody Vegetation	Footage with Stabilizing Woody Vegetation	Adjusted % for Stabilizing Woody Vegetation		
1. Bed	1. Vertical Stability (Riffle and Run units)	1. <u>Aggradation</u> - Bar formation/growth sufficient to significantly deflect flow laterally (not to include point bars)			0	0	100%					
		2. <u>Degradation</u> - Evidence of downcutting			0	0	100%					
	2. Riffle Condition	1. <u>Texture/Substrate</u> - Riffle maintains coarser substrate	39	39			100%					
		1. <u>Depth</u> Sufficient (Max Pool Depth : Mean Bankfull Depth $\geq$ 1.6)					100%					
	3. Meander Pool Condition	2. Length appropriate (>30% of centerline distance between tail of upstream riffle and head of downstream riffle)	100	100			100%					
		1. Thalweg centering at upstream of meander bend (Run)					100%					
	4. Thalweg Position	2. Thalweg centering at downstream of meander (Glide)	100	100			100%					
							100%					
2. Bank	1. Scoured/Eroding	Bank lacking vegetative cover resulting simply from poor growth and/or scour and erosion			0	0	100%			100%		
	2. Undercut	Banks undercut/overhanging to the extent that mass wasting appears likely. Does NOT include undercuts that are modest, appear sustainable and are providing habitat.			0	0	100%			100%		
	3. Mass Wasting	Bank slumping, calving, or collapse			0	0	100%			100%		
			<b>Totals</b>		0	0	100%	0	0	100%		
3. Engineered Structures	1. Overall Integrity	Structures physically intact with no dislodged boulders or logs.	3	3			100%					
	2. Grade Control	Grade control structures exhibiting maintenance of grade across the sill.	3	3			100%					
	2a. Piping	Structures lacking any substantial flow underneath sills or arms.	3	3			100%					
	3. Bank Protection	Bank erosion within the structures extent of influence does <u>not</u> exceed 15%. (See guidance for this table in EEP monitoring guidance document)	3	3			100%					
	4. Habitat	Pool forming structures maintaining ~ Max Pool Depth : Mean Bankfull Depth ratio $\geq$ 1.6 Rootwads/logs providing some cover at base-flow.	3	3			100%					

Table 8C  
Reach ID  
Assessed Length

**Visual Stream Morphology Stability Assessment**

Tributary 3  
644

Major Channel Category	Channel Sub-Category	Metric	Number Stable, Performing as Intended	Total Number in As-built	Number of Unstable Segments	Amount of Unstable Footage	% Stable, Performing as Intended	Number with Stabilizing Woody Vegetation	Footage with Stabilizing Woody Vegetation	Adjusted % for Stabilizing Woody Vegetation
1. Bed	1. Vertical Stability (Riffle and Run units)	1. <u>Aggradation</u> - Bar formation/growth sufficient to significantly deflect flow laterally (not to include point bars)			0	0	100%			
		2. <u>Degradation</u> - Evidence of downcutting			0	0	100%			
	2. Riffle Condition	1. <u>Texture/Substrate</u> - Riffle maintains coarser substrate	27	27			100%			
		1. <u>Depth</u> Sufficient (Max Pool Depth : Mean Bankfull Depth $\geq$ 1.6)	27	27			100%			
	3. Meander Pool Condition	2. Length appropriate (>30% of centerline distance between tail of upstream riffle and head of downstream riffle)	100	100			100%			
		1. Thalweg centering at upstream of meander bend (Run)	100	100			100%			
	4. Thalweg Position	2. Thalweg centering at downstream of meander (Glide)	100	100			100%			
2. Bank	1. Scoured/Eroding	Bank lacking vegetative cover resulting simply from poor growth and/or scour and erosion			0	0	100%			
	2. Undercut	Banks undercut/overhanging to the extent that mass wasting appears likely. Does NOT include undercuts that are modest, appear sustainable and are providing habitat.			0	0	100%			
	3. Mass Wasting	Bank slumping, calving, or collapse			0	0	100%			
					Totals	0	100%	0	0	100%
3. Engineered Structures	1. Overall Integrity	Structures physically intact with no dislodged boulders or logs.	8	8			100%			
	2. Grade Control	Grade control structures exhibiting maintenance of grade across the sill.	8	8			100%			
	2a. Piping	Structures lacking any substantial flow underneath sills or arms.	8	8			100%			
	3. Bank Protection	Bank erosion within the structures extent of influence does <u>not</u> exceed 15%. (See guidance for this table in EEP monitoring guidance document)	8	8			100%			
	4. Habitat	Pool forming structures maintaining ~ Max Pool Depth : Mean Bankfull Depth ratio $\geq$ 1.6 Rootwads/logs providing some cover at base-flow.	8	8			100%			

**Table 9. Verification of Bankfull Events**

Date of Data Collection	Date of Occurrence	Method	Photo (if available)
		No Bankfull Events Recorded to Date	

\*Weather Underground 2012

**Table 10A. Baseline Morphology and Hydraulic Summary****Herman Dairy UT 1**

Parameter	USGS Gage Data			Pre-Existing Condition			Project Reference Stream UT Catawba*			Project Reference Reach 1			Design			As-built		
	Min	Max	Med	Min	Max	Med	Min	Max	Med	Min	Max	Med	Min	Max	Med	Min	Max	Med
<b>Dimension</b>																		
BF Width (ft)	USGS gage data is unavailable for this project	16	19	18	9	12	10	9	10	10	16	18	17	15.5	16.4	16.1		
Floodprone Width (ft)		26	150	150	25	150	50	22	25	24			150			250		
BF Cross Sectional Area (ft <sup>2</sup> )				20.2			10.9			11.8	36	53	20.2	14	18.2	16.4		
BF Mean Depth (ft)		1.1	1.3	1.2	1.1	1.3	1.1	1.2	1.3	1.3	1.1	1.3	1.2	0.9	1.1	1		
BF Max Depth (ft)		1.9	2.3	2	1.5	1.8	1.7	1.5	1.6	1.6	1.4	1.8	1.6	1.2	1.6	1.4		
Width/Depth Ratio		12	17	16	8	13	10	7.2	8	7.6	12	16	14	14	17	16		
Entrenchment Ratio		1.6	9.6	7.9	2.7	14.6	4.9	2.3	2.7	2.5	8	10	9	15	16	16		
Bank Height Ratio		1.8	3.1	1.9			1			1	1	1.3	1.1			1		
Wetted Perimeter(ft)				==			==			==			==	15.9	16.8	16.7		
Hydraulic radius (ft)				==			==			==			==	0.9	1.1	1		
<b>Pattern</b>																		
Channel Beltwidth (ft)	No pattern of riffles and pools due to straightening activities	30	40	35	35	58	45	50	101	67	50	101	67					
Radius of Curvature (ft)		12.5	25	18	10	32	16	34	168	50	34	168	50					
Meander Wavelength (ft)		25	70	45	65	128	81	101	202	143	101	202	143					
Meander Width ratio		2.9	3.9	3.4	3.7	6.1	4.7	3	6	4	3	6	4					
<b>Profile</b>																		
Riffle length (ft)	No pattern of riffles and pools due to straightening activities			==			==			==			==	23	65	36		
Riffle slope (ft/ft)		0.30%	0.36%	0.34%	0.34%	4.31%	2.48%	1.10%	1.65%	1.38%	0.00%	1.50%	0.64%					
Pool length (ft)				==			==			==			==	10	54	32		
Pool spacing (ft)		22	62	39	29	103	60	50	134	67	50	134	67					
<b>Substrate</b>																		
d50 (mm)			==			==			==			==				==		
d84 (mm)			==			==			==			==				==		
<b>Additional Reach Parameters</b>																		
Valley Length (ft)			==			==			==			==						.
Channel Length (ft)			==			==			==			==						2108
Sinuosity			1.1			1.4			1.4			1.2						1.2
Water Surface Slope (ft/ft)			0.62%			0.28%			1.27%			0.55%						0.53%
BF slope (ft/ft)			==			==			==			==						==
Rosgen Classification			Cd 5			E 4/5			E 4/5			Ec4/5						E/C 4/5

\*UT to Catawba River Reference Site includes measurements from a stream measured in 2008

**Table 10B. Baseline Morphology and Hydraulic Summary**

Herman Dairy UT 2

Parameter	USGS Gage Data			Pre-Existing Condition			Project Reference Stream UT Catawba*			Project Reference Reach 1			Design			As-built^				
				Min	Max	Med	Min	Max	Med	Min	Max	Med	Min	Max	Med	Min	Max	Med		
<b>Dimension</b>	Min	Max	Med	USGS gage data is unavailable for this project	6	15	9	9	12	10	9	10	10	5.3	6.1	5.7	6.8	7.9	6.9	
BF Width (ft)	14	19	15		25	150	50	22	25	24				150			150			
Floodprone Width (ft)			2.3				10.9			11.8			2.3	2.2	2.4	2.3				
BF Cross Sectional Area (ft <sup>2</sup> )	0.2	0.4	0.3		1.1	1.3	1.1	1.2	1.3	1.3	0.3	0.5	0.4	0.3	0.3	0.3				
BF Mean Depth (ft)	0.4	0.8	0.5		1.5	1.8	1.7	1.5	1.6	1.6	0.4	0.6	0.5	0.5	0.5	0.5				
BF Max Depth (ft)	16	76	30		8	13	10	7.2	8	7.6	12	16	14	20	27	21				
Width/Depth Ratio	1.3	2.2	1.6		2.7	14.6	4.9	2.3	2.7	2.5	14	38	26	19	22	22				
Entrenchment Ratio	5	12	7				1			1	1	1.3	1.1			1				
Bank Height Ratio			==				==			==			==	7	8	7.1				
Wetted Perimeter(ft)			==				==			==			==	0.3	0.3	0.3				
Hydraulic radius (ft)			==				==			==			==							
<b>Pattern</b>	No pattern of riffles and pools due to straightening activities				30	40	35	35	58	45	17	34	23	17	34	23				
Channel Beltwidth (ft)					12.5	25	18	10	32	16	11	57	17	11	57	17				
Radius of Curvature (ft)					25	70	45	65	128	81	34	68	49	34	68	49				
Meander Wavelength (ft)					2.9	3.9	3.4	3.7	6.1	4.7	3	8	4	3	8	4				
<b>Profile</b>	No pattern of riffles and pools due to straightening activities						==			==			==	6	44	14				
Riffle length (ft)					0.30%	0.36%	0.34%	0.34%	4.31%	2.48%	0.86%	1.29%	1.08%	0.00%	1.25%	0.39%				
Riffle slope (ft/ft)							==			==			==	6	32	13				
Pool length (ft)					22	62	39	29	103	60	17	46	23	17	46	23				
<b>Substrate</b>							==			==			==			==				
d50 (mm)							==			==			==			==				
d84 (mm)							==			==			==			==				
<b>Additional Reach Parameters</b>							==			==			==			.				
Valley Length (ft)							==			==			==							
Channel Length (ft)							==			==			==			1696				
Sinuosity							1.04			1.4			1.4		1.2		1.2			
Water Surface Slope (ft/ft)							0.85%			0.28%			1.27%		0.43%		0.40%			
BF slope (ft/ft)							==			==			==		==		==			
Rosgen Classification							Fc 5/6			E 4/5			E 4/5		Ec4/5		C 4/5			

^Measured as-built numbers do not include D-type reach

\*UT to Catawba River Reference Site includes measurements from a stream measured in 2008

**Table 10C. Baseline Morphology and Hydraulic Summary**

Herman Dairy UT 3

Parameter	USGS Gage Data			Pre-Existing Condition			Project Reference Stream UT Catawba*			Project Reference Reach 1			Design			As-built		
				Min	Max	Med	Min	Max	Med	Min	Max	Med	Min	Max	Med	Min	Max	Med
<b>Dimension</b>	Min	Max	Med	Min	Max	Med	Min	Max	Med	Min	Max	Med	Min	Max	Med	Min	Max	Med
BF Width (ft)	USGS gage data is unavailable for this project	6	9	7	9	12	10	9	10	10	6	7	6.5	6.8	8.5	7.7		
Floodprone Width (ft)		12	13	12	25	150	50	22	25	24			150			150		
BF Cross Sectional Area (ft <sup>2</sup> )				3			10.9			11.8			3	2.2	3.1	2.7		
BF Mean Depth (ft)		0.3	0.5	0.4	1.1	1.3	1.1	1.2	1.3	1.3	0.4	0.6	0.5	0.3	0.4	0.4		
BF Max Depth (ft)		0.6	0.9	0.7	1.5	1.8	1.7	1.5	1.6	1.6	0.6	0.8	0.7	0.5	0.5	0.5		
Width/Depth Ratio		13	31	17	8	13	10	7.2	8	7.6	12	16	14	21	23	22		
Entrenchment Ratio		1.4	1.9	1.7	2.7	14.6	4.9	2.3	2.7	2.5	22	25	23	17	22	19.5		
Bank Height Ratio		4	7	6			1			1	1	1.3	1.1			1		
Wetted Perimeter(ft)				==			==			==			==	7	8.7	7.9		
Hydraulic radius (ft)				==			==			==			==	0.3	0.4	0.4		
<b>Pattern</b>																		
Channel Beltwidth (ft)	No pattern of riffles and pools due to straightening activities	30	40	35	35	58	45	20	39	26	20	20	39	26				
Radius of Curvature (ft)		12.5	25	18	10	32	16	13	65	20	13	65	20					
Meander Wavelength (ft)		25	70	45	65	128	81	39	78	55	39	78	55					
Meander Width ratio		2.9	3.9	3.4	3.7	6.1	4.7	3	8	4	3	8	4					
<b>Profile</b>																		
Riffle length (ft)	No pattern of riffles and pools due to straightening activities			==			==			==			==	5	26	11		
Riffle slope (ft/ft)		0.30%	0.36%	0.34%	0.34%	4.31%	2.48%	0.22%	0.33%	0.28%	0.00%	1.59%	0.22%					
Pool length (ft)				==			==			==			==	7	21	13		
Pool spacing (ft)				22	62	39	29	103	60	20	52	26	20	52	26			
<b>Substrate</b>						==			==			==				==		
d50 (mm)						==			==			==				==		
d84 (mm)						==			==			==				==		
<b>Additional Reach Parameters</b>						==			==			==						.
Valley Length (ft)						==			==			==						
Channel Length (ft)						==			==			==					743	
Sinuosity						1.01			1.4			1.4						1.2
Water Surface Slope (ft/ft)						0.40%			0.28%			1.27%						0.12%
BF slope (ft/ft)						==			==			==				==		==
Rosgen Classification						Fc 5/6			E 4/5			E 4/5				Ec4/5		C 4/5

\*UT to Catawba River Reference Site includes measurements from a stream measured in 2008

**Table 11A. Morphology and Hydraulic Monitoring Summary  
Herman Dairy - Stream and Wetland Restoration Site**

**Table 11B. Morphology and Hydraulic Monitoring Summary  
Herman Dairy - Stream and Wetland Restoration Site**

**Table 11C. Morphology and Hydraulic Monitoring Summary  
Herman Dairy - Stream and Wetland Restoration Site**

**Table 11D. Morphology and Hydraulic Monitoring Summary  
Herman Dairy - Stream and Wetland Restoration Site**


Herriman Daily Stream and Wetland Restoration Site																									
Parameter	Cross Section 13 Riffle (UT 2)					Cross Section 14 Pool (UT 2)					Cross Section 15 Riffle (UT2)					Cross Section 16 Pool (UT2)									
Dimension	MY 0	MY1	MY2	MY3	MY4	MY5	MY 0	MY1	MY2	MY3	MY4	MY5	MY 0	MY1	MY2	MY3	MY4	MY5	MY 0	MY1	MY2	MY3	MY4	MY5	
BF Width (ft)	6.9	7					6.6	6.8					6.8	6.9					5.7	7.1					
Floodprone Width (ft)	150	150					----	----					150	150					----	----					
BF Cross Sectional Area (ft <sup>2</sup> )	2.4	1.5					2.4	2.6					2.2	2.2					2.3	2.4					
BF Mean Depth (ft)	0.3	0.2					0.4	0.4					0.3	0.3					0.4	0.3					
BF Max Depth (ft)	0.5	0.5					0.7	0.7					0.5	0.5					0.8	0.8					
Width/Depth Ratio	19.8	32.7					----	----					21.0	21.6					----	----					
Entrenchment Ratio	21.7	21.4					----	----					22.1	21.7					----	----					
Bank Height Ratio	1	1					----	----					1	1					----	----					
Wetted Perimeter (ft)	7.1	7.2					6.8	7					7	7.1					6	7.3					
Hydraulic Radius (ft)	0.3	0.2					0.3	0.4					0.3	0.3					0.4	0.3					
Substrate																									
d50 (mm)	----	----					----	----					----	----					----	----					
d84 (mm)	----	----					----	----					----	----					----	----					
Parameter	MY-00 (2012)			MY-01 (2012)			MY-02 (2013)			MY-03 (2014)			MY-04 (2015)			MY-05 (2016)									
	Min	Max	Med	Min	Max	Med	Min	Max	Med	Min	Max	Med	Min	Max	Med	Min	Max	Med	Min	Max	Med				
Pattern																									
Channel Beltwidth (ft)	17	34	23	17	34	23																			
Radius of Curvature (ft)	11	57	17	11	57	17																			
Meander Wavelength (ft)	34	68	49	34	68	49																			
Meander Width Ratio	3	6	4	3	6	4																			
Profile																									
Riffle Length (ft)	6	44	14	6	41	11																			
Riffle Slope (ft/ft)	0.00%	1.25%	0.39%	0	3.39	0.42																			
Pool Length (ft)	6	32	13	7	21	11																			
Pool Spacing (ft)	17	46	23	17	46	23																			
Additional Reach Parameters																									
Valley Length (ft)	1413			1522																					
Channel Length (ft)	1,696			1,827																					
Sinuosity	1.2			1.2																					
Water Surface Slope (ft/ft)	0.004			0.0041																					
BF Slope (ft/ft)	-----			-----																					
Rosgen Classification	C/E 4/5			C 4/5																					

### **Table 11E. Morphology and Hydraulic Monitoring Summary Herman Dairy - Stream and Wetland Restoration Site**

**Project Name** Herman Dairy - Year 1 (2012) Profile  
**Reach** Tributary 1  
**Feature** Profile  
**Date** 8/29/12  
**Crew** Perkinson, Lewis

Station	2012 As-built Survey		2012 Year 1 Monitoring  Survey		2013 Year 2 Monitoring  Survey		2014 Year 3 Monitoring  Survey	
	Bed Elevation	Water Elevation	Bed Elevation	Water Elevation	Bed Elevation	Water Elevation	Bed Elevation	Water Elevation
0.0	93.3	93.9	309.6	97.6	98.9			
34.6	94.0	94.3	328.9	97.8	98.9			
64.3	94.8	95.2	338.1	98.4	99.0			
74.2	95.1	95.4	361.2	98.6	99.1			
113.3	97.0	97.5	372.6	97.8	99.2			
133.7	97.2	97.9	384.9	98.1	99.2			
138.4	96.2	98.0	399.8	98.8	99.2			
145.3	96.3	97.9	425.9	98.8	99.2			
154.5	96.3	98.0	442.1	98.2	99.2			
167.2	97.5	98.0	448.7	98.0	99.3			
182.9	97.5	98.1	460.2	98.8	99.3			
195.8	97.6	98.1	495.5	99.0	99.5			
204.1	97.1	98.1	505.1	98.4	99.5			
221.9	96.9	98.1	517.5	98.5	99.5			
225.5	97.4	98.1	534.0	98.6	99.4			
240.5	97.8	98.2	542.1	99.2	99.5			
259.8	97.8	98.3	569.5	99.1	99.6			
263.0	97.3	98.3	587.1	98.6	99.6			
266.2	97.3	98.3	599.2	98.6	99.6			
269.8	97.9	98.4	615.4	99.0	99.6			
282.4	98.2	98.5	620.7	99.4	99.7			
297.4	98.4	98.7	647.1	99.6	99.9			
303.3	97.6	98.7	656.5	99.1	100.0			
331.6	97.7	98.7	665.6	99.0	100.0			
338.2	98.3	98.8	672.0	99.7	100.0			
364.5	98.4	98.9	705.7	99.8	100.2			
370.8	97.9	99.0	719.8	99.1	100.2			
383.9	97.9	99.0	727.3	99.3	100.3			


	As-built	2012	2013	2014
Avg. Water Surface Slope	0.0053	0.0045		
Riffle Length	36	28		
Avg. Riffle Slope	0.0064	0.0057		
Pool Length	32	35		

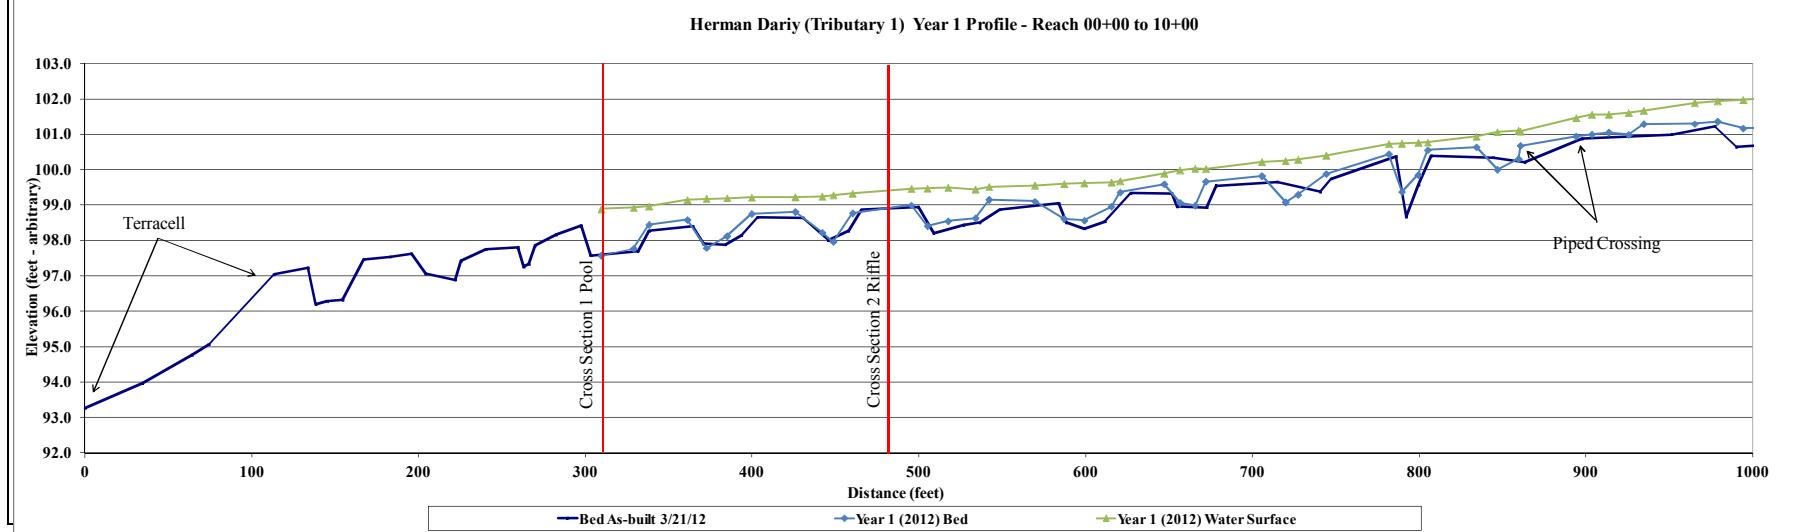

**Project Name** Herman Dairy - Year 1 (2012) Profile  
**Reach** Tributary 1  
**Feature** Profile  
**Date** 8/29/12  
**Crew** Perkinson, Lewis

Station	2012 As-built Survey			2012 Year 1 Monitoring  Survey			Station	2013 Year 2 Monitoring  Survey			Station	2014 Year 3 Monitoring  Survey		
	Bed Elevation	Water Elevation		Bed Elevation	Water Elevation			Bed Elevation	Water Elevation			Bed Elevation	Water Elevation	
990.2	100.6	101.7		994.2	101.2	102.0								
1001.8	100.7	101.7		1015.4	101.2	102.1								
1015.7	101.4	101.7		1027.3	101.5	102.1								
1053.0	101.5	101.9		1056.7	101.7	102.3								
1061.5	101.0	101.9		1069.3	101.0	102.3								
1094.8	101.1	102.0		1085.1	101.0	102.3								
1106.1	101.6	102.2		1105.4	101.3	102.4								
1141.7	102.0	102.4		1111.8	101.8	102.4								
1145.7	101.2	102.3		1139.4	102.2	102.7								
1158.5	101.1	102.3		1151.1	100.8	102.7								
1163.3	102.0	102.4		1158.5	101.0	102.7								
1183.3	102.4	102.7		1168.8	102.1	102.7								
1197.8	102.3	102.8		1174.7	102.2	102.7								
1214.6	102.0	102.8		1199.3	102.4	102.9								
1226.9	101.9	102.8		1207.4	101.2	103.0								
1242.5	102.1	102.8		1219.3	101.9	103.0								
1251.9	102.4	102.8		1235.6	101.9	103.0								
1275.5	102.6	102.8		1248.9	102.1	103.1								
1280.7	101.7	102.9		1258.6	102.6	103.2								
1289.3	102.0	102.9		1276.2	102.5	103.3								
1300.0	102.6	102.8		1285.3	101.6	103.3								
1321.8	102.5	102.9		1295.7	102.4	103.3								
1364.7	102.6			1302.3	102.6	103.4								
1376.2	102.2	103.0		1318.4	102.6	103.5								
1386.5	102.0	103.1		1326.0	102.7	103.5								
1397.1	101.9	103.1		1333.8	102.3	103.5								
1408.4	102.7	103.4		1337.9	102.7	103.5								


	As-built	2012	2013	2014
Avg. Water Surface Slope	0.0053			
Riffle Length	36	28		
Avg. Riffle Slope	0.0064	0.0057		
Pool Length	32	35		

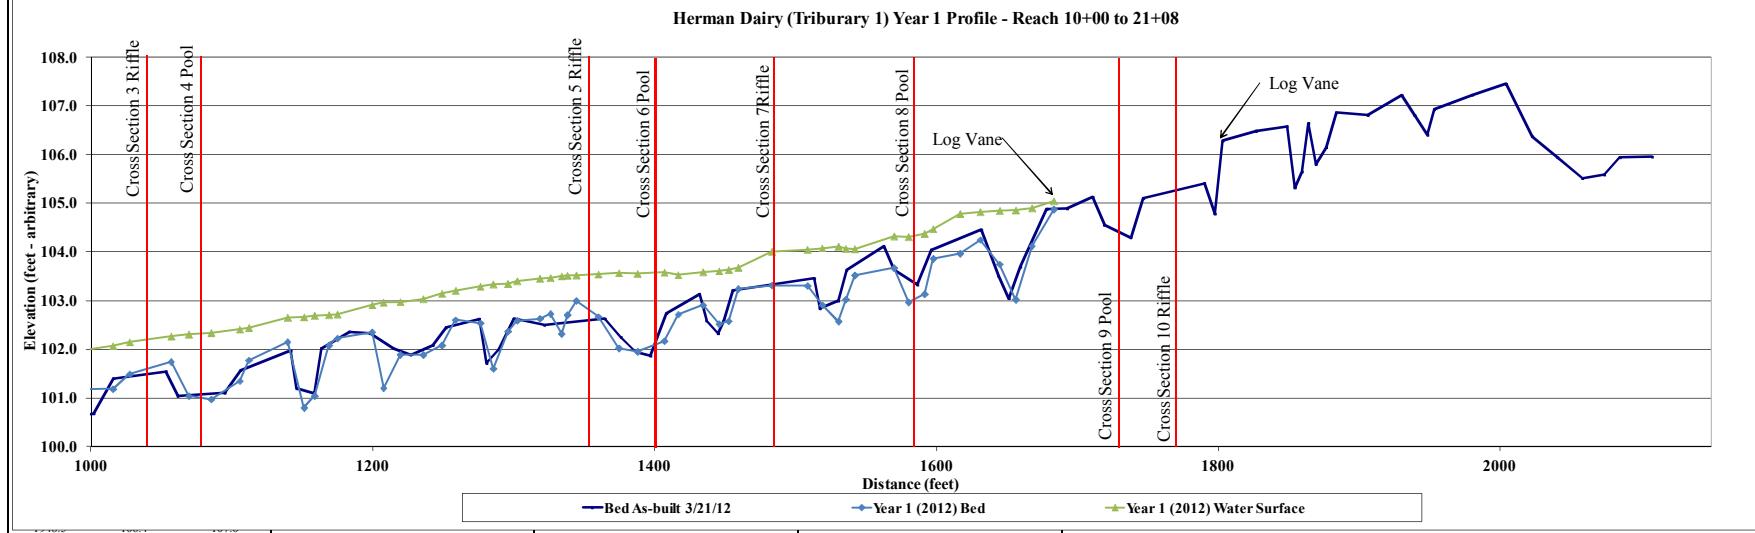

**Project Name** Herman Dairy - Year 1 (2012) Profile  
**Reach** Tributary 2  
**Feature** Profile  
**Date** 9/19/12  
**Crew** Perkins, Jernigan

Station	2012 As-built Survey		2012 Year 1 Monitoring  Survey		2013 Year 2 Monitoring  Survey		2014 Year 3 Monitoring  Survey	
	Bed Elevation	Water Elevation	Bed Elevation	Water Elevation	Bed Elevation	Water Elevation	Bed Elevation	Water Elevation
0.0	97.9	98.2	53.5	98.0	98.4			
11.2	97.9	98.2	58.4	97.7	98.4			
14.9	97.5	98.2	62.3	97.5	98.3			
20.1	97.5	98.2	67.7	98.0	98.3			
22.2	98.0	98.0	77.5	98.1	98.4			
34.9	98.0		84.1	97.6	98.4			
37.6	97.6	98.1	87.5	97.7	98.4			
41.7	97.7	98.1	92.2	97.9	98.4			
44.1	97.9		106.8	98.0	98.4			
60.6	98.0		110.6	97.8	98.3			
62.3	97.4	98.1	114.0	98.1	98.2			
69.1	97.8	98.1	137.1	98.1	98.4			
71.7	98.0		141.4	97.7	98.4			
81.1	98.0		147.7	98.2	98.3			
85.9	97.7	98.3	168.6	98.2	98.5			
93.8	97.9	98.3	176.9	97.9	98.5			
99.3	98.0	98.3	182.9	98.2	98.4			
110.8	98.2		209.1	98.5	98.5			
113.8	97.9	98.4	223.9	98.4	98.6			
116.9	98.2		226.4	98.0	98.6			
126.7	98.1	98.4	231.4	98.0	98.6			
138.4	98.2		235.9	98.4	98.7			
143.4	97.7	98.4	257.1	98.5	98.8			
146.8	97.7	98.5	261.1	98.1	98.8			
150.8	98.3		267.6	98.5	98.8			
161.2	98.1		284.8	98.6	98.8			

	As-built	2012	2013	2014
Avg. Water Surface Slope	0.0040	0.0041		
Riffle Length	14	13		
Avg. Riffle Slope	0.0039	0.0042		
Pool Length	13	12		

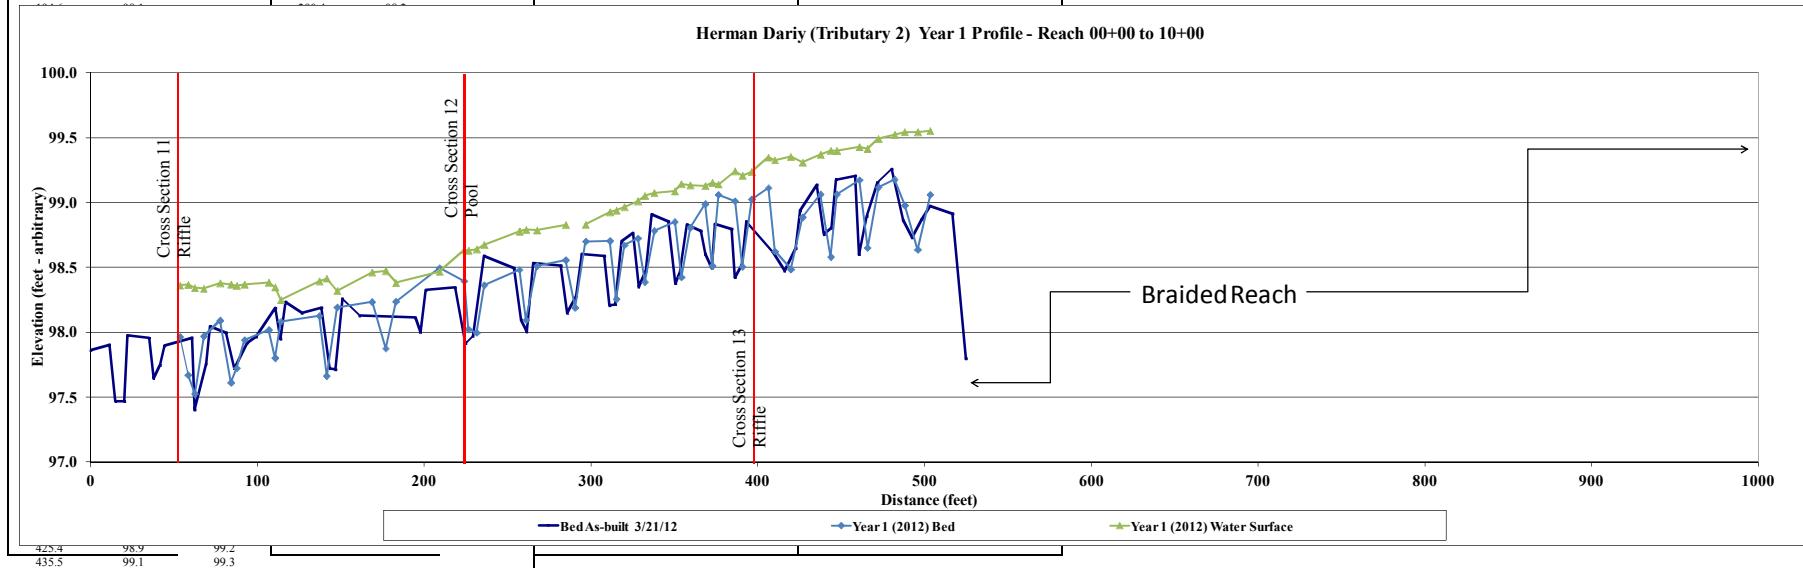


**Project Name** Herman Dairy - Year 1 (2012) Profile  
**Reach** Tributary 2  
**Feature** Profile  
**Date** 9/19/12  
**Crew** Perkins, Jernigan

Station	2012 As-built Survey		2012 Year 1 Monitoring  Survey		2013 Year 2 Monitoring  Survey		2014 Year 3 Monitoring  Survey	
	Bed Elevation	Water Elevation	Bed Elevation	Water Elevation	Bed Elevation	Water Elevation	Bed Elevation	Water Elevation
524.8	99.4	99.6	503.3	99.1	101.5	101.5		
1041.2	100.2	100.8	1041.2	101.3	101.6	101.6		
1041.8	101.2	101.2	1064.1	101.3	101.6	101.6		
1043.5	101.5	101.5	1072.4	101.1	101.7	101.7		
1060.7	101.4	101.7	1078.9	101.2	101.7	101.7		
1071.8	101.3	101.7	1087.0	101.3	101.7	101.7		
1074.4	101.0	101.6	1094.2	101.1	101.7	101.7		
1095.6	101.2	101.7	1096.1	101.6	101.9	101.9		
1098.7	101.7	109.7	1109.7	102.0	102.4	102.4		
1110.0	102.2	1115.0	101.5	102.4	102.4	102.4		
1116.6	101.6	102.3	1120.4	101.8	102.4	102.4		
1122.1	101.8	102.3	1125.5	102.1	102.4	102.4		
1128.3	102.3		1134.2	102.4	102.8	102.8		
1137.3	102.3		1137.5	101.9				
1139.8	102.0	102.6	1144.2	102.0	102.8	102.8		
1146.0	102.0	102.6	1145.5	103.0				
1147.4	103.1		1153.5	102.9	103.1	103.1		
1156.8	102.8	103.1	1159.3	102.4	103.1	103.1		
1160.6	102.4	103.1	1165.4	102.5	103.1	103.1		
1167.7	102.5	103.1	1170.1	102.8	103.1	103.1		
1172.0	102.9	103.1	1188.5	102.9	103.2	103.2		
1191.8	102.9	103.2	1192.5	102.5	103.2	103.2		
1195.0	102.4	103.2	1198.5	102.6	103.3	103.3		
1201.3	102.6	103.2	1202.8	103.0	103.3	103.3		
1205.2	103.0	103.2	1217.5	103.0	103.4	103.4		
1220.4	103.1	103.3	1222.8	102.7	103.4	103.4		
1225.1	102.8	103.3	1226.2	103.1	103.5	103.5		
1230.0	103.3	103.4	1236.2	103.3	103.5	103.5		

	As-built	2012	2013	2014
Avg. Water Surface Slope	0.0040	0.0041		
Riffle Length	14	13		
Avg. Riffle Slope	0.0039	0.0042		
Pool Length	13	12		


### Herman Dairy (Tributary 2) Year 1 Profile - Reach 10+00 to 16+96

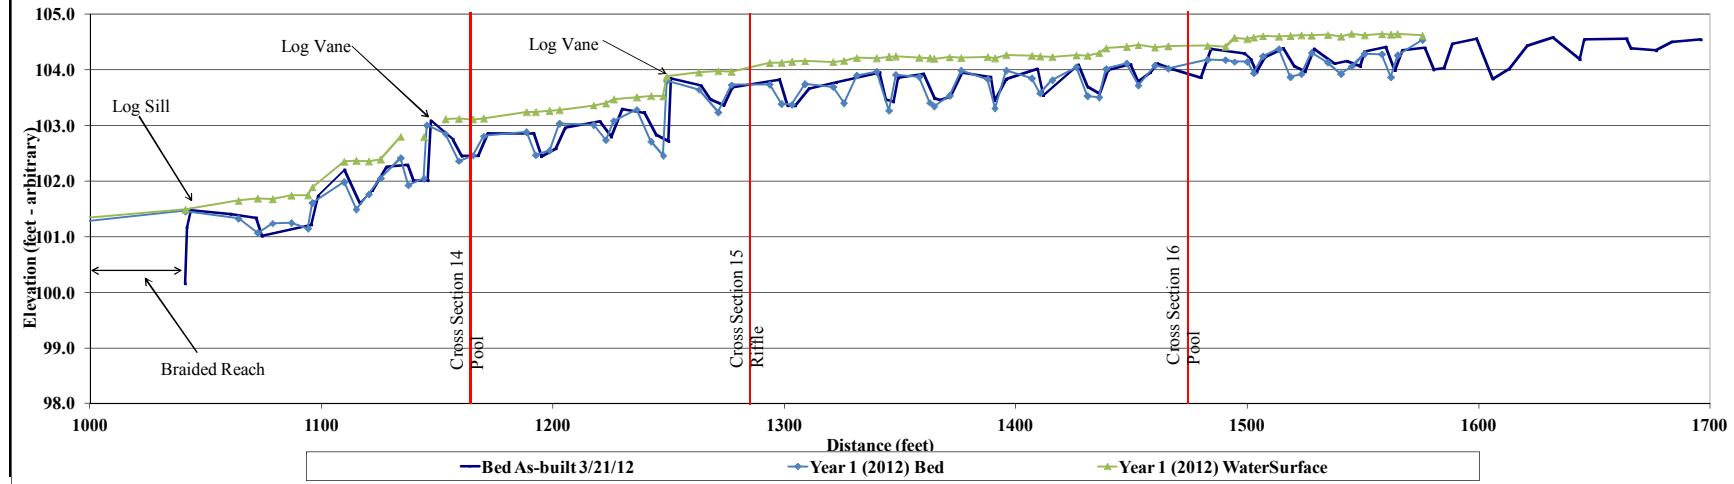

**Project Name** Herman Dairy - Year 1 (2012) Profile  
**Reach** Tributary 3  
**Feature** Profile  
**Date** 9/27/12  
**Crew** Perkinson, Jernigan

Station	2012 As-built Survey		2012 Year 1 Monitoring  Survey		2013 Year 2 Monitoring  Survey		2014 Year 3 Monitoring  Survey	
	Bed Elevation	Water Elevation	Bed Elevation	Water Elevation	Bed Elevation	Water Elevation	Bed Elevation	Water Elevation
0.0	94.6		82.0	99.6				
22.2	97.1		85.1	99.1				
42.1	98.7		86.6	99.2				
69.9	99.5		89.0	99.7				
82.7	99.6		116.0	99.6				
85.8	99.2	99.9	118.9	99.0				
89.2	99.7	99.9	122.4	99.1				
115.5	99.6	99.9	125.1	99.6				
119.0	99.0	99.9	138.8	99.7				
122.7	99.1	99.9	143.8	99.0				
125.8	99.6	99.9	151.9	99.1				
138.2	99.6	99.9	158.4	99.6				
142.3	99.1	99.9	171.8	99.6				
146.4	99.0	99.9	176.8	99.0				
151.0	99.1	99.9	182.1	99.1				
156.1	99.6	99.9	185.4	99.5				
170.2	99.6	99.9	197.4	99.4				
175.3	99.0	99.9	199.7	99.0				
182.1	99.1	99.9	204.8	98.8				
185.9	99.6	99.9	209.1	99.6				
196.0	99.6	99.9	215.3	99.6				
199.5	99.0	99.9	218.7	99.0				
205.7	98.8	99.9	223.9	99.1				
208.9	99.6		227.8	99.7				
214.2	99.8	100.0	234.9	99.8				
217.5	99.0	100.0	239.4	99.1				

	As-built	2012	2013	2014
Avg. Water Surface Slope	0.0012	NA		
Riffle Length	11	10		
Avg. Riffle Slope	0.0022	NA		
Pool Length	13	13		

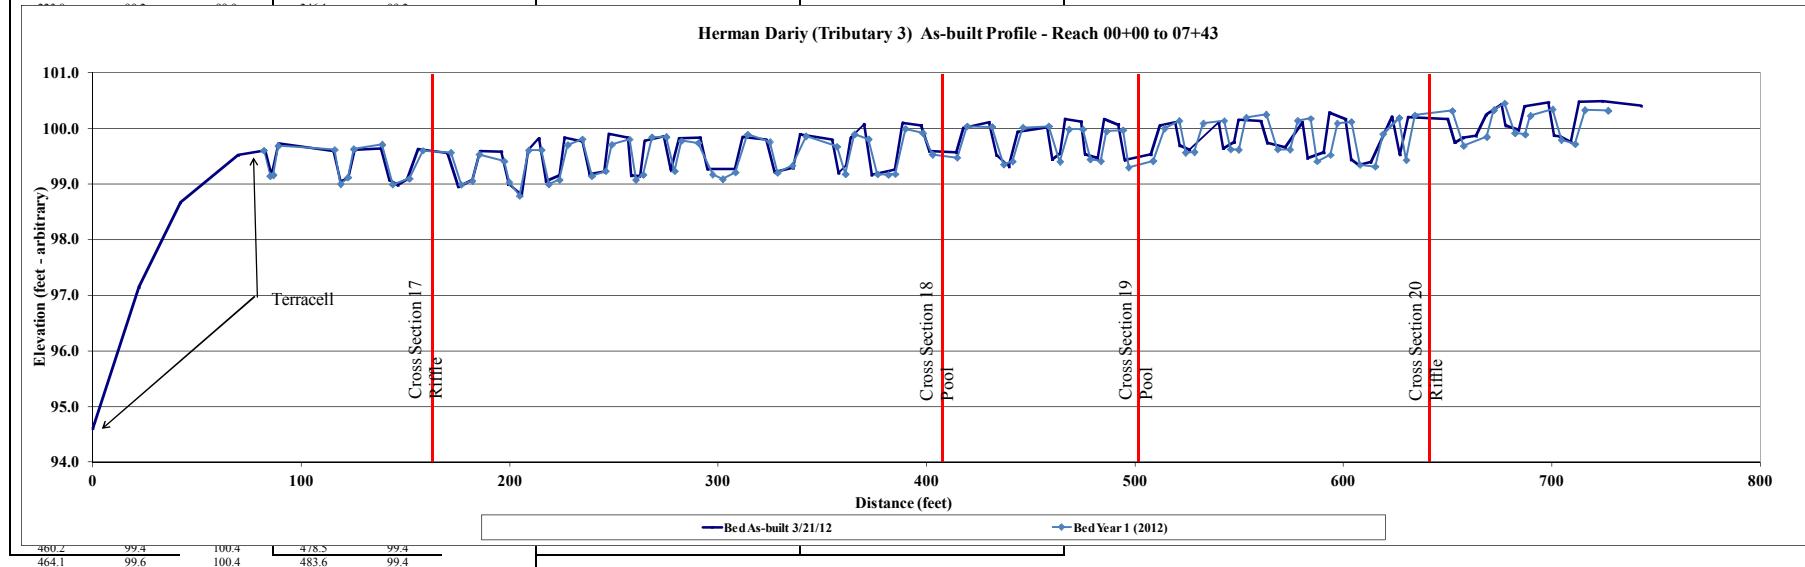





<b>Site Name:</b>	Herman Dairy
<b>Watershed:</b>	30501001120030
<b>XS ID</b>	Tributary 1 (XS-1.Pool)
<b>Drainage Area (sq mi):</b>	1.01
<b>Date:</b>	4/3/2012
<b>Field Crew:</b>	Perkinson, Thomas

Station	Elevation
0.00	99.55
12.84	99.89
17.85	99.77
19.16	99.72
19.93	99.62
21.15	99.09
21.64	98.93
23.18	98.03
23.91	97.71
25.11	97.41
25.88	97.55
26.70	98.11
27.73	98.17
29.72	98.51
31.64	98.85
33.32	98.98
35.1	99.22
38.05	99.40
39.79	99.76
44.63	99.87
50.01	99.75

Stream Type      E

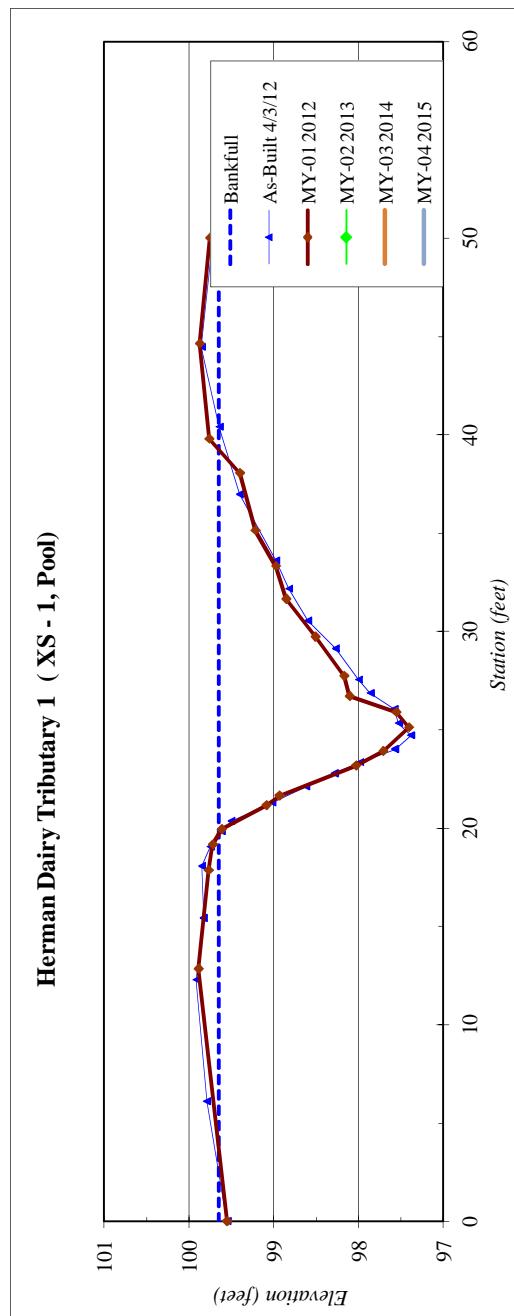

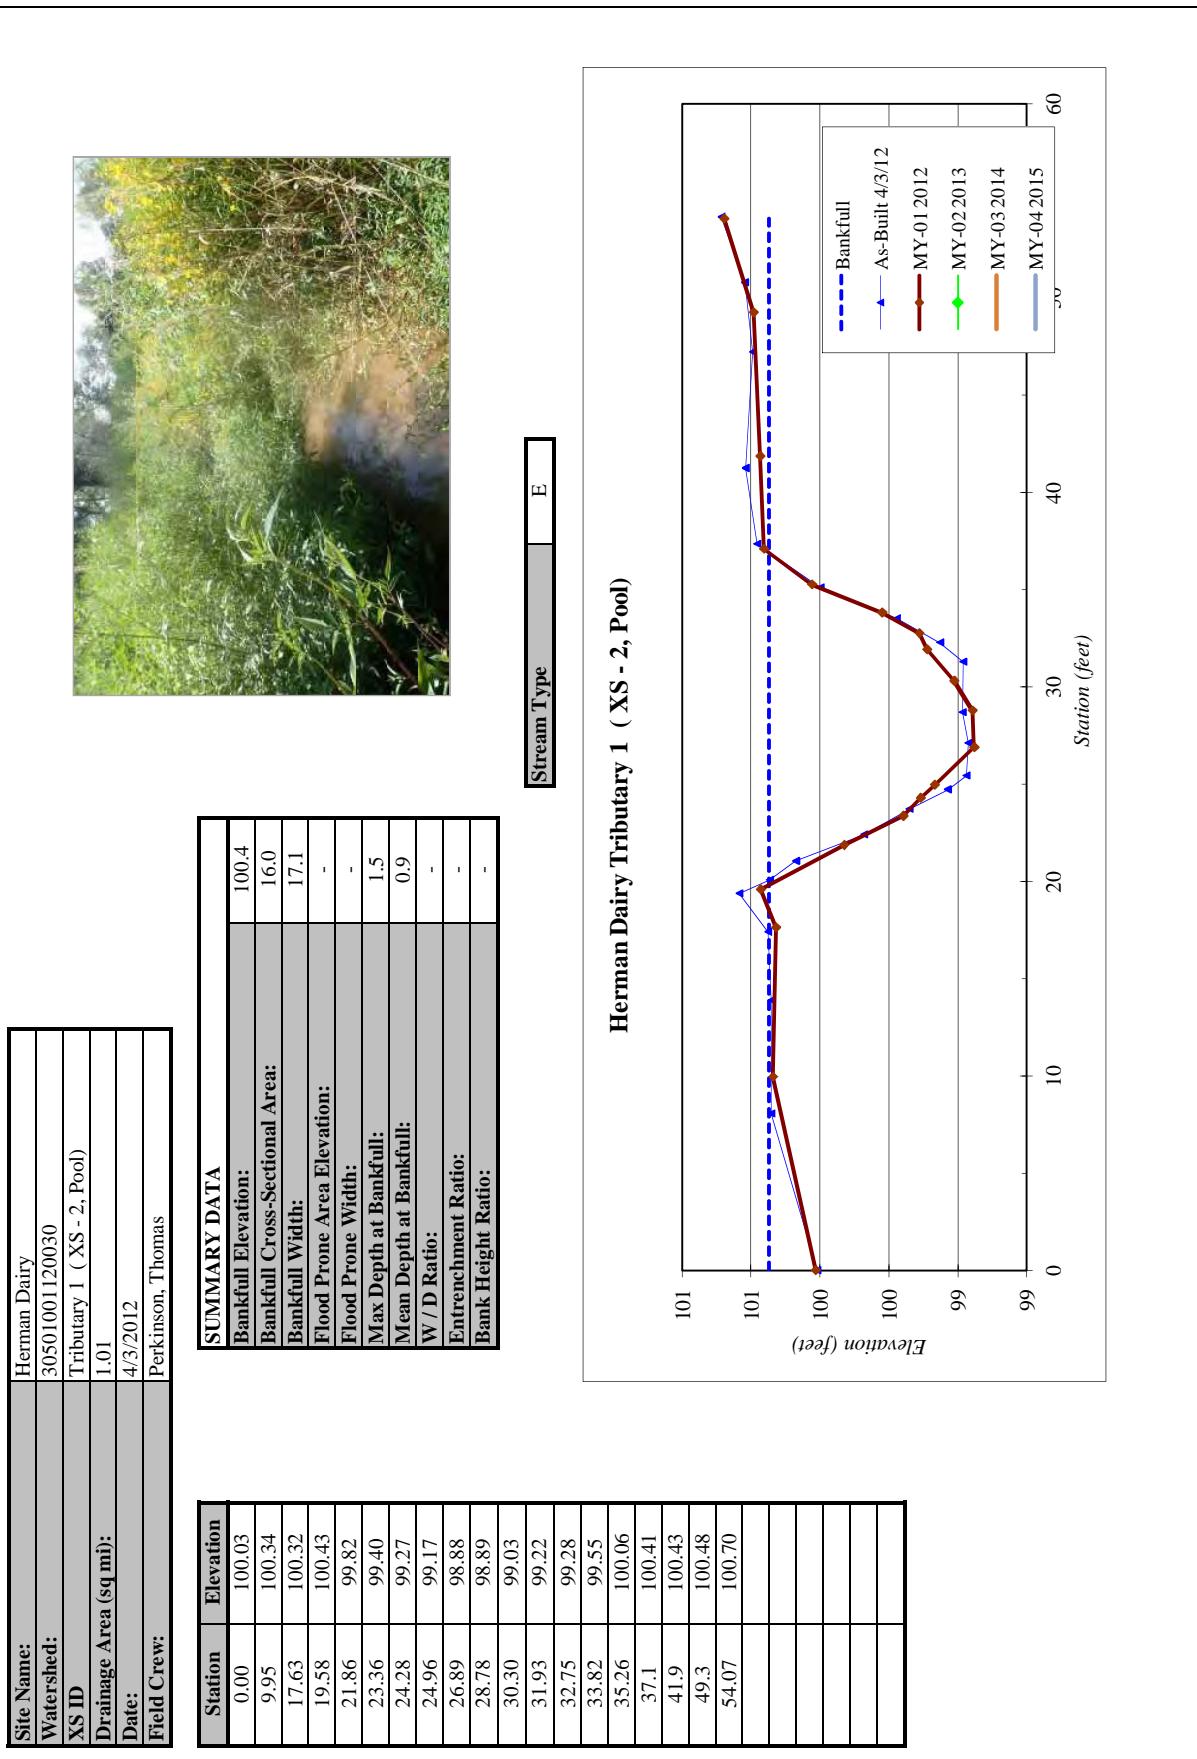


Site Name:	Herman Dairy
Watershed:	30501001120030
XS ID	Tributary 1 (XS - 3, Riffle)
Drainage Area (sq mi):	1.01
Date:	4/3/2012
Field Crew:	Perkinson, Thomas



SUMMARY DATA A	
Bankfull Elevation:	102.8
Bankfull Cross-Sectional Area:	17.0
Bankfull Width:	17.0
Flood Prone Area Elevation:	104.2
Flood Prone Width:	>80
Max Depth at Bankfull:	1.4
Mean Depth at Bankfull:	1.0
W/D Ratio:	17.0
Entrenchment Ratio:	>5
Bank Height Ratio:	1.0

Stream Type	E/C

### Herman Dairy Tributary 1 (XS - 3, Riffle)

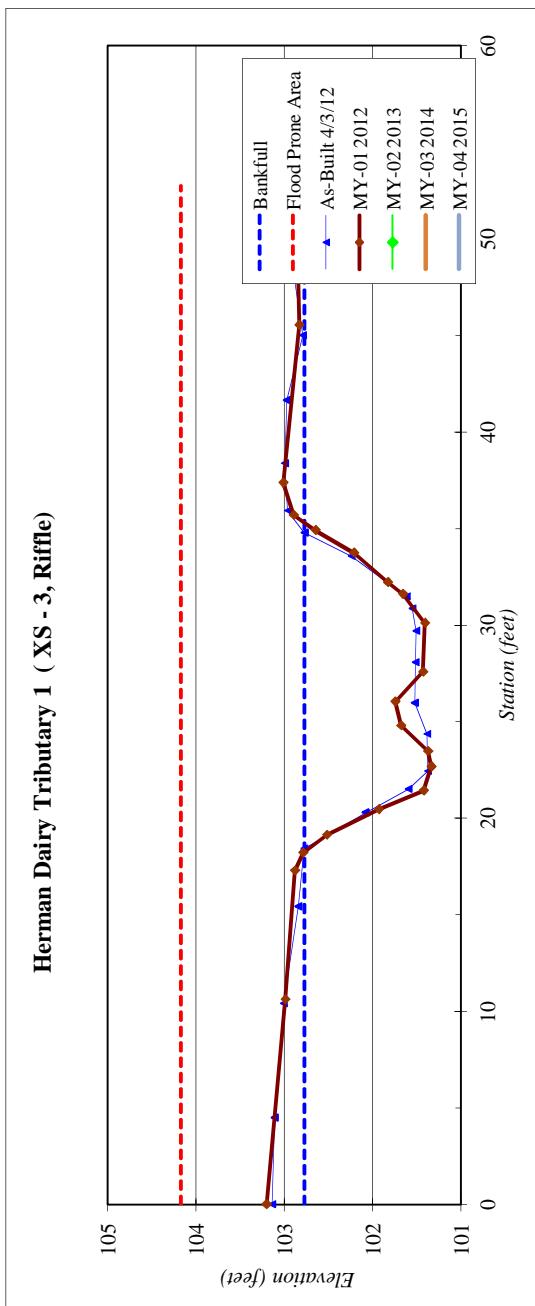


Site Name:	Herman Dairy
Watershed:	30501001120030
XS ID	Tributary 1 ( XS - 4, Pool)
Drainage Area (sq mi):	1.01
Date:	4/3/2012
Field Crew:	Perkinson, Thomas




SUMMARY DATA A	
Bankfull Elevation:	103.0
Bankfull Cross-Sectional Area:	14.5
Bankfull Width:	18.2
Flood Prone Area Elevation:	-
Flood Prone Width:	-
Max Depth at Bankfull:	2.1
Mean Depth at Bankfull:	0.8
W/D Ratio:	-
Entrenchment Ratio:	-
Bank Height Ratio:	-

Stream Type      E

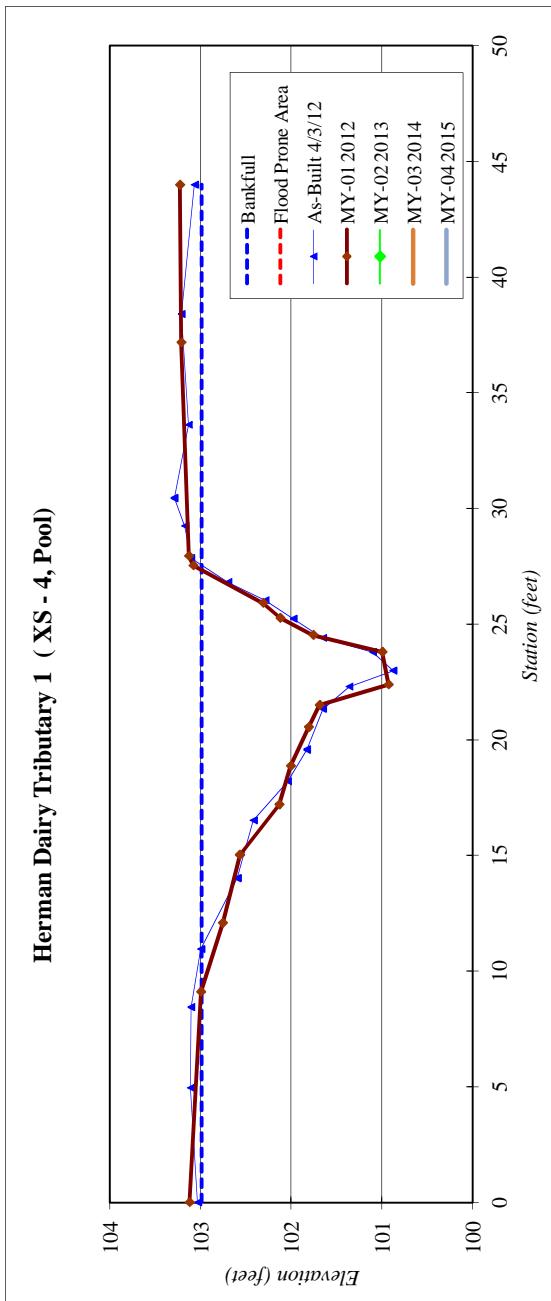


Site Name:	Herman Dairy
Watershed:	30501001120030
XS ID	Tributary 1 (XS - 5, Riffle)
Drainage Area (sq mi):	1.01
Date:	4/3/2012
Field Crew:	Perkinson, Thomas

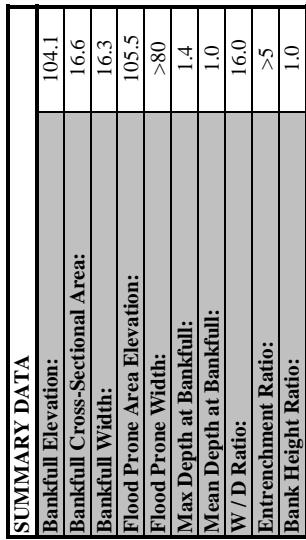


Stream Type      E/C


### Herman Dairy Tributary 1 (XS - 5, Riffle)

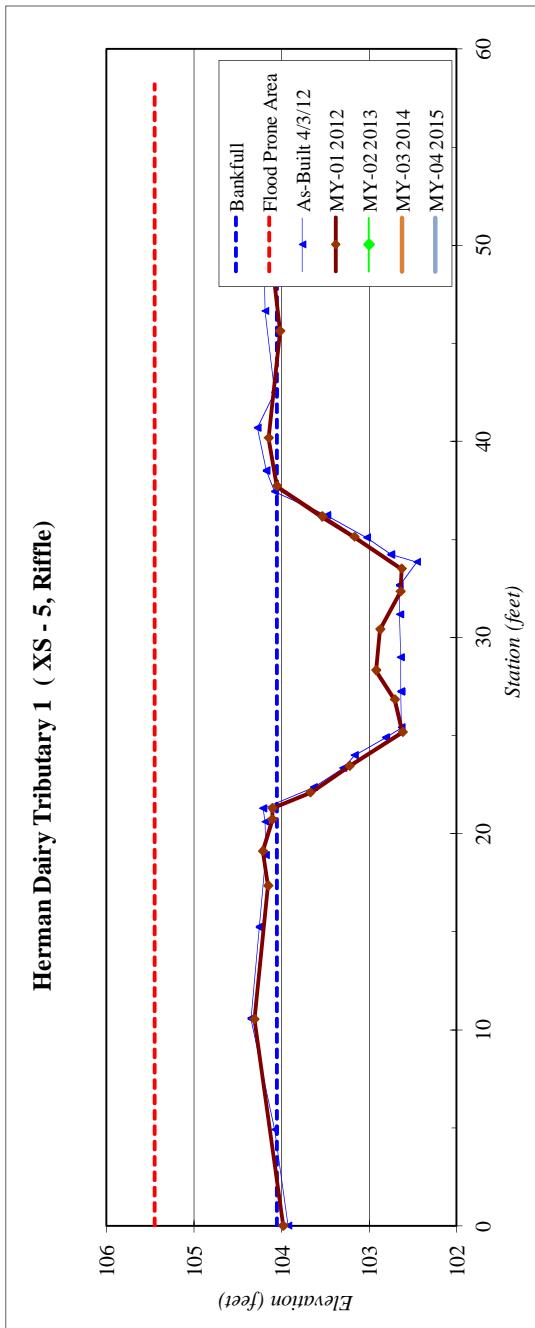


Site Name:	Herman Dairy
Watershed:	30501001120030
XS ID	Tributary 1 (XS - 6, Pool)
Drainage Area (sq mi):	1.01
Date:	4/3/2012
Field Crew:	Perkinson, Thomas

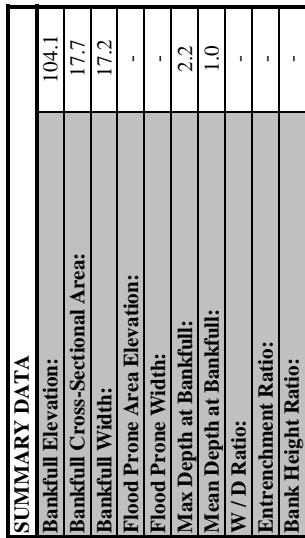

Stream Type      E/C

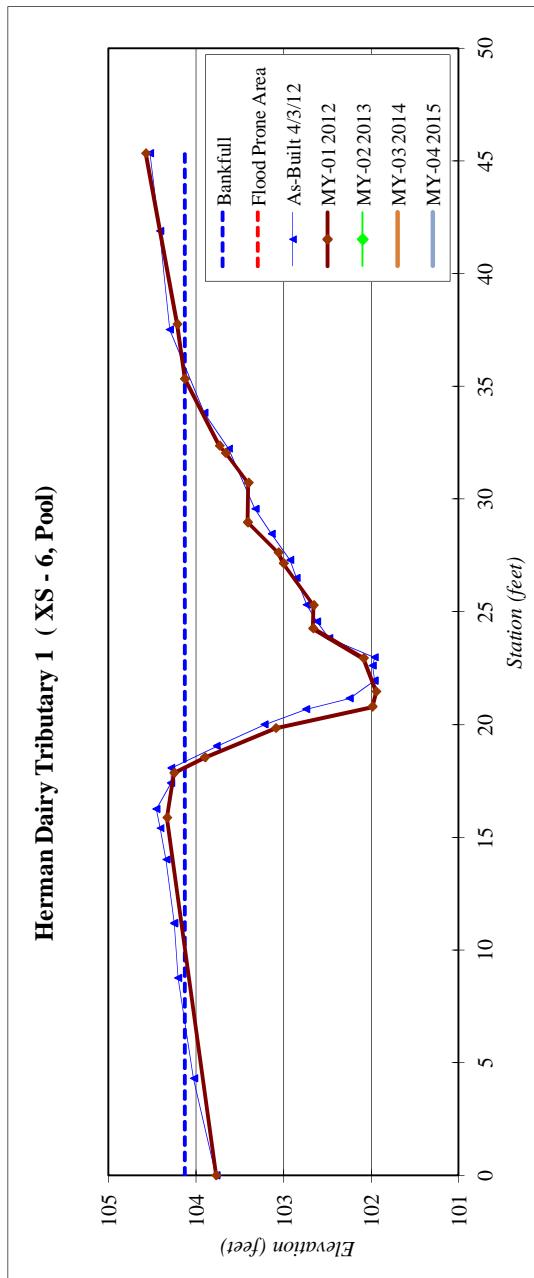

21.5	101.9
20.8	102.0
19.8	103.1
18.5	103.9
17.9	104.2
15.9	104.3
0.0	103.8

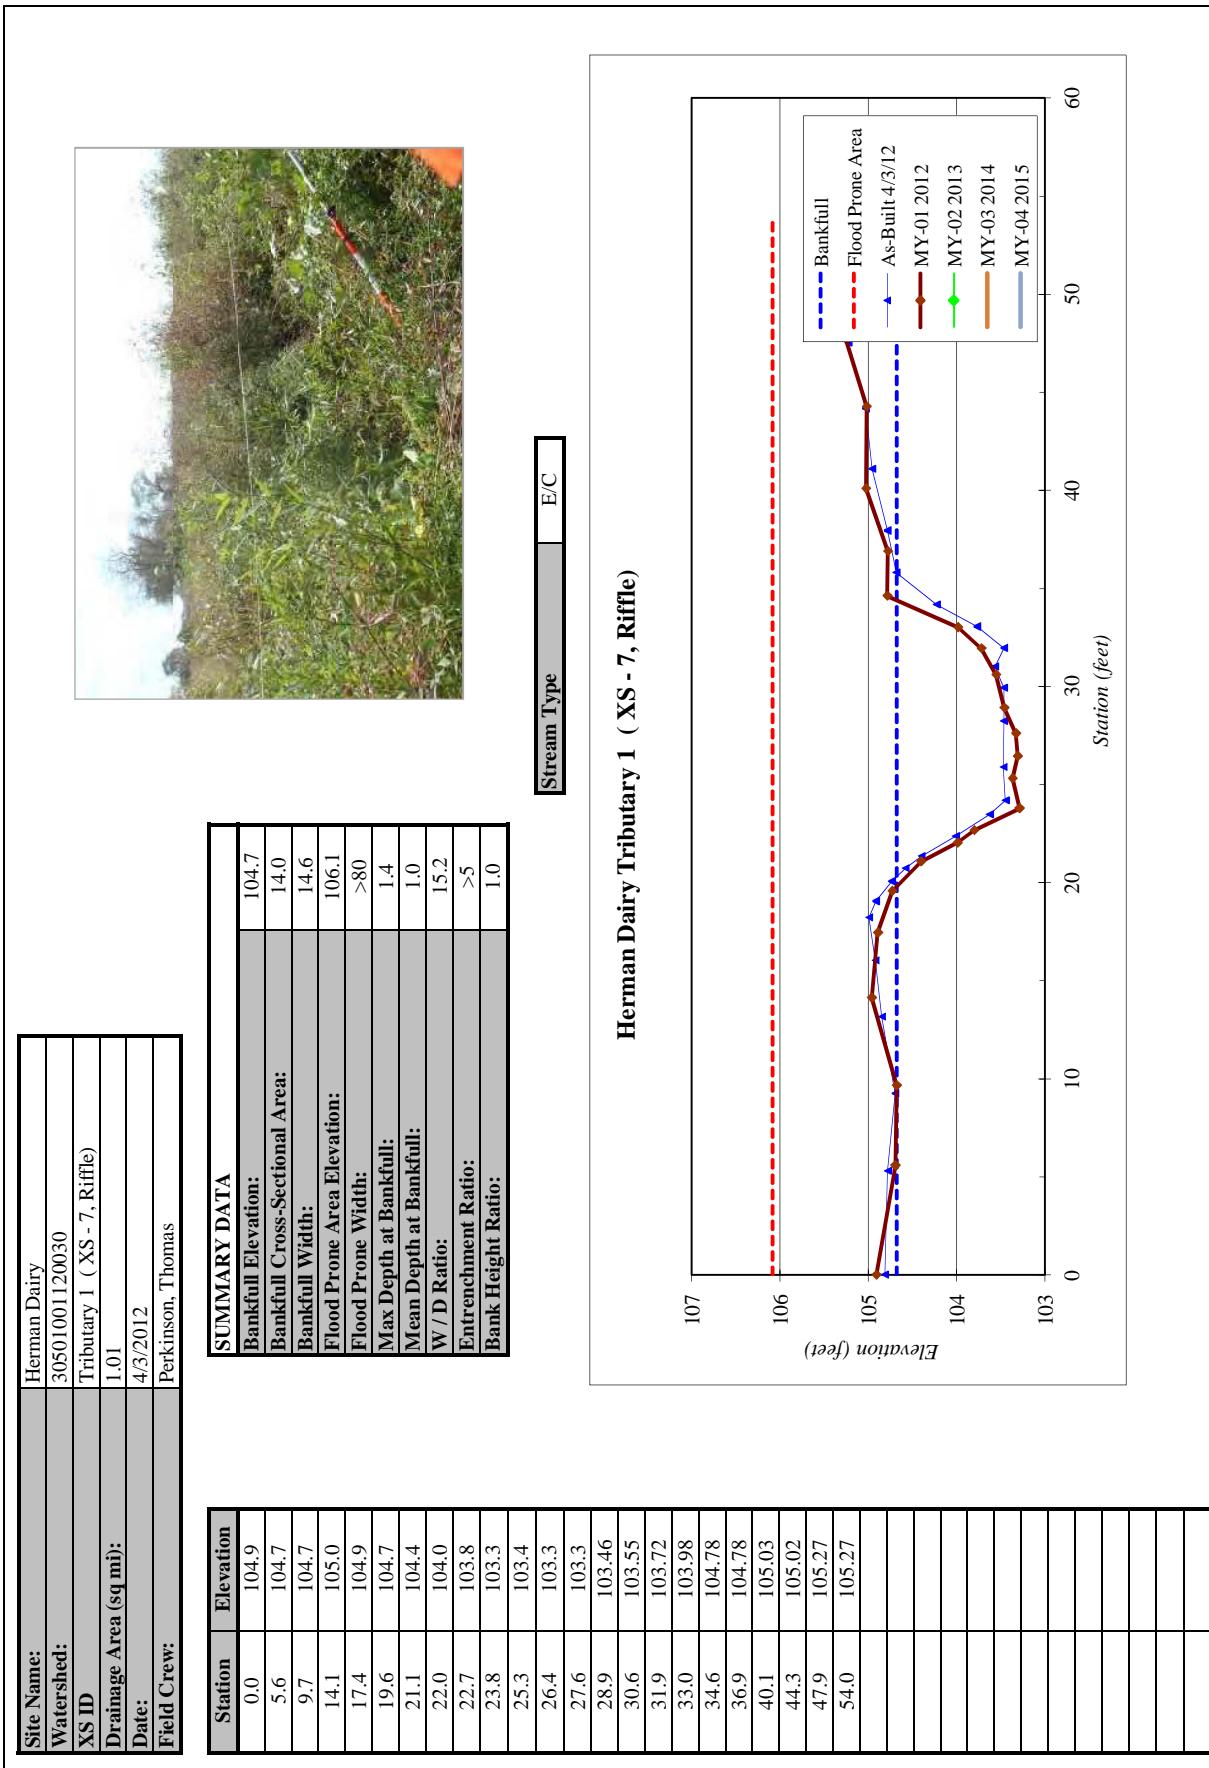





Site Name:	Herman Dairy
Watershed:	30501001120030
XS ID	Tributary 1 (XS - 8, Pool)
Drainage Area (sq mi):	1.01
Date:	4/3/2012
Field Crew:	Perkinsen, Thomas


SUMMARY DATA A	
Bankfull Elevation:	105.4
Bankfull Cross-Sectional Area:	16.0
Bankfull Width:	18.4
Flood Prone Area Elevation:	-
Flood Prone Width:	-
Max Depth at Bankfull:	2.1
Mean Depth at Bankfull:	0.9
W/D Ratio:	-
Entrenchment Ratio:	-
Bank Height Ratio:	-

Stream Type	E/C
-------------	-----

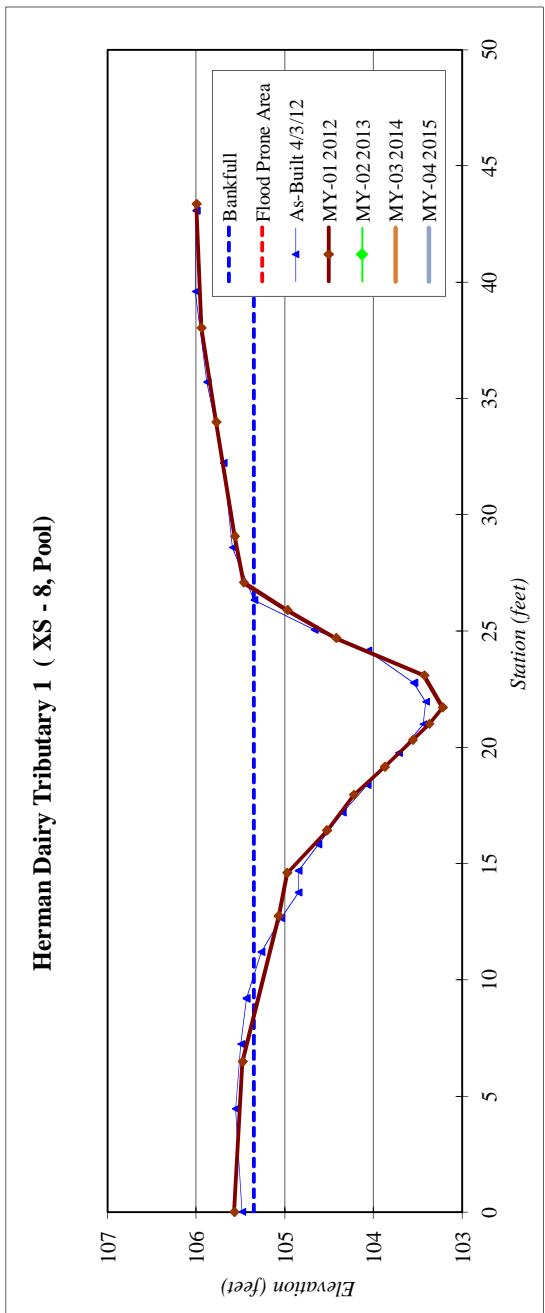

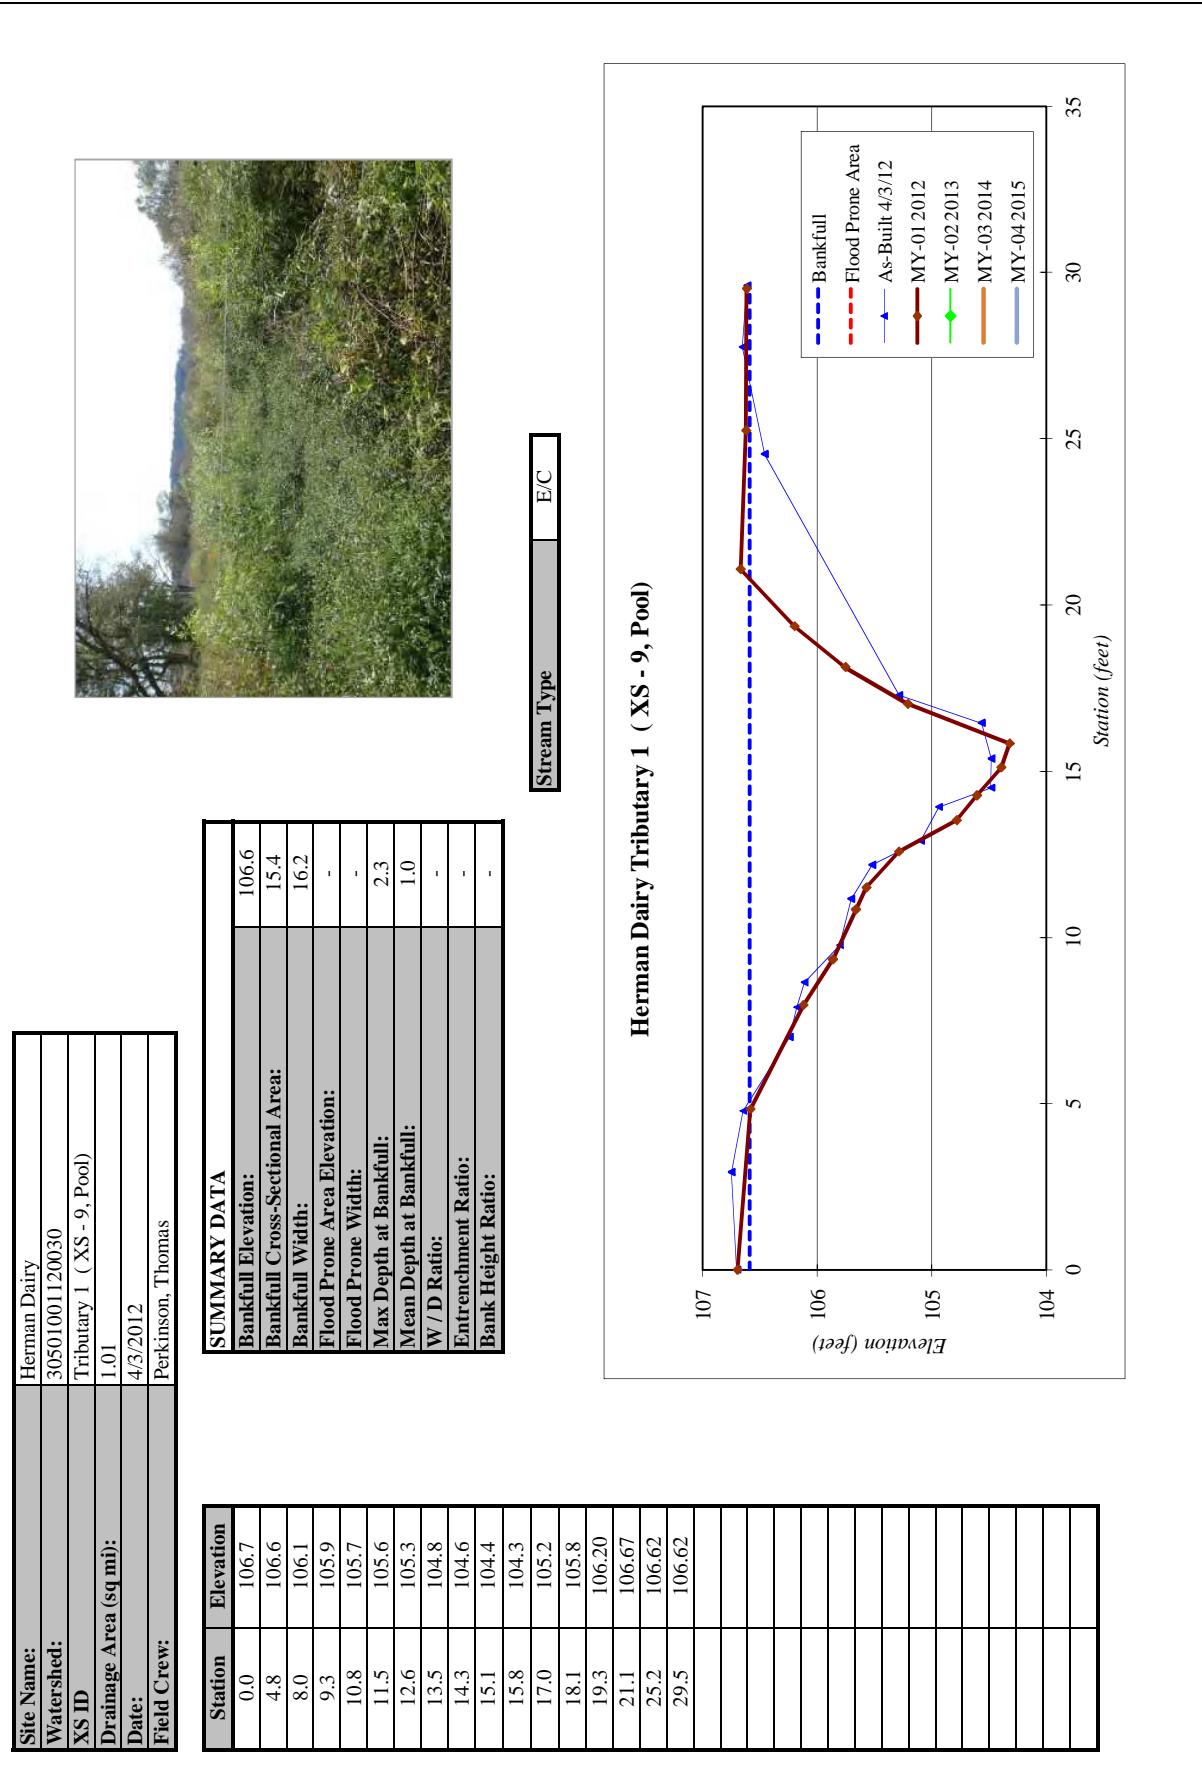


<b>Site Name:</b>	Herman Dairy
<b>Watershed:</b>	30501001120030
<b>XS ID</b>	Tributary 1 ( XS - 10, Riffle)
<b>Drainage Area (sq mi):</b>	1.01
<b>Date:</b>	4/3/2012
<b>Field Crew:</b>	Perkinson, Thomas

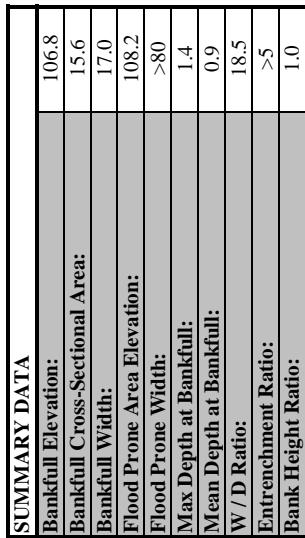


<b>Stream Type</b>	E/C
--------------------	-----

### Herman Dairy Tributary 1 ( XS - 10, Riffle)


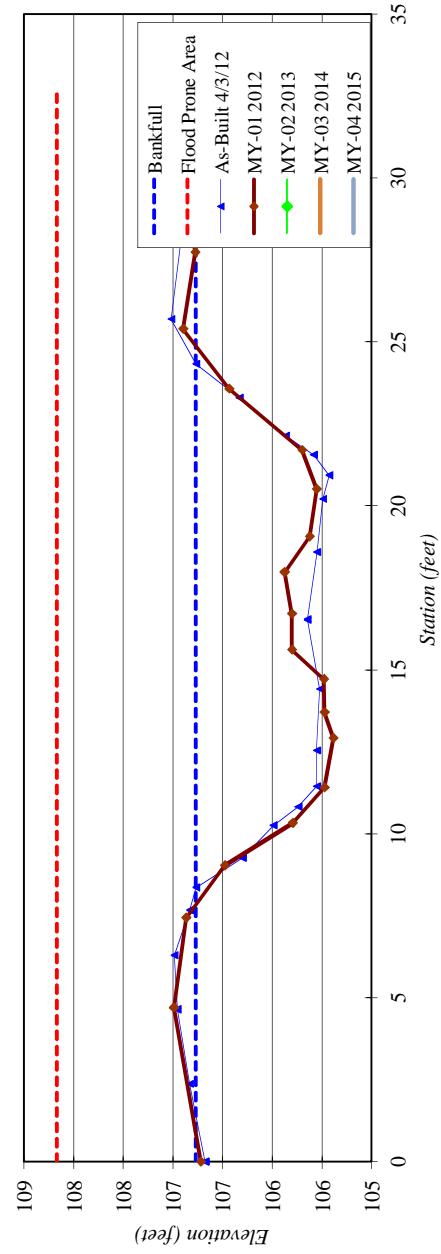



Site Name:	Herman Dairy
Watershed:	30501001120030
XS ID	Tributary 2 (XS - 11, Riffle)
Drainage Area (sq mi):	1.01
Date:	4/3/2012
Field Crew:	Perkins, Thomas

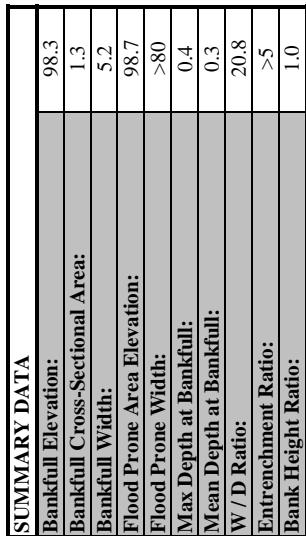

Stream Type	E/C

### Herman Dairy Tributary 2 (XS - 11, Riffle)

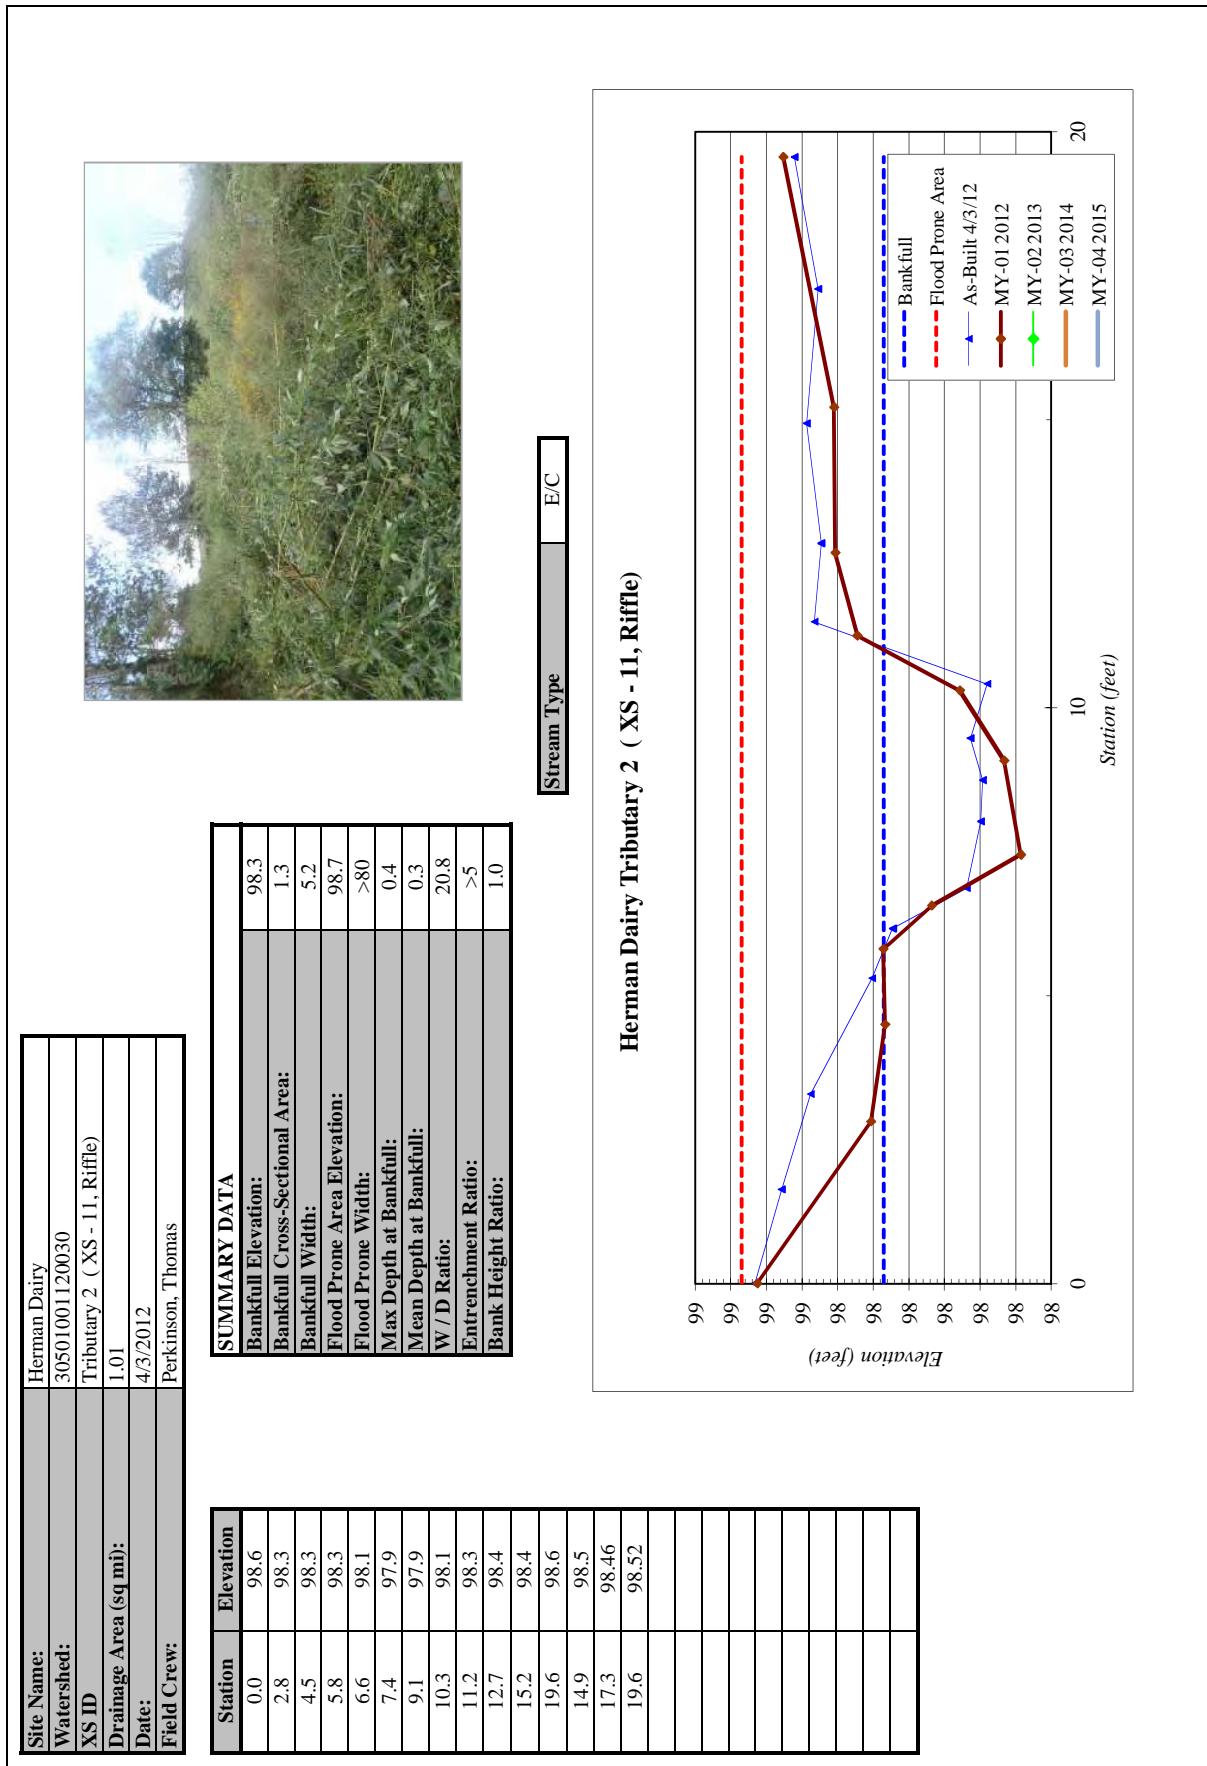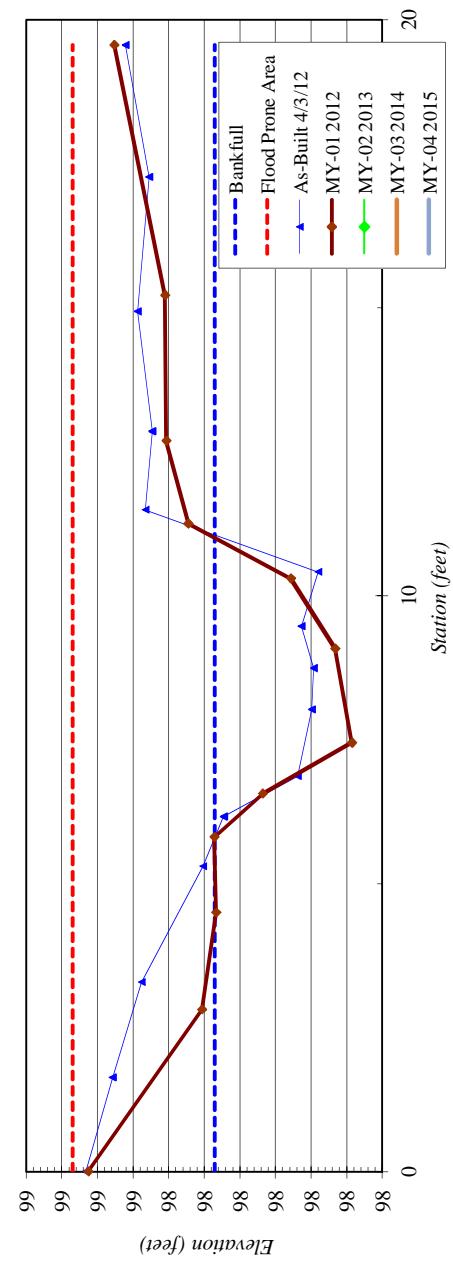

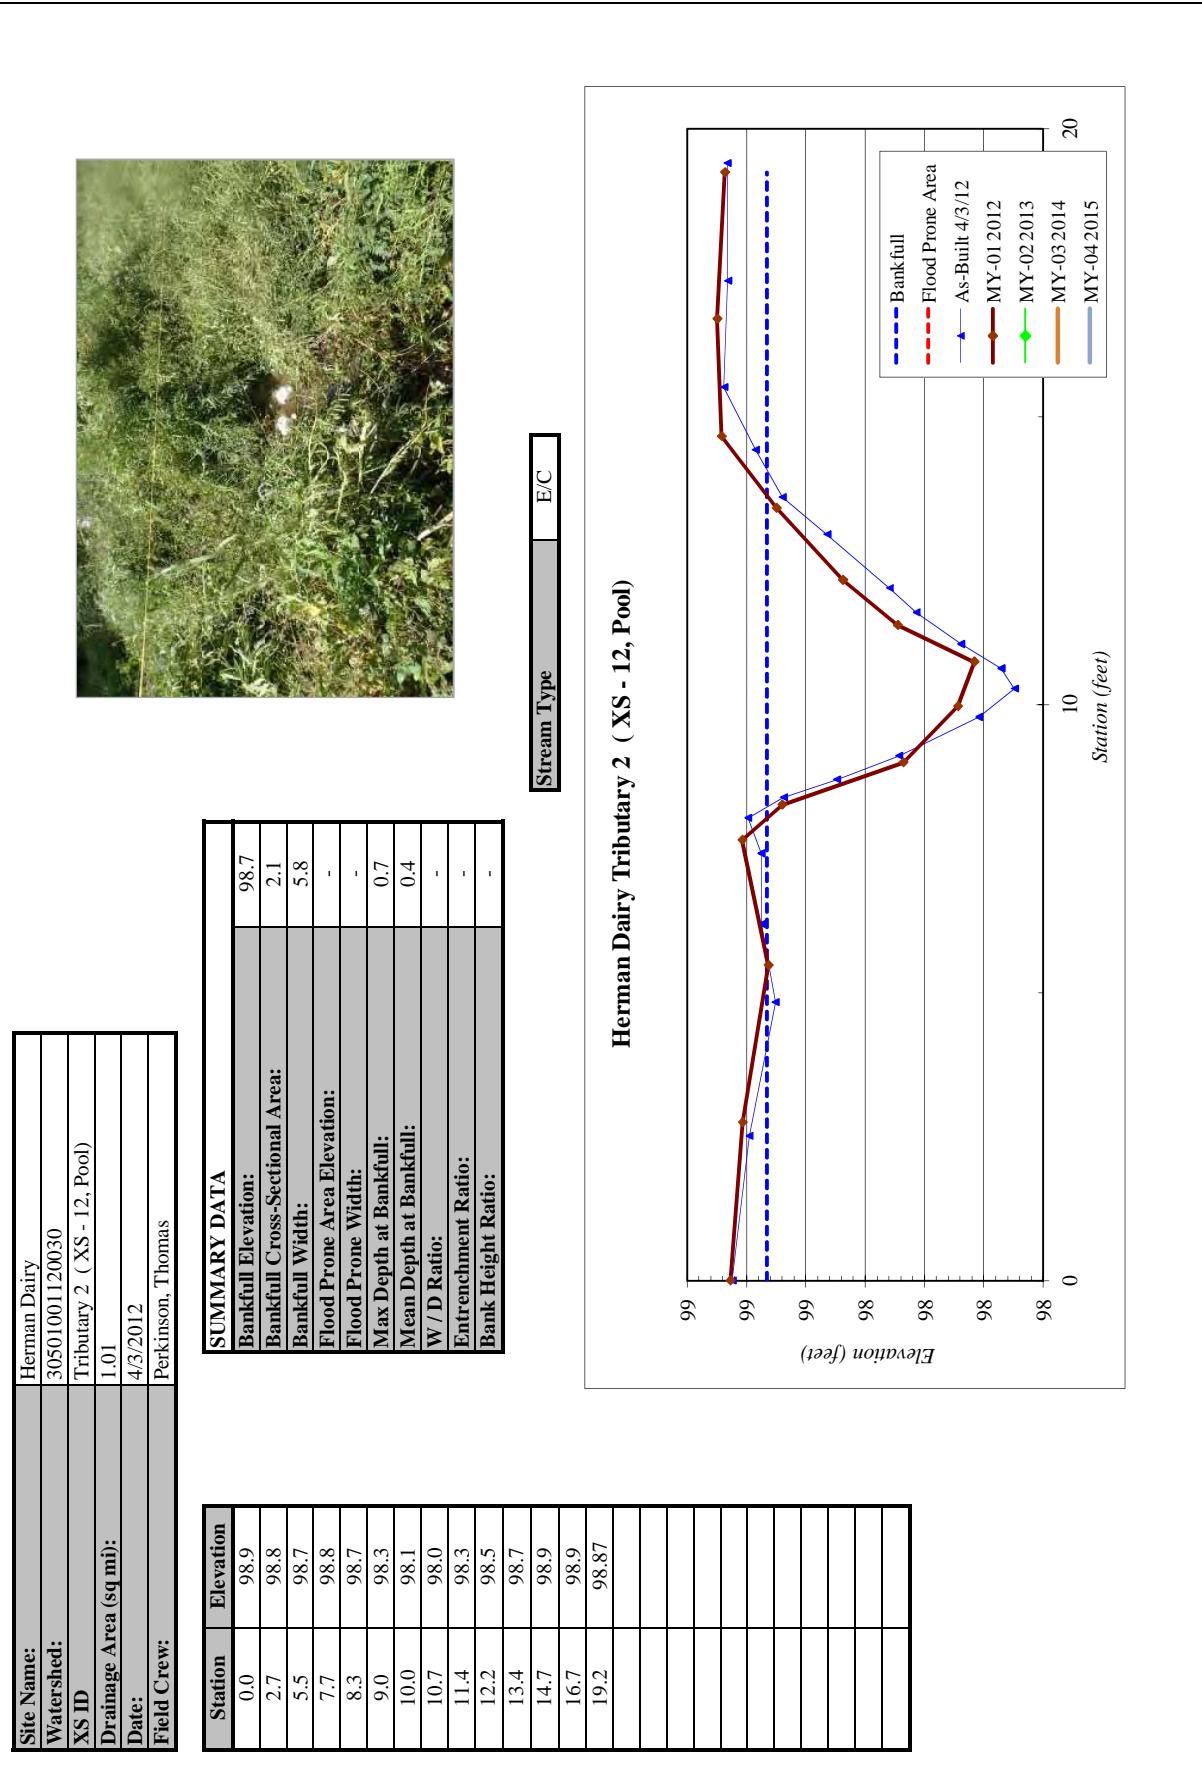


<b>Site Name:</b>	Herman Dairy
<b>Watershed:</b>	30501001120030
<b>XS ID</b>	Tributary 2 (XS - 13, Riffle)
<b>Drainage Area (sq mi):</b>	1.01
<b>Date:</b>	4/3/2012
<b>Field Crew:</b>	Perkinson, Thomas

<b>SUMMARY DATA</b>	
Bankfull Elevation:	99.3
Bankfull Cross-Sectional Area:	1.5
Bankfull Width:	7.0
FloodProne Area Elevation:	99.8
FloodProne Width:	>80
Max Depth at Bankfull:	0.5
Mean Depth at Bankfull:	0.2
W / D Ratio:	32.7
Entrenchment Ratio:	>5
Bank Height Ratio:	1.0




## Herman Dairy Tributary 2 (XS-13, Riffle)

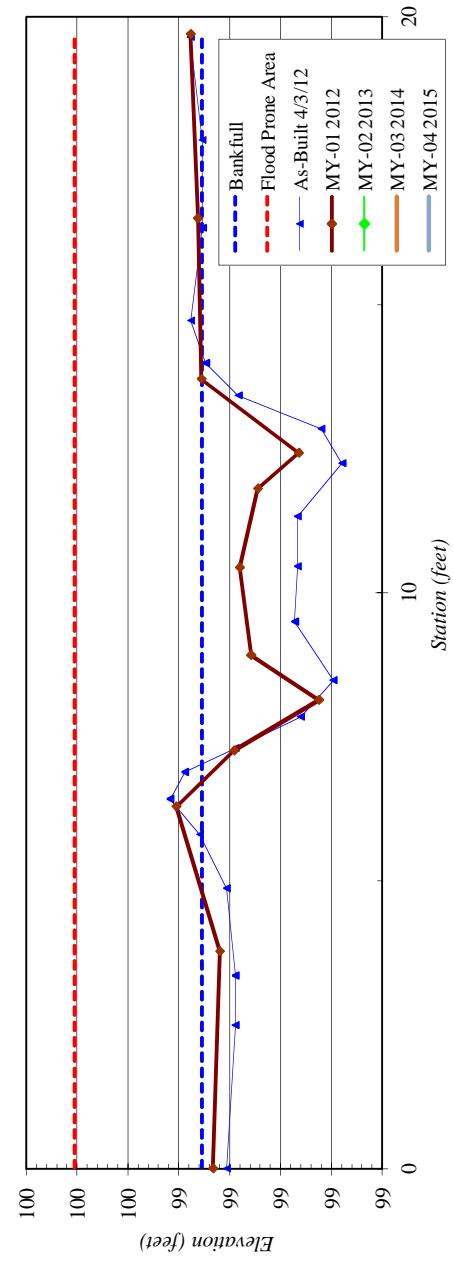


<b>Site Name:</b>	Herman Dairy
<b>Watershed:</b>	30501001120030
<b>XS ID</b>	Tributary 2 ( XS - 14, Pool)
<b>Drainage Area (sq mi):</b>	1.01
<b>Date:</b>	4/3/2012
<b>Field Crew:</b>	Perkinson, Thomas


<b>SUMMARY DATA</b>	
Bankfull Elevation:	103.2
Bankfull Cross-Sectional Area:	2.6
Bankfull Width:	6.8
FloodProne Area Elevation:	-
FloodProne Width:	-
Max Depth at Bankfull:	0.7
Mean Depth at Bankfull:	0.4
W / D Ratio:	-
Entrenchment Ratio:	-
Bank Height Ratio:	-

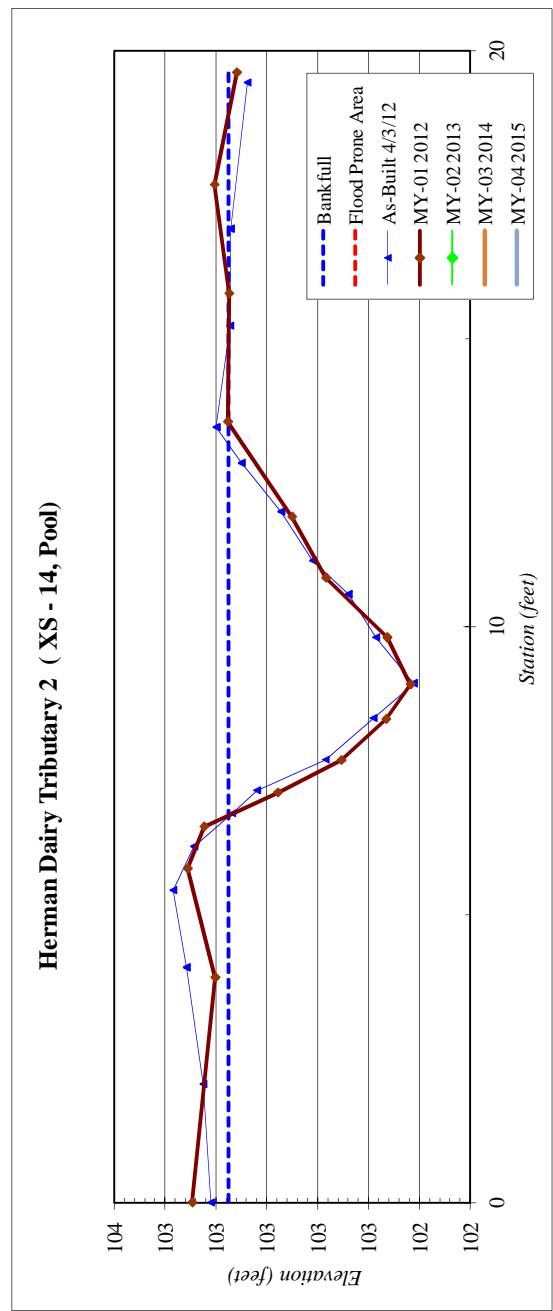

Site Name:	Herman Dairy
Watershed:	30501001120030
XS ID	Tributary 2 (XS - 15, Riffle)
Drainage Area (sq mi):	1.01
Date:	4/3/2012
Field Crew:	Perkinson, Thomas

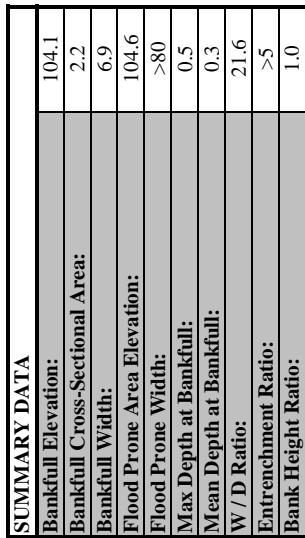


Station	Elevation
0.0	104.2
2.8	104.2
4.4	104.1
5.6	104.2
6.6	104.0
7.3	103.7
8.7	103.7
10.4	103.7
11.6	103.8
12.5	104.1
14.1	104.2
16.3	104.3
19.4	104.2

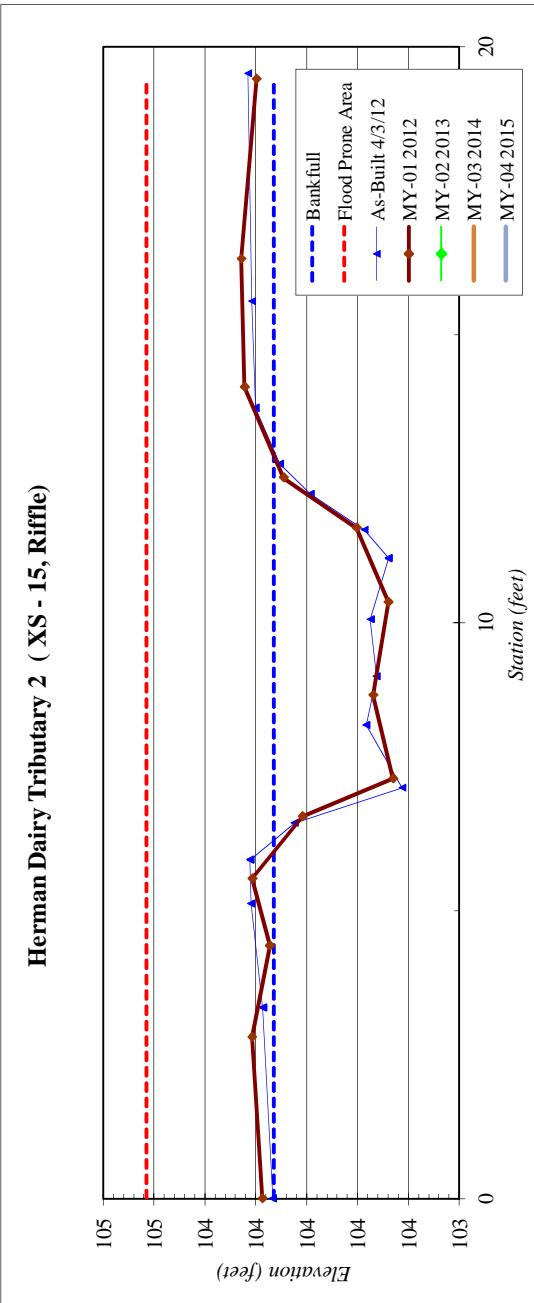

<b>Site Name:</b>	Herman Dairy
<b>Watershed:</b>	30501001120030
<b>XS ID</b>	Tributary 2 (XS - 16, Pool)
<b>Drainage Area (sq mi):</b>	1.01
<b>Date:</b>	4/3/2012
<b>Field Crew:</b>	Perkinson, Thomas



SUMMARY DATA	
Bankfull Elevation:	104.5
Bankfull Cross-Sectional Area:	2.4
Bankfull Width:	7.1
FloodProne Area Elevation:	-
FloodProne Width:	-
Max Depth at Bankfull:	0.8
Mean Depth at Bankfull:	0.3
W / D Ratio:	-
Entrenchment Ratio:	-
Bank Height Ratio:	-

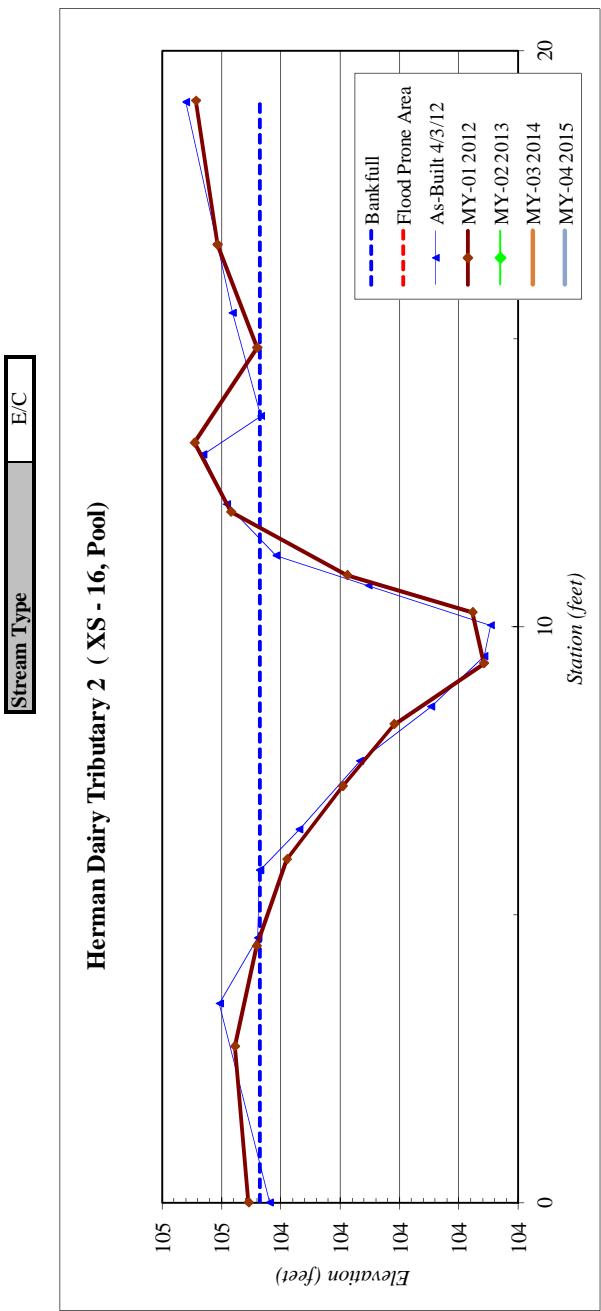





Site Name:	Herman Dairy
Watershed:	30501001120030
XS ID	Tributary 3 (XS - 17, Riffle)
Drainage Area (sq mi):	0.06
Date:	4/3/2012
Field Crew:	Perkins, Thomas

SUMMARY DATA A	
Bankfull Elevation:	100.0
Bankfull Cross-Sectional Area:	2.6
Bankfull Width:	7.7
Flood Prone Area Elevation:	100.5
Flood Prone Width:	>80
Max Depth at Bankfull:	0.5
Mean Depth at Bankfull:	0.3
W/D Ratio:	22.8
Entrenchment Ratio:	>5
Bank Height Ratio:	1.0

Stream Type	E/C

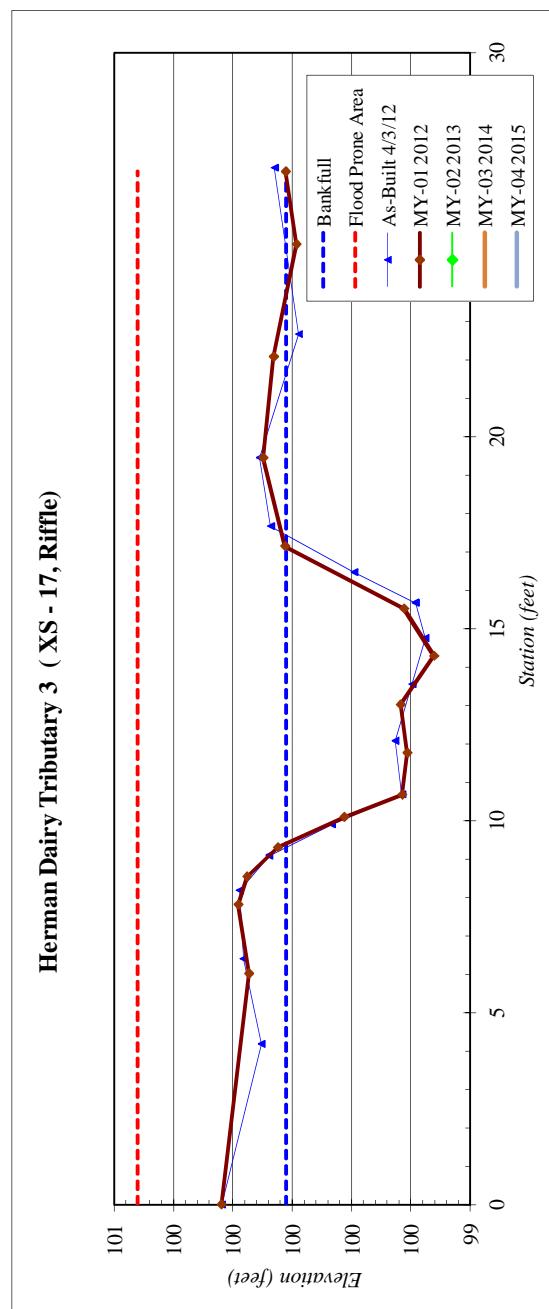


Site Name:	Herman Dairy
Watershed:	30501001120030
XS ID	Tributary 3 (XS - 18, Pool)
Drainage Area (sq mi):	0.06
Date:	4/3/2012
Field Crew:	Perkins, Thomas

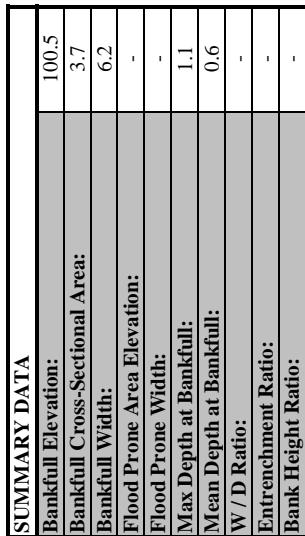


Station	Elevation
0.0	100.7
4.2	100.7
6.6	100.8
8.0	100.7
9.3	100.5
10.9	99.5
11.6	99.5
12.2	99.5
12.9	99.8
14.0	100.2
15.1	100.5
16.9	100.5
19.4	100.7
23.0	100.66

Stream Type	E/C
-------------	-----


Herman Dairy Tributary 3 (XS - 18, Pool)

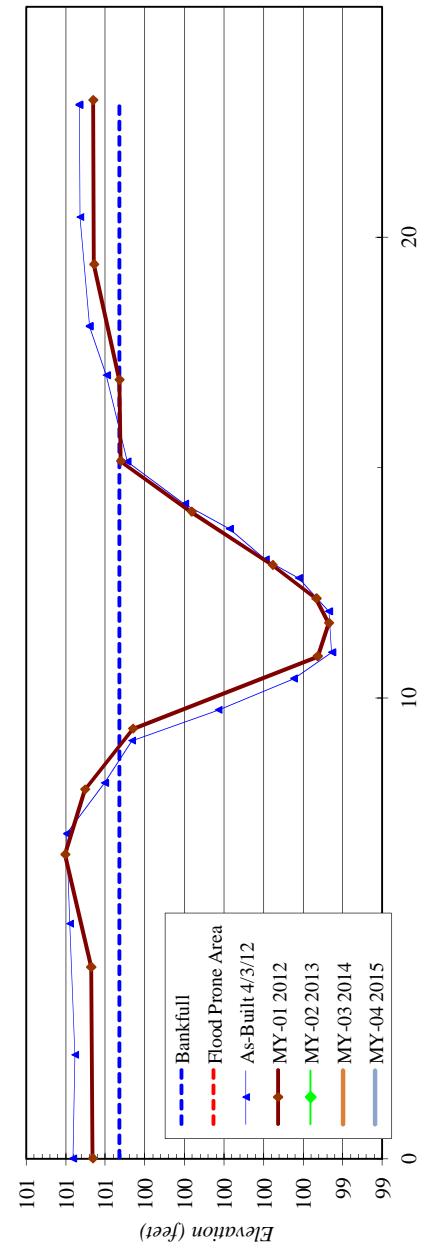

Site Name:	Herman Dairy
Watershed:	30501001120030
XS ID	Tributary 3 (XS - 19, Pool)
Drainage Area (sq mi):	0.06
Date:	4/3/2012
Field Crew:	Perkinson, Thomas

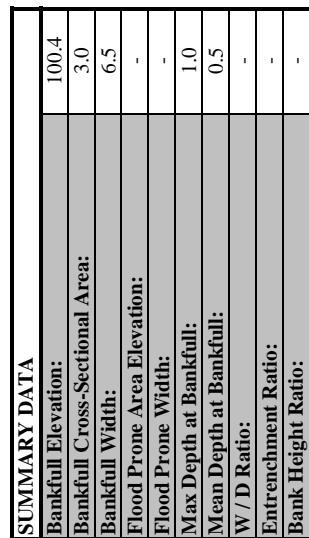

Station	Elevation
0.0	100.4
4.6	100.4
7.2	100.4
9.8	100.4
11.1	100.3
11.9	99.9
12.8	99.4
13.5	99.5
14.2	99.6
15.0	99.9
16.0	100.1
17.2	100.4
20.4	100.6
23.2	100.74
25.9	100.79

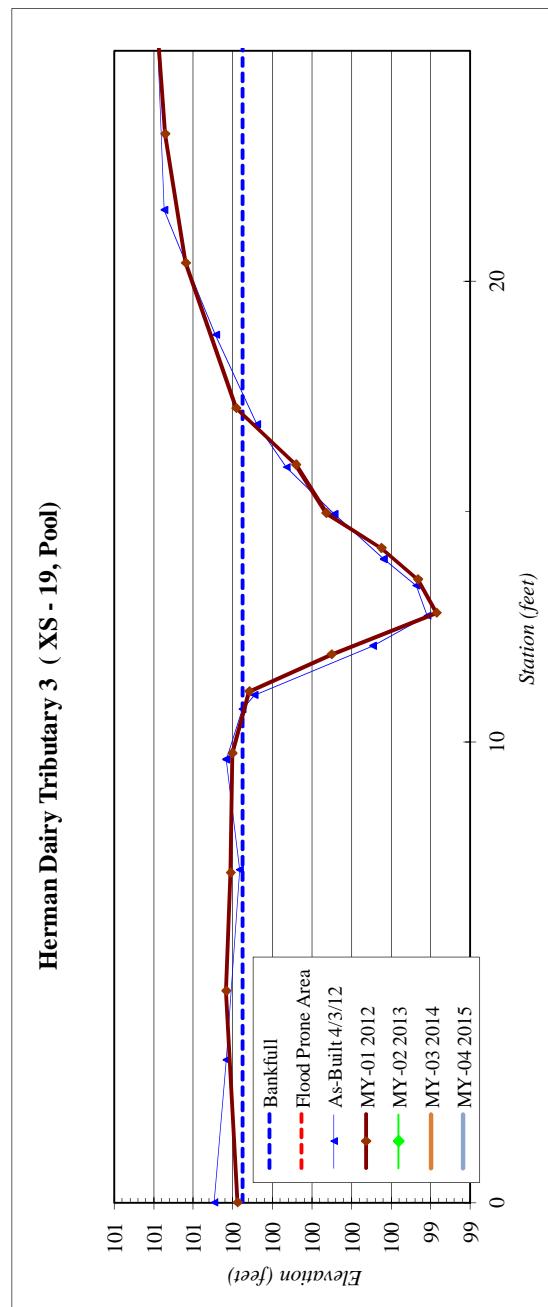


Site Name:	Herman Dairy
Watershed:	30501001120030
XS ID	Tributary 3 (XS - 20, Riffle)
Drainage Area (sq mi):	0.06
Date:	4/3/2012
Field Crew:	Perkinson, Thomas



SUMMARY DATA A	
Bankfull Elevation:	100.7
Bankfull Cross-Sectional Area:	2.3
Bankfull Width:	7.8
Flood Prone Area Elevation:	101.1
Flood Prone Width:	>80
Max Depth at Bankfull:	0.4
Mean Depth at Bankfull:	0.3
W/D Ratio:	26.5
Entrenchment Ratio:	>5
Bank Height Ratio:	1.0

Stream Type	E/C

Herman Dairy Tributary 3 (XS - 20, Riffle)

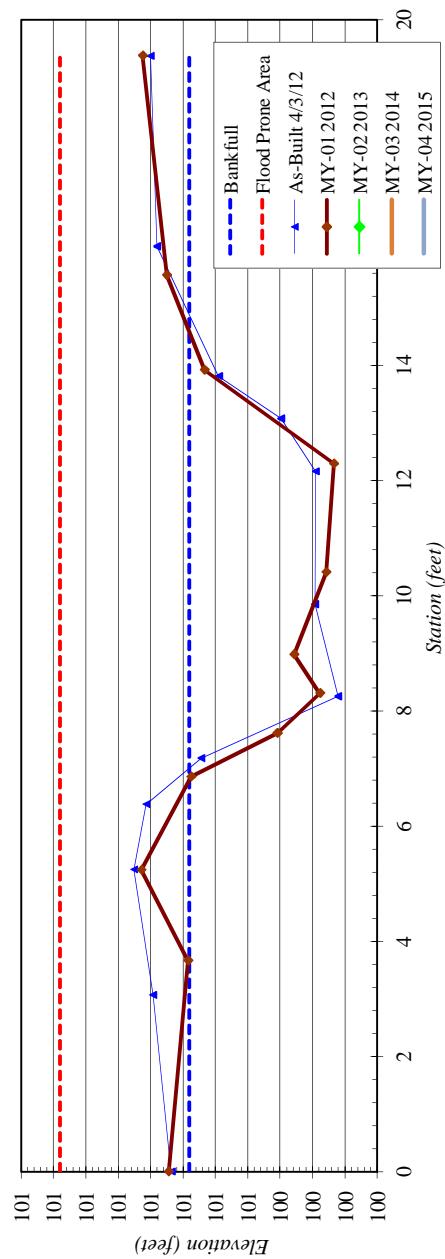

## **Appendix E. Hydrology Data**

Table 12. Wetland Hydrology Criteria Attainment

2012 Groundwater Gauge Graphs


Figure E1. Annual Climatic Data vs. 30-year Historic Data

**Table 12. Wetland Hydrology Criteria Attainment**


Gauge	Success Criteria Achieved/Max Consecutive Days During Growing Season (Percentage)				
	Year 1 (2012)*	Year 2 (2013)	Year 3 (2014)	Year 4 (2015)	Year 5 (2016)
1	Yes/38 days (16.2 percent)				
2	Yes/64 days (27.2 percent)				
3	Yes/182 days (77.4 percent)				
4	Yes/183 days (77.9 percent)				
5	Yes/87 days (37.0 percent)				
6	Yes/86 days (36.6 percent)				
7	Yes/192 days (81.7 percent)				
8	Yes/178 days (75.7 percent)				
9	Yes/19 days (8.1 percent)				
10	Yes/102 days (43.4 percent)				
Ref	Yes/148 days (62.9 percent)				

\*Data has been collected through October 15, 2012 for the Year 1 (2012) monitoring season; data will continue to be collected throughout the remainder of the growing season and will be available upon request.


## Herman Dairy Groundwater Gauge 1 Year 1 (2012 Gauge Data)

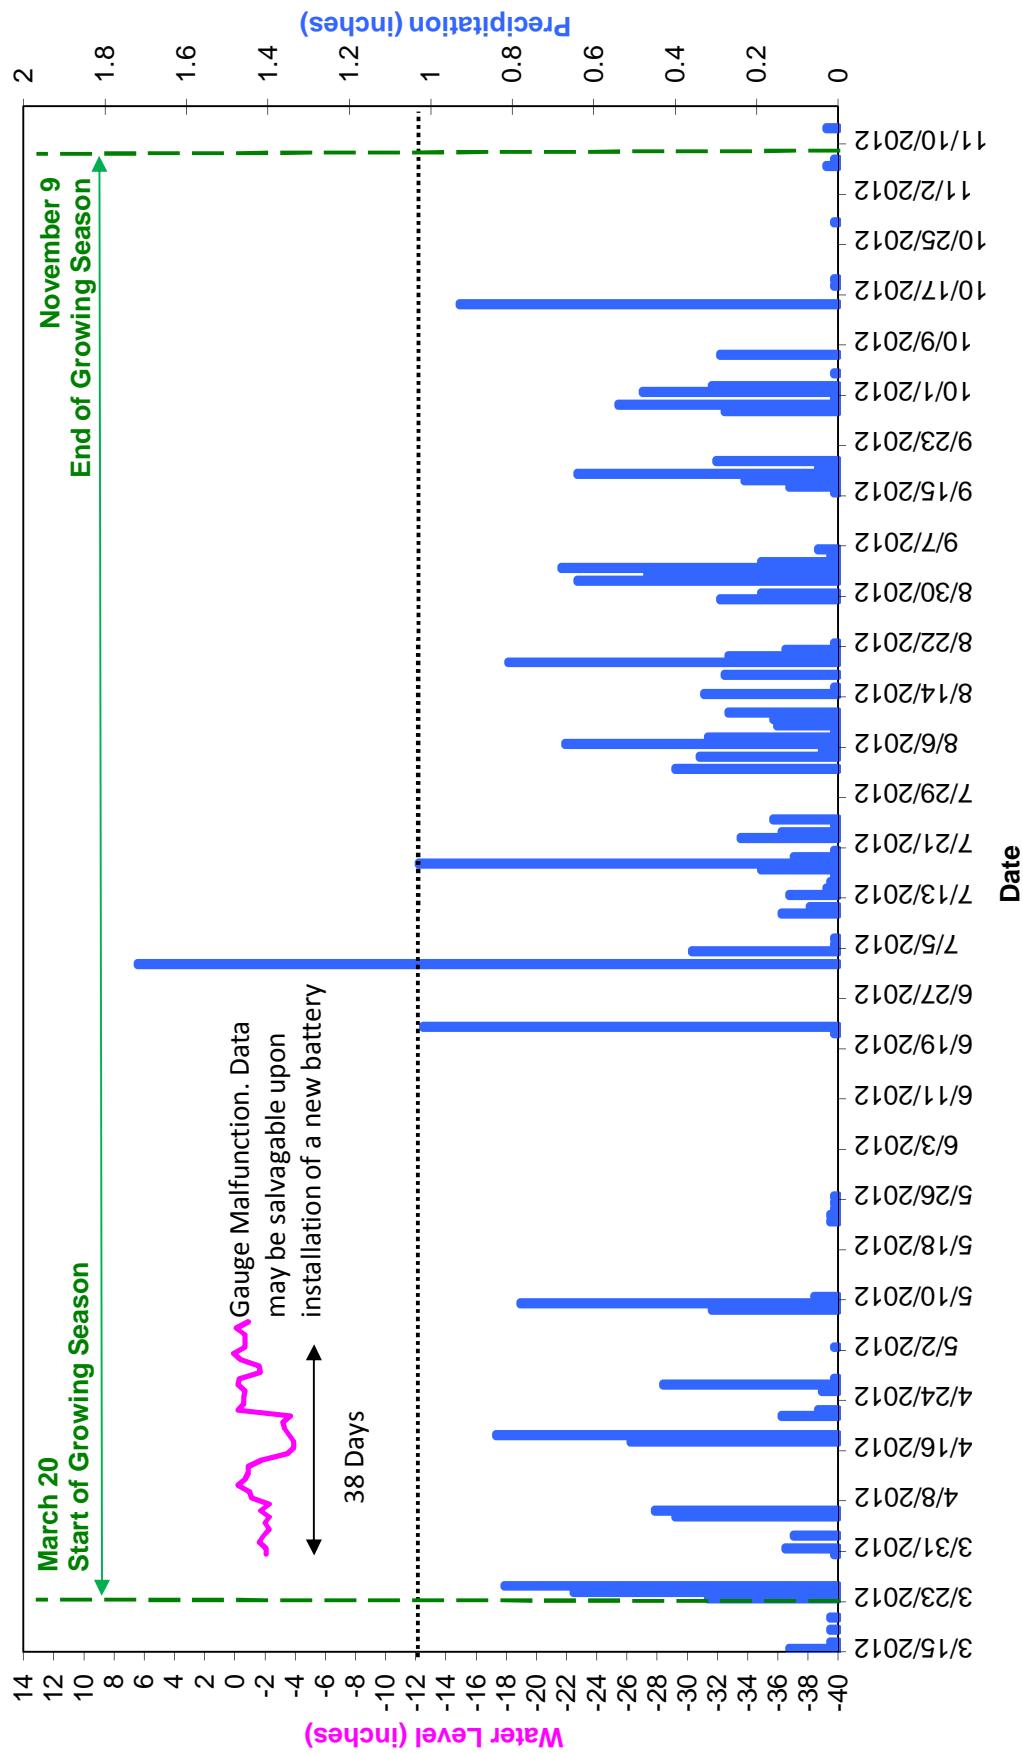


## Herman Dairy Groundwater Gauge 2 Year 1 (2012 Gauge Data)

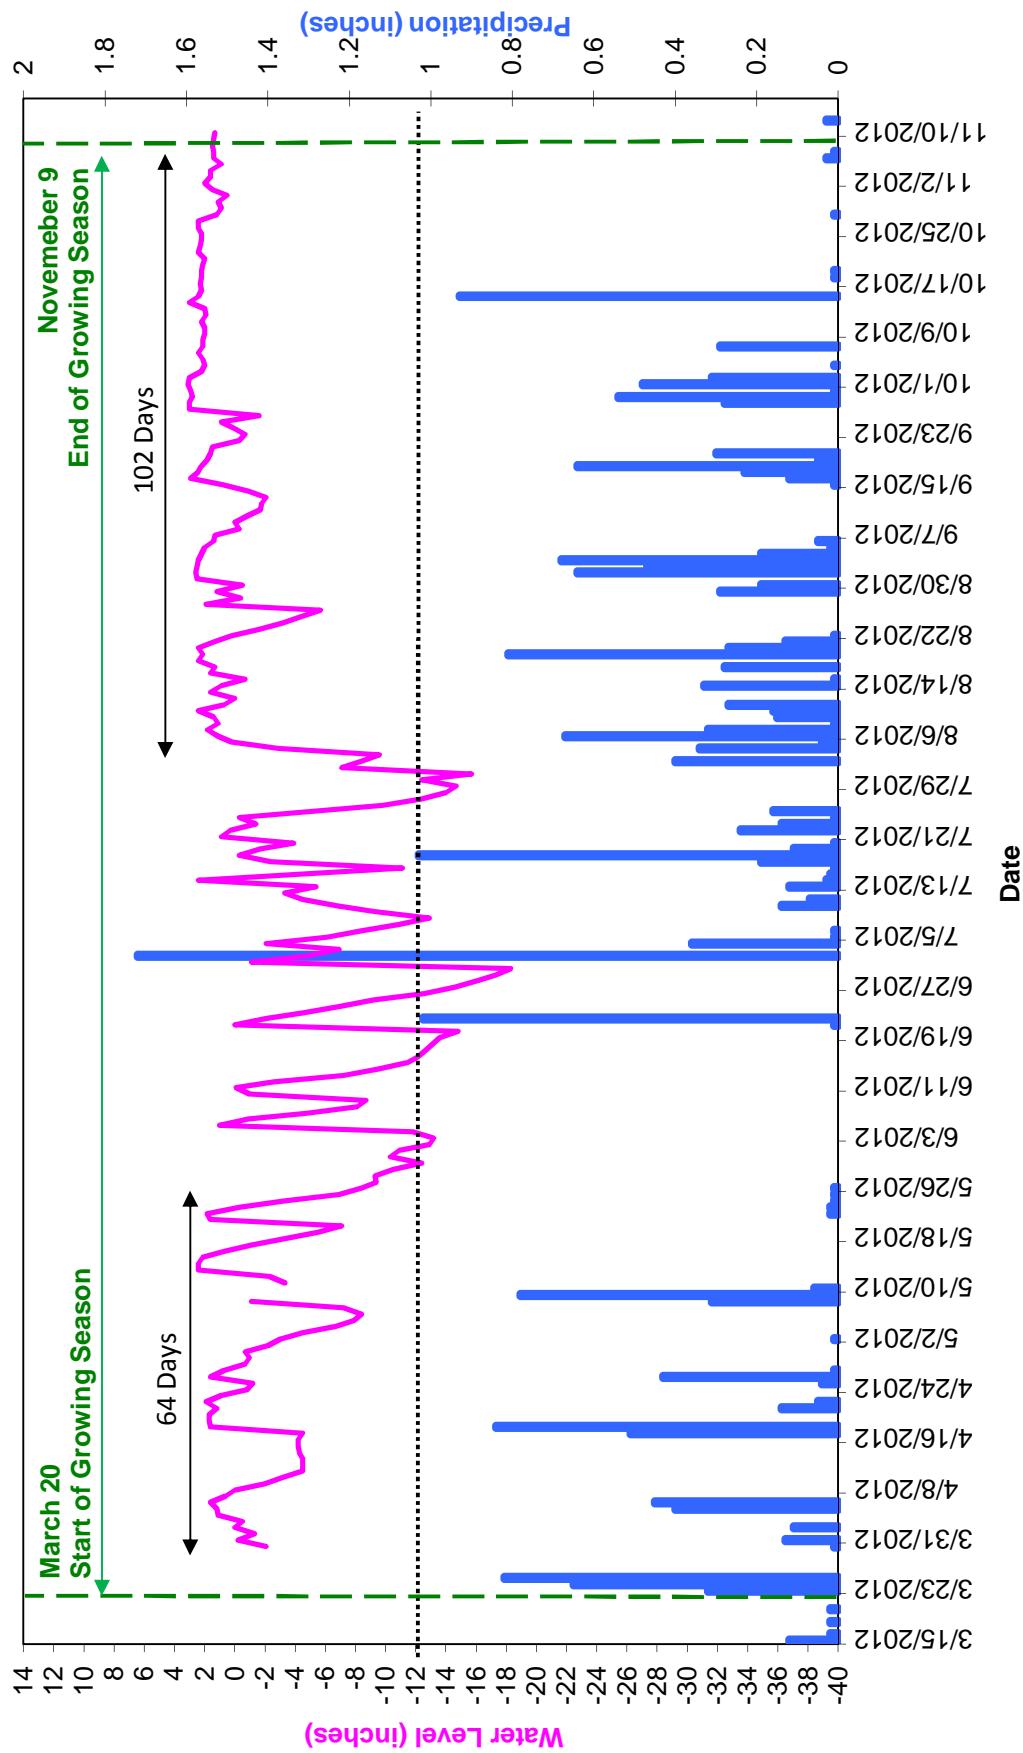


### Herman Dairy Groundwater Gauge 3 Year 1 (2012 Gauge Data)

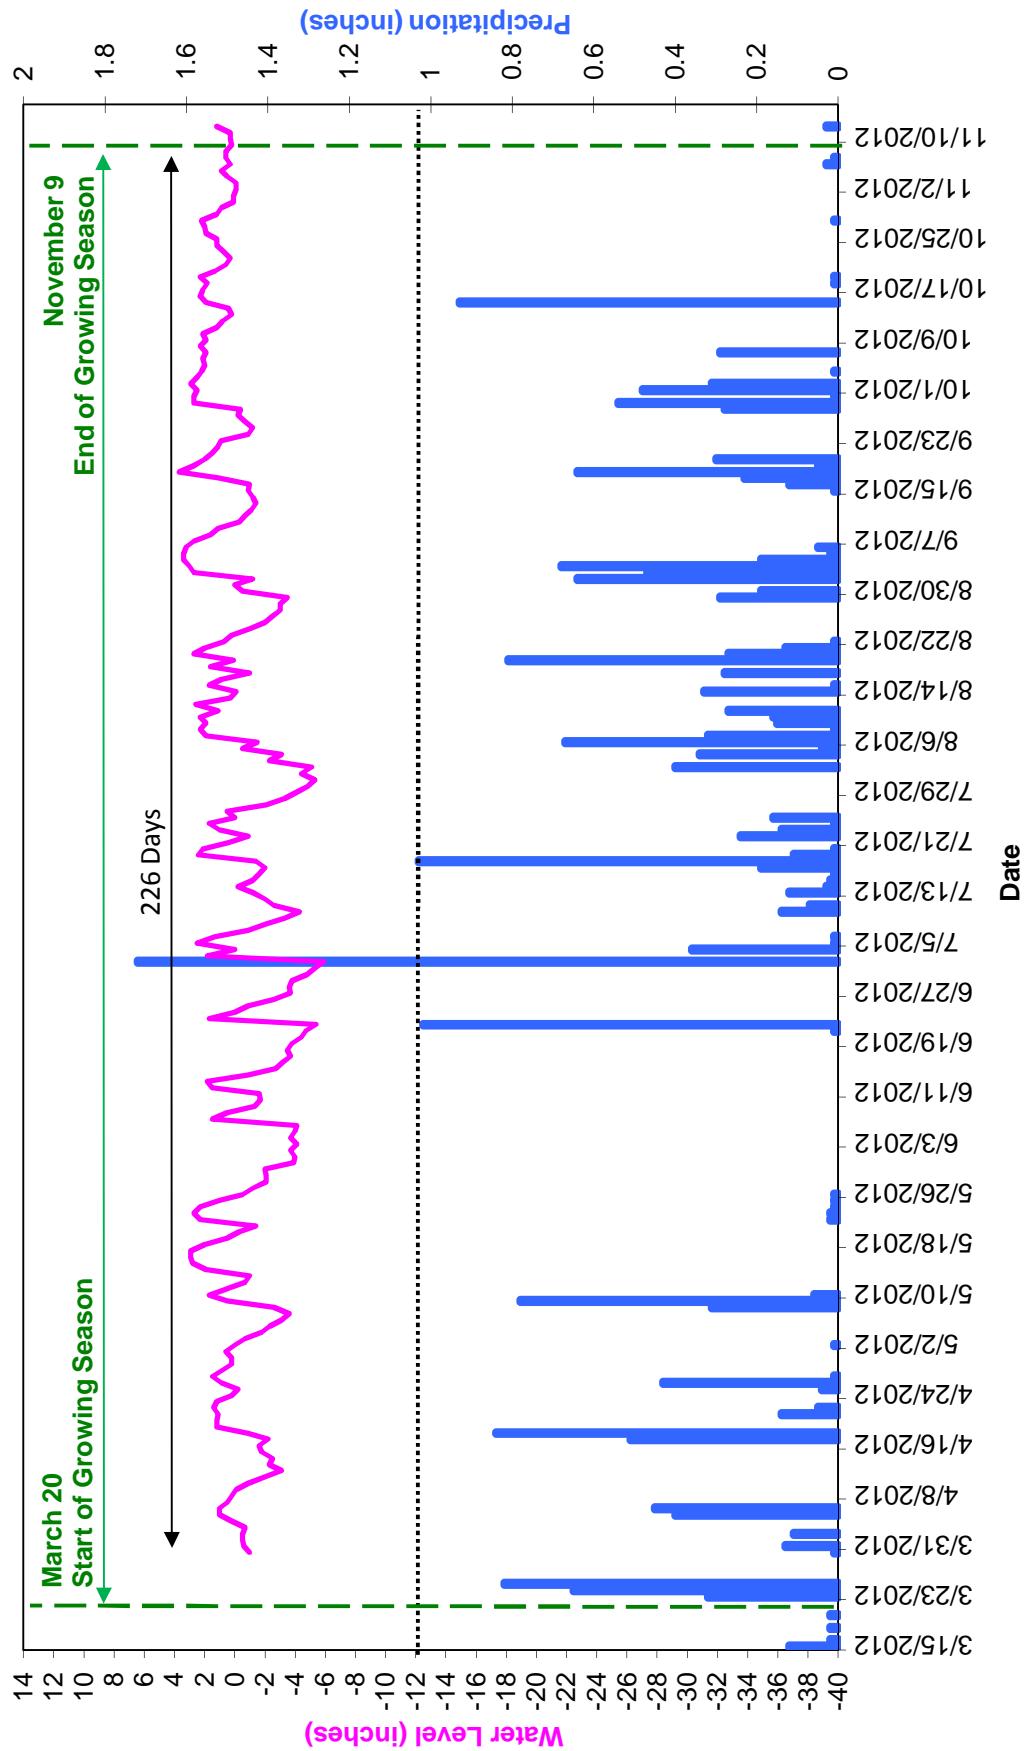


## Herman Dairy Groundwater Gauge 4 Year 1 (2012 Gauge Data)

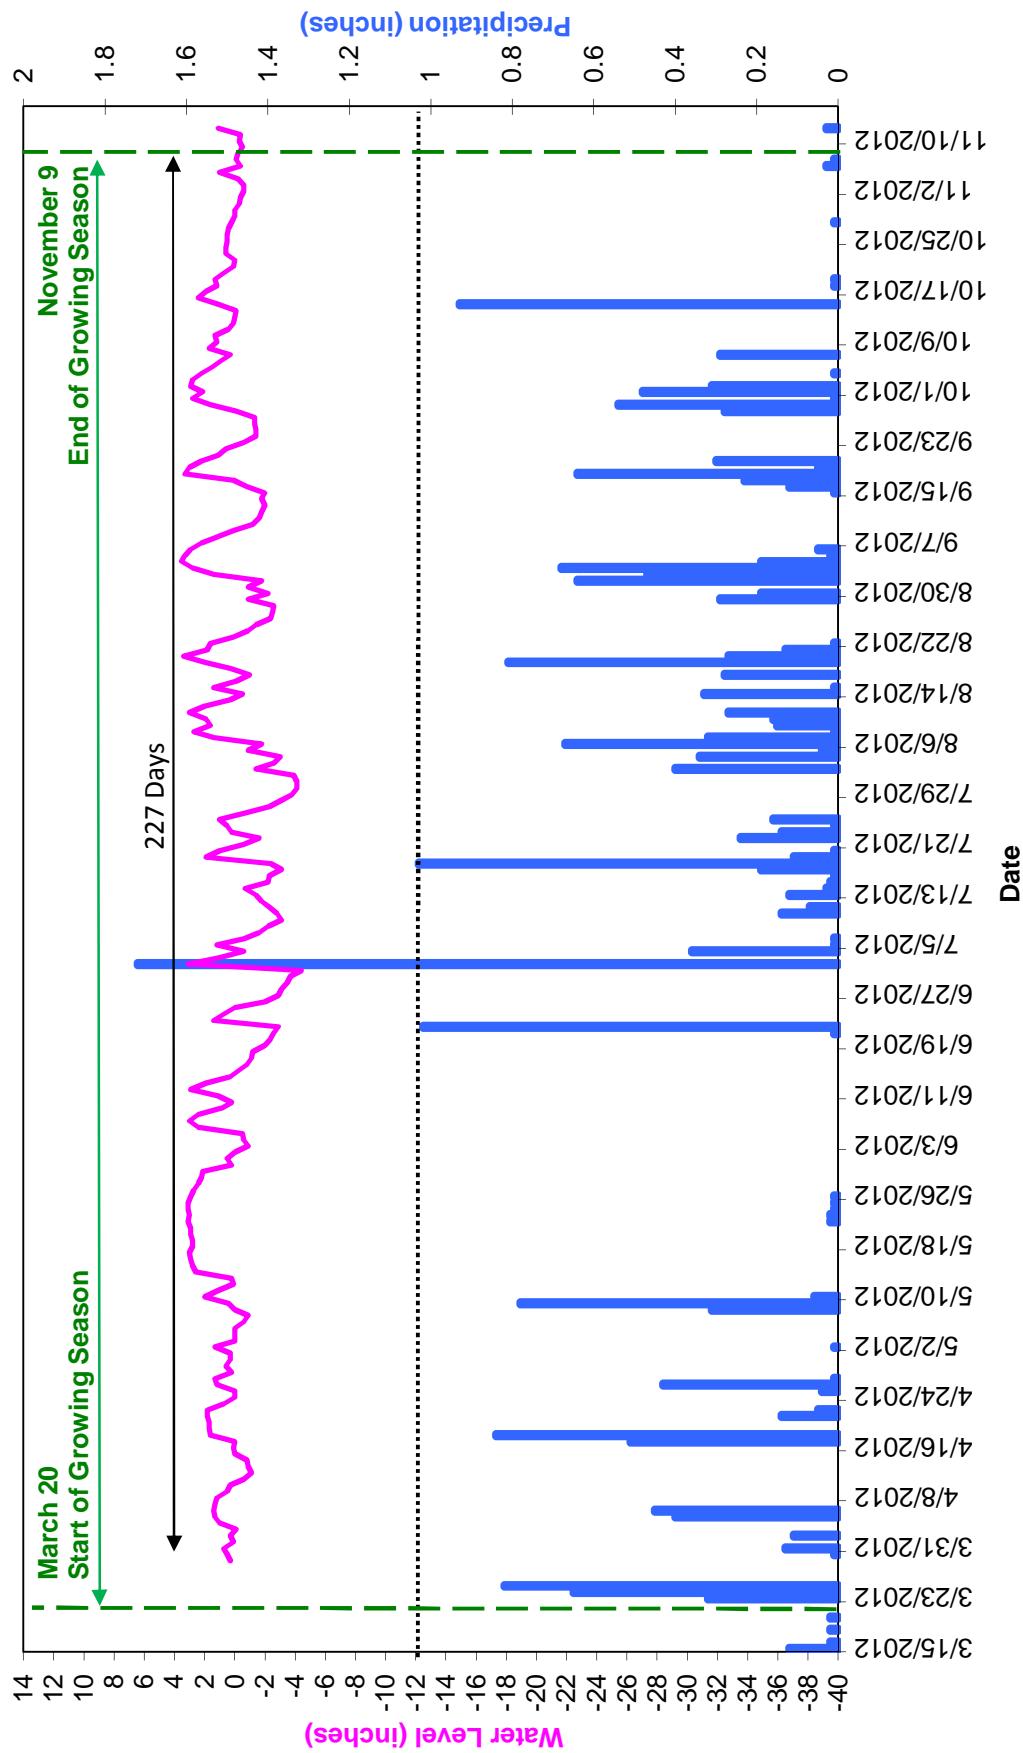


## Herman Dairy Groundwater Gauge 5 Year 1 (2012 Gauge Data)

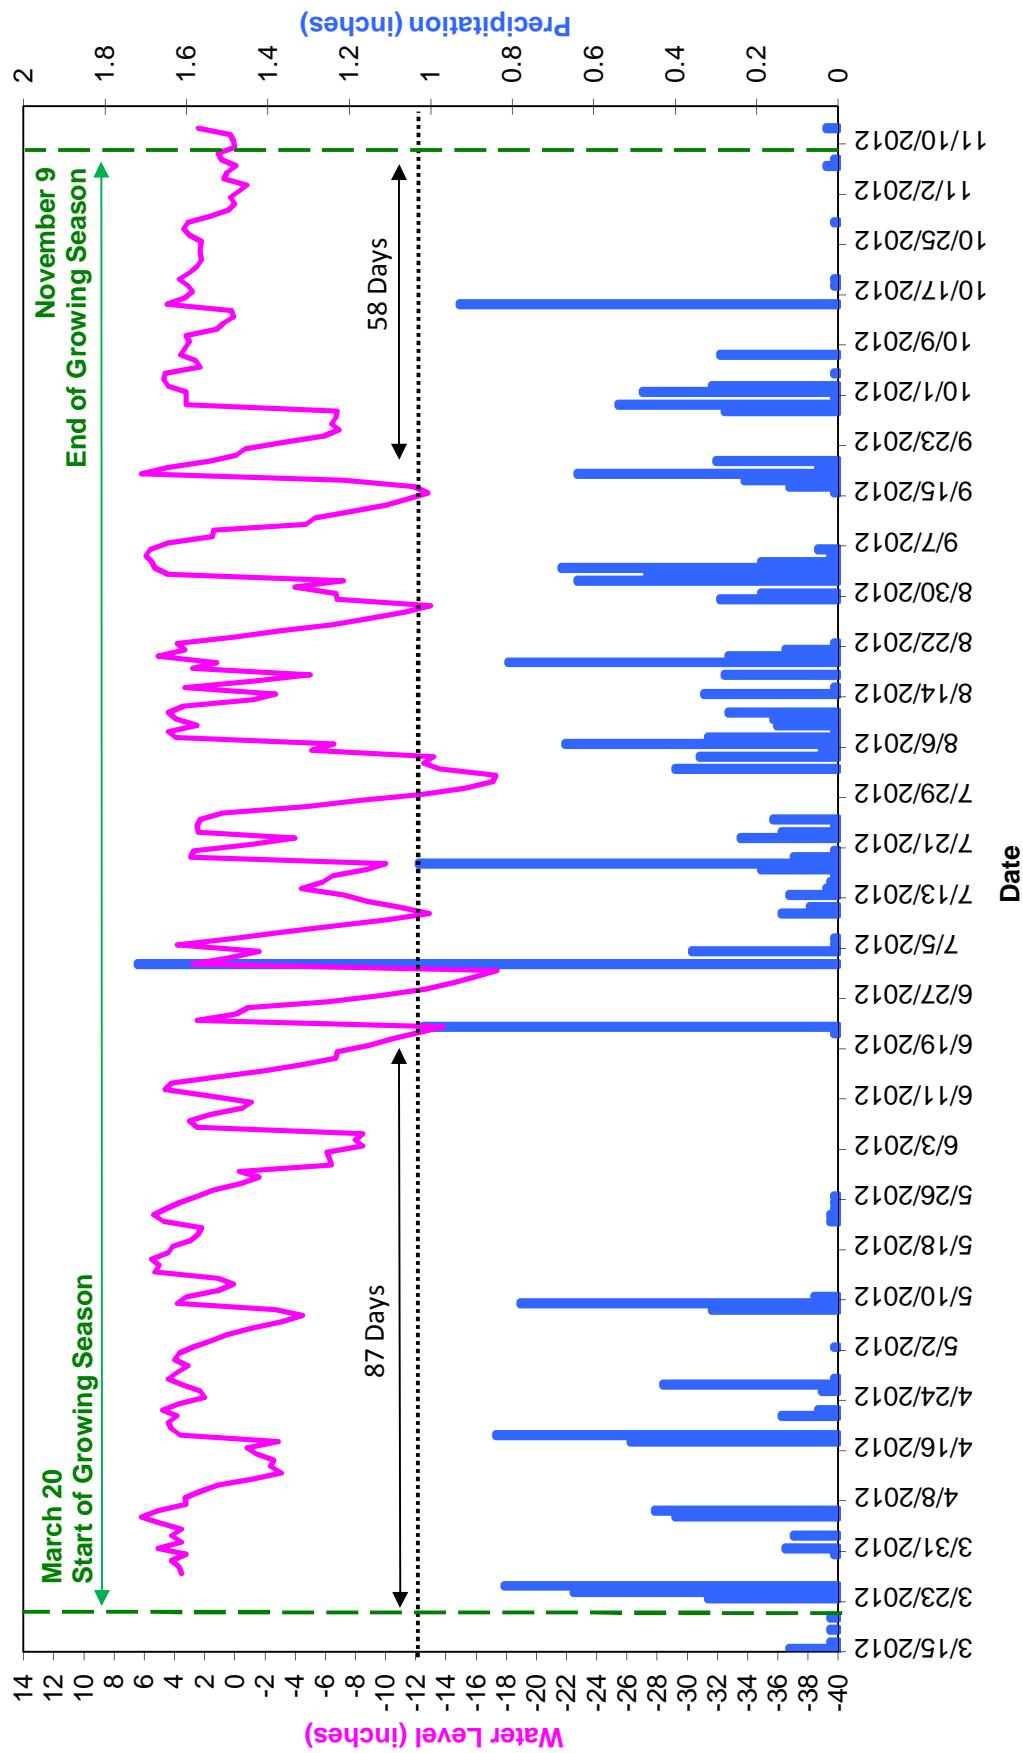


## Herman Dairy Groundwater Gauge 6 Year 1 (2012 Gauge Data)

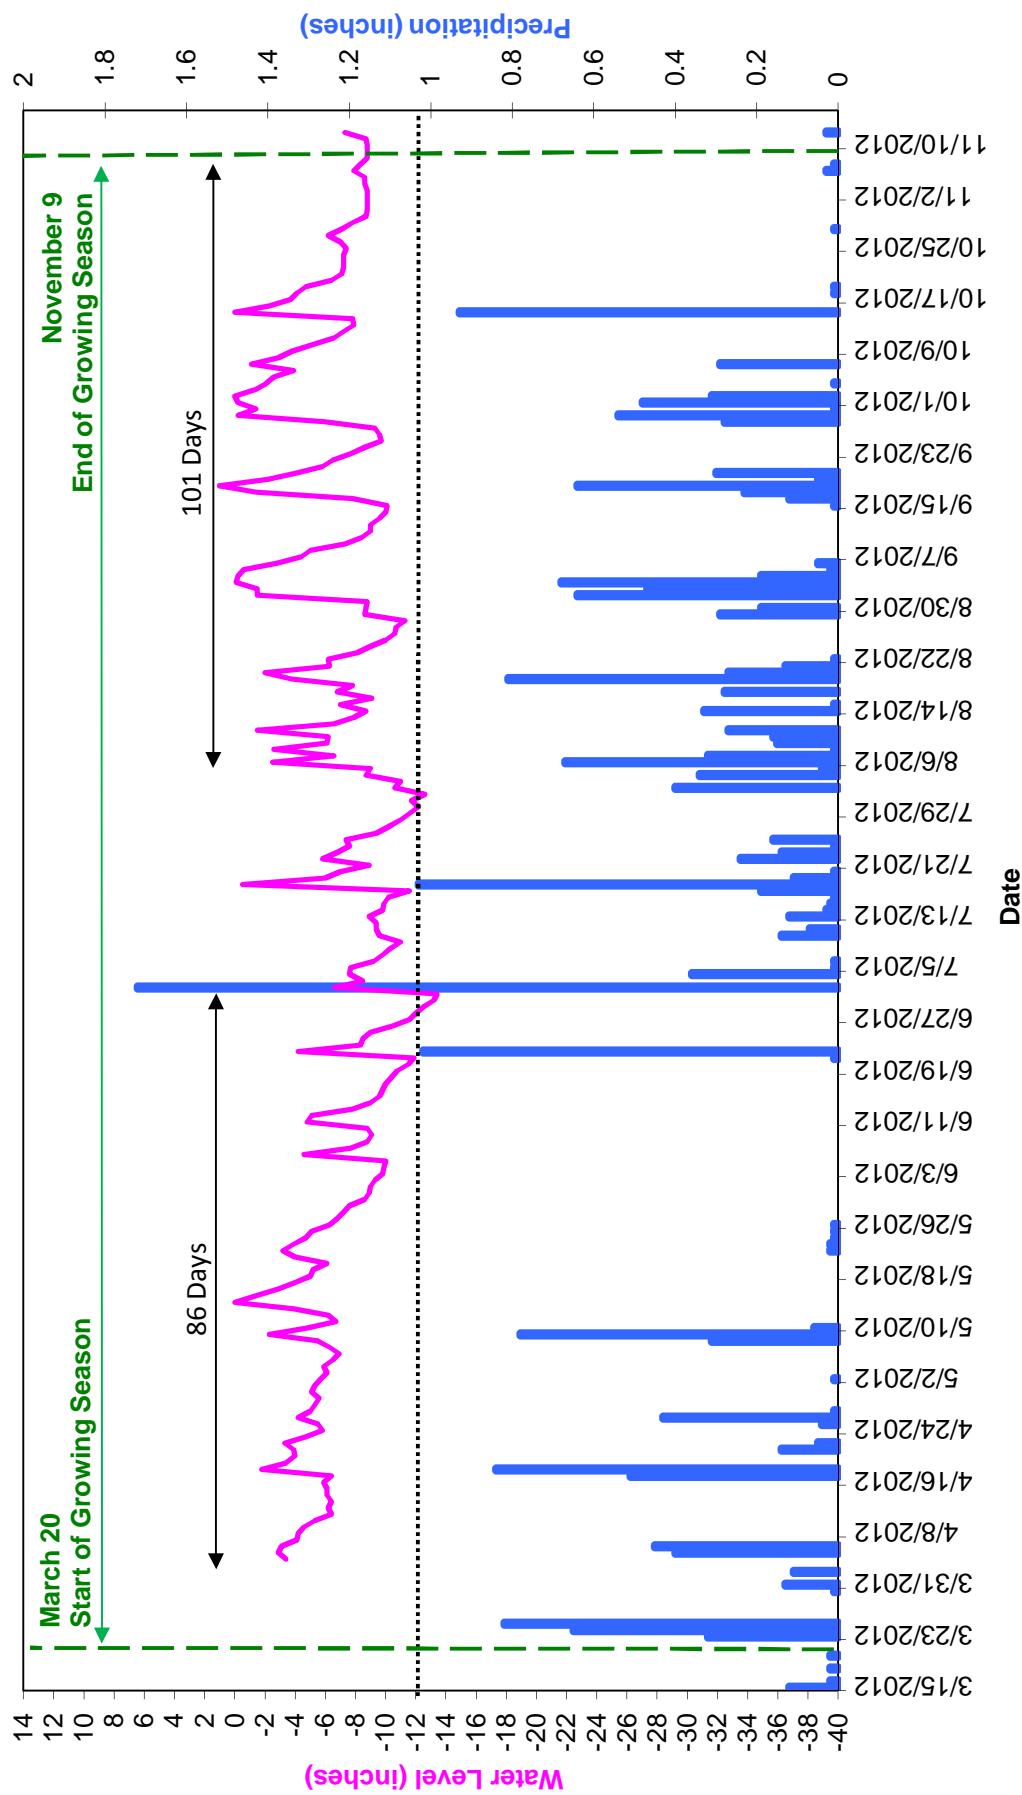


## Herman Dairy Groundwater Gauge 7 Year 1 (2012 Gauge Data)

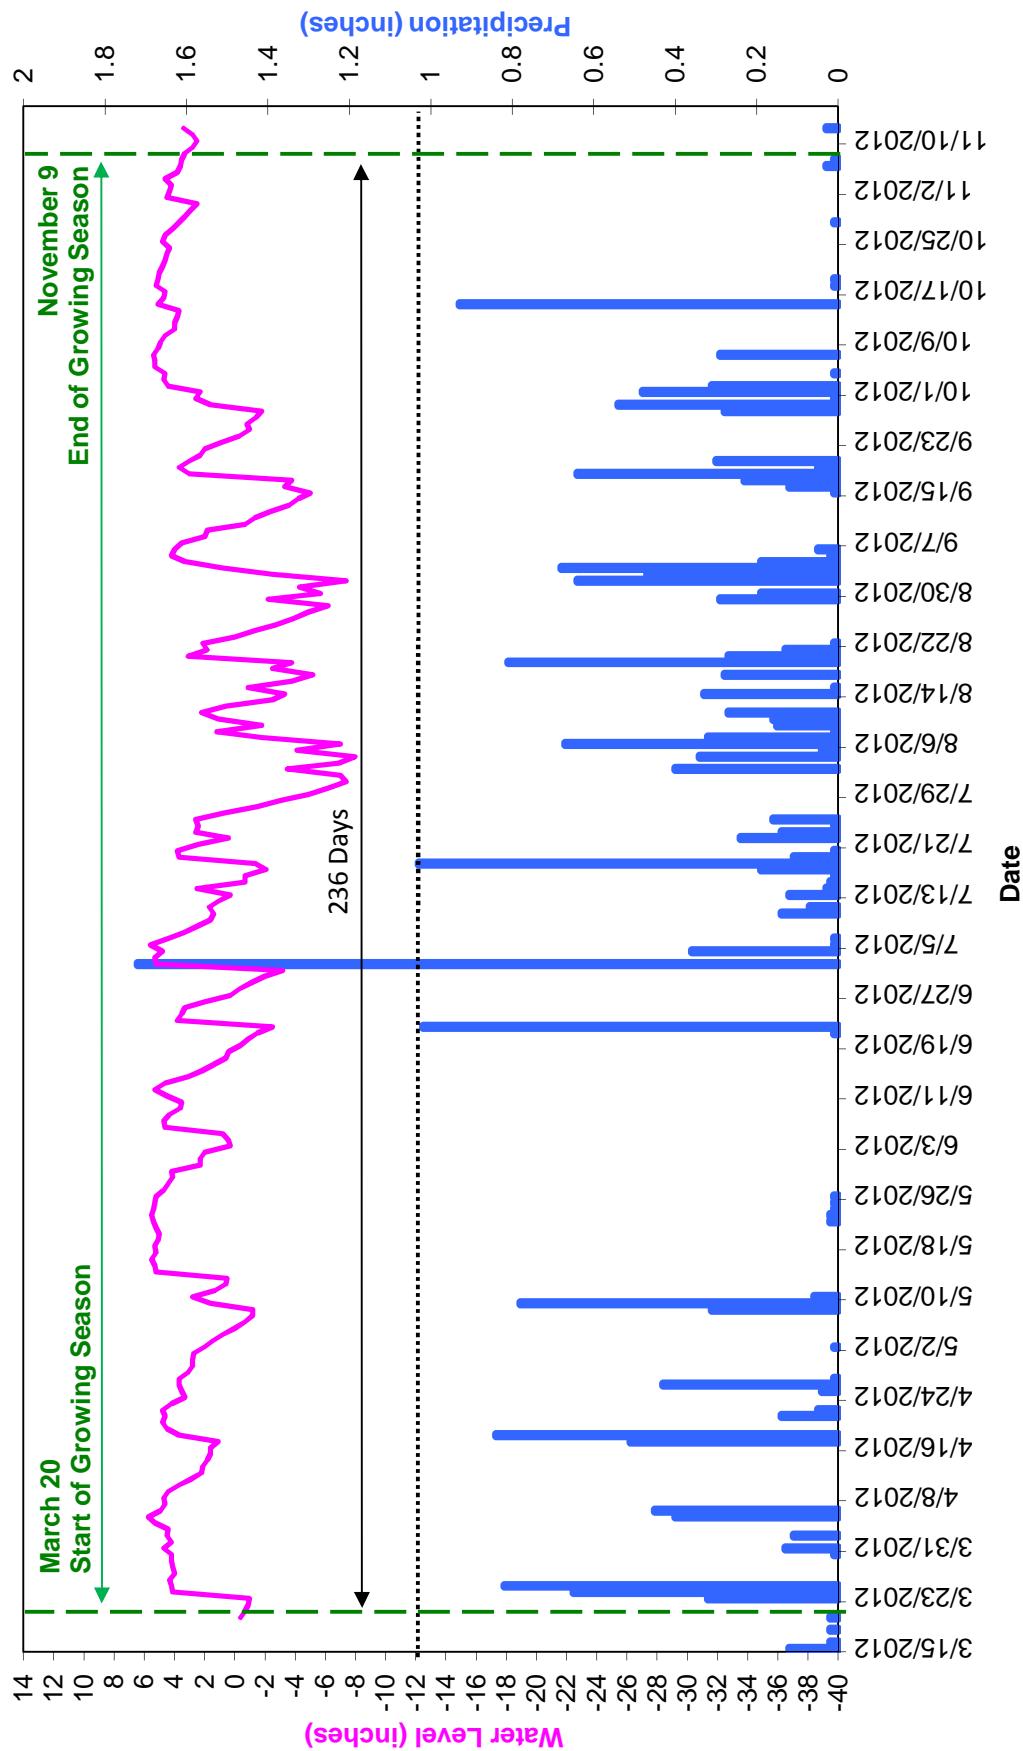


## Herman Dairy Groundwater Gauge 8 Year 1 (2012 Gauge Data)

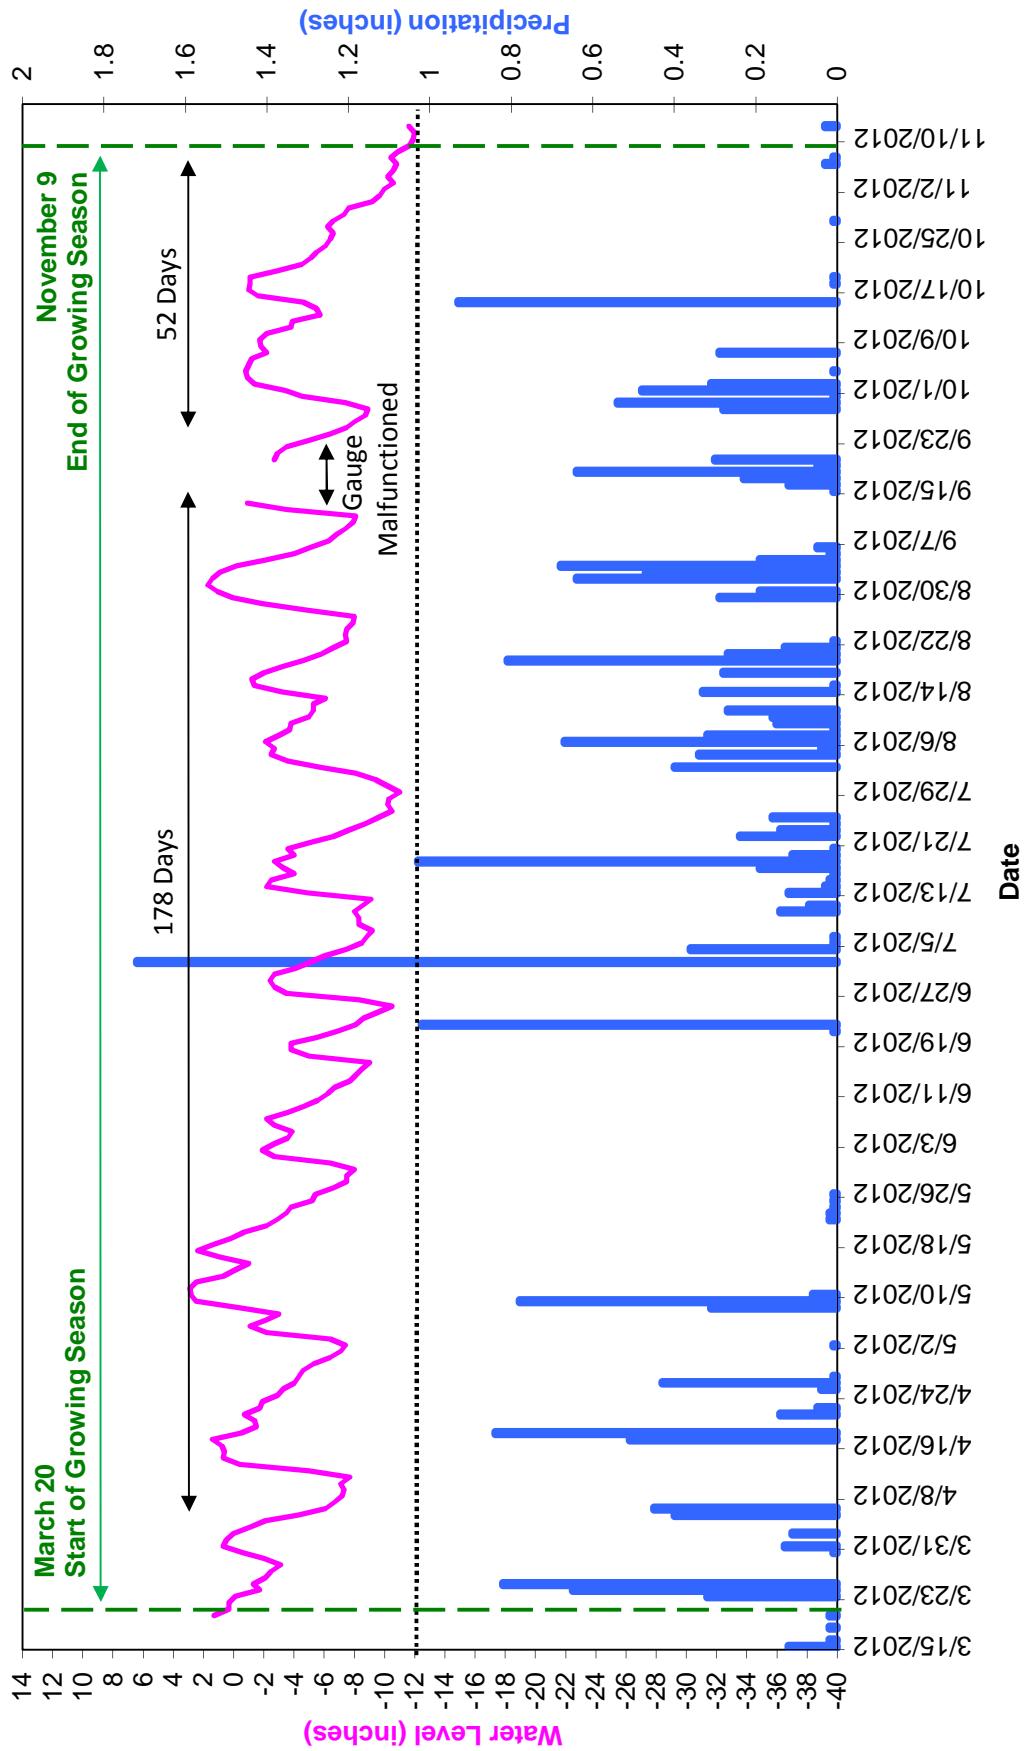


## Herman Dairy Groundwater Gauge 9 Year 1 (2012 Gauge Data)

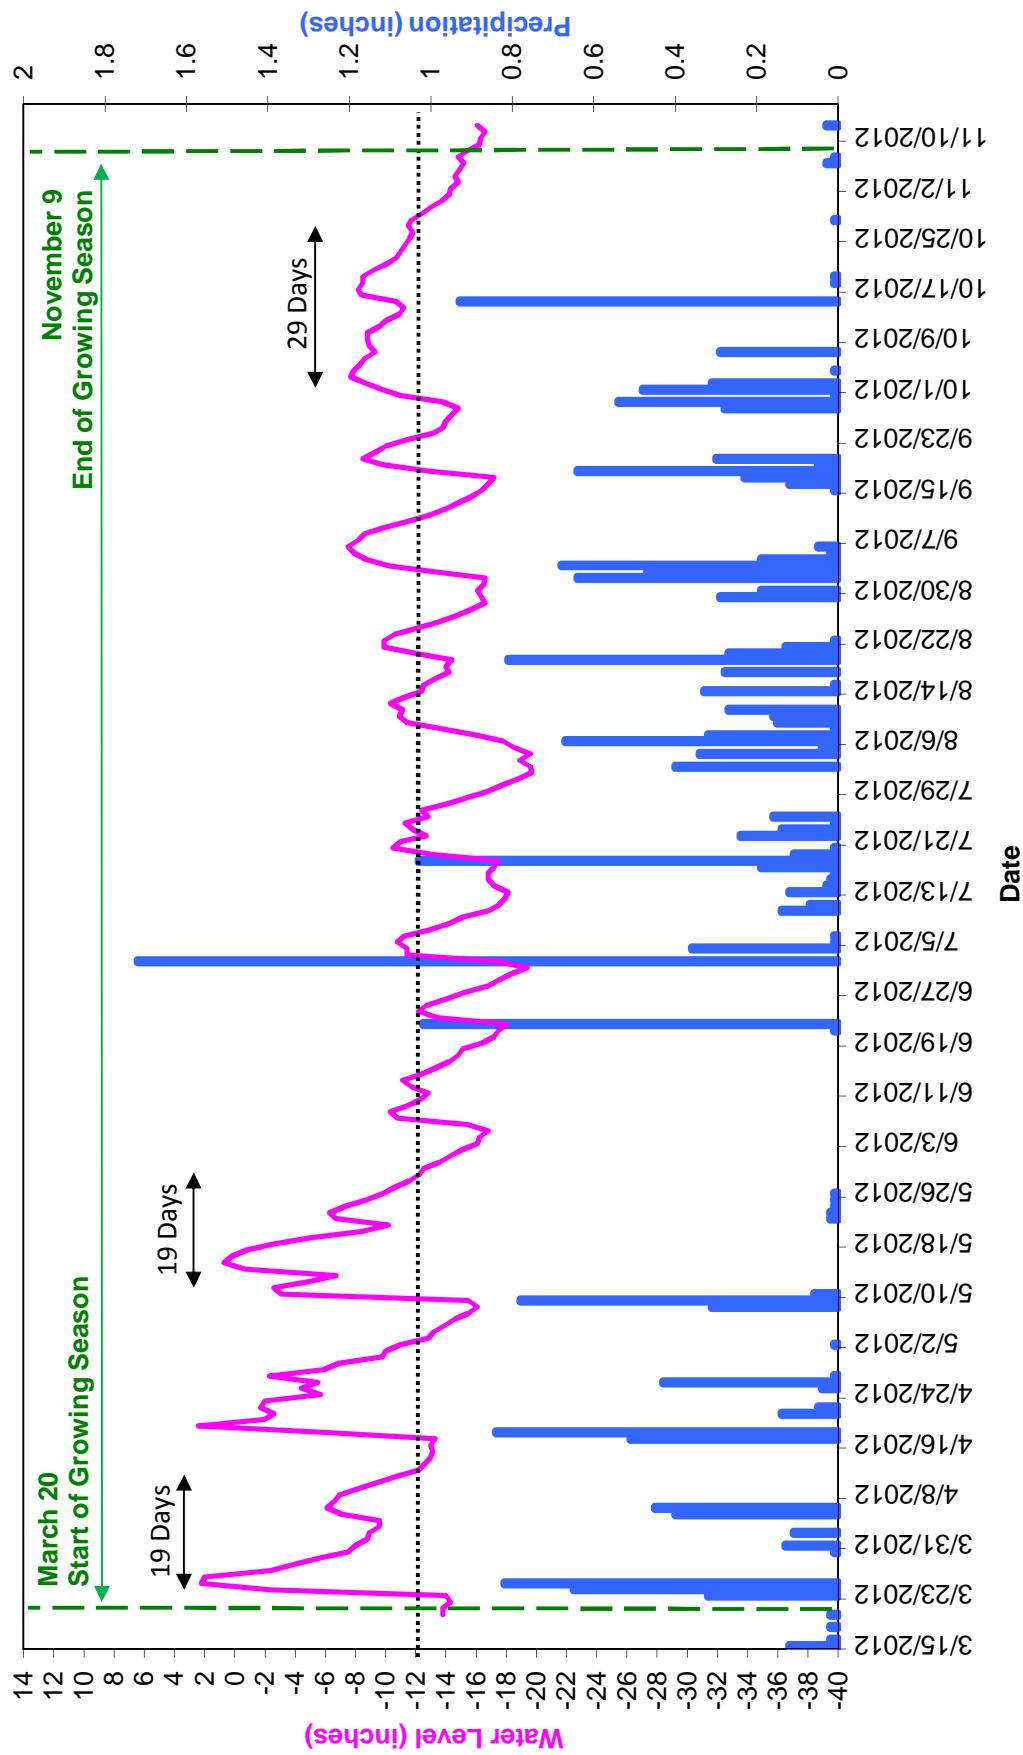

## Herman Dairy Groundwater Gauge 10 Year 1 (2012 Gauge Data)

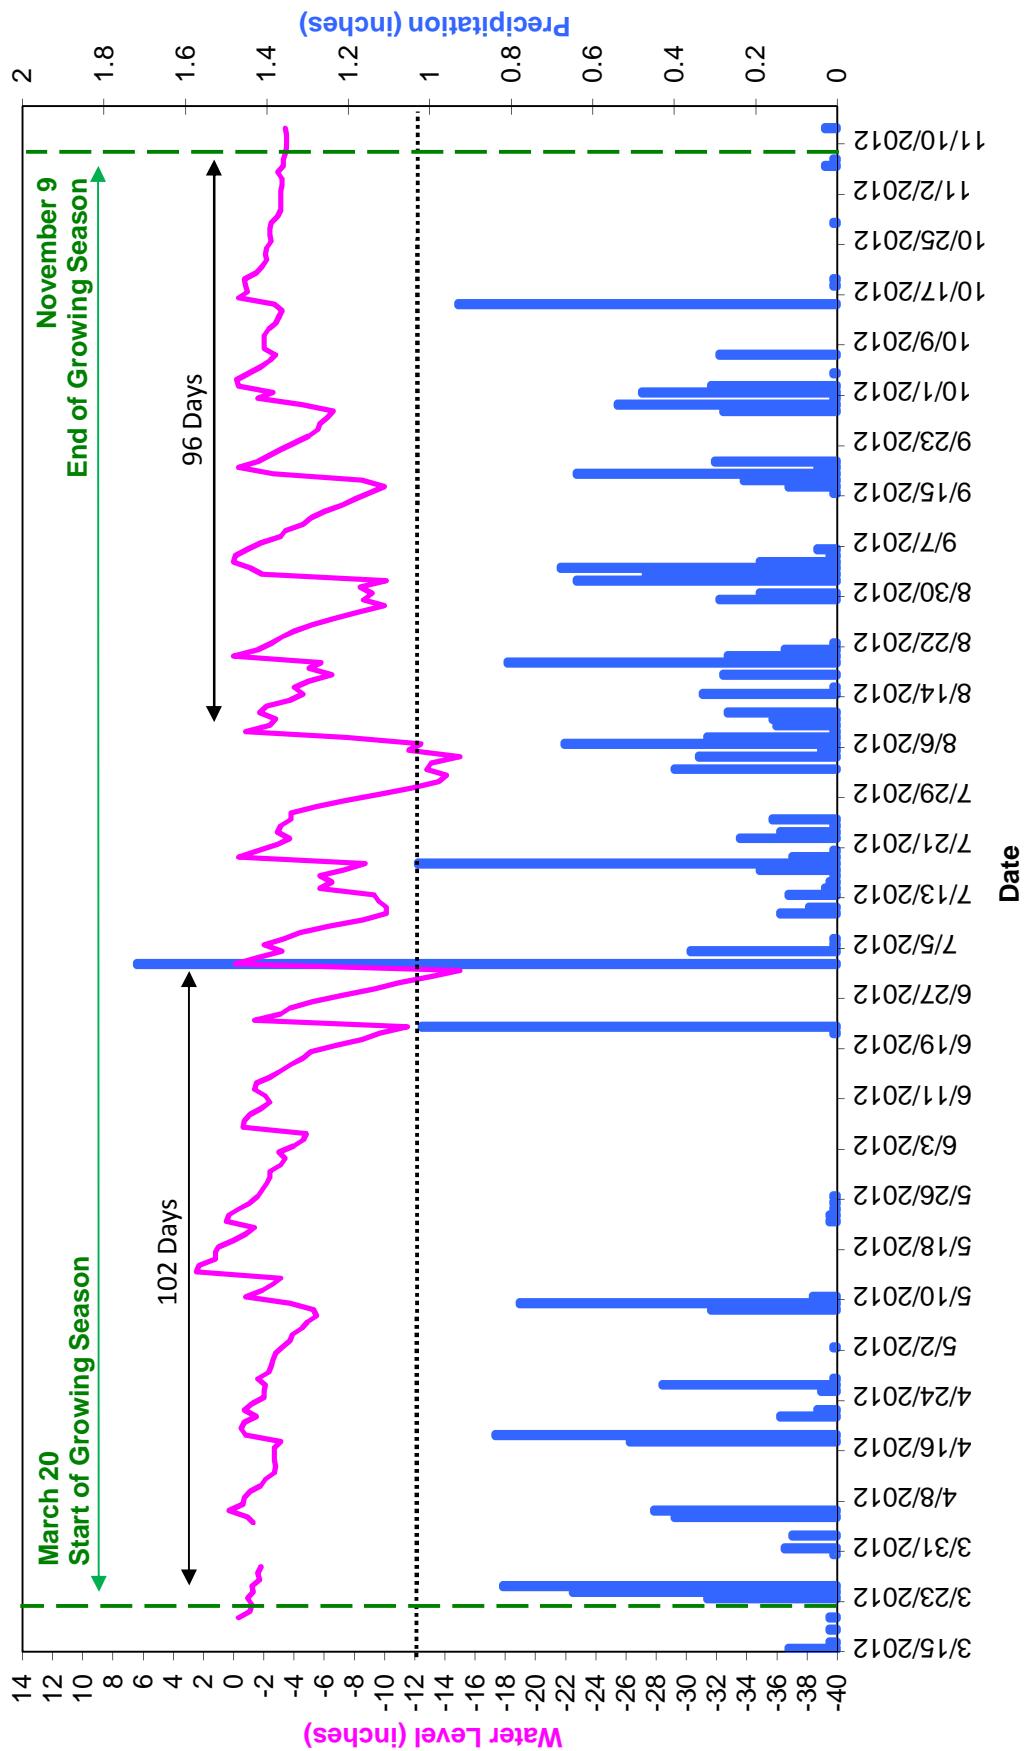

## Herman Dairy Groundwater Reference Gauge Year 1 (2012 Gauge Data)

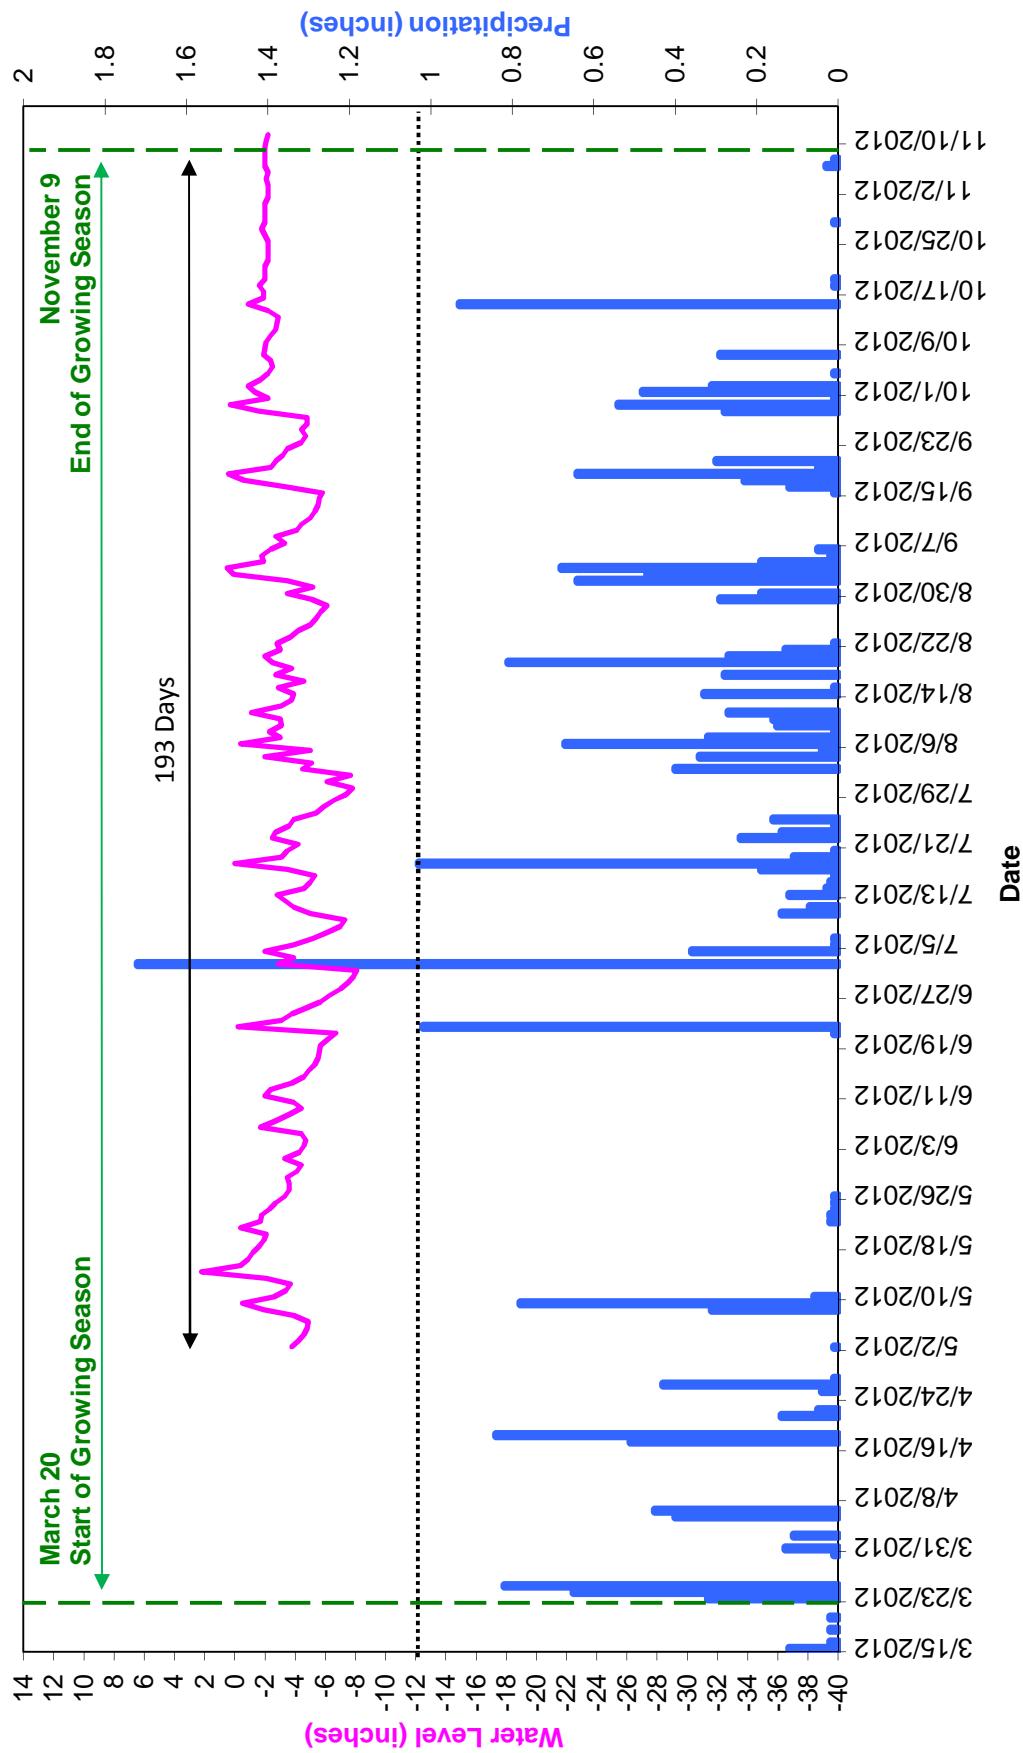


Month	30th %*	70th %*	2012**
Jan	2.77	5.09	
Feb	2.48	4.65	
Mar	3.43	5.85	
Apr	2.02	4.52	
May	3.08	5.31	1.22
June	2.89	5.74	1.03
July	2.41	5.07	4.38
Aug	2.43	4.64	4.68
Sept	1.98	5.17	4.33
Oct	1.69	4.4	2.05
Nov	2.49	4.34	
Dec	2.25	4.34	

Figure E1. Annual Climatic Data vs. 30-year Historic Data


\*Hickory Regional Airport, NC 30-year  
historic data (NOAA 2004)

\*\*Off-site rain gauge

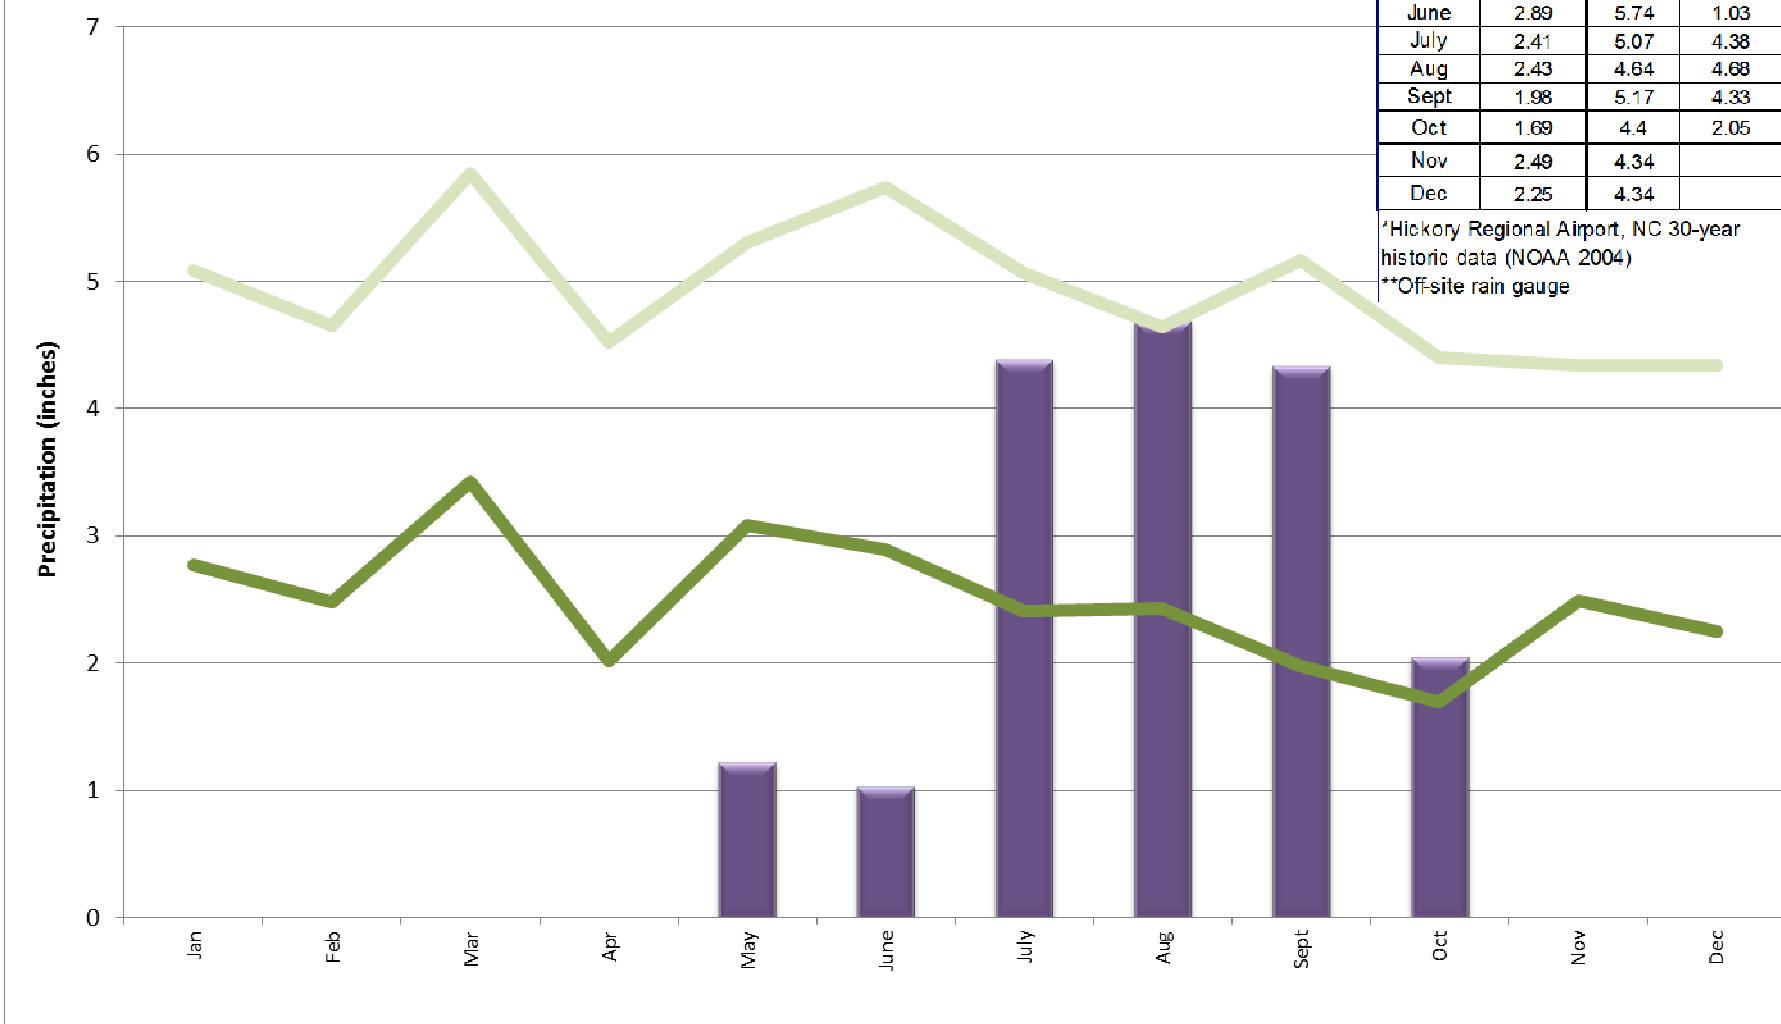

## **Appendix F. Benthic Data**

Figure F1. Post construction Benthic Station Locations  
Habitat Assessment Field Datasheets

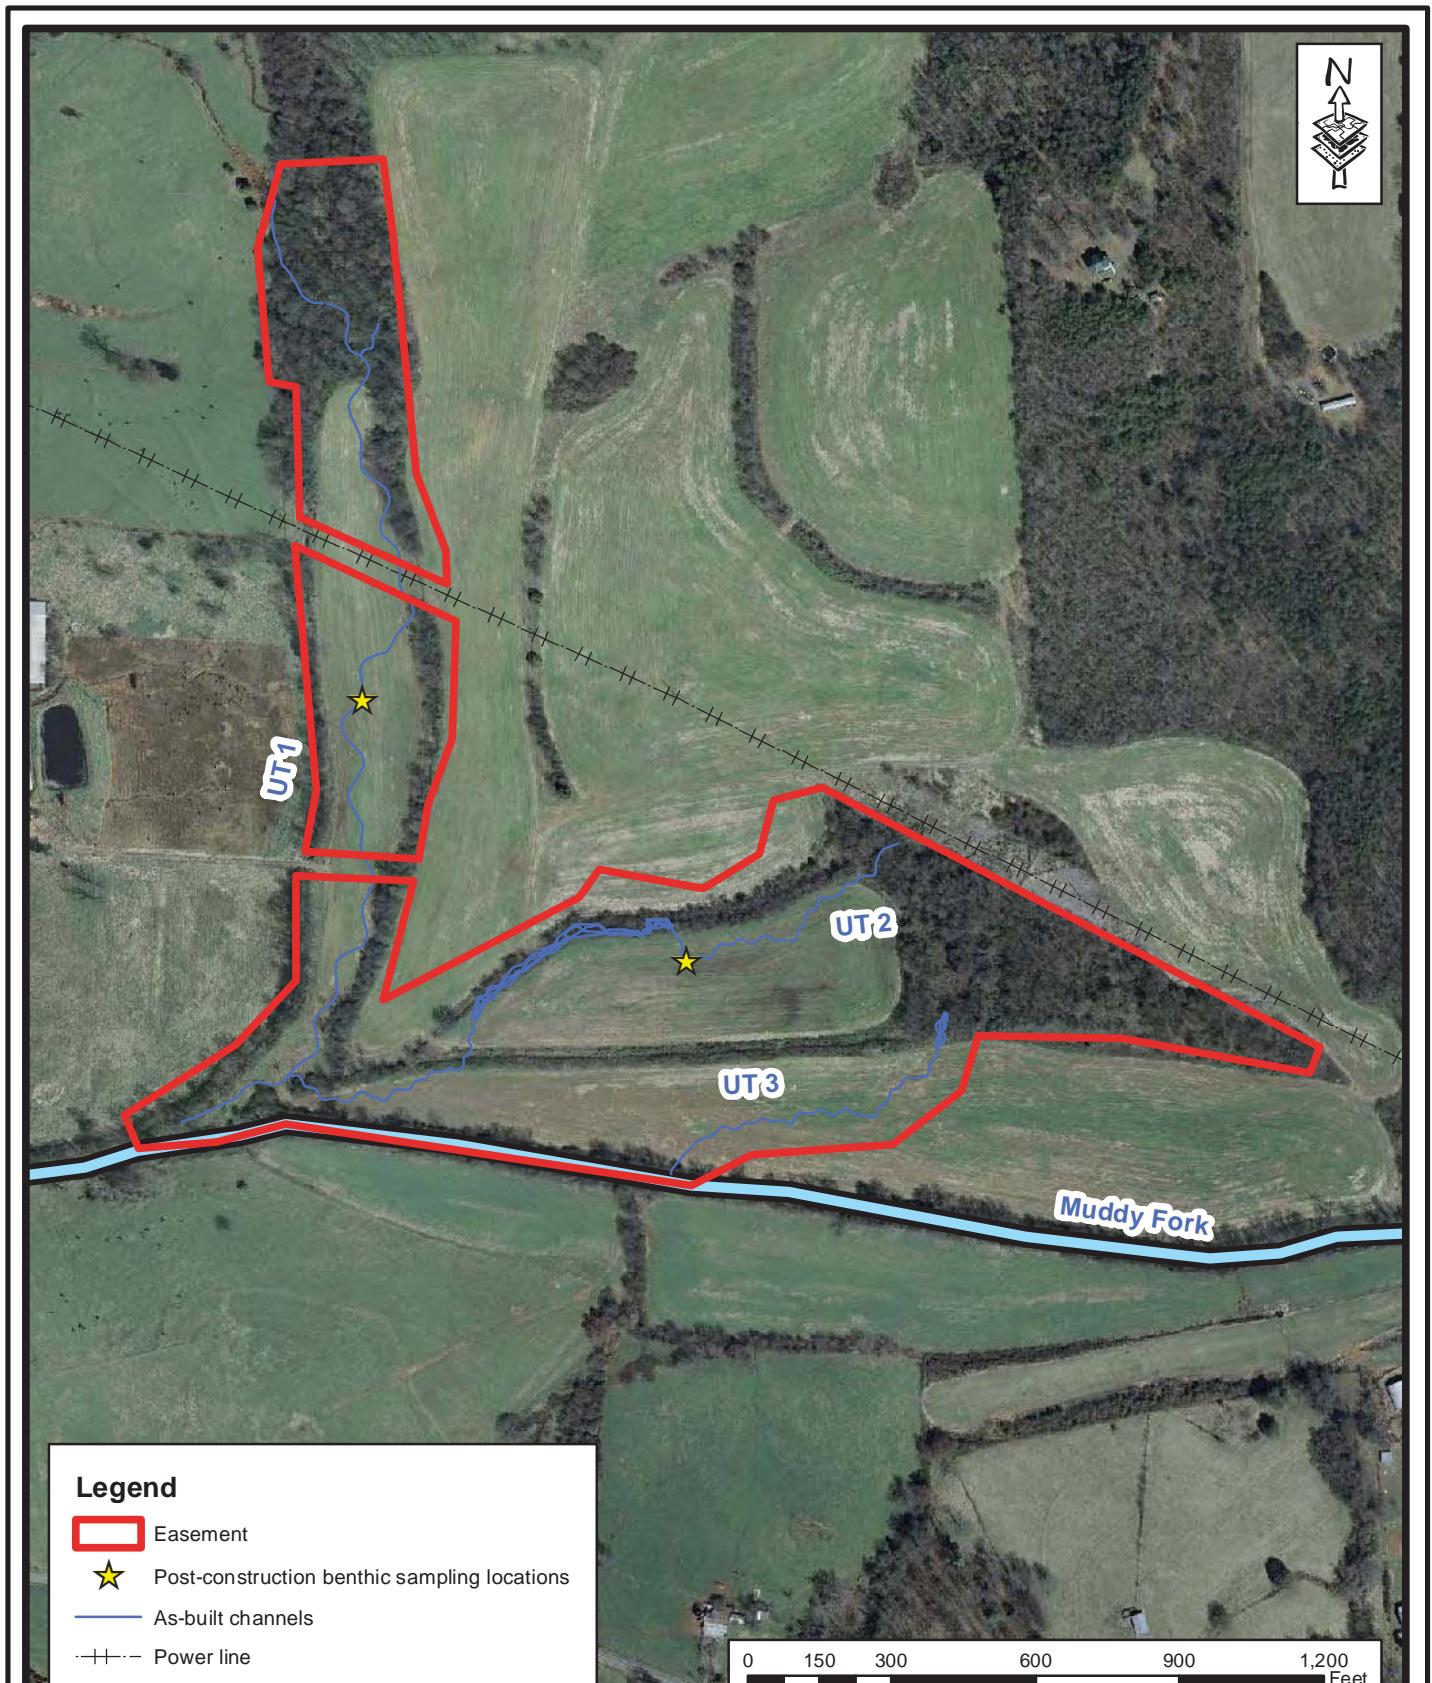

### Legend

- Easement
- Post-construction benthic sampling locations
- As-built channels
- Power line

0 150 300 600 900 1,200  
Feet



HERMAN DAIRY  
STREAM AND WETLAND MITIGATION SITE  
POST-CONSTRUCTION BENTHIC  
LOCATIONS  
Alexander County, North Carolina

Dwn. By:	SGD
Date:	Oct 2012
Project:	10-016

FIGURE  
F1

**Habitat Assessment Field Data Sheet**  
**Mountain/ Piedmont Streams**

UT 1

**TOTAL SCORE 69****Biological Assessment Unit, DWQ**

Directions for use: The observer is to survey a **minimum of 100 meters with 200 meters preferred** of stream, preferably in an **upstream** direction starting above the bridge pool and the road right-of-way. The segment which is assessed should represent average stream conditions. To perform a proper habitat evaluation the observer needs to get into the stream. To complete the form, select the description which best fits the observed habitats and then circle the score. If the observed habitat falls in between two descriptions, select an intermediate score. A final habitat score is determined by adding the results from the different metrics.

Stream UT Muddy Fork Location/road: Church Rd (Road Name) — County Alexander

Date 6/28/12 CC# 03050101120030 Basin Catawba Subbasin 03-08-32

Observer(s) Davis/ Observer Type of Study:  Fish  Benthos  Basinwide  Special Study (Describe) \_\_\_\_\_

Latitude 35.9316 Longitude -81.2069 Ecoregion:  MT  P  Slate Belt  Triassic Basin

Water Quality: Temperature — °C DO — mg/l Conductivity (corr.) — μS/cm pH —

**Physical Characterization:** **Visible land use refers to immediate area that you can see from sampling location - include what you estimate driving thru the watershed in watershed land use.**

Visible Land Use: %Forest %Residential 42 %Active Pasture 43 %Active Crops  
%Fallow Fields %Commercial %Industrial 10 %Other - Describe: Recently planted  
5% riparian buffer

Watershed land use:  Forest  Agriculture  Urban  Animal operations upstream

Width: (meters) Stream 4 Channel (at top of bank) 5 Stream Depth: (m) Avg 0.75 Max 1.0  
 Width variable  Large river >25m wide

Bank Height (from deepest part of riffle to top of bank-first flat surface you stand on): (ft) 0.75-1

Bank Angle: 45 ° or  NA (Vertical is 90°, horizontal is 0°. Angles > 90° indicate slope is towards mid-channel, < 90° indicate slope is away from channel. NA if bank is too low for bank angle to matter.)

Channelized Ditch

Deeply incised-steep, straight banks  Both banks undercut at bend  Channel filled in with sediment  
 Recent overbank deposits  Bar development  Buried structures  Exposed bedrock

Excessive periphyton growth  Heavy filamentous algae growth  Green tinge  Sewage smell

Manmade Stabilization:  N  Y:  Rip-rap, cement, gabions  Sediment/grade-control structure  Berm/levee

Flow conditions:  High  Normal  Low

Turbidity:  Clear  Slightly Turbid  Turbid  Tannic  Milky  Colored (from dyes)

Good potential for Wetlands Restoration Project??  YES  NO Details \_\_\_\_\_

**Channel Flow Status**

Useful especially under abnormal or low flow conditions.

A. Water reaches base of both lower banks, minimal channel substrate exposed .....

B. Water fills >75% of available channel, or <25% of channel substrate is exposed.....

C. Water fills 25-75% of available channel, many logs/snags exposed.....

D. Root mats out of water.....

E. Very little water in channel, mostly present as standing pools.....

Weather Conditions: hot, dry, 90° Photos:  N  Y  Digital  35mm

Remarks: Site is in 1st year of post-construction monitoring.

**I. Channel Modification**

	Score
A. channel natural, frequent bends.....	(5)
B. channel natural, infrequent bends (channelization could be old).....	4
C. some channelization present.....	3
D. more extensive channelization, >40% of stream disrupted.....	2
E. no bends, completely channelized or rip rapped or gabioned, etc.....	0
<input type="checkbox"/> Evidence of dredging <input type="checkbox"/> Evidence of desnagging= no large woody debris in stream <input type="checkbox"/> Banks of uniform shape/height	
Remarks _____	<u>Subtotal</u> <u>5</u>

**II. Instream Habitat:** Consider the percentage of the reach that is favorable for benthos colonization or fish cover. If >70% of the reach is rocks, 1 type is present, circle the score of 17. Definition: leafpacks consist of older leaves that are packed together and have begun to decay (not piles of leaves in pool areas). Mark as Rare, Common, or Abundant.

C Rocks    M Macrophytes    R Sticks and leafpacks    A Snags and logs    U Undercut banks or root mats

**AMOUNT OF REACH FAVORABLE FOR COLONIZATION OR COVER**

	>70%	40-70%	20-40%	<20%
	Score	Score	Score	Score
4 or 5 types present.....	20	16	12	(8)
3 types present.....	19	15	11	7
2 types present.....	18	14	10	6
1 type present.....	17	13	9	5
No types present.....	0			
<input type="checkbox"/> No woody vegetation in riparian zone				Subtotal <u>0</u>
Remarks _____				

**III. Bottom Substrate (silt, sand, detritus, gravel, cobble, boulder)** Look at entire reach for substrate scoring, but only look at riffle for embeddedness, and use rocks from all parts of riffle-look for "mud line" or difficulty extracting rocks.

	Score
<b>A. substrate with good mix of gravel, cobble and boulders</b>	
1. embeddedness <20% (very little sand, usually only behind large boulders).....	15
2. embeddedness 20-40%.....	12
3. embeddedness 40-80%.....	8
4. embeddedness >80%.....	3
<b>B. substrate gravel and cobble</b>	
1. embeddedness <20%.....	14
2. embeddedness 20-40%.....	11
3. embeddedness 40-80%.....	(6)
4. embeddedness >80%.....	2
<b>C. substrate mostly gravel</b>	
1. embeddedness <50%.....	8
2. embeddedness >50%.....	4
<b>D. substrate homogeneous</b>	
1. substrate nearly all bedrock.....	3
2. substrate nearly all sand .....	3
3. substrate nearly all detritus.....	2
4. substrate nearly all silt/ clay.....	1
Remarks _____	Subtotal <u>6</u>

**IV. Pool Variety** Pools are areas of deeper than average maximum depths with little or no surface turbulence. Water velocities associated with pools are always slow. Pools may take the form of "pocket water", small pools behind boulders or obstructions, in large high gradient streams, or side eddies.

	Score
<b>A. Pools present</b>	
1. Pools Frequent (>30% of 200m area surveyed)	
a. variety of pool sizes.....	(10)
b. pools about the same size (indicates pools filling in).....	8
2. Pools Infrequent (<30% of the 200m area surveyed)	
a. variety of pool sizes.....	6
b. pools about the same size.....	4
<b>B. Pools absent.....</b>	0
	Subtotal <u>10</u>

Pool bottom boulder-cobble=hard     Bottom sandy-sink as you walk     Silt bottom     Some pools over wader depth

Remarks \_\_\_\_\_

Page Total 29

**V. Riffle Habitats**

Definition: Riffle is area of reaeration-can be debris dam, or narrow channel area.	Riffles Frequent	Riffles Infrequent
	Score	Score
A. well defined riffle and run, riffle as wide as stream and extends 2X width of stream....	16	12
B. riffle as wide as stream but riffle length is not 2X stream width .....	14	7
C. riffle not as wide as stream and riffle length is not 2X stream width .....	10	3
<b>D. riffles absent.....</b>	0	

Channel Slope: Typical for area Steep=fast flow Low=like a coastal streamSubtotal 14**VI. Bank Stability and Vegetation**

FACE UPSTREAM	Left Bank Score	Rt. Bank Score
<b>A. Banks stable</b>		
1. little evidence of erosion or bank failure(except outside of bends), little potential for erosion..	7	7
<b>B. Erosion areas present</b>		
1. diverse trees, shrubs, grass; plants healthy with good root systems.....	6	6
2. few trees or small trees and shrubs; vegetation appears generally healthy.....	5	5
3. sparse mixed vegetation; plant types and conditions suggest poorer soil binding.....	3	3
4. mostly grasses, few if any trees and shrubs, high erosion and failure potential at high flow..	2	2
5. little or no bank vegetation, mass erosion and bank failure evident.....	0	0

Total 14

Remarks \_\_\_\_\_

**VII. Light Penetration** Canopy is defined as tree or vegetative cover directly above the stream's surface. Canopy would block out sunlight when the sun is directly overhead. Note shading from mountains, but not use to score this metric.

	Score
A. Stream with <b>good</b> canopy with some breaks for light penetration .....	10
B. Stream with <b>full</b> canopy - breaks for light penetration absent.....	8
C. Stream with <b>partial</b> canopy - sunlight and shading are essentially equal.....	7
D. Stream with <b>minimal</b> canopy - full sun in all but a few areas.....	2
E. <b>No canopy</b> and no shading.....	0

Remarks Just planted this winter; young seedlings. Subtotal 0**VIII. Riparian Vegetative Zone Width**

Definition: Riparian zone for this form is area of natural vegetation adjacent to stream (can go beyond floodplain). Definition: A break in the riparian zone is any place on the stream banks which allows sediment or pollutants to directly enter the stream, such as paths down to stream, storm drains, uprooted trees, otter slides, etc.

FACE UPSTREAM	Lft. Bank Score	Rt. Bank Score
Dominant vegetation: <input type="checkbox"/> Trees <input checked="" type="checkbox"/> Shrubs <input type="checkbox"/> Grasses <input checked="" type="checkbox"/> Weeds/old field <input type="checkbox"/> Exotics (kudzu, etc)		
<b>A. Riparian zone intact (no breaks)</b>		
1. width > 18 meters.....	5	5
2. width 12-18 meters.....	4	4
3. width 6-12 meters.....	3	3
4. width < 6 meters.....	2	2
<b>B. Riparian zone not intact (breaks)</b>		
1. breaks rare		
a. width > 18 meters.....	4	4
b. width 12-18 meters.....	3	3
c. width 6-12 meters.....	2	2
d. width < 6 meters.....	1	1
2. breaks common		
a. width > 18 meters.....	3	3
b. width 12-18 meters.....	2	2
c. width 6-12 meters.....	1	1
d. width < 6 meters.....	0	0


Total 10

Remarks \_\_\_\_\_


 Disclaimer-form filled out, but score doesn't match subjective opinion-atypical stream.Page Total 40TOTAL SCORE 109

## Supplement for Habitat Assessment Field Data Sheet

Diagram to determine bank angle:

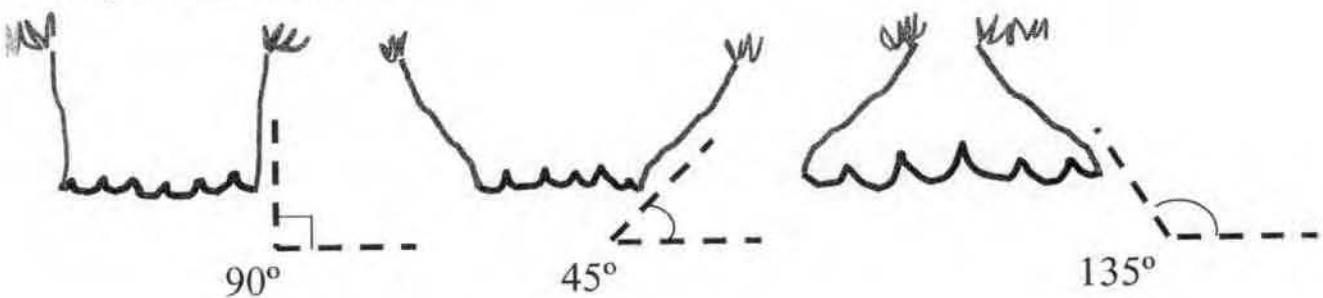

Typical Stream Cross-section

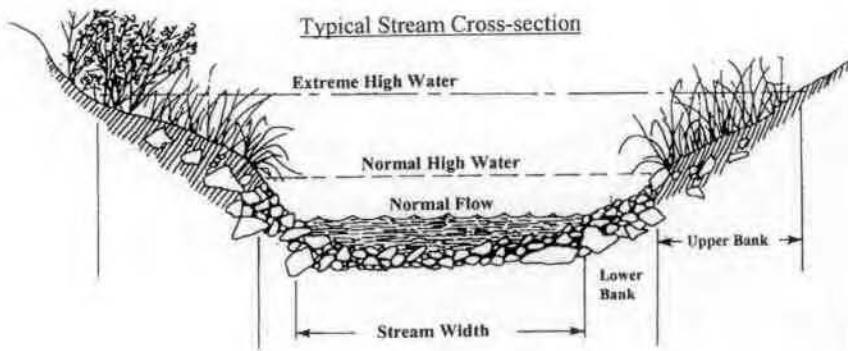

This side is 45° bank angle.

Site Sketch:

Other comments:

multiple frogs, salamanders, tadpoles.

**Habitat Assessment Field Data Sheet**  
**Mountain/ Piedmont Streams**

UT2

**TOTAL SCORE 72****Biological Assessment Unit, DWQ**

Directions for use: The observer is to survey a minimum of 100 meters with 200 meters preferred of stream, preferably in an upstream direction starting above the bridge pool and the road right-of-way. The segment which is assessed should represent average stream conditions. To perform a proper habitat evaluation the observer needs to get into the stream. To complete the form, select the description which best fits the observed habitats and then circle the score. If the observed habitat falls in between two descriptions, select an intermediate score. A final habitat score is determined by adding the results from the different metrics.

Stream UT Muddy Fork Location/road: Three Forks Church Rd. (Road Name) \_\_\_\_\_ County Alexander  
 Date 6/28/12 CC# 03050101120030 Basin Catawba Subbasin 03-08-32

Observer(s) Davis/Perkinson Type of Study:  Fish  Benthos  Basinwide  Special Study (Describe) \_\_\_\_\_

Latitude 35.9314 Longitude -81.2049 Ecoregion:  MT  P  State Belt  Triassic Basin

Water Quality: Temperature — °C DO — mg/l Conductivity (corr.) — µS/cm pH —

**Physical Characterization:** Visible land use refers to immediate area that you can see from sampling location - include what you estimate driving thru the watershed in watershed land use.

Visible Land Use: 15 %Forest — %Residential — %Active Pasture 75 % Active Crops  
— %Fallow Fields — % Commercial — %Industrial 10 %Other - Describe: recently planted riparian buffer

Watershed land use:  Forest  Agriculture  Urban  Animal operations upstream

Width: (meters) Stream 2 Channel (at top of bank) 3 Stream Depth: (ft) 0.1-0.2 Avg 0.1-0.2 Max 0.2  
 Width variable  Large river >25m wide

Bank Height (from deepest part of riffle to top of bank-first flat surface you stand on): (m) 0.5

Bank Angle: 45 ° or  NA (Vertical is 90°, horizontal is 0°. Angles > 90° indicate slope is towards mid-channel, < 90° indicate slope is away from channel. NA if bank is too low for bank angle to matter.)

Channelized Ditch  
 Deeply incised-steep, straight banks  Both banks undercut at bend  Channel filled in with sediment  
 Recent overbank deposits  Bar development  Buried structures  Exposed bedrock  
 Excessive periphyton growth  Heavy filamentous algae growth  Green tinge  Sewage smell

Manmade Stabilization:  N  Y:  Rip-rap, cement, gabions  Sediment/grade-control structure  Berm/levee

Flow conditions:  High  Normal  Low

Turbidity:  Clear  Slightly Turbid  Turbid  Tannic  Milky  Colored (from dyes)

Good potential for Wetlands Restoration Project??  YES  NO Details \_\_\_\_\_

**Channel Flow Status**

Useful especially under abnormal or low flow conditions.

- A. Water reaches base of both lower banks, minimal channel substrate exposed .....
- B. Water fills >75% of available channel, or <25% of channel substrate is exposed.....
- C. Water fills 25-75% of available channel, many logs/snags exposed.....
- D. Root mats out of water.....
- E. Very little water in channel, mostly present as standing pools.....

Weather Conditions: hot, dry, 90's Photos:  N  Y  Digital  35mm

Remarks: Site is in 1st year of post-restoration monitoring.

**I. Channel Modification**

	Score
A. channel natural, frequent bends.....	5
B. channel natural, infrequent bends (channelization could be old).....	4
C. some channelization present.....	3
D. more extensive channelization, >40% of stream disrupted.....	2
E. no bends, completely channelized or rip rapped or gabioned, etc.....	0

Evidence of dredging    Evidence of desnagging= no large woody debris in stream    Banks of uniform shape/height  
 Remarks \_\_\_\_\_ Subtotal 5

**II. Instream Habitat:** Consider the percentage of the reach that is favorable for benthos colonization or fish cover. If >70% of the reach is rocks, 1 type is present, circle the score of 17. Definition: leafpacks consist of older leaves that are packed together and have begun to decay (not piles of leaves in pool areas). Mark as Rare, Common, or Abundant.

C Rocks A Macrophytes R Sticks and leafpacks A Snags and logs R Undercut banks or root mats

**AMOUNT OF REACH FAVORABLE FOR COLONIZATION OR COVER**

	>70%	40-70%	20-40%	<20%
	Score	Score	Score	Score
4 or 5 types present.....	20	16	12	8
3 types present.....	19	(15)	11	7
2 types present.....	18	14	10	6
1 type present.....	17	13	9	5
No types present.....	0			

No woody vegetation in riparian zone   Remarks \_\_\_\_\_ Subtotal 15

**III. Bottom Substrate (silt, sand, detritus, gravel, cobble, boulder)** Look at entire reach for substrate scoring, but only look at riffle for embeddedness, and use rocks from all parts of riffle-look for "mud line" or difficulty extracting rocks.

	Score
A. substrate with good mix of gravel, cobble and boulders	
1. embeddedness <20% (very little sand, usually only behind large boulders).....	15
2. embeddedness 20-40%.....	12
3. embeddedness 40-80%.....	8
4. embeddedness >80%.....	3
B. substrate gravel and cobble	
1. embeddedness <20%.....	14
2. embeddedness 20-40%.....	11
3. embeddedness 40-80%.....	(6)
4. embeddedness >80%.....	2
C. substrate mostly gravel	
1. embeddedness <50%.....	8
2. embeddedness >50%.....	4
D. substrate homogeneous	
1. substrate nearly all bedrock.....	3
2. substrate nearly all sand.....	3
3. substrate nearly all detritus.....	2
4. substrate nearly all silt/ clay.....	1

Remarks \_\_\_\_\_ Subtotal 6

**IV. Pool Variety** Pools are areas of deeper than average maximum depths with little or no surface turbulence. Water velocities associated with pools are always slow. Pools may take the form of "pocket water", small pools behind boulders or obstructions, in large high gradient streams, or side eddies.

	Score
A. Pools present	
1. Pools Frequent (>30% of 200m area surveyed)	
a. variety of pool sizes.....	(10)
b. pools about the same size (indicates pools filling in).....	8
2. Pools Infrequent (<30% of the 200m area surveyed)	
a. variety of pool sizes.....	6
b. pools about the same size.....	4
B. Pools absent.....	0

Subtotal 10

Pool bottom boulder-cobble=hard    Bottom sandy-sink as you walk    Silt bottom    Some pools over wader depth

Remarks \_\_\_\_\_ Page Total 34

**V. Riffle Habitats**

Definition: Riffle is area of reaeration-can be debris dam, or narrow channel area.	Riffles Frequent	Riffles Infrequent
	Score	Score
A. well defined riffle and run, riffle as wide as stream and extends 2X width of stream.....	16	(12)
B. riffle as wide as stream but riffle length is not 2X stream width .....	14	7
C. riffle not as wide as stream and riffle length is not 2X stream width .....	10	3
<b>D. riffles absent.....</b>	0	

Channel Slope:  Typical for area  Steep=fast flow  Low=like a coastal streamSubtotal 12**VI. Bank Stability and Vegetation**

FACE UPSTREAM	Left Bank Score	Rt. Bank Score
<b>A. Banks stable</b>		
1. little evidence of erosion or bank failure(except outside of bends), little potential for erosion.....	(7)	(7)
<b>B. Erosion areas present</b>		
1. diverse trees, shrubs, grass; plants healthy with good root systems.....	6	6
2. few trees or small trees and shrubs; vegetation appears generally healthy.....	5	5
3. sparse mixed vegetation; plant types and conditions suggest poorer soil binding.....	3	3
4. mostly grasses, few if any trees and shrubs, high erosion and failure potential at high flow..	2	2
5. little or no bank vegetation, mass erosion and bank failure evident.....	0	0
	Total	<u>14</u>

Remarks \_\_\_\_\_

**VII. Light Penetration** Canopy is defined as tree or vegetative cover directly above the stream's surface. Canopy would block out sunlight when the sun is directly overhead. Note shading from mountains, but not use to score this metric.

	Score
A. Stream with <b>good canopy</b> with some breaks for light penetration .....	10
B. Stream with <b>full canopy</b> - breaks for light penetration absent.....	8
C. Stream with <b>partial canopy</b> - sunlight and shading are essentially equal.....	7
D. Stream with <b>minimal canopy</b> - full sun in all but a few areas.....	2
E. <b>No canopy</b> and no shading.....	(6)

Remarks Recently planted with young seedlings. Subtotal 0**VIII. Riparian Vegetative Zone Width**

Definition: Riparian zone for this form is area of natural vegetation adjacent to stream (can go beyond floodplain). Definition: A break in the riparian zone is any place on the stream banks which allows sediment or pollutants to directly enter the stream, such as paths down to stream, storm drains, uprooted trees, otter slides, etc.



FACE UPSTREAM	Lft. Bank Score	Rt. Bank Score
Dominant vegetation: <input type="checkbox"/> Trees <input checked="" type="checkbox"/> Shrubs <input checked="" type="checkbox"/> Grasses <input checked="" type="checkbox"/> Weeds/old field <input type="checkbox"/> Exotics (kudzu, etc)		
<b>A. Riparian zone intact (no breaks)</b>		
1. width > 18 meters.....	(5)	(5)
2. width 12-18 meters.....	4	4
3. width 6-12 meters.....	3	3
4. width < 6 meters.....	2	2
<b>B. Riparian zone not intact (breaks)</b>		
1. breaks rare		
a. width > 18 meters.....	4	4
b. width 12-18 meters.....	3	3
c. width 6-12 meters.....	2	2
d. width < 6 meters.....	1	1
2. breaks common		
a. width > 18 meters.....	3	3
b. width 12-18 meters.....	2	2
c. width 6-12 meters.....	1	1
d. width < 6 meters.....	0	0
	Total	<u>10</u>

Remarks \_\_\_\_\_

Page Total 34TOTAL SCORE 72 Disclaimer-form filled out, but score doesn't match subjective opinion-atypical stream.

## Supplement for Habitat Assessment Field Data Sheet

Diagram to determine bank angle:

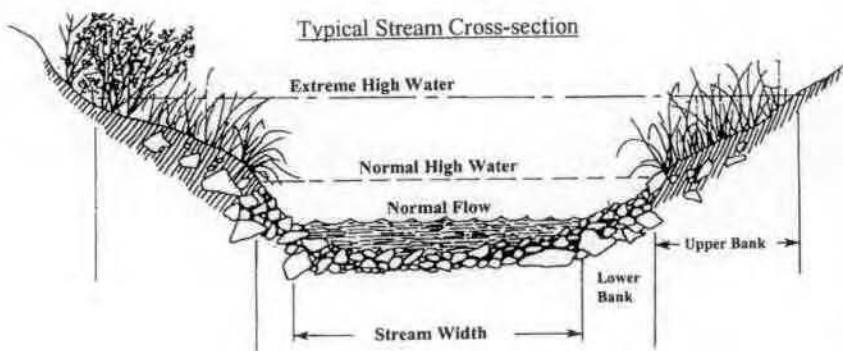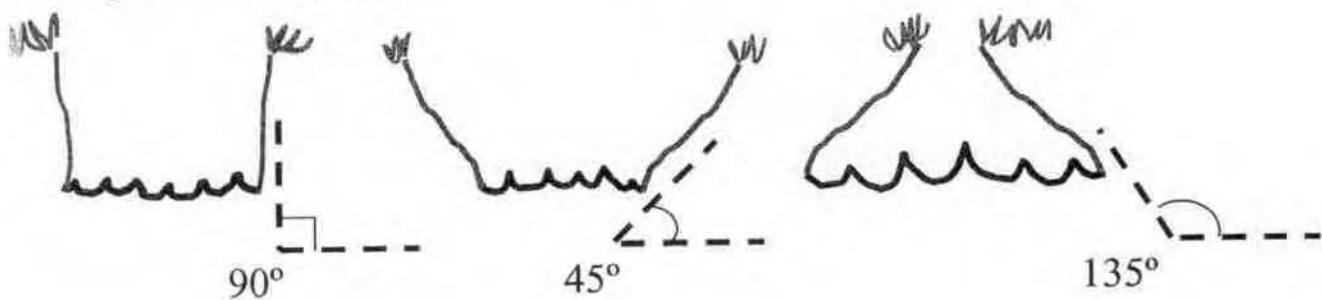

This side is 45° bank angle.

Site Sketch:

Other comments:

Multiple frogs & tadpoles.

**Herman Dairy**  
**Year 1 Profile (2012)**

**Tributary 3**

**Average Water Surface Slope**

NA

Point	Description	Station	Bed Elevation	Water Elevation	Riffle Length	Pool Length	Riffle Slope
3	tr structure	82	99.60643				
4	gl	85.09	99.14768				
5	r	86.58	99.16396				
6	br	88.96	99.68868		27.1	7.0	
7	tr	116.03	99.61981				
8	gl	118.90	99.00211				
9	r	122.39	99.12086				
10	br	125.14	99.63055		13.7	9.1	
11	tr	138.80	99.71201				
12	gl	143.81	98.99396				
13	r	151.86	99.09967				
14	br	158.40	99.60502		13.3	19.6	
31	tr	171.75	99.56886				
32	gl	176.81	98.98937				
33	r	182.12	99.05873				
34	br	185.44	99.53456		12.0	13.7	
35	tr	197.40	99.41204				
36	gl	199.75	99.03574				
37	r	204.76	98.78868				
38	br	209.12	99.61027		6.1	11.7	
39	tr	215.25	99.61475				
40	gl	218.73	98.9984				
41	r	223.88	99.07643				
42	br	227.83	99.70605		7.0	12.6	
43	tr	234.86	99.81036				
44	gl	239.39	99.14756				
45	r	246.10	99.23519				
46	br	248.99	99.71146		8.6	14.1	
47	tr	257.54	99.80705				
48	gl	260.52	99.0788				
49	r	264.09	99.16883				
50	br	268.24	99.8462		6.9	10.7	
51	tr	275.14	99.84858				
52	p	279.19	99.23515				
53	br	282.44	99.77872		8.0	7.3	
54	tr	290.47	99.74185				
55	gl	297.33	99.17284				
56	p	302.20	99.08933				
57	r	308.26	99.21192				
58	br	314.11	99.89287		10.7	23.6	
59	tr	324.83	99.75984				
60	gl	328.48	99.20494				
61	r	335.65	99.33486				
62	br	342.14	99.86091		14.8	17.3	
63	tr	356.97	99.67441				
64	p	361.08	99.18057				
65	br	365.37	99.89562		6.7	8.4	
66	tr	372.12	99.80793				
67	gl	376.50	99.17751				
68	p	381.63	99.16793				
69	r	384.96	99.18051				
70	br	389.86	99.99439		8.3	17.7	

71	tr	398.21	99.9194			
72	gl	402.83	99.53157			
87	r	414.61	99.47699			
88	br	419.40	100.0406	12.0	21.2	
89	tr	431.38	100.0305			
90	gl	436.99	99.35207			
91	r	441.27	99.4084			
92	br	446.19	100.0191	12.4	14.8	
93	tr	458.60	100.0423			
94	p	464.02	99.40542			
95	br	468.38	99.98652	6.6	9.8	
96	tr	475.03	99.98543			
97	gl	478.48	99.44599			
98	r	483.61	99.41471			
99	br	486.33	99.95104	7.9	11.3	
100	tr	494.21	99.97183			
101	gl	496.93	99.30021			
117	r	508.66	99.41739			
118	br	514.18	100.0006	7.1	20.0	
119	tr	521.27	100.1405			
120	gl	524.22	99.5669			
121	r	528.50	99.57733			
122	br	532.69	100.0928	10.1	11.4	
123	tr	542.82	100.1392			
124	gl	545.85	99.6234			
125	r	549.75	99.61901			
126	br	553.27	100.1971	9.6	10.5	
127	tr	562.90	100.2529			
128	gl	568.38	99.62612			
129	r	574.37	99.62264			
130	br	578.06	100.1408	6.2	15.2	
131	tr	584.24	100.1812			
132	gl	587.31	99.40846			
133	r	593.79	99.5259			
134	br	596.98	100.0943	6.8	12.7	
135	tr	603.79	100.1211			
136	gl	607.90	99.34593	99.81509		
138	r	615.22	99.31616	99.82848		
140	br	618.92	99.89949	7.8	15.1	
141	tr	626.74	100.1916			
142	p	630.13	99.43265	99.81272		
144	br	634.25	100.2394	17.9	7.5	
157	tr	652.18	100.3119			
158	gl	657.64	99.68881			
159	r	668.71	99.85003			
160	br	672.17	100.3335	5.1	20.0	
161	tr	677.30	100.455			
162	gl	682.24	99.91877			
163	r	687.18	99.89439			
164	br	689.69	100.2286	10.6	12.4	
165	tr	700.33	100.3461			
166	gl	704.52	99.79428			
167	r	711.11	99.7219			
168	br	715.80	100.3339	11.1	15.5	
169	tr	726.95	100.3206			
				<b>ave</b>	<b>10.2</b>	<b>13.7</b>
				<b>med</b>	<b>8.6</b>	<b>12.7</b>
				<b>min</b>	<b>5.1</b>	<b>7.0</b>
				<b>max</b>	<b>27.1</b>	<b>23.6</b>
				<b>count</b>	<b>27</b>	<b>27</b>
				<b>sd</b>	<b>4.6</b>	<b>4.5</b>