

Little Beaver Creek (EEP #221) Stream and Wetland Restoration Site

2010 Annual Monitoring Report (Year 3)

**Wake County
EEP Project No. 221
Design Firm: Earthtech
Construction Completed 2005**



May 2010

Prepared for:



**NCDENR/ Ecosystem Enhancement Program
1619 Mail Service Center
Raleigh, NC 27699-1619**

Prepared by:



**The Catena Group
410-B Millstone Dr.
Hillsborough, NC 27278**

and



**Ward Consulting Engineers
8368 Six Forks Road, Suite 104
Raleigh, North Carolina 27615-5083**

TABLE OF CONTENTS

I.	Executive Summary	1
II.	Methodology	2
A.	Vegetation Methodologies	3
B.	Stream Methodologies.....	3
C.	Wetland Methodologies	3
III.	References.....	3

APPENDICES

Appendix A.	General Figures and Plan View.....	4
Appendix B.	General Project Tables	13
Appendix C.	Vegetation Assessment Data	18
Appendix D.	Stream Assessment Data	27
Appendix E.	Wetland Assessment.....	54

I. Executive Summary

The Little Beaver Creek stream and wetland restoration project consists of 3712 linear feet of stream restoration, 1,913 linear feet of stream preservation, and 2.4 acres of wetland restoration. Little Beaver Creek is located in Wake County southwest of Apex, North Carolina at the end of Olive Farm Road (SR 1178). Construction of the site was conducted between July 2005 and November 2005. The goals and objectives for the Little Beaver Creek (EEP #221) stream and wetland restoration are:

- | Goals | Objectives |
|--|--|
| <ul style="list-style-type: none">• Improve water quality and reduce erosion• Improve aquatic habitat• Re-establish connectivity of the stream with its floodplain• Restore characteristic natural plant communities/wildlife habitat and hydrologic regime to disturbed wetlands | <ul style="list-style-type: none">• Implementation of stream stabilization techniques• Improve aquatic habitat through the implementation of natural structures such as rootwads, rock vanes, woody debris, and the planting of a riparian buffer• Provide aesthetic value, wildlife habitat, and bank stability through the creation or enhancement of a riparian zone with plantings• Provide a stable stream channel that neither aggrades or degrades while maintaining its dimension, pattern, and profile, with the capacity to transport |

Eight vegetation monitoring plots (2, 5, 7, 8, 9, 10, 11, and 14) were monitored for MY3. Of these eight, 38% of the plots (VP 5, 7, & 11) are meeting the vegetation success criteria. Including all eight monitoring plots, there are 5139 stems/acre including natural and planted stems. The success criterion for planted woody species is 320 stems/acre after MY-03. A mortality rate of ten percent will be allowed after MY-04 (288 stems/acre), with another ten percent allowed after MY-05 (260 stems/acre). Currently the vegetation criteria are being met with 379 planted stems/acre. Bare banks, benches, and floodplains as well as invasive exotics are the only notable vegetation problem areas for MY-03. Invasive exotics within the conservation easement include tall fescue (*Schedonurus arundinaceus*), Gill over the ground (*Glechoma hederacea*), Japanese honeysuckle (*Lonicera japonica*), Japanese stiltgrass (*Microstegium vimineum*), multiflora rose (*Rosa multiflora*), and Chinese privet (*Ligustrum sinense*). Although these species have been given different ranks of severity, the functionality of the project is not expected to be impaired significantly. It is likely that all of these species were present in and adjacent to the conservation easement previous to construction. The fescue appears to be inhibiting some growth of planted stems and there is little evidence of natural succession in these fescue dominated areas (Figure 2). For additional information relating to vegetation, see Appendix C.

The project is divided into three separate reaches (Reach 1, Reach 2, and Reach 3) for the purposes of the design. Reach 1 and 2 consist of Priority 1 and 2 stream restoration. Priority 1 restoration involves the re-establishment of the bankfull stage at the historical floodplain elevation. Priority 2 involves the creation of a new floodplain and stream pattern with the streambed remaining at the present elevation. In order to accomplish this type of restoration, a combination of bedform transformation, channel dimension adjustments, pattern alterations, and the structure installation was performed. Natural meander patterns were restored and grade control rock vanes and rootwads were incorporated for aquatic habitat enhancement and bed and bank stability. Tributaries were restored using Priority 1 restoration. Due to bedrock constraints,

the restoration of Reach 3 below the road crossing was abandoned. This portion of Reach 3 (i.e. Reach 3b) is preserved within the permanent conservation easement.

The upper portion of Little Beaver Creek, Reach 1 (station 10+00-19+90), remains in stable condition with some isolated minor bank erosion. From station 19+90 to 23+50, the project continues to be stable. The state of the stream, however, begins to degrade significantly at station 23+50 and continues through station 38+00. The stream's vertical profile is not significantly different from the previous monitoring year through this stream segment, however worsening bank erosion is evident. The failing structures throughout this steep gradient stream length continue to adversely impact the stream banks located adjacent to and directly below the structures. The structural failures have produced significant increases in the stream cross sectional area through accelerated bank erosion caused by increased shear stresses. Little Beaver Creek below station 38+00 to the culvert at the end of the restored reach is stable and well vegetated. Two tributaries located on the project site tie into the north bank of Little Beaver Creek. Tributary 1 is exhibiting some isolated bank stability issues, with the most significant occurring just downstream of a long and steep riffle at the head of the restoration reach. Tributary 2 is very stable with vegetation that has established throughout the channel bed and banks.

Currently there are eight RDS groundwater gauges (2, 3, 4, 5, 6, 7, 8, & 9) within the conservation easement. By recommendation from EEP, these gauges were installed on June 25, 2008 to replace an older set of gauges. In January of 2010, four gauges (2, 3, 4, and 5) were relocated upstream to more appropriate locations. At this time, a complete growing season's data set has not been collected but gauge 3 has already met hydrological requirements. Five of the eight groundwater gauges (Gauge 3, 6, 7, 8, and 9) are meeting hydrological requirements. Gauges 6-9 are located in the proposed wetland restoration areas of Reach 1, and Gauge 3 is located in Reach 2 in an unmapped wetland within the conservation easement approximately 0.2 acre in size. Additional features included in this report that were not previously mapped include two ponds totaling 0.16 acres in size, and two ditches (Figure 2). Two bankfull events have been recorded to date. One was recorded as a result of Tropical Storm Hannah passing over the area on September 6, 2008 which created a rain event of greater than four inches in Apex. The flooding eroded many areas which were already noted as stream problem areas in the monitoring report for year one, two, and three. The other bankfull event was recorded from evidence of overbank flooding (i.e. wrack lines) in September 2008.

Summary information/data related to the occurrences of items such as beaver or encroachment, and statistics related to performance of various project and monitoring elements, can be found in the tables and figures in the report appendices. Narrative background and supporting information formerly found in these reports can be found in the mitigation plan and restoration plan documents available on EEPs website. All raw data supporting the tables and figures in the appendices is available from EEP upon request.

II. Methodology

Methodologies follow the current EEP monitoring report template (Version 1.2-11/16/06) and guidelines (Lee et al 2006). Photos were taken with a digital camera. A Trimble Geo XT handheld unit with sub-meter accuracy was used to collect groundwater gauge locations, vegetation monitoring plot origins, and problem area locations. Cross sectional and longitudinal surveys were conducted using total station survey equipment. Data was entered into Microstation to obtain dimensions of the cross sections and parameters applicable to the longitudinal profile. Reports were then generated to display summaries of the stream survey.

A. Vegetation Methodologies

Eight representative vegetation monitoring plots were chosen out of the original fifteen plots established in Reach 1, 2 and 3 during the as built survey data collection. Level II of the EEP/CVS protocol Version 4.0 was used to collect data for monitoring year two. Data collected for these plots are in Appendix A.

B. Stream Methodologies

Stream profile and cross-sections were surveyed using total station equipment and methods. The survey data was plotted using AutoCAD Civil3D. The longitudinal profile was generated using the design baseline alignment provided by Earth Tech. This was determined to be the alignment that was used for the mitigation plan and MY-01 monitoring report. Cross sectional data was extracted based on a linear alignment between the end pins of MY-02 alignment. Dimensional data was generated using in-house designed spreadsheets based on the Rosgen dimension criteria and equations. The pattern parameter values remained the same as MY-02 as there was not any significant lateral migration of the stream centerline.

C. Wetland Methodologies


Eight RDS groundwater monitoring gauges (2, 3, 4, 5, 6, 7, 8, & 9) were downloaded monthly to ensure proper function throughout the growing season. Gauges 2, 3, 4, and 5 were relocated to more appropriate locations upstream on January 15, 2010. Data was exported into Excel spreadsheet along with incorporation of local rainfall data provided by the NC State Climate Office (Appendix C).

III. References

Lee, Michael T. Peet, Robert K. Roberts, Steven D., Wentworth, Thomas R. (2008). *CVS-EEP Protocol for Recording Vegetation Version 4.2*.

Weakley, Alan (2007). *Flora of the Carolinas, Virginia, Georgia, and Surrounding Areas*.
<http://www.herbarium.unc.edu/flora.htm>.

Appendix A. General Figures and Plan View

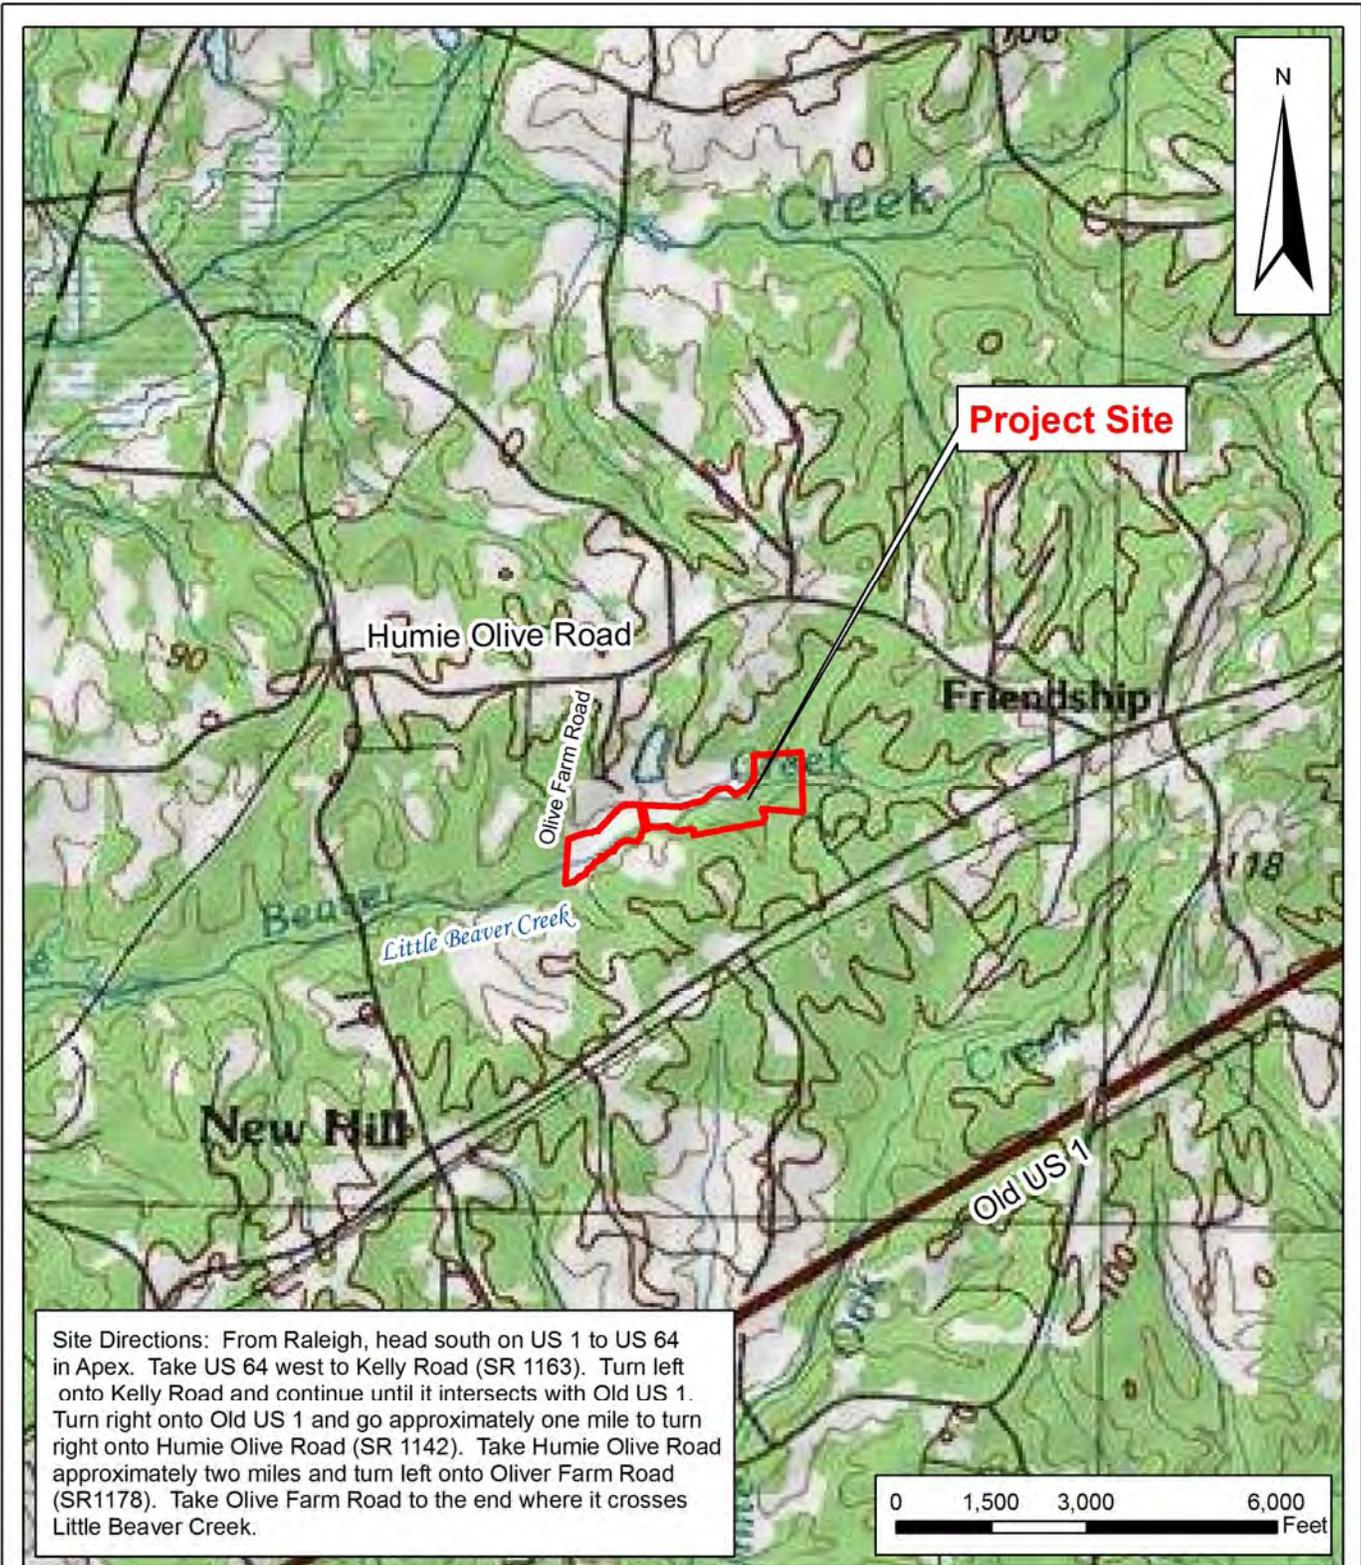

**Little Beaver Creek
Stream and Wetland Restoration Site
Site Location Map**

Wake County, North Carolina

USGS 7.5-Minute Topographic Quadrangle Map
(Newhill, NC)


EEP Project No. 221


Date:
May 2010





Figure
1


Figure 2A-E. Consolidated Current Conditions Plan View

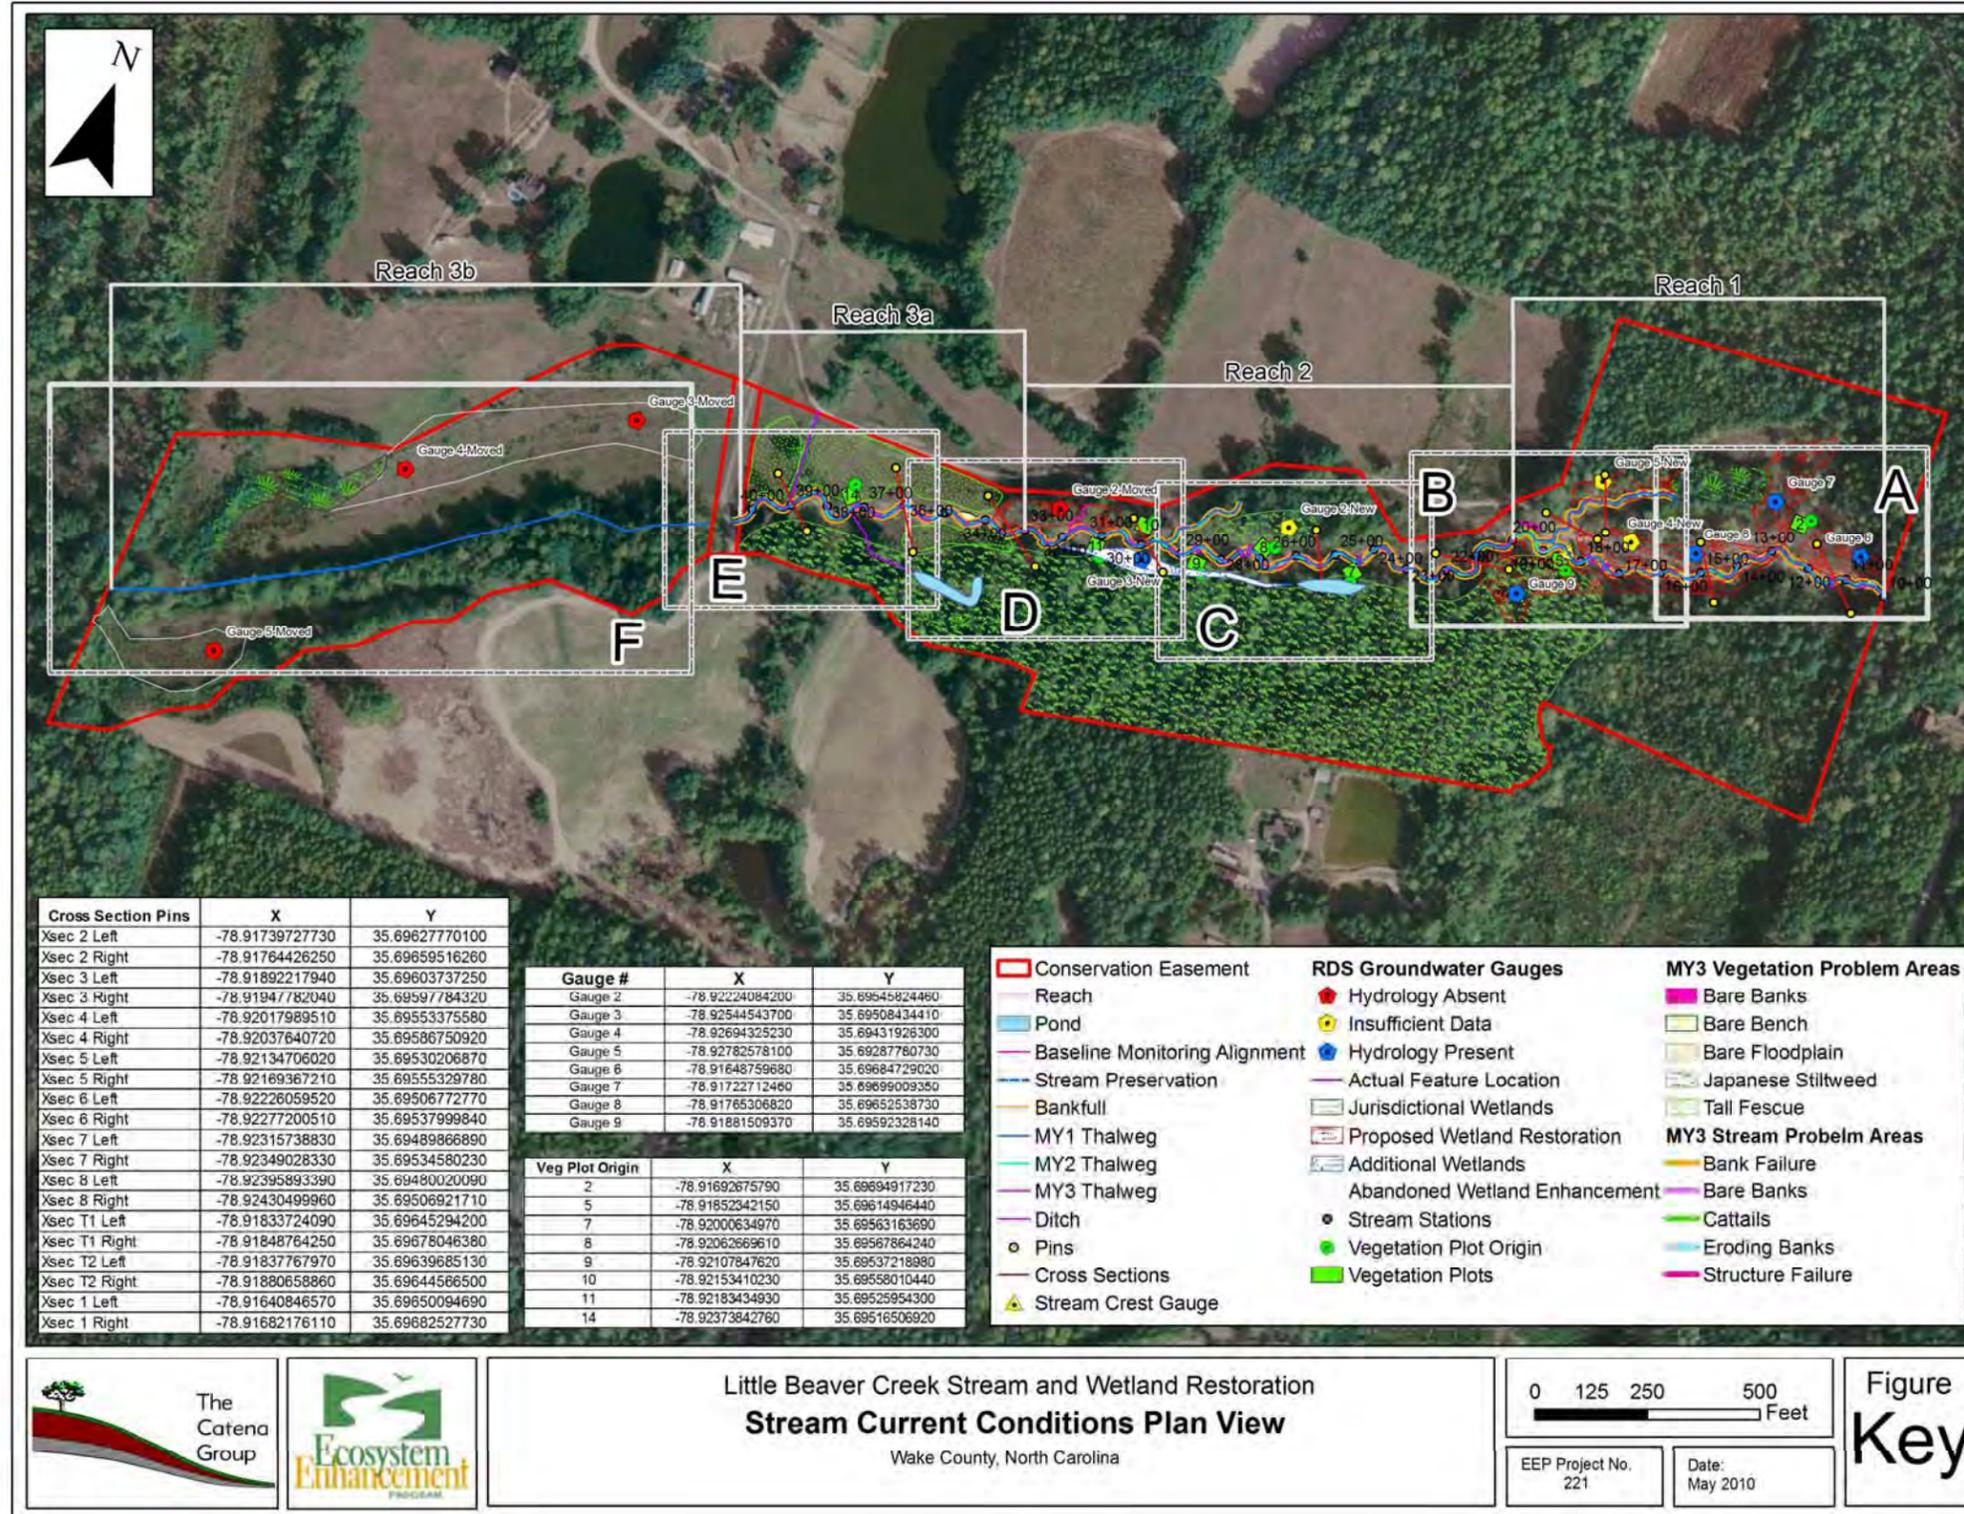



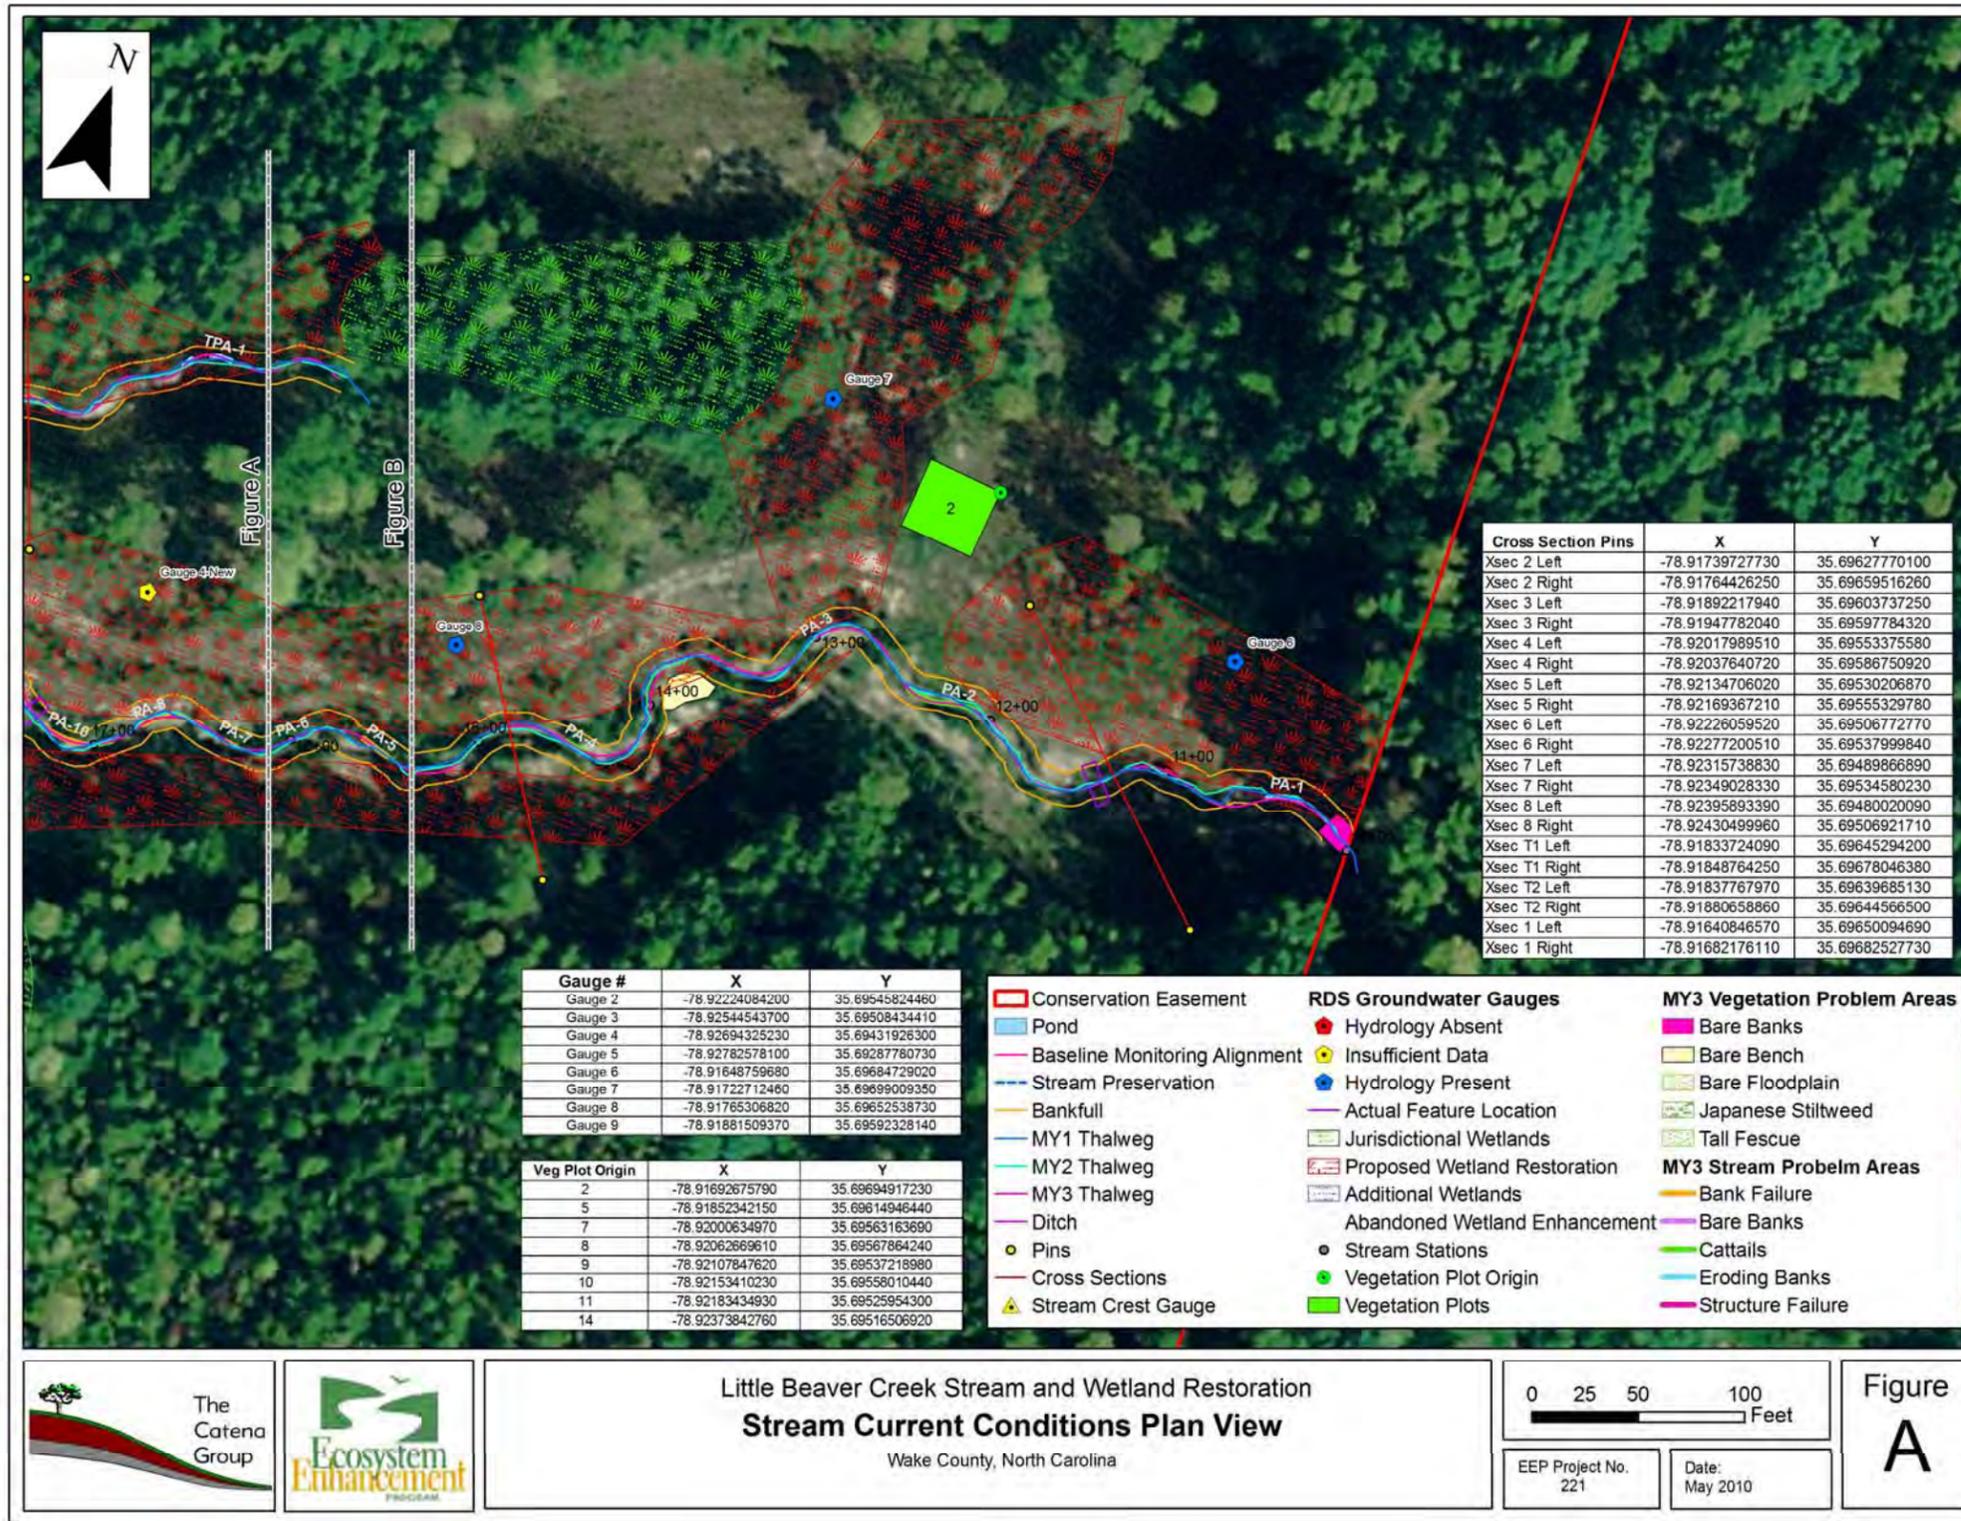


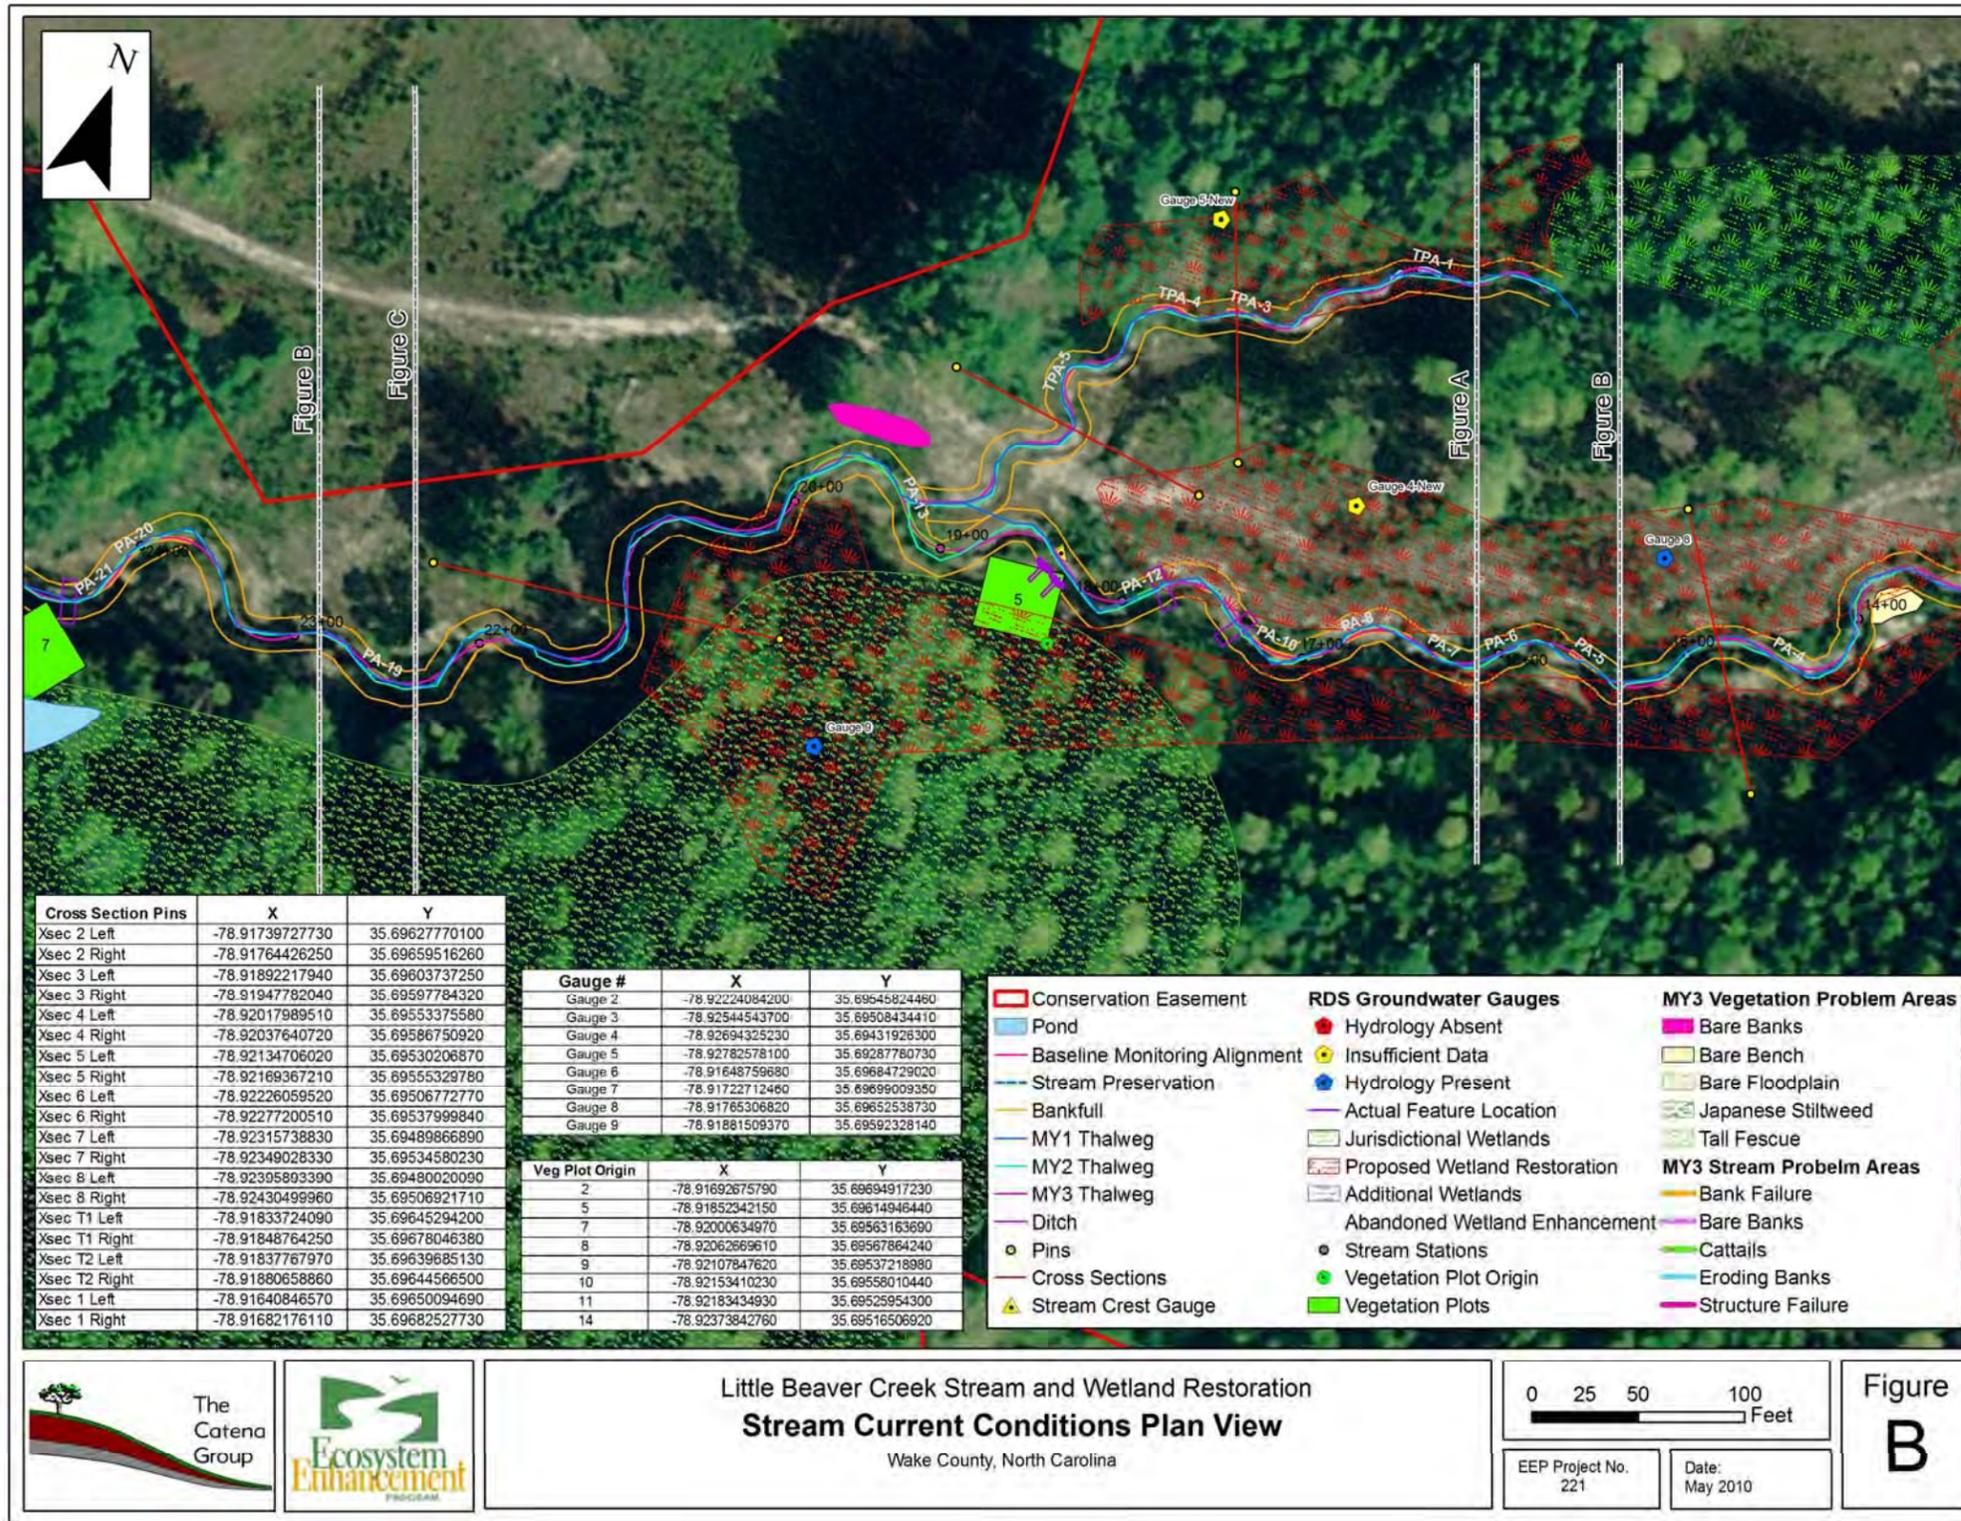

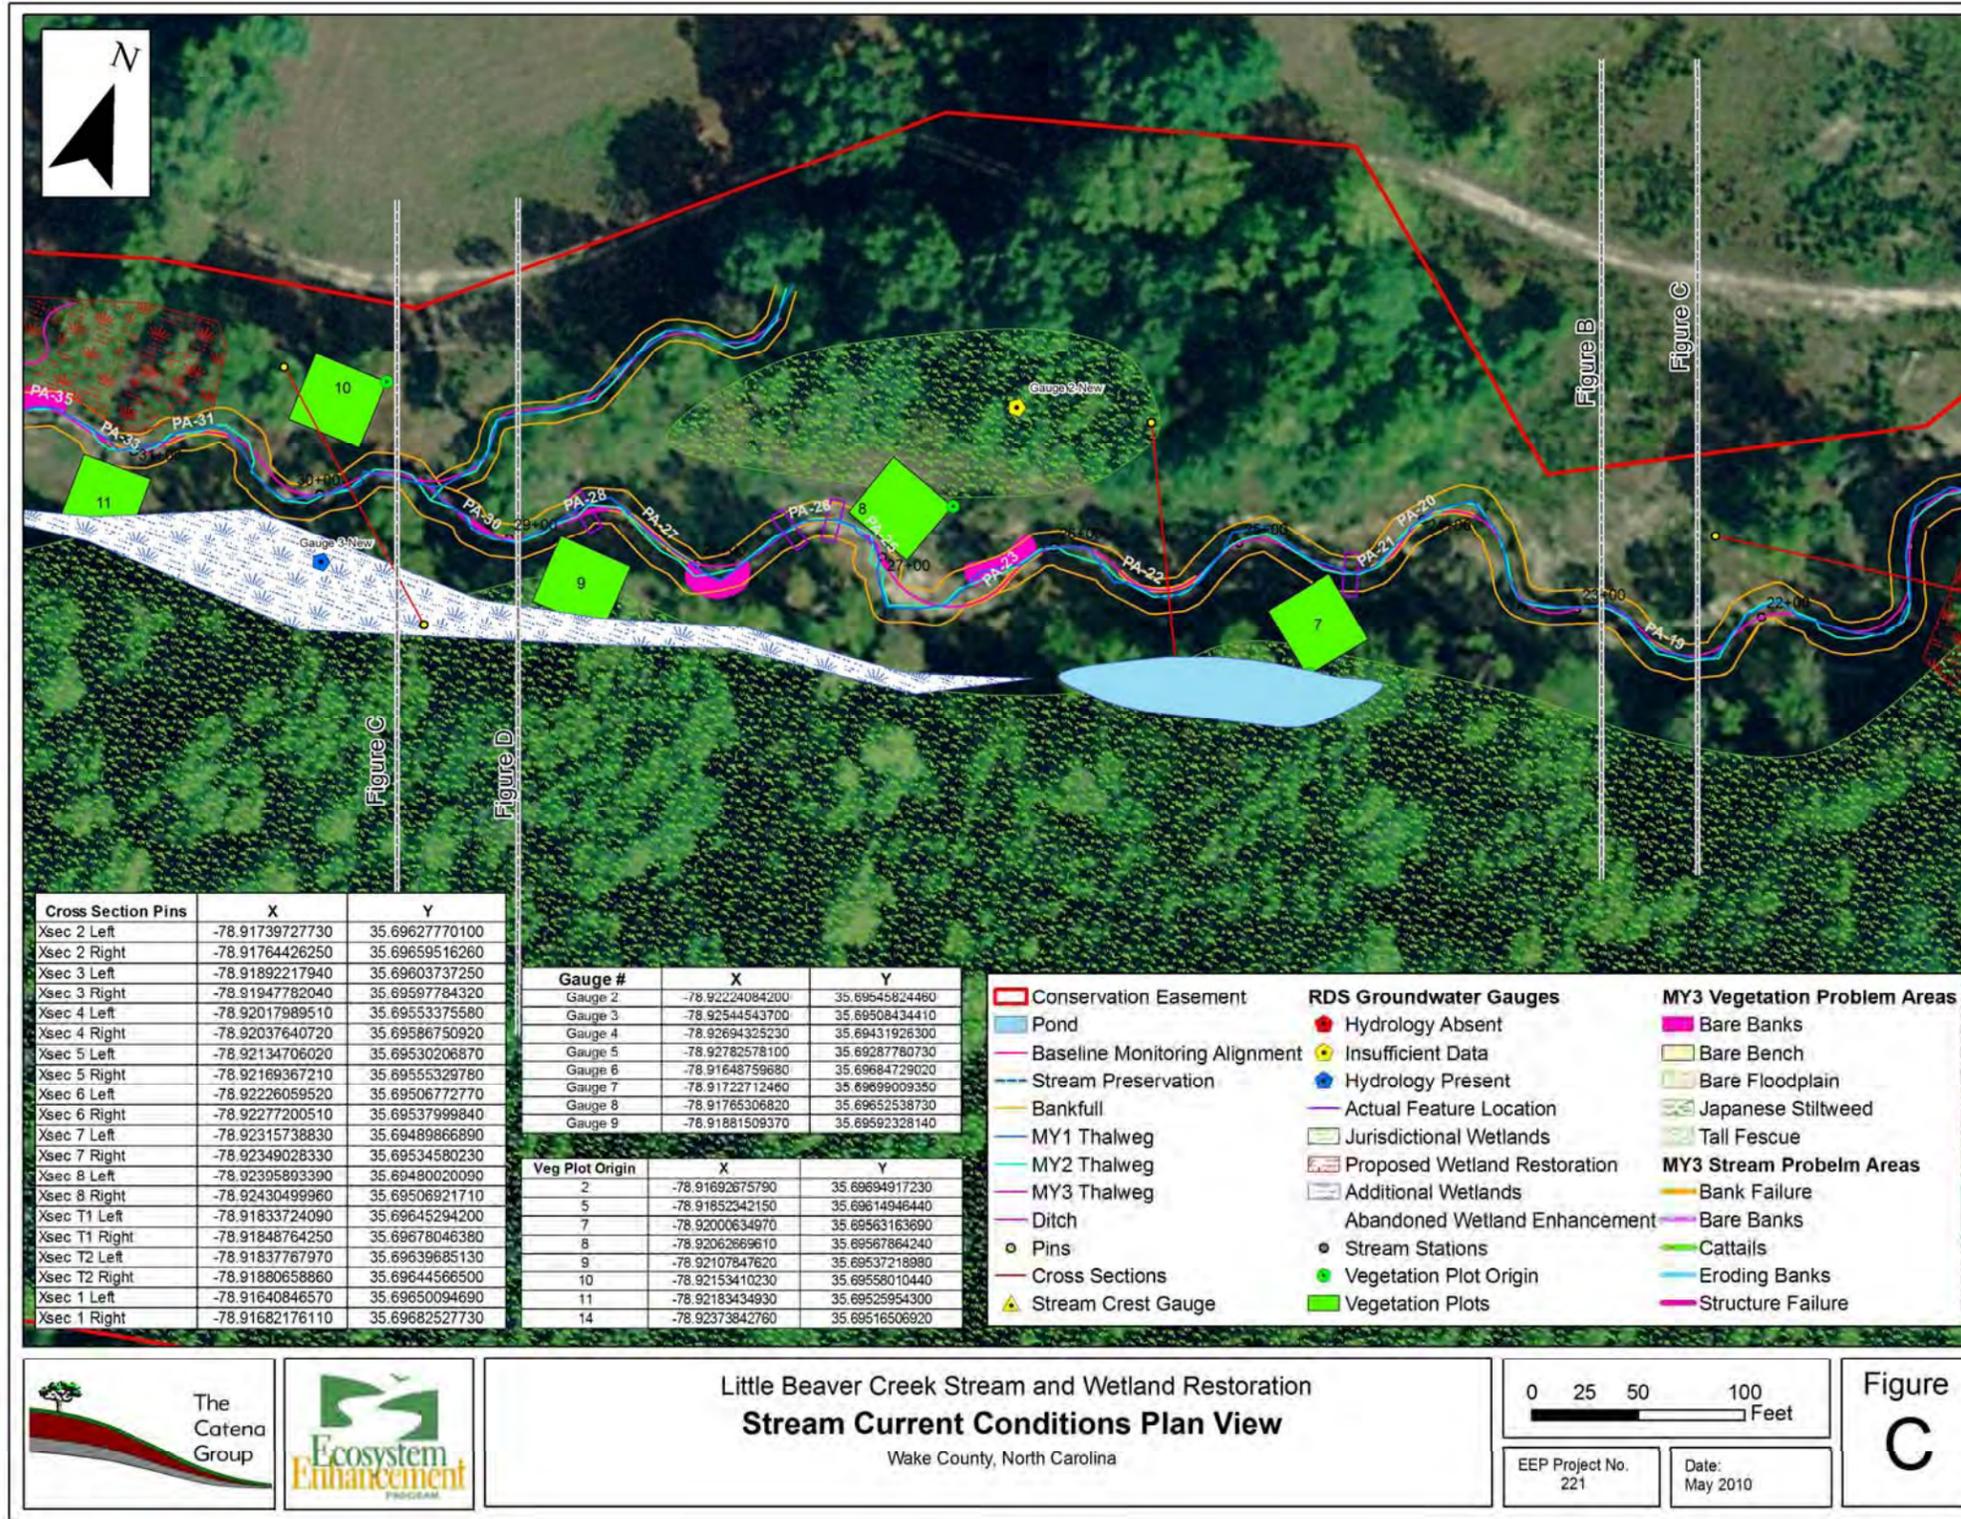


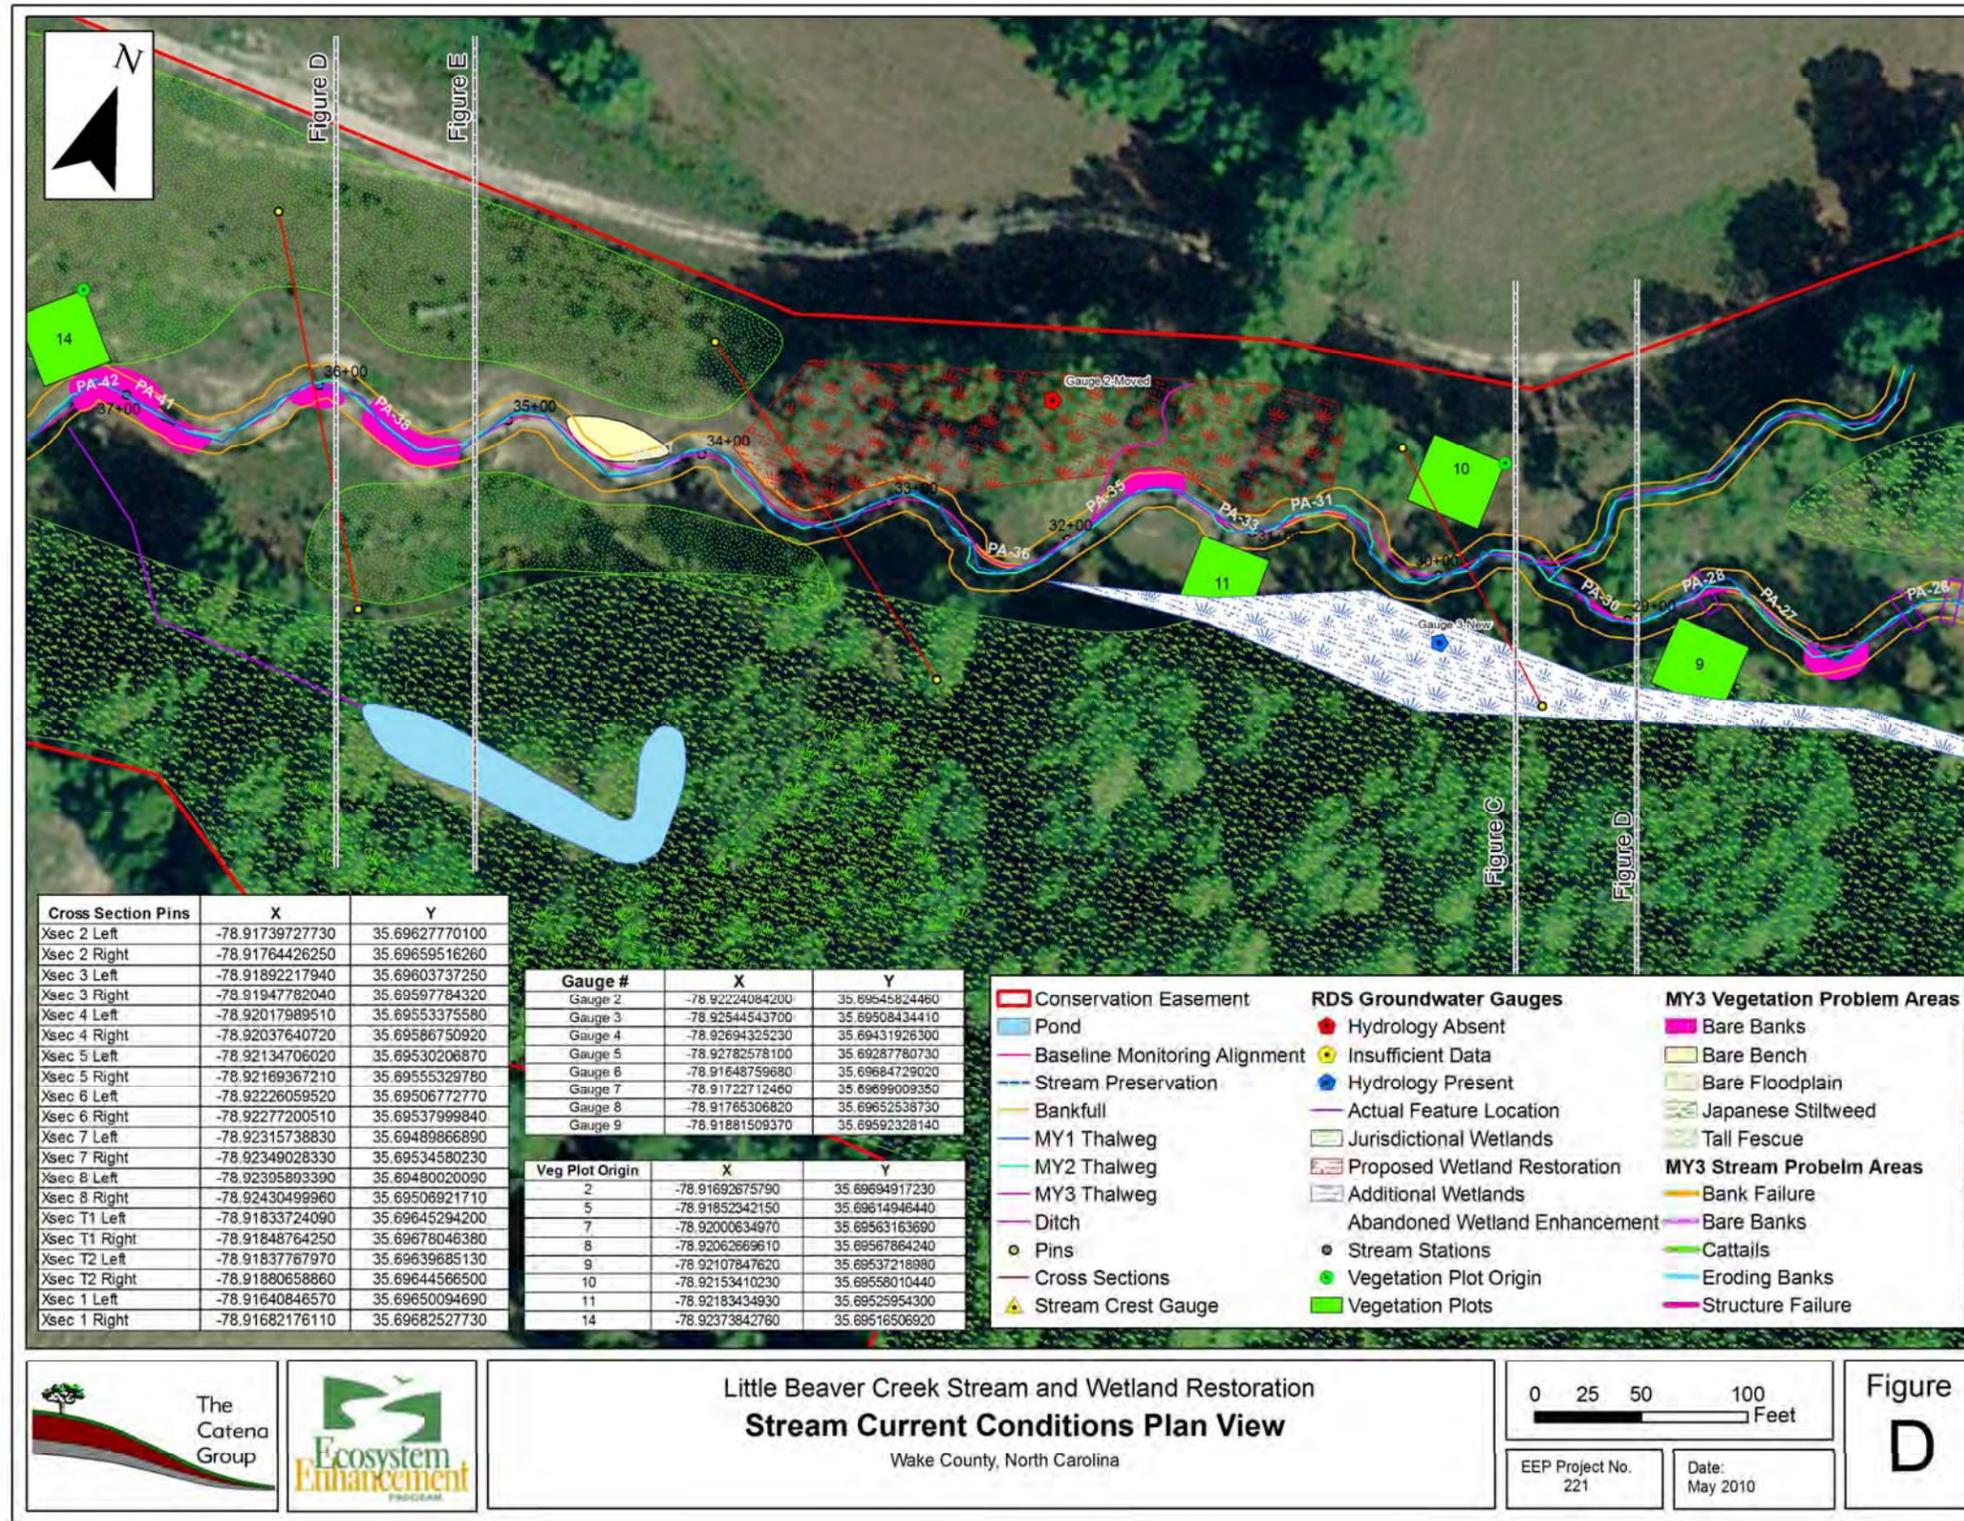

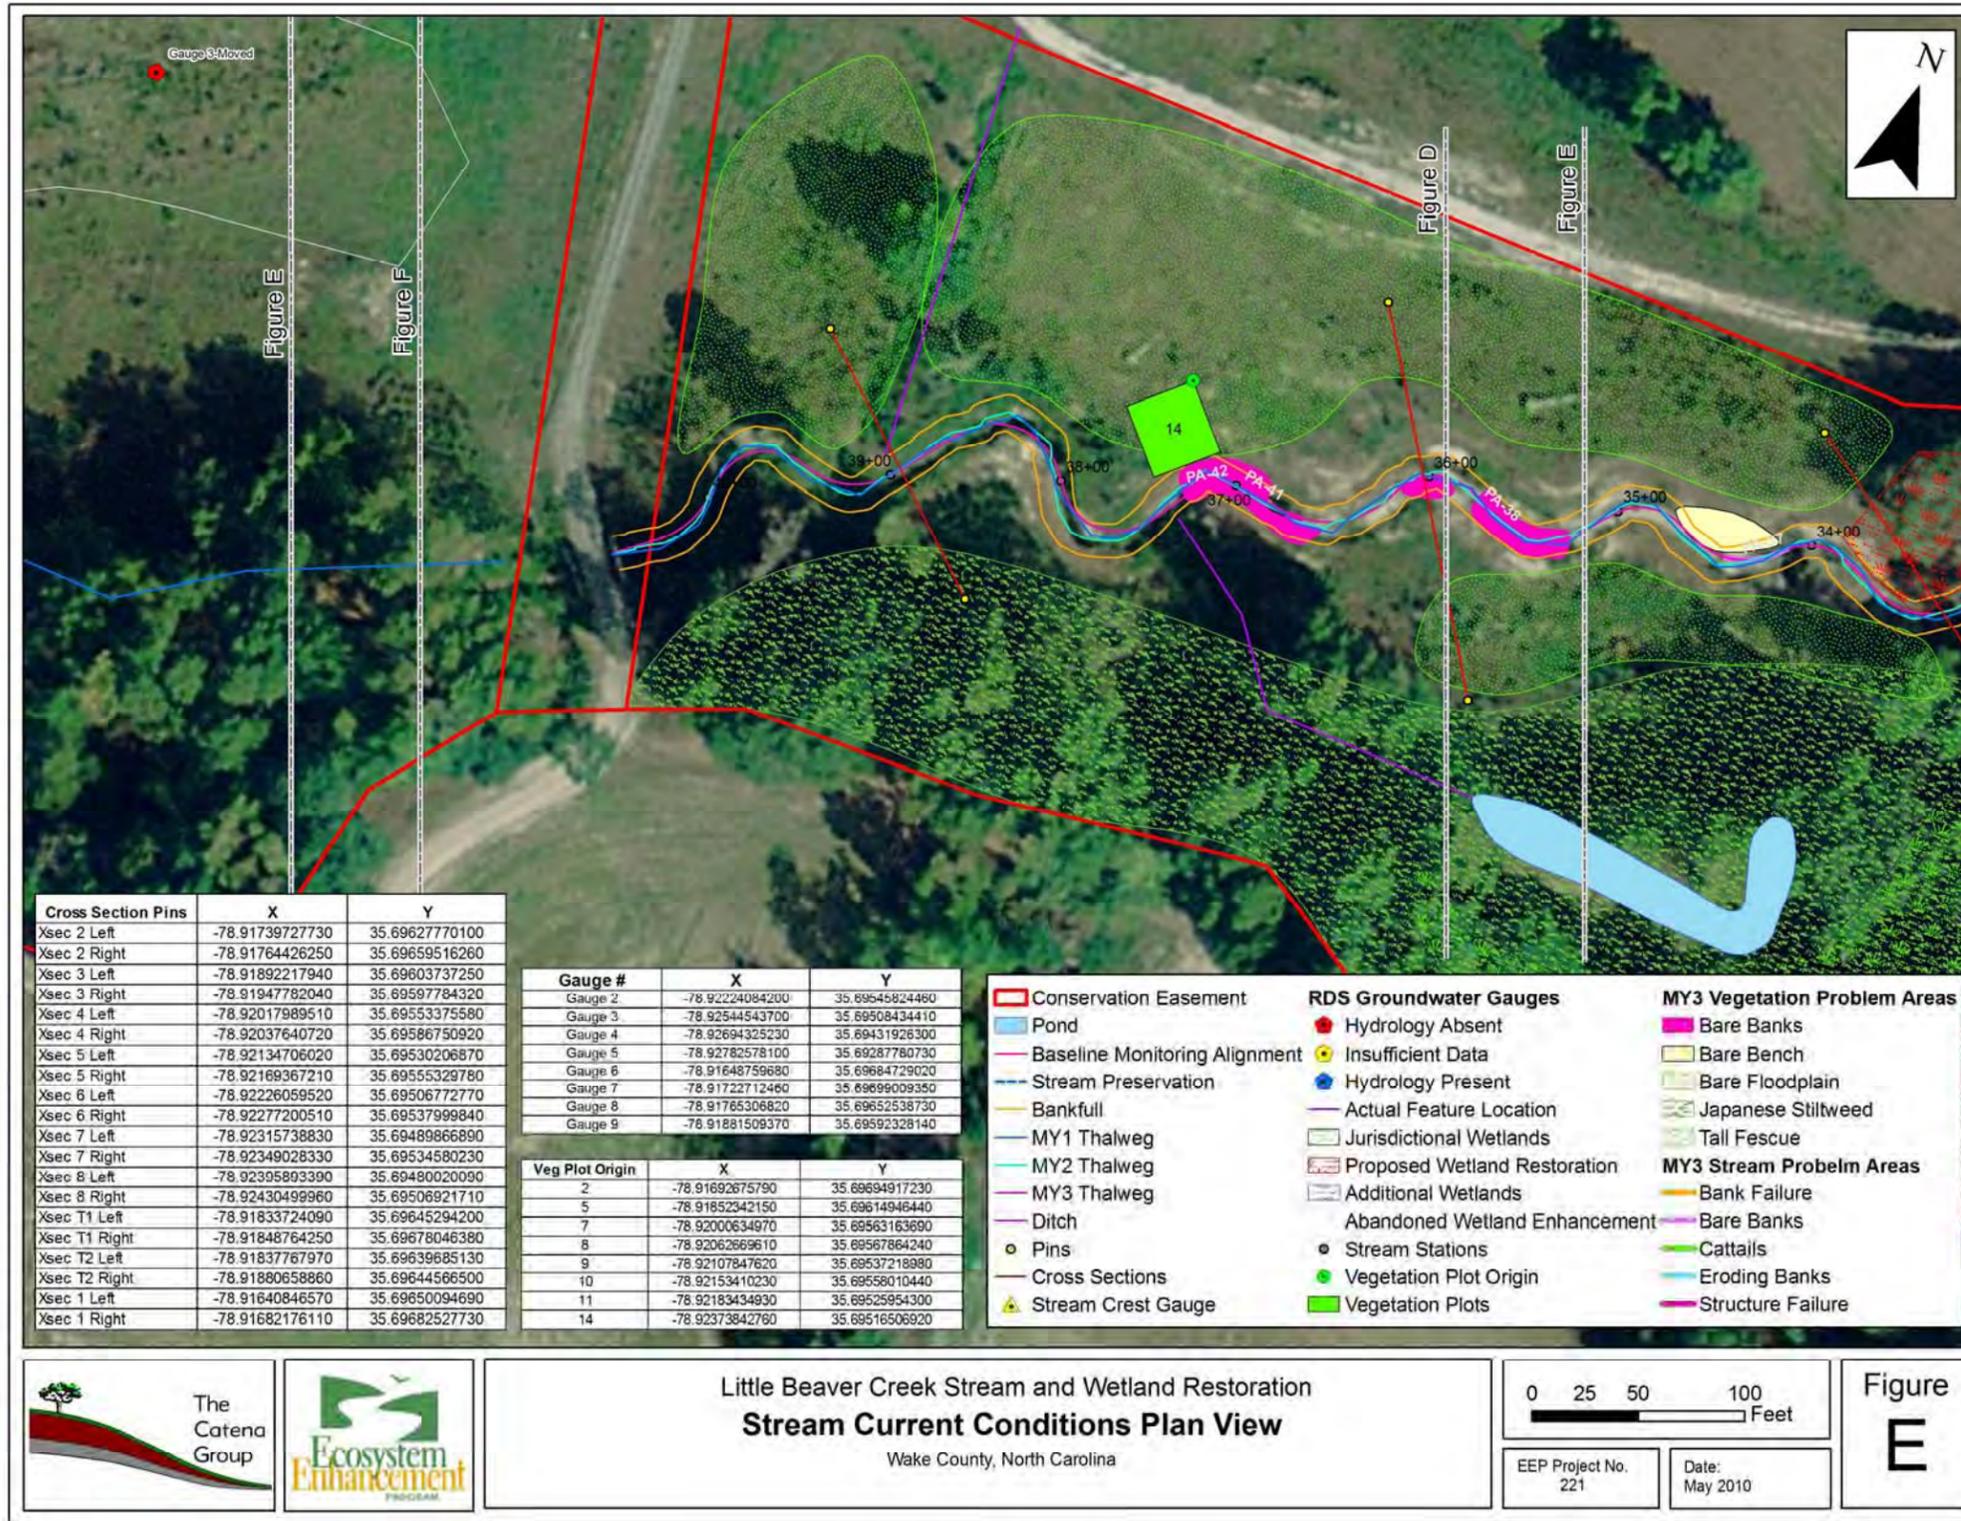

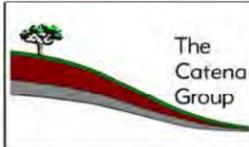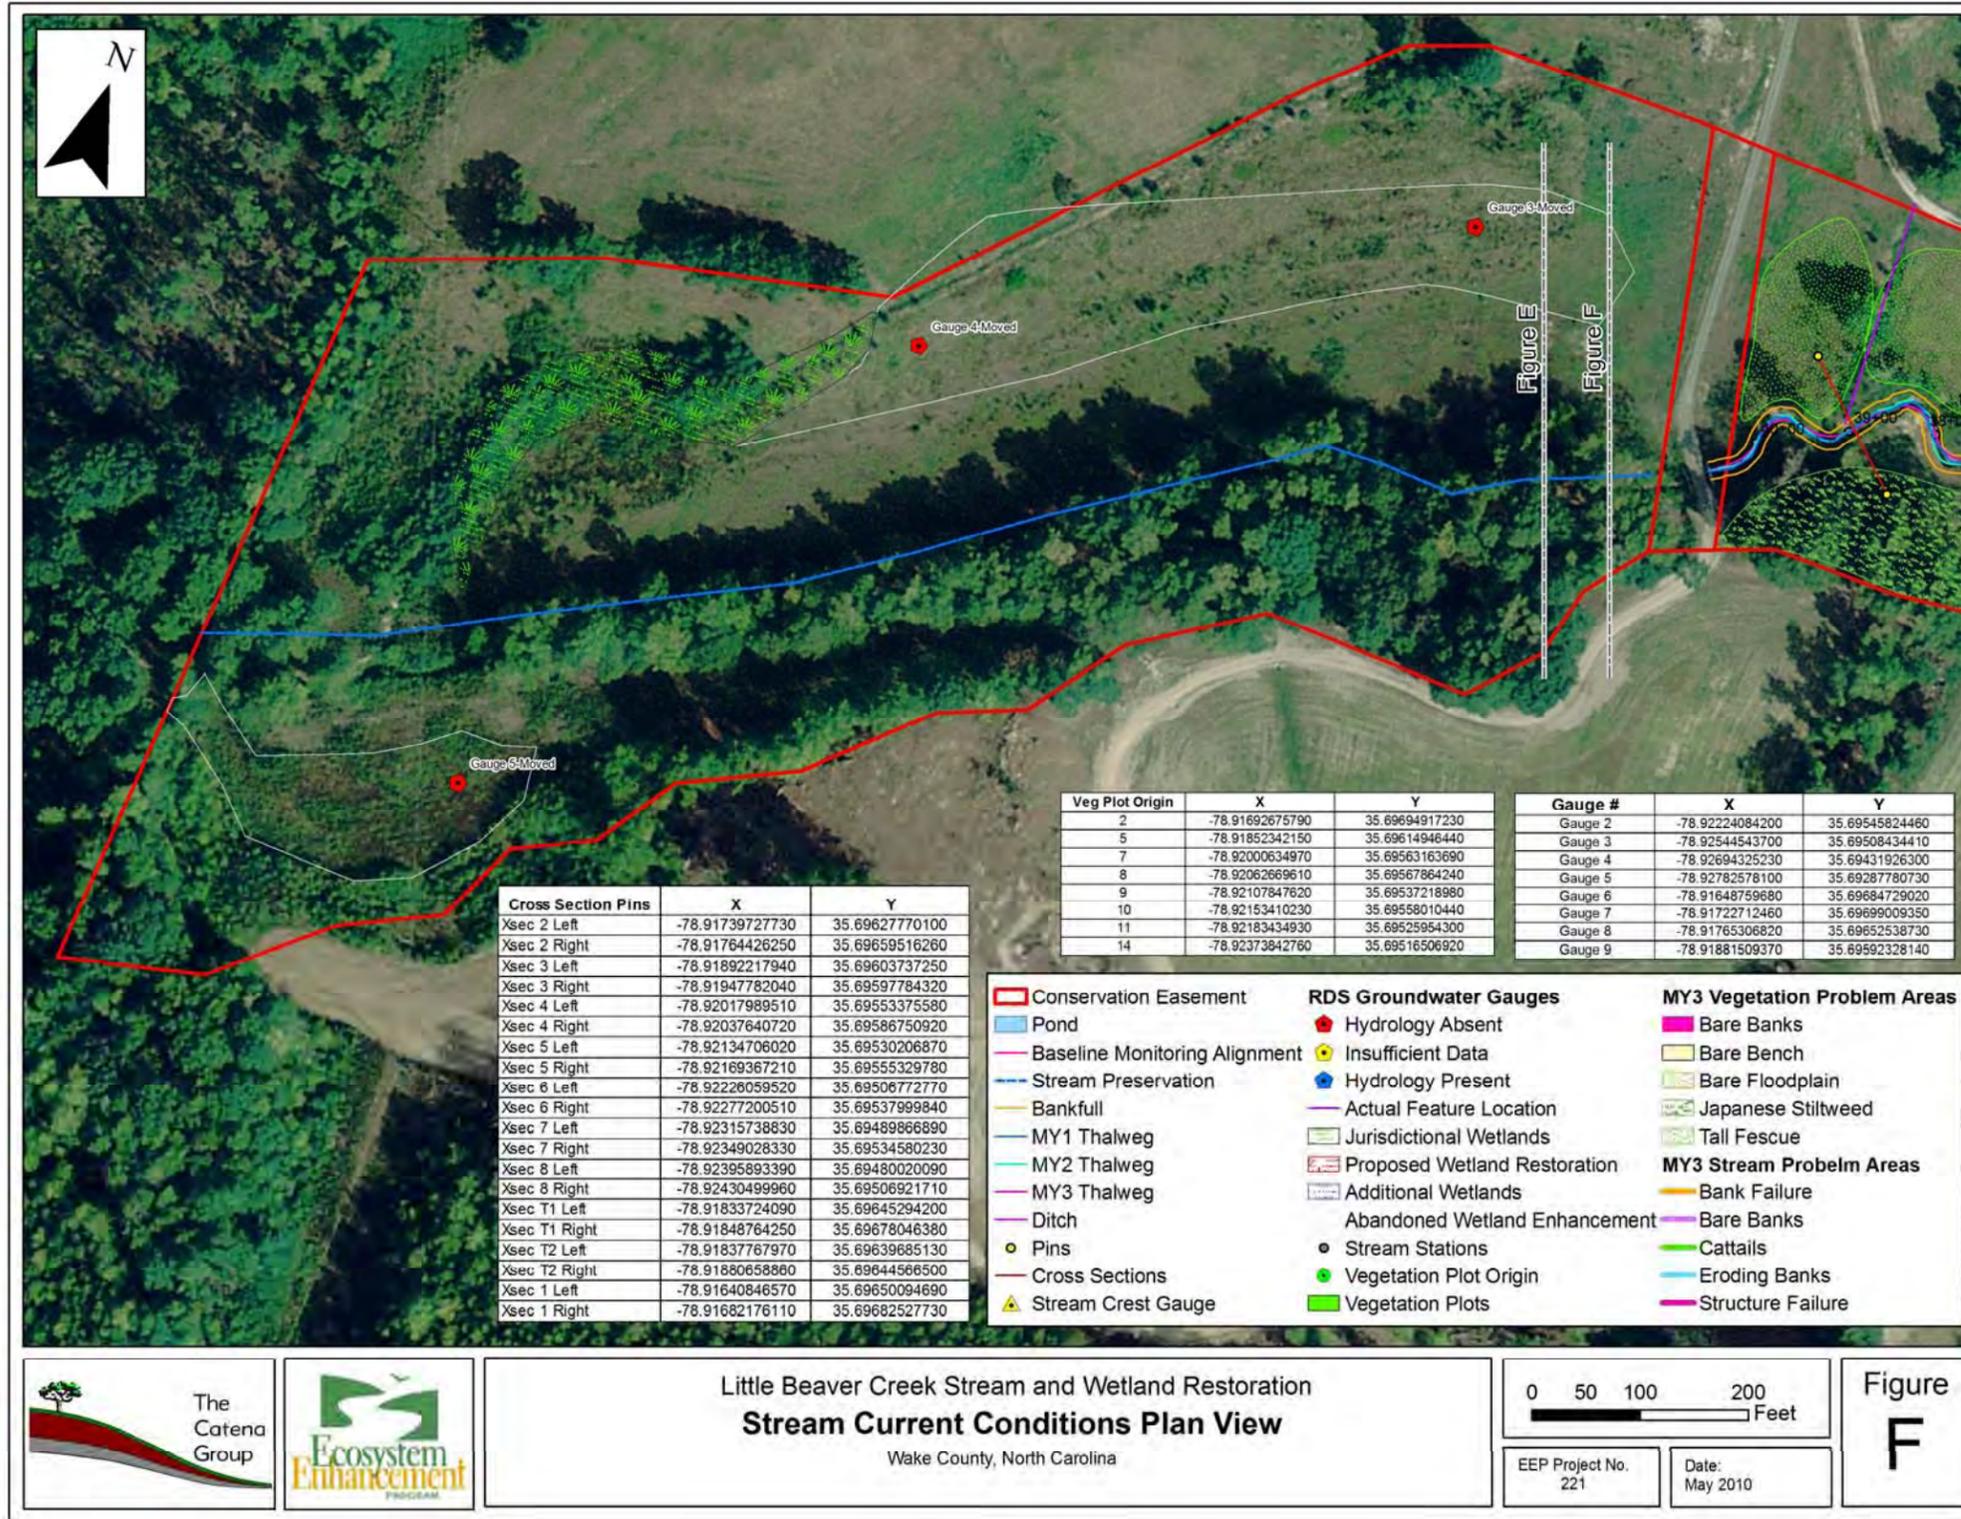

Little Beaver Creek Stream and Wetland Restoration
Stream Current Conditions Plan View
 Wake County, North Carolina

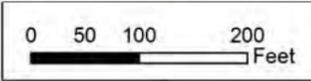

EEP Project No. 221

Date: May 2010

Figure F

Appendix B. General Project Tables

Table 1A and B. Project Components and Summations

Table 1a. Project Components Little Beaver Creek /Project No. 221								
Project Component or Reach ID	Existing Feet/Acres	Restoration Level	Approach	Footage or Acreage	Stationing	Buffer Acres	BMP Elements ¹	Comment
Little Beaver Creek/Reach 1 & 2	2.4 acres	R	N/A	2.4 acres	SEE CCPV	N/A		Wetland Restoration
Little Beaver Creek/Reach 1 & 2	2300 lf	R	P1 & P2	2300 lf	10+00 to 19+91/19+91 to 33+00	N/A		Instream Structure and Vegetated Buffers
Little Beaver Creek/Reach 3a	732 lf	R	P2	732 lf	33+00 to 40+32	N/A		Instream Structure and Vegetated Buffers
Little Beaver Creek/Reach 3b	1913lf	Preservation	N/A	1913lf	48+00 to 63+13	N/A		Instream Structure and Vegetated Buffers
Tributary 1	381 lf	R	P1	381 lf	10+00 to 13+81	N/A		Instream Structure and Vegetated Buffers
Tributary 2	206 lf	R	P1	206 lf	10+00 to 12+06	N/A		Instream Structure and Vegetated Buffers
Tributary 3	93 lf	R	P1 & P2	93 lf	10+00 to 10+92	N/A		Instream Structure and Vegetated Buffers

1 = BR = Bioretention Cell; SF = Sand Filter; SW = Stormwater Wetland; WDP = Wet Detention Pond; DDP = Dry Detention Pond;
 FS = Filter Strip; Grassed Swale = S; LS = Level Spreader; NI = Natural Infiltration Area, O = Other
 CF = Cattle Fencing; WS = Watering System; CH = Livestock Housing

Table 1b. Component Summations

Table 1b. Component Summations Little Beaver Creek/Project No. 221							
Restoration Level	Stream (lf)	Riparian Wetland (Ac)		Non-Ripar (Ac)	Upland (Ac)	Buffer (Ac)	BMP
		Riverine	Non-Riverine				
Restoration	3712	2.4					
Enhancement							
Enhancement I							
Enhancement II							
Creation							
Preservation	1913						
HQ Preservation							
		2.4	0				
Totals	5625	2.4		0	0		Count
	Non-Applicable						

Table 2. Project Activity and Reporting History

Table 2. Project Activity and Reporting History Little Beaver Creek Stream and Wetland Restoration Site-Project No. 221			
Activity or Reporting	Scheduled Completion	Data Collection Complete	Actual Completion Date
Restoration Plan	2003	2003	March 2003
Final Design-90%	2005	2005	2005
Construction	2005	2005	November 2005
Temporary S&E mix applied to entire project area	2005	2005	2005
Permanent seed mix applied to entire project area	2005	2005	2005
Containerized, B&B, and livestock planting	January 2007	February 2007	February 2007
Mitigation Plan/As-built (Year 0 Monitoring-baseline)	July 2006	March 2006	February 2007
Year 1 Monitoring	Fall 2006	February 2007	November 2007
Year 2 Monitoring	December 2008	Fall 2008	December 2008
Year 3 Monitoring	December 2009*	May 2010*	May 2010*
Year 4 Monitoring	NA	NA	NA
Year 5 Monitoring	NA	NA	NA

* Postepone due to Scoped Regrading Activities

Table 3. Project Contact Table

Table 3. Project Contacts Table Little Beaver Creek Stream and Wetland Restoration Site-Project No. 221	
Designer POC	Earth Tech 701 Corporate Center Drive Suite 475 Raleigh, NC 27607 Bill Jenkins PE (919) 854-6200
Construction Contractor	Envirocon, Inc. 651 Corporate Circle Suite 114 Golden, CO 80401 Verne Musser (303) 215-0187
Planting Contractor POC	Seal Brothers 131 West Cleve St. Mt. Airy, NC 27030 Brain Seal (336) 786-2263
Seeding Contractor POC	Seal Brothers 131 West Cleve St. Mt. Airy, NC 27030 Brain Seal (336) 786-2263
Seed Mix Sources	Evergreen Seeding 4792 Rawls Church Rd. Fuquay-Varina, NC 27526
Nursery Stock Suppliers	Mellow March Farm 1312 Woody Store Rd. Siler City, NC 27344 (919) 742-1200
Monitoring Performers	The Catena Group 410-B Millstone Drive Hillsborough, NC 27278
Stream Monitoring	Ward Consulting Engineers 8368 Six Forks Road, Suite 104 Raleigh, North Carolina 27615-5083
Vegetation Monitoring	The Catena Group 410-B Millstone Drive Hillsborough, NC 27278
Wetland Monitoring	The Catena Group 410-B Millstone Drive Hillsborough, NC 27278

Table 4. Project Attribute Table


Table 4. Project Attribute Table Little Beaver Creek Stream and Wetland Restoration Site-Project No. 221	
Project County	Wake
Drainage Area	
Little Beaver Creek	1.1 sq mi
Drainage impervious surface cover estimate (%)	< 5%
Stream Order	
Little Beaver Creek	2nd
Physiographic Region	Piedmont
Ecoregion	Triassic Basin
Rosgen Classification of As-Built	C
Cowardin Classification	Riverine
Dominant Soil Types	Augusta fine sandy loam, Wehadkee silt loam, Worsham sandy loam
USGS HUC for Project	3030002
USGS HUC for Reference	Richland Creek (03030003) and Little Beaver Creek (03030002)
NCDWQ Sub-basin for Project	030605
NCDWQ Sub-basin for Reference Reach	Richland Creek (030610), Little Beaver Creek (030605)
NCDWQ Classification for Project	Little Beaver Creek (WS-IV, NSW)
NCDWQ Classification for Reference	Richland Creek (B), Little Beaver Creek (WS-IV, NSW)
Is any portion of any project segment 303D listed?	No
Is any portion of any project segment upstream of a 303D listed segment?	Yes
Reasons for 303D listing or stressor	Chlorophyll a
% of project easement fenced	0%
NCDWQ Classification for Reference -CB	WS-IV NSW
NCDWQ Classification for Reference -LC	C
Is any portion of any project segment 303D listed?	No
Is any portion of any project segment upstream of a 303D listed segment?	No
Reasons for 303D listing or stressor	N/A
% of project easement fenced	100%

Appendix C. Vegetation Assessment Data

Table 5. Vegetation Plot Mitigation Success Summary Table

Little Beaver Creek (EEP #221)		
Veg Plot ID	Veg Survival Threshold Met?	Tract Mean
VP2	No	38%
VP5	Yes	
VP7	Yes	
VP8	No	
VP9	No	
VP10	No	
VP11	Yes	
VP14	No	

Vegetation Monitoring Plot Photos

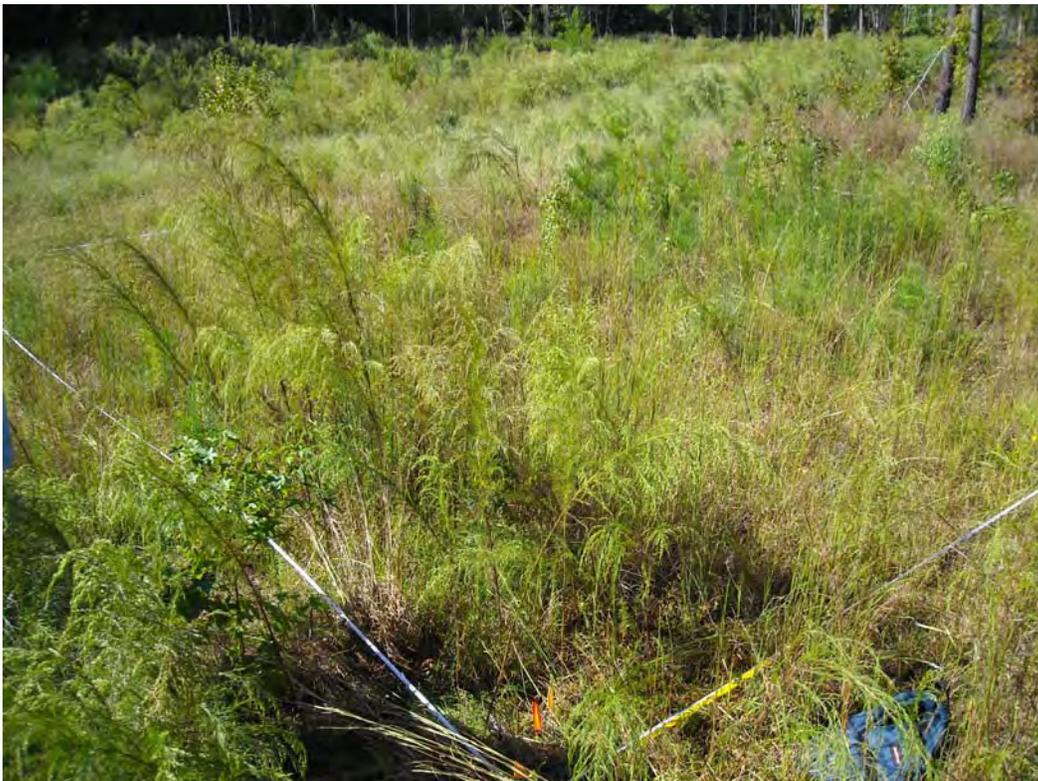

Vegetation Plot 2



Vegetation Plot 5



Vegetation Plot 7



Vegetation Plot 8



Vegetation Plot 9



Vegetation Plot10



Vegetation Plot 11



Vegetation Plot 14

Table 6. Vegetation Metadata Table

Report Prepared By	The Catena Group
database name	Little Beaver Creek cvs-eep-entrytool-v2.2.5.mdb
DESCRIPTION OF WORKSHEETS IN THIS DOCUMENT-----	
Metadata	Description of database file, the report worksheets, and a summary of project(s) and project data.
Proj, planted	Each project is listed with its PLANTED stems per acre, for each year. This excludes live stakes.
Proj, total stems	Each project is listed with its TOTAL stems per acre, for each year. This includes live stakes, all planted stems, and all natural/volunteer stems.
Plots	List of plots surveyed with location and summary data (live stems, dead stems, missing, etc.).
Vigor	Frequency distribution of vigor classes for stems for all plots.
Vigor by Spp	Frequency distribution of vigor classes listed by species.
Damage	List of most frequent damage classes with number of occurrences and percent of total stems impacted by each.
Damage by Spp	Damage values tallied by type for each species.
Damage by Plot	Damage values tallied by type for each plot.
ALL Stems by Plot and spp	A matrix of the count of total living stems of each species (planted and natural volunteers combined) for each plot; dead and missing stems are excluded.
PROJECT SUMMARY-----	
Project Code	221
project Name	Little Beaver Creek
Description	4435 stream restoration, 1560 preservation, 2.4 acres wetland restoration southwest of Apex, NC. Constructed July-Nov. 2005.
River Basin	Cape Fear
length(ft)	4435
stream-to-edge width (ft)	50
area (sq m)	41198.33
Required Plots (calculated)	11
Sampled Plots	0

Appendix D. Stream Assessment Data

Stream Station Photos



Photo 1 CS-1 Looking DS



Photo 4 CS-4 Looking DS



Photo 2 CS-2 Looking DS



Photo 5 CS-5 Looking DS



Photo 3 CS-3 Looking DS



Photo 6 CS-6 Looking DS



Photo 7 CS-7 Looking DS



Photo 10 CS-T2 Looking DS



Photo 8 CS-8 Looking DS



Photo 9 CS-T1 Looking DS

**Table 8. Visual Morphological Stability Assessment
Little Beaver Creek Stream Restoration/Project 221
Reaches 1, 2, 3a.: (3032 feet)**

Feature Category	Metric (per As-built and reference baselines)	(# Stable) Number Performing as Intended	Total number per As-built	Total Number / feet in unstable state	% Perform in Stable Condition	Feature Perform Mean or Total
A. Riffles	1. Present?	31	64	NA	48%	
	2. Armor stable (e.g.no displacement?)	24	64	NA	38%	
	3. Facet grade appears stable?	23	64	NA	36%	
	4. Minimal evidence of embedding/fining?	17	64	NA	27%	
	5. Length appropriate?	18	64	NA	28%	35%
B. Pools	1. Present? (e.g. not subject to severe aggrad. Or migrat.?)	41	64	NA	64%	
	2. Sufficiently deep (Max. Pool D:Mean Bkf>1.6?)	38	64	NA	59%	
	3. Length appropriate?	27	64	NA	42%	55%
C. Thalweg	1. Upstream of meander bend (run/inflection) centering?	38	64	NA	59%	
	2. Downstream of meander (glide/inflection) centering?	32	64	NA	50%	55%
D. Meanders	1. Outer bend in state of limited/controlled erosion?	21	64	NA	33%	
	2. Of those eroding, # w/concomitant point bar formation?	4	43	NA	9%	
	3. Apparent Rc within spec?	38	64	NA	59%	
	4. Sufficient floodplain access and relief?	24	64	NA	38%	35%
E. Bed General	1. General channel bed aggradation areas (bar formation)	NA	NA	15/210	93%	
	2. Channel bed degradation-areas of increasing downcutting of head cutting?	NA	NA	4/106	97%	95%
F. Bank	1. Actively eroding, wasting, or slumping bank?	NA	NA	22/534	91%	91%
G. Cross vanes, sills, single wing vanes	1. Free of back or arm scour?	16	34	NA	47%	
	2. Height appropriate?	18	34	NA	53%	
	3. Angle and geometry appear appropriate?	17	34	NA	50%	
	4. Free of piping or other structural failures?	12	34	NA	35%	46%
H. Wads/ Boulders	1. Free of scour?	12	25	NA	48%	
	2. Footing stable?	12	25	NA	48%	48%

**Table B2. Visual Morphological Stability Assessment
Little Beaver Creek Stream Restoration/Project 221
Tributary 1: (381 feet)**

Feature Category	Metric (per As-built and reference baselines)	(# Stable) Number Performing as Intended	Total number per As-built	Total Number / feet in unstable state	% Perform in Stable Condition	Feature Perform Mean or Total
A. Riffles	1. Present?	10	11	NA	91%	
	2. Armor stable (e.g.no displacement?)	10	11	NA	91%	
	3. Facet grade appears stable?	10	11	NA	91%	
	4. Minimal evidence of embedding/fining?	8	11	NA	73%	
	5. Length appropriate?	10	11	NA	91%	87%
B. Pools	1. Present? (e.g. not subject to severe aggrad. Or migrat.?)	8	11	NA	73%	
	2. Sufficiently deep (Max. Pool D:Mean Bkf>1.6?)	6	11	NA	55%	
	3. Length appropriate?	6	11	NA	55%	61%
C. Thalweg	1. Upstream of meander bend (run/inflection) centering?	8	11	NA	73%	
	2. Downstream of meander (glide/inflection) centering?	8	11	NA	73%	73%
D. Meanders	1. Outer bend in state of limited/controlled erosion?	4	11	NA	36%	
	2. Of those eroding, # w/concomitant point bar formation?	1	7	NA	14%	
	3. Apparent Rc within spec?	8	11	NA	73%	
	4. Sufficient floodplain access and relief?	8	11	NA	73%	49%
E. Bed General	1. General channel bed aggradation areas (bar formation)	NA	NA	0	100%	
	2. Channel bed degradation-areas of increasing downcutting of head cutting?	NA	NA	0	100%	100%
F. Bank	1. Actively eroding, wasting, or slumping bank?	NA	NA	6/90	88%	88%
G. Cross vanes, sills, single wing vanes	1. Free of back or arm scour?	2	2	NA	100%	
	2. Height appropriate?	2	2	NA	100%	
	3. Angle and geometry appear appropriate?	2	2	NA	100%	
	4. Free of piping or other structural failures?	2	2	NA	100%	100%
H. Wads/ Boulders	1. Free of scour?	0	0	NA	NA	
	2. Footing stable?	0	0	NA	NA	NA

**Table B2. Visual Morphological Stability Assessment
Little Beaver Creek Stream Restoration/Project 221
Tributary 2: (200 feet)**

Feature Category	Metric (per As-built and reference baselines)	(# Stable) Number Performing as Intended	Total number per As-built	Total Number / feet in unstable state	% Perform in Stable Condition	Feature Perform Mean or Total
A. Riffles	1. Present?	5	5	NA	100%	
	2. Armor stable (e.g.no displacement?)	5	5	NA	100%	
	3. Facet grade appears stable?	5	5	NA	100%	
	4. Minimal evidence of embedding/fining?	5	5	NA	100%	
	5. Length appropriate?	5	5	NA	100%	100%
B. Pools	1. Present? (e.g. not subject to severe aggrad. Or migrat.?)	5	5	NA	100%	
	2. Sufficiently deep (Max. Pool D:Mean Bkf>1.6?)	5	5	NA	100%	
	3. Length appropriate?	5	5	NA	100%	100%
C. Thalweg	1. Upstream of meander bend (run/inflection) centering?	5	5	NA	100%	
	2. Downstream of meander (glide/inflection) centering?	5	5	NA	100%	100%
D. Meanders	1. Outer bend in state of limited/controlled erosion?	5	5	NA	100%	
	2. Of those eroding, # w/concomitant point bar formation?	0	0	NA	100%	
	3. Apparent Rc within spec?	5	5	NA	100%	
	4. Sufficient floodplain access and relief?	5	5	NA	100%	100%
E. Bed General	1. General channel bed aggradation areas (bar formation)	NA	NA	0	0%	
	2. Channel bed degradation-areas of increasing downcutting of head cutting?	NA	NA	0	0%	100%
F. Bank	1. Actively eroding, wasting, or slumping bank?	NA	NA	0	0%	100%
G. Cross vanes, sills, single wing vanes	1. Free of back or arm scour?	1	1	NA	100%	
	2. Height appropriate?	1	1	NA	100%	
	3. Angle and geometry appear appropriate?	1	1	NA	100%	
	4. Free of piping or other structural failures?	1	1	NA	100%	100%
H. Wads/Boulders	1. Free of scour?	0	0	NA	NA	
	2. Footing stable?	0	0	NA	NA	NA

Table 8. Verification of Bankfull Events

Table 9. Verification of Bankfull Events Little Beaver Creek Stream and Wetland Restoration Site-Project No. 221			
Date of Data Collection	Date of Occurrence	Method	Photo #
2006	14-Jun-06	Visual	N/A
September 18, 2008	September 7, 2008	Visual (i.e. wrack lines)	N/A

Figure 3. Cross-Section 1

Project		Little Beaver Creek		Summary (bankfull)				
Cross Section	Station	Feature	Date	Crew	MY0	MY1	MY2	MY3
Cross Section 1	11+25	R/R	4/8/10	BW, RL, BV, ZP	N/A	25.1	22.4	25.1
					A (BKF)	N/A	13.8	15.4
					W(BKF)	N/A	3.4	2.9
					Max d	N/A	1.8	1.8
					Mean d	N/A	7.6	10.6
					W/D	N/A	7.7	7.7

MY1-2007			MY2-2008			MY3-2009		
Station	Elevation	Notes	Station	Elevation	Notes	Station	Elevation	Notes
0	295.22		0.00	296.27	LPIN	0.00	296.36	X 1 LP
5	295.63		11.04	295.47		7.24	295.73	
10	295.75		20.11	294.89		17.43	294.62	
14	295.13		31.79	294.84		33.70	294.95	
17	294.91		41.33	294.71		49.41	294.70	
20	294.83		47.43	294.65		54.44	293.68	
22.5	294.51		52.75	294.10		58.05	292.03	
24	294.71		56.75	292.71		66.60	291.65	
29	294.74		60.95	292.00		72.45	291.86	BKF
36	294.73		70.58	291.82	BKF	77.04	290.21	
40	294.56		73.54	291.09		77.81	288.96	
49.5	294.69		76.60	290.15	Toe L	80.17	288.93	TW
54	293.96		77.63	288.93		82.30	288.87	
57	292.42		79.11	288.77		83.23	280.10	
58.5	292.04		80.98	288.95		86.73	291.72	BKF
60	291.9		81.84	289.10		99.57	291.37	
70	291.33		82.52	290.33	TDE R	109.31	292.67	
73.3	291.9	BKF	83.73	290.51		122.20	292.90	
76.3	290.55		84.34	290.89		148.91	292.70	
77.2	289.96		86.67	291.65	BKF	167.52	292.72	X 1 RP
78	289.62		91.51	291.41				
78.2	289.38	lew	101.45	291.36				
78.2	288.67		107.37	292.20				
80	288.81		111.16	292.53				
81	289.59		117.86	292.93				
81.9	288.44	TW	131.38	292.79				
83	288.64		142.99	292.91				
83.1	289.97		155.43	292.93				
87.2	291.79	BKF	167.26	292.80	RPIN			



Photo of XS-1, Sta 11+25 looking in the downstream direction

*This cross section was moved after MY0, therefore MY0 is not represented on this plot.

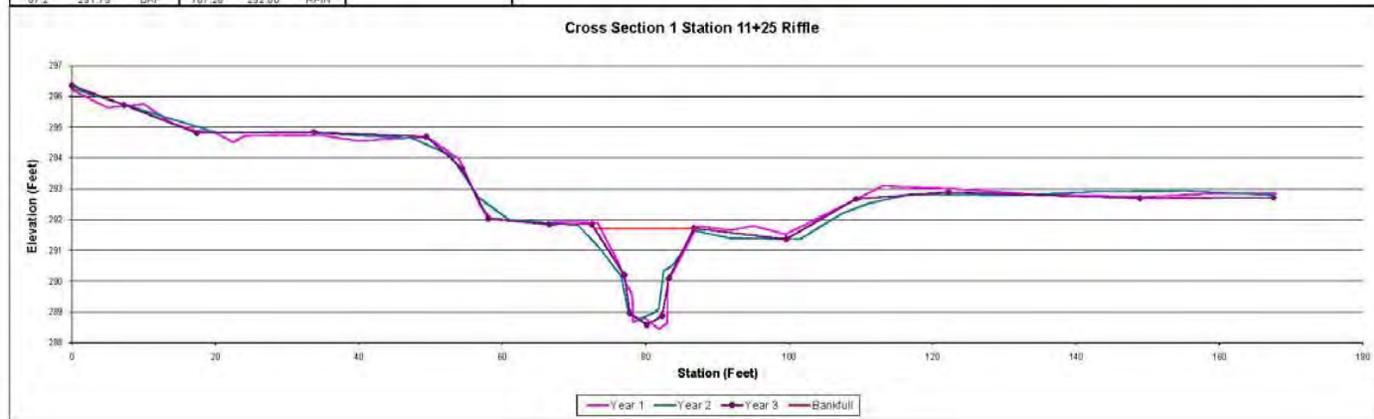


Figure 4. Cross-Section 2

Project		Little Beaver Creek		Summary (bankfull)					
Cross Section		Cross Section 2		A (BKF)	MY0	MY1	MY2	MY3	
Feature		Pool		W(BKF)	34.2	17.2	18.4	18.0	
Station		14+85		Max.d	2.3	2.2	2.2	2.1	
Date		4/8/10		Mean.d	1.2	1.0	1.0	0.8	
Crew		BW, RL, SV, ZP		WTD	25.7	17.5	19.9	25.2	
MY1-2007		MY2-2008		MY3-2009					
Station	Elevation	Notes	Station	Elevation	Notes	Station	Elevation	Notes	
11080	291.053	X2	5.433	291.459	LP	5.678	291.589	X2 LP	
14.6	290.474	X2	-1.413	290.919		1.012	291.03		
35.299	290.055	X2	5.387	290.429		0.942	290.89		
50.125	289.036	X2	16.537	290.389		24.892	290.21		
56.522	288.929	X2	27.087	290.189		37.382	290.02		
62.525	287.794	X2BKF	36.757	289.909		45.872	289.85		
70.82	286.587	X2ECW	46.937	289.799		53.112	289.56		
72.483	285.579	X2TW	50.487	289.659		55.882	287.61		
73.532	285.931	X2	55.827	287.509		58.502	289.1	BKF	
75.785	286.036	X2TV	57.397	287.919		63.272	287.65		
78.618	286.564	X2ECW	60.397	287.879	BKF L	69.042	287.72		
81.881	288.466	X2BKF	64.371	287.239		70.812	286.49		
92.989	289.735	X2	68.927	287.629		74.852	286.13		
98.697	290.068	X2	70.717	286.249	TOE L	74.062	285.56	TYW	
103.321	289.902	X2	73.207	285.639	TW	75.992	286.36		
108.642	290.052	X2	75.217	285.969		78.152	287.69		
118.767	289.669	X2	76.707	286.269	TOE R	81.652	286.54	BKF	
128.755	289.992	X2	77.827	287.419		85.672	286.54		
136.617	290.359	X2RPH	80.807	288.229		89.092	289.17		
			83.527	286.859	BKFLR	92.102	288.92		
			86.557	289.139		97.872	290.01		
			93.187	288.989		104.922	290.11		
			97.547	289.979		123.942	289.73		
			105.227	290.089		136.862	290.32	X2 RP	
			110.767	289.639					
			136.617	290.959	RP				



Photo of XS-2, Sta 14+85 looking in the downstream direction

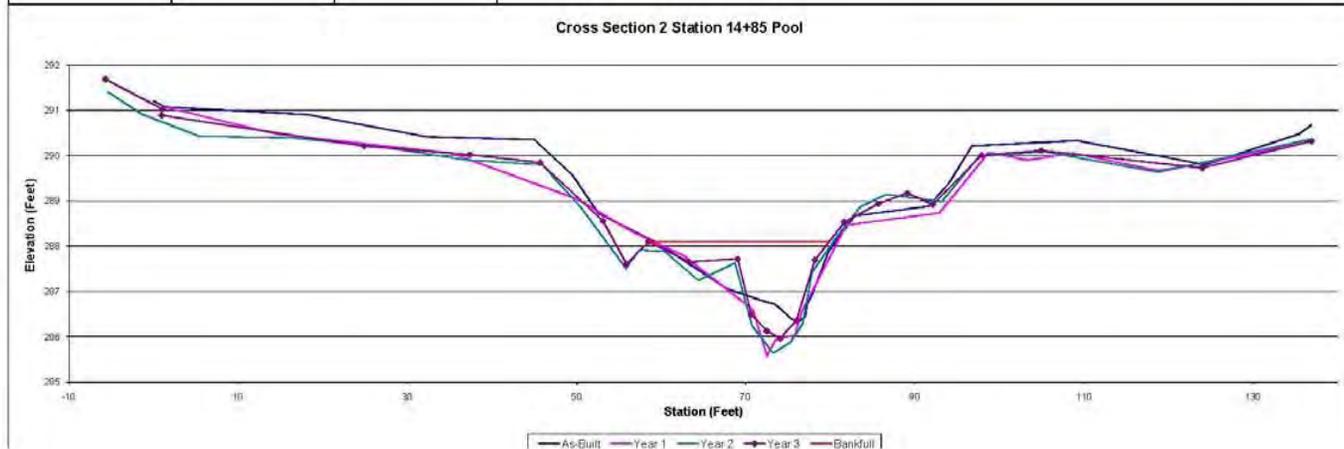


Figure 5. Cross-Section 3

Project: Little Beaver Creek		Summary (bankfull)						
Cross Section: Cross Section 3		A (BKF)	MY0	MY1	MY2	MY3		
Feature: 21+16		W(BKF)	17.9	19.1	18.5	16.1		
Date: 4/8/10		Max d	21.1	16.4	16.7	16.6		
Crew: BW,RL,SV,ZP		Mean d	1.9	2.3	2.4	2.3		
		WID	0.8	1.2	1.1	1.0		
			25.0	14.1	15.0	17.1		
MY1-2007		MY2-2008		MY3-2009				
Station	Elevation	Notes	Station	Elevation	Notes	Station	Elevation	Notes
0.043	288.436	XSL	0.00	288.44		0.50	288.44	XSLP
26.603	287.908	XSS	17.50	287.93	RP	20.16	288.27	
50.259	287.387	XSS	34.63	287.56		36.88	287.46	
57.458	284.146	XSS	44.52	287.66		47.43	287.47	
66.395	284.432	XSS	48.45	287.29		57.26	284.32	
70.353	282.821	XSSBKF	57.10	284.54		64.79	284.25	BKF
71.88	282.652	XSSBCHW	64.33	284.34	BKF	68.97	283.53	
73.745	282.006	XSSSTW	68.70	283.71		71.45	282.81	
74.544	282.239	XSS	72.44	282.68	TOE L	72.74	282.12	
76.907	282.433	XSSBCHW	73.24	282.23		73.69	281.91	TW
77.864	283.228	XSSBKF	74.01	281.95	TW	74.68	282.09	
81.703	284.22	XSS	75.66	282.10		75.79	283.12	
92.955	284.433	XSS	76.30	282.70	TOE R	76.99	283.56	
108.805	287.28	XSS	78.40	283.40		82.24	284.45	BKF
135.877	288.007	XSS	81.19	284.31	BKF	93.50	284.57	
			85.97	284.31		107.80	287.00	
			94.40	284.48		122.63	287.74	
			105.98	286.81		148.82	287.30	
			115.27	287.90		166.50	287.19	XSRP
			135.36	286.90				
			153.35	286.25				
			166.66	287.19	RP			



Photo of XS-3, Sta 21+16 looking in the downstream direction

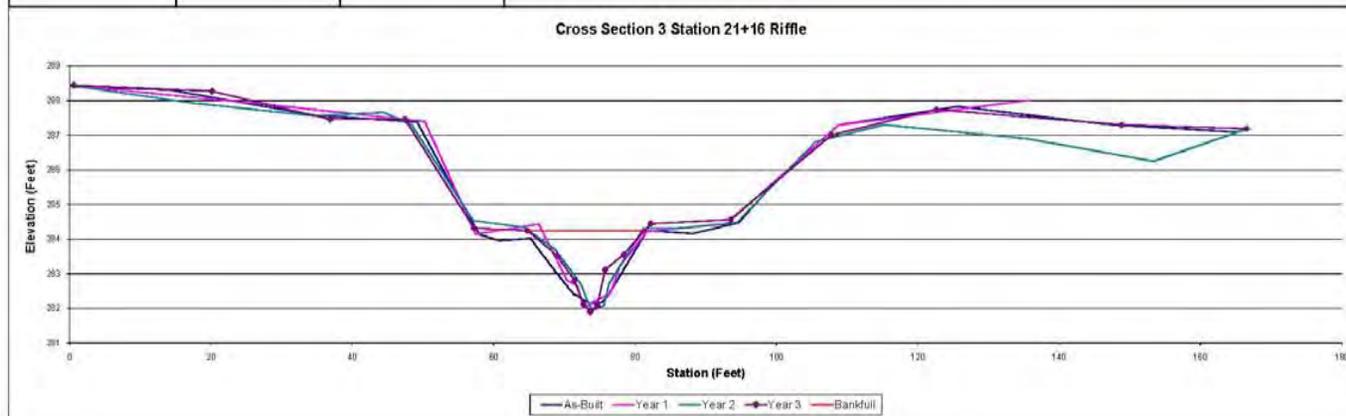


Figure 6. Cross-Section 4

Project		Little Beaver Creek		Summary (bankfull)			
Cross Section		Cross Section 4		MY0	MY1	MY2	MY3
Feature	Pool	A (BKF)	20.4	23.9	26.9	28.2	
Station	25+40	W (BKF)	15.4	19.4	21.6	21.6	
Date	4/9/10	Max d	2.5	2.7	2.7	2.9	
Crew	BW, RL, SV, ZP	Mean d	1.3	1.2	1.2	1.3	
		Wd	11.6	15.8	17.5	16.5	

MY1-2007			MY2-2008			MY3-2009		
Station	Elevation	Notes	Station	Elevation	Notes	Station	Elevation	Notes
4 978	285 334	X S4	0 00	285 72	LP	0 00	285 66	X4 LP
11 69	285 792	X G4	9 32	285 50		5 43	285 37	
26 999	286 008	X S3	22 94	286 36		16 39	285 92	
36 108	284 101	X S4	29 27	283 78		21 65	285 91	
48 188	283 533	X S4 BKF	34 08	284 46		26 36	286 23	
50 03	281 889	X S4 EOW	37 89	284 01		31 50	285 18	
52 311	280 847	X S4 TW	43 16	284 17		35 72	284 12	
54 912	281 546	X S4 TW	47 07	284 18	BKF	45 34	284 99	BKF
57 971	281 831	X S4 EOW	48 47	283 44		48 44	283 53	
63 503	287 404	X S4 BKF	50 26	281 98	TOE L	49 47	282 55	
75 146	283 843	X S4	51 29	281 21		50 28	281 68	
81 117	285 473	X S4	52 39	281 11	TW	51 72	281 09	
101 114	285 125	X S4	54 21	281 27		53 49	281 17	TW
			56 92	281 62		55 54	281 21	
			58 34	282 02	TOE R	58 33	281 77	
			58 79	282 49		59 73	282 65	
			59 87	282 76		61 44	282 92	
			61 26	282 90		64 72	283 64	
			63 34	283 40	BKF	69 12	283 78	BKF
			67 06	283 72		73 00	283 79	
			73 71	283 92		79 41	282 06	
			75 81	284 25		82 05	285 61	
			78 38	284 96		82 78	285 57	
			81 63	285 48		109 32	285 13	
			86 99	285 68		124 61	284 79	
			103 94	285 33		135 09	284 72	X4 RP
			123 27	284 82				
			135 06	284 77	RP			



Photo of XS-4, Sta 25+40 looking in the downstream direction

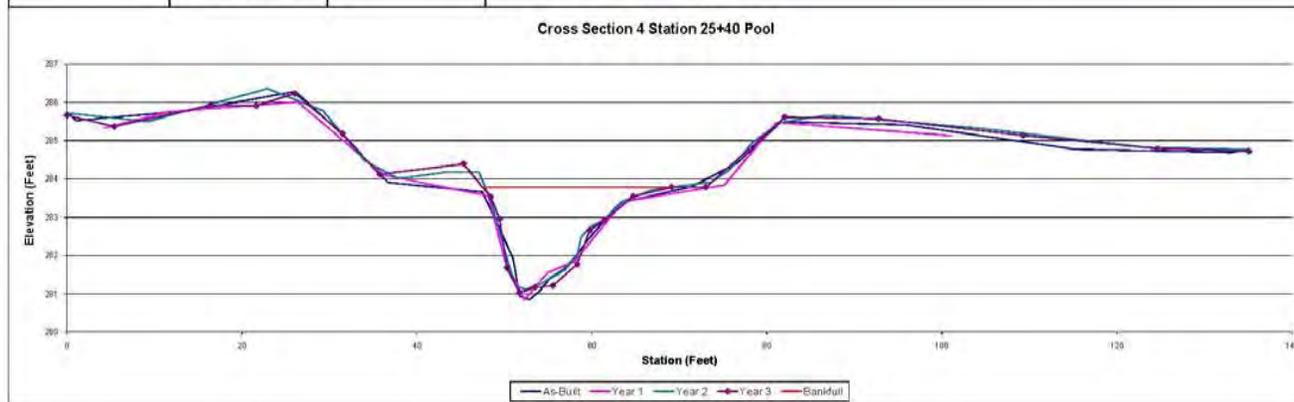


Figure 7. Cross-Section 5

Project		Summary (bankfull)				
Project	Little Beaver Creek	MY0	MY1	MY2	MY3	
Cross Section	Cross Section 5	A (BKF)	22.0	44.0	39.0	36.9
Feature	Riffle	W(BKF)	17.1	20.2	30.7	19.4
Station	29+86	Max d	2.5	3.9	3.8	3.7
Date	4/8/10	Mean d	1.3	1.6	1.3	1.9
Crew	BW, RL, SV, ZP	Wd	12.8	19.1	24.1	10.3

MY1-2007			MY2-2008			MY3-2009		
Station	Elevation	Notes	Station	Elevation	Notes	Station	Elevation	Notes
9.759	282.698	XSS	0.00	281.44	LP	0.00	281.43	X5 LP
18.551	282.059	XSS	4.16	281.45		1.80	281.09	
48.367	281.937	XSS	10.87	282.82		4.41	281.69	
53.092	281.674	XSS	19.92	281.96		8.21	282.98	
70.014	279.871	XSSBKF	35.77	281.67		16.13	282.61	
70.928	279.271	XSS	44.29	282.19		18.27	282.16	
72.217	277.638	XSS	52.09	281.67		36.12	281.71	
74.647	276.22	XSS	61.74	281.50	BKF	43.91	282.31	
77.751	279.004	XSS/EOW	64.15	280.98		52.85	281.70	
82.766	281.471	XSSBKF	67.25	280.77		63.32	281.61	
100.074	281.419	XSS	69.23	279.99		67.03	281.32	BKF
115.403	283.957	XSS	70.18	279.67		69.27	280.66	
135.854	283.753	XSS	70.75	278.03	TOE L	70.63	278.23	
			73.75	277.88		73.38	277.78	
			75.46	277.69	TW	74.75	277.90	TW
			77.48	278.22		77.56	278.07	
			77.61	278.35	TOER	78.61	279.83	
			78.32	279.56		80.30	280.38	
			79.80	279.82		84.20	281.50	BKF
			81.46	280.59		88.10	281.68	
			83.50	281.43	BKF	98.13	281.69	
			93.87	281.47		107.88	282.92	
			101.20	281.88		117.43	283.65	
			110.84	283.19		129.61	283.86	X5 RP
			122.73	283.63		137.91	283.93	
			130.67	283.79				
			136.98	283.94				
			137.61	283.92	RP			



Photo of Xs-5, sta 29+86 looking in the downstream direction

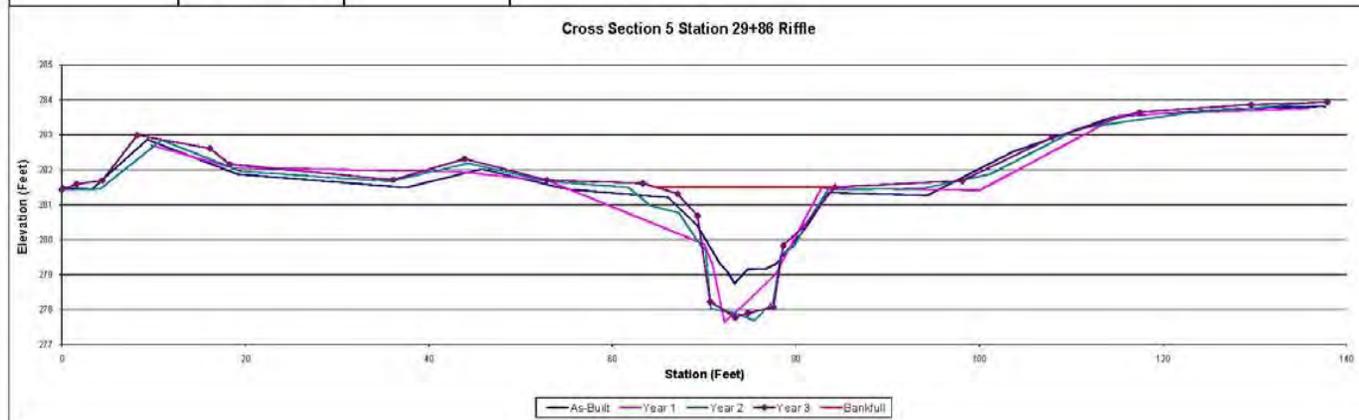


Figure 8. Cross-Section 6

Project			Summary (bankfull)						
Project	Little Beaver Creek			MY0	MY1	MY2	MY3		
Cross Section	Cross Section 5								
Feature	Rifle		A (BKF)	20.1	20.5	20.8	19.0		
Station	33+28		W(BKF)	18.6	21.7	19.6	19.9		
Date	4/8/10		Max d	1.8	2.3	1.8	1.7		
Crew	BW, RL, SV, ZP		Meand	1.1	1.2	1.1	1.0		
			WD	17.2	18.4	18.2	20.9		

MY1-2007			MY2-2008			MY3-2009		
Station	Elevation	Notes	Station	Elevation	Notes	Station	Elevation	Notes
19.292	282.021	X6	0.00	281.75	LP	0.00	281.76	X6 LP
33.812	281.877	X6	12.51	282.05		1.62	282.00	
55.538	280.599	X8	36.06	281.09		21.24	282.07	
65.114	278.96	X6BKF	48.26	281.20		39.11	281.69	
77.748	278.452	X6	58.49	280.72		53.78	281.11	
83.532	276.312	X6	64.05	279.71		58.38	280.56	
85.261	276.122	X6TW	67.61	278.80		71.27	278.93	
88.145	276.199	X6	80.05	278.25	BKF	79.17	278.26	BKF
89.949	276.653	X6EOW	83.66	277.22		81.89	277.79	
94.358	278.308	X6	85.37	277.17		84.59	277.27	
110.838	278.942	X6	86.43	276.97	TCEL	85.73	277.21	
120.705	280.324	X6	89.13	276.46	TW	86.41	276.87	
125.496	280.422	X6	91.70	276.57	TDE R	87.95	276.80	TW
136.128	279.874	X6	94.01	277.07		90.45	276.66	
152.535	281.232	X6	101.28	278.62	BKF	91.97	276.80	
168.928	281.717	X6RPH	115.97	278.81		92.40	276.99	
			134.98	279.45		99.67	277.14	
			153.02	281.31		100.42	278.56	BKF
			172.91	281.76		107.66	278.93	
			186.18	281.93		112.57	278.65	
			189.89	281.85	RP	117.49	278.95	
						128.91	279.48	
						141.96	280.00	
						154.92	281.32	
						173.80	281.85	
						188.24	281.83	
						198.03	281.83	X6 RP



Photo of XS-B, Sta 33+28 looking in the downstream direction

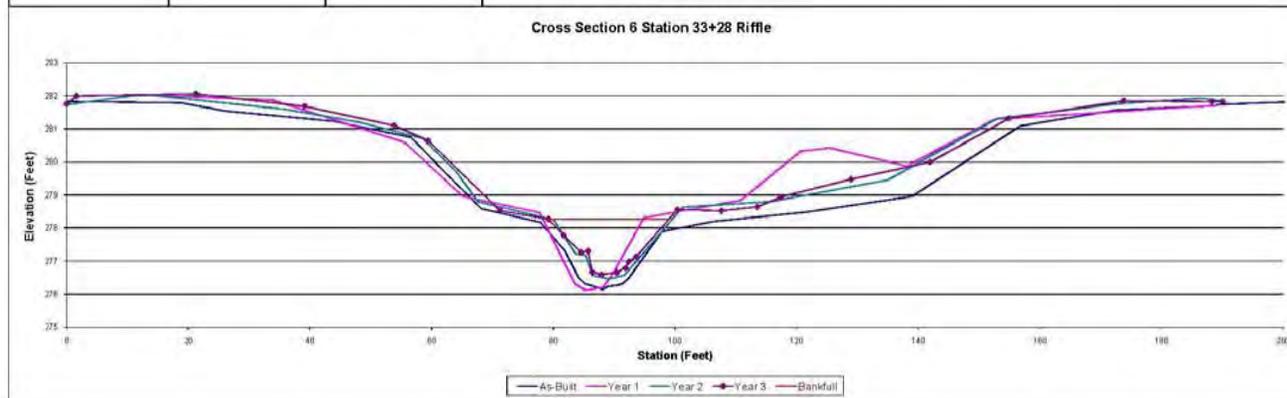


Figure 9. Cross-Section 7

Project		Little Beaver Creek		Summary (bankfull)				
Cross Section		Cross Section 7		A (BKF)	MY0	MY1	MY2	MY3
Feature		Pool		33.6	38.1	34.7	48.3	
Station		36+03		W(BKF)	18.8	19.9	17.7	18.4
Date		4/8/10		Max d	3.2	4.3	4.7	5.5
Crew		BW, RL, SV, ZP		Mean d	1.8	1.9	2.0	2.6
				WD	10.5	10.4	9.0	7.0
MY1-2007		MY2-2008		MY3-2009				
Station	Elevation	Station	Elevation	Station	Elevation	Notes		
0	278.836	X/LRPH	0.00	279.00	UP	0.00	278.30	X7 LP
33.671	279.486	X7	10.98	279.04		0.78	278.97	
80.043	279.431	X7	27.27	279.46		9.10	279.03	
82.978	278.174	X7	51.48	279.82		35.87	279.56	
93.22	278.001	X7	64.37	279.69		47.46	279.89	
99.724	277.739	X7BKF	79.27	279.73		59.29	279.41	
98.349	276.99	X7	84.35	278.44		78.35	279.82	
99.368	276.863	X7	93.18	278.09		83.08	278.54	
100.513	276.5	X7	99.41	277.36	BKF	90.66	279.31	
104.615	275.711	X7	100.05	276.62		94.59	278.12	
105.514	275.836	X7EOW	104.88	275.89		96.51	277.84	BKF
107.136	274.455	X7	106.12	275.59		97.53	277.64	
109.075	273.707	X7TW	106.98	275.56	TOEL	100.27	276.91	
110.653	274.181	X7	108.65	272.99	TW	102.39	276.73	
112.523	276.792	X7	109.62	274.05		103.97	276.51	
113.122	278.052	X7	111.04	274.57		104.82	275.89	
124.51	278.285	BFF	113.90	278.05	BKF	105.08	273.97	
128.632	278.601	X7	119.43	278.21		106.95	272.78	
133.265	280.31	X7	128.11	278.74		109.27	272.10	TW
176.974	280.341	X7	133.95	280.45		110.89	272.72	
190.038	280.536	X7RPB	139.75	280.91		114.35	278.03	BKF
			152.76	280.79		128.12	278.69	
			175.17	280.20		133.87	280.50	
			189.83	280.53	RP	150.92	280.96	
						176.60	280.59	
						189.07	280.57	
						190.59	280.52	X7 RP



Photo of XS-7, Sta 36+03 looking in the downstream direction

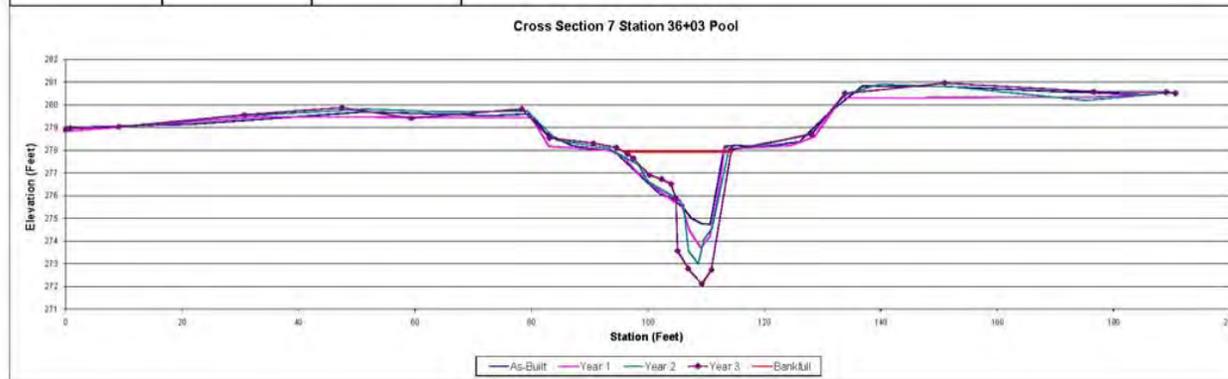


Figure 10. Cross-Section 8

Project		Summary (bankfull)				
Project	Little Beaver Creek	MY0	MY1	MY2	MY3	
Cross Section:	Cross Section 8	A (BKF)	22.9	29.6	27.6	26.5
Feature	Riffle	W (BKF)	16.9	19.5	19.3	20.6
Station:	38+95	Max d	2.3	2.7	2.7	2.8
Date:	4/8/10	Mean d	1.4	1.2	1.4	1.3
Crew:	BV, PL, SV, ZP	W/D	12.5	16.0	13.5	16.0

MY1-2007			MY2-2008			MY3-2009		
Station	Elevation	Notes	Station	Elevation	Notes	Station	Elevation	Notes
0	276.133	X8LPIN	0.00	276.15	LP	-0.02	276.13	X8 LP
25.334	277.525	X8	2.47	278.11		18.03	277.65	
40.752	276.877	X8	9.85	277.93		39.42	277.38	
49.89	274.594	X8	22.03	277.64		44.68	276.72	
57.682	273.884	X8BKF	31.79	277.58		50.67	274.44	
61.183	273.676	X8	38.64	277.39		57.06	274.31	BKF
64.709	271.887	X8	44.38	276.75		59.93	273.99	
66.321	271.478	X8	50.52	274.81		63.01	273.17	
69.8	271.212	X8TW	52.99	274.23		64.65	272.44	
70.922	272.187	X8EOV	58.74	274.18	BKF	65.79	271.65	
76.153	273.83	X8EOV	61.64	273.66		68.12	271.38	TW
82.659	274.11	X8	63.35	272.96		69.99	271.31	
88.153	274.343	X8	65.41	272.25		70.78	271.50	
96.616	275.246	X8	68.33	271.57	TOEL	71.64	272.43	
104.537	274.307	X8	68.42	271.39	TW	72.81	272.80	
104.8	274.305	X8	71.34	271.44	TOER	75.80	273.66	
106.021	272.985	X8	72.72	272.41		78.62	274.09	BKF
111.011	274.269	X8	73.29	272.74		80.32	274.33	
117.043	276.938	X8	78.73	274.06	BKF	84.99	274.34	
			83.12	274.09		106.97	273.39	
			88.92	274.30		110.63	274.28	
			92.04	274.85		121.02	277.53	
			95.82	275.12		134.12	277.53	
			98.59	274.86		142.08	277.68	X8 RP
			101.95	274.15				
			104.80	273.44				
			110.58	274.27				
			115.42	276.02				
			118.97	277.14				



Photo of XS-8, Sta 38+95 looking in the downstream direction

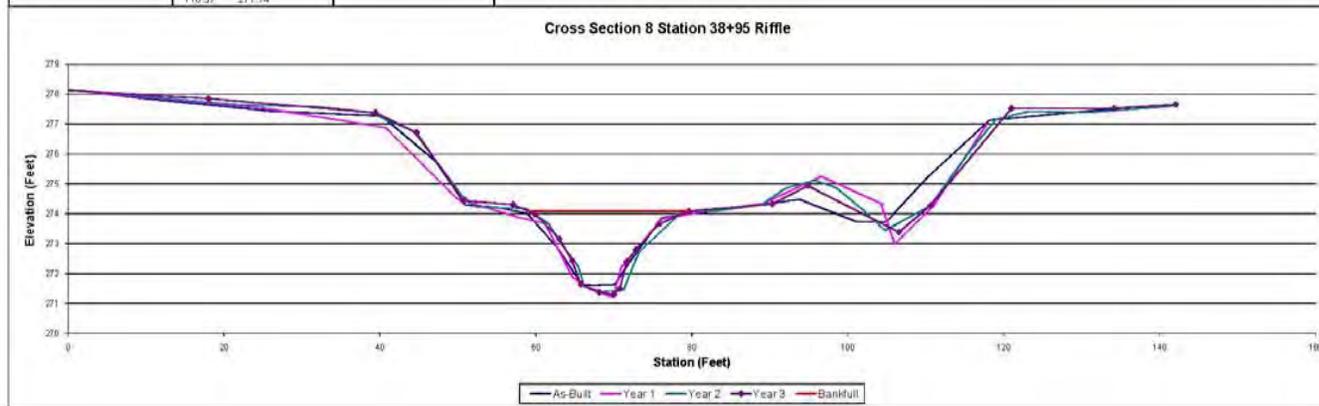


Figure 11. Cross-Section T1

Project		Summary (bankfull)					
Project	Little Beaver Creek						
Cross Section	Cross Section T1 (Tributary)						
Feature	Rim	A (BKF)	5.0	10.7	6.6	5.2	
Station	11+63	W (BKF)	9.4	12.5	14.0	15.1	
Date	4/8/10	Max d	1.1	2.0	1.6	1.5	
Crew	BW, RL, SV, ZP	Mean d	0.6	0.9	0.6	0.6	
		W/D	14.8	14.8	22.2	24.6	

MY1-2007			MY2-2008			MY3-2009		
Station	Elevation	Notes	Station	Elevation	Notes	Station	Elevation	Notes
0	291.686	XT1 LP RR	0.00	290.53		0.01	290.58	XT1 LP
19.848	291.124	XT1	11.94	291.21		19.84	291.21	
38.653	291.332	XT1	24.13	291.26		39.00	291.36	
47.673	289.254	XT1	34.65	291.43		56.56	287.25	
54.181	287.426	XT1	40.39	291.22		64.95	286.96	BKF
64.276	287.419	XT1	46.69	290.03		67.90	286.96	
63.34	287.019	XT1 BKF	53.82	287.74		68.70	286.98	
67.412	286.556	XT1	57.40	287.14		69.22	285.71	
67.498	286.002	XT1 EOW	64.23	287.03	BKF	71.06	285.58	TW
67.551	285.618	XT1 EOW	68.85	286.45		72.26	285.63	
68.876	284.979	XT1 TW	63.36	285.58	TOE L	74.47	286.76	
70.254	285.407	XT1 TW	71.06	285.48	TW	75.82	287.23	BKF
71.042	285.366	XT1 TW	72.15	285.78	TOE R	83.45	287.17	
72.563	285.816	XT1 EOW	74.08	286.71		83.65	289.61	
73.202	286.692	XT1 BKF	75.53	287.11	BKF	114.60	290.29	
77.762	287.263	XT1 BKF	73.64	287.07		127.56	290.51	XT1 RP
83.723	287.24	XT1	84.39	287.20				
90.119	288.991	XT1	88.37	286.34				
99.126	290.447	XT1	94.57	290.12				
109.917	290.206	XT1	101.47	290.77				
			107.80	290.12				
			117.09	290.33				
			121.67	290.83				
			124.62	290.50				
			127.63	290.51	RP			



Photo of XS-T1, Sta 11+63 looking in the downstream direction

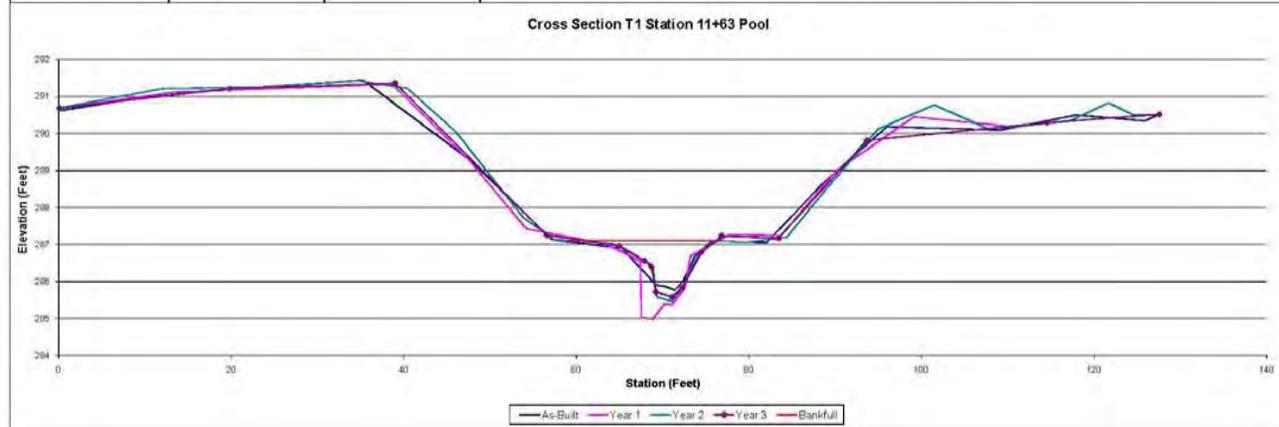


Figure 12. Cross-Section T2

Project: Little Beaver Creek		Summary (bankfull)			
Cross Section:	Cross Section T2 (Tributary)	MY0	MY1	MY2	MY3
Feature:	Pool	A (BKF)	6.0	9.1	10.0
Station:	12+89	W (BKF)	11.6	13.8	12.6
Date:	4/8/10	Max d	1.5	1.8	1.9
Crew:	BW, RL, SV, ZP	Meand	0.8	0.7	0.6
		W/D	15.5	21.0	15.9

MY1-2007			MY2-2008			MY3-2009		
Station	Elevation	Notes	Station	Elevation	Notes	Station	Elevation	Notes
29.046	290.148	XT2	0.00	290.32	LP	0.00	290.39	XT2 LP
46.945	289.666	XT2	4.97	290.18		16.72	290.21	
56.845	286.786	XT2	22.13	290.16		32.94	290.19	
66.579	286.049	XT2BKF	34.82	290.22		47.52	290.05	
66.135	285.334	XT2EQW	47.28	290.07		56.93	286.83	
69.29	284.743	XT2	51.86	288.92		60.65	286.43	
71.111	284.854	XT2	55.59	287.23		64.94	286.39	BKF
71.615	285.310	XT2EQW	57.60	286.63		66.27	286.15	
72.662	285.518	XT2	60.91	286.43		68.81	284.43	TW
77.88	286.337	XT2	65.64	286.26	BKF	68.87	284.41	
83.882	286.144	XT2	67.16	285.80		69.98	284.51	
102.17	286.792	XT2	68.21	285.09	TOEL	72.06	285.69	
113.043	287.853	XT2	68.62	284.61		77.49	286.30	BKF
122.497	288.979	XT2	69.20	284.48	TW	97.56	286.55	
			70.34	284.74		103.98	287.08	
			70.84	285.11	TOEL	122.34	289.13	
			73.06	285.77		130.76	288.98	XT2 RP
			76.79	286.34	BKF			
			91.66	286.33				
			98.02	286.49				
			119.42	288.08				
			122.83	288.99				
			130.76	288.98	RP			



Photo of XS-T2, Sta 12+89 looking in the downstream direction

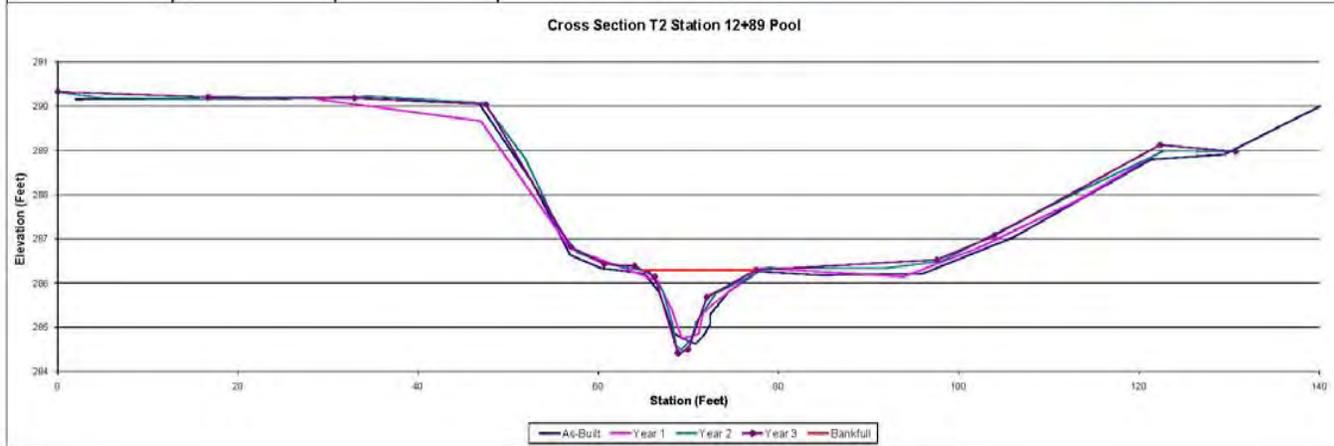


Figure 13. Longitudinal Profile – Main channel Reach 1

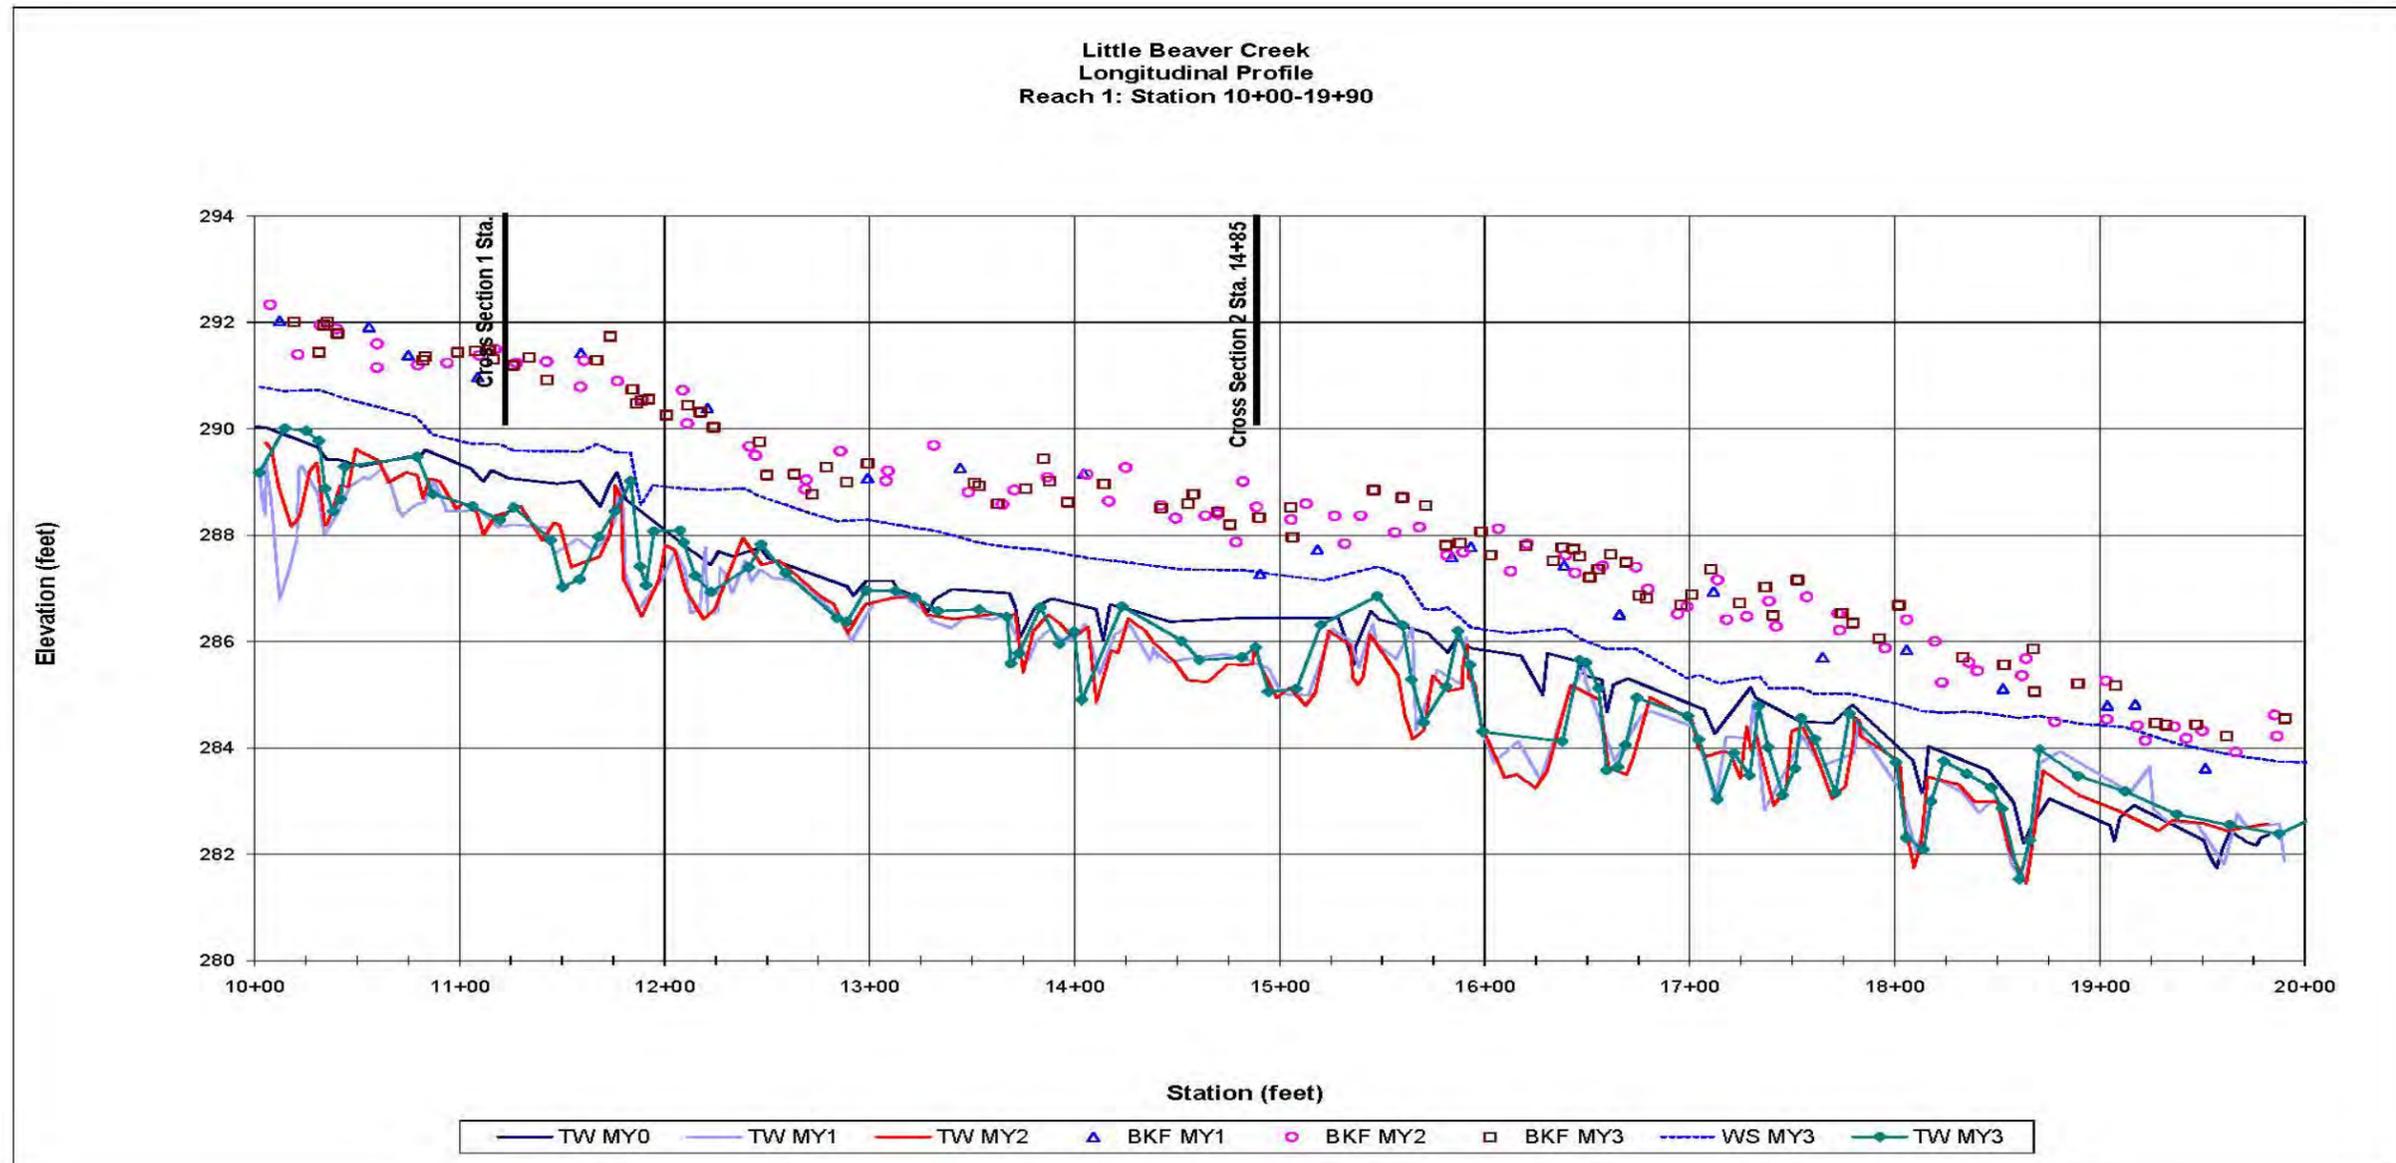


Figure 14. Longitudinal Profile – Main channel Reach 2

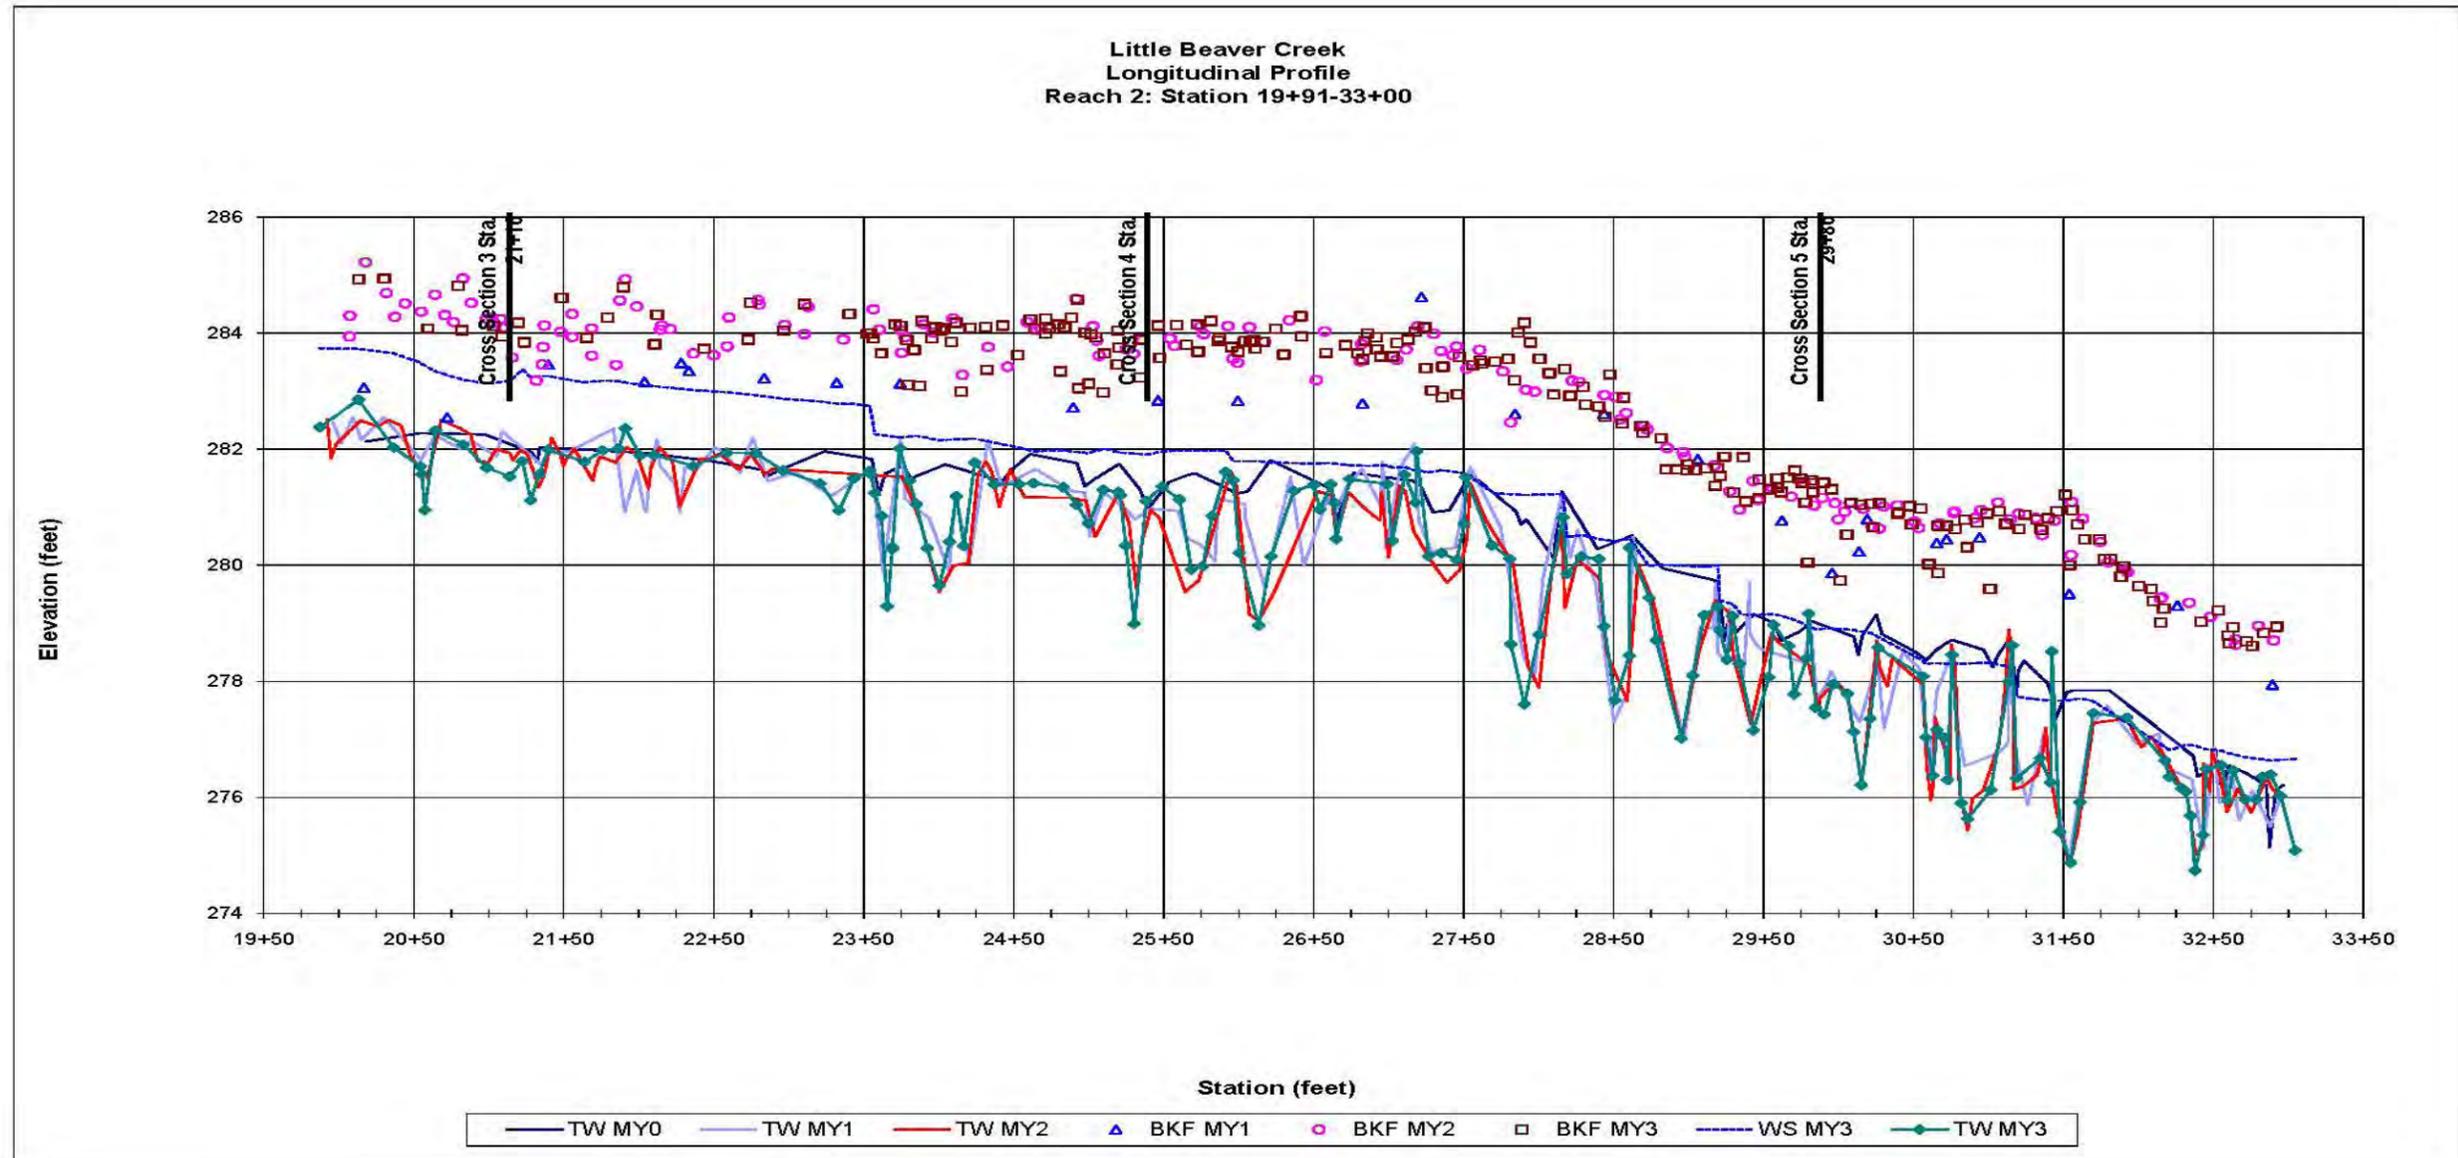


Figure 15. Longitudinal Profile – Main channel Reach 3a

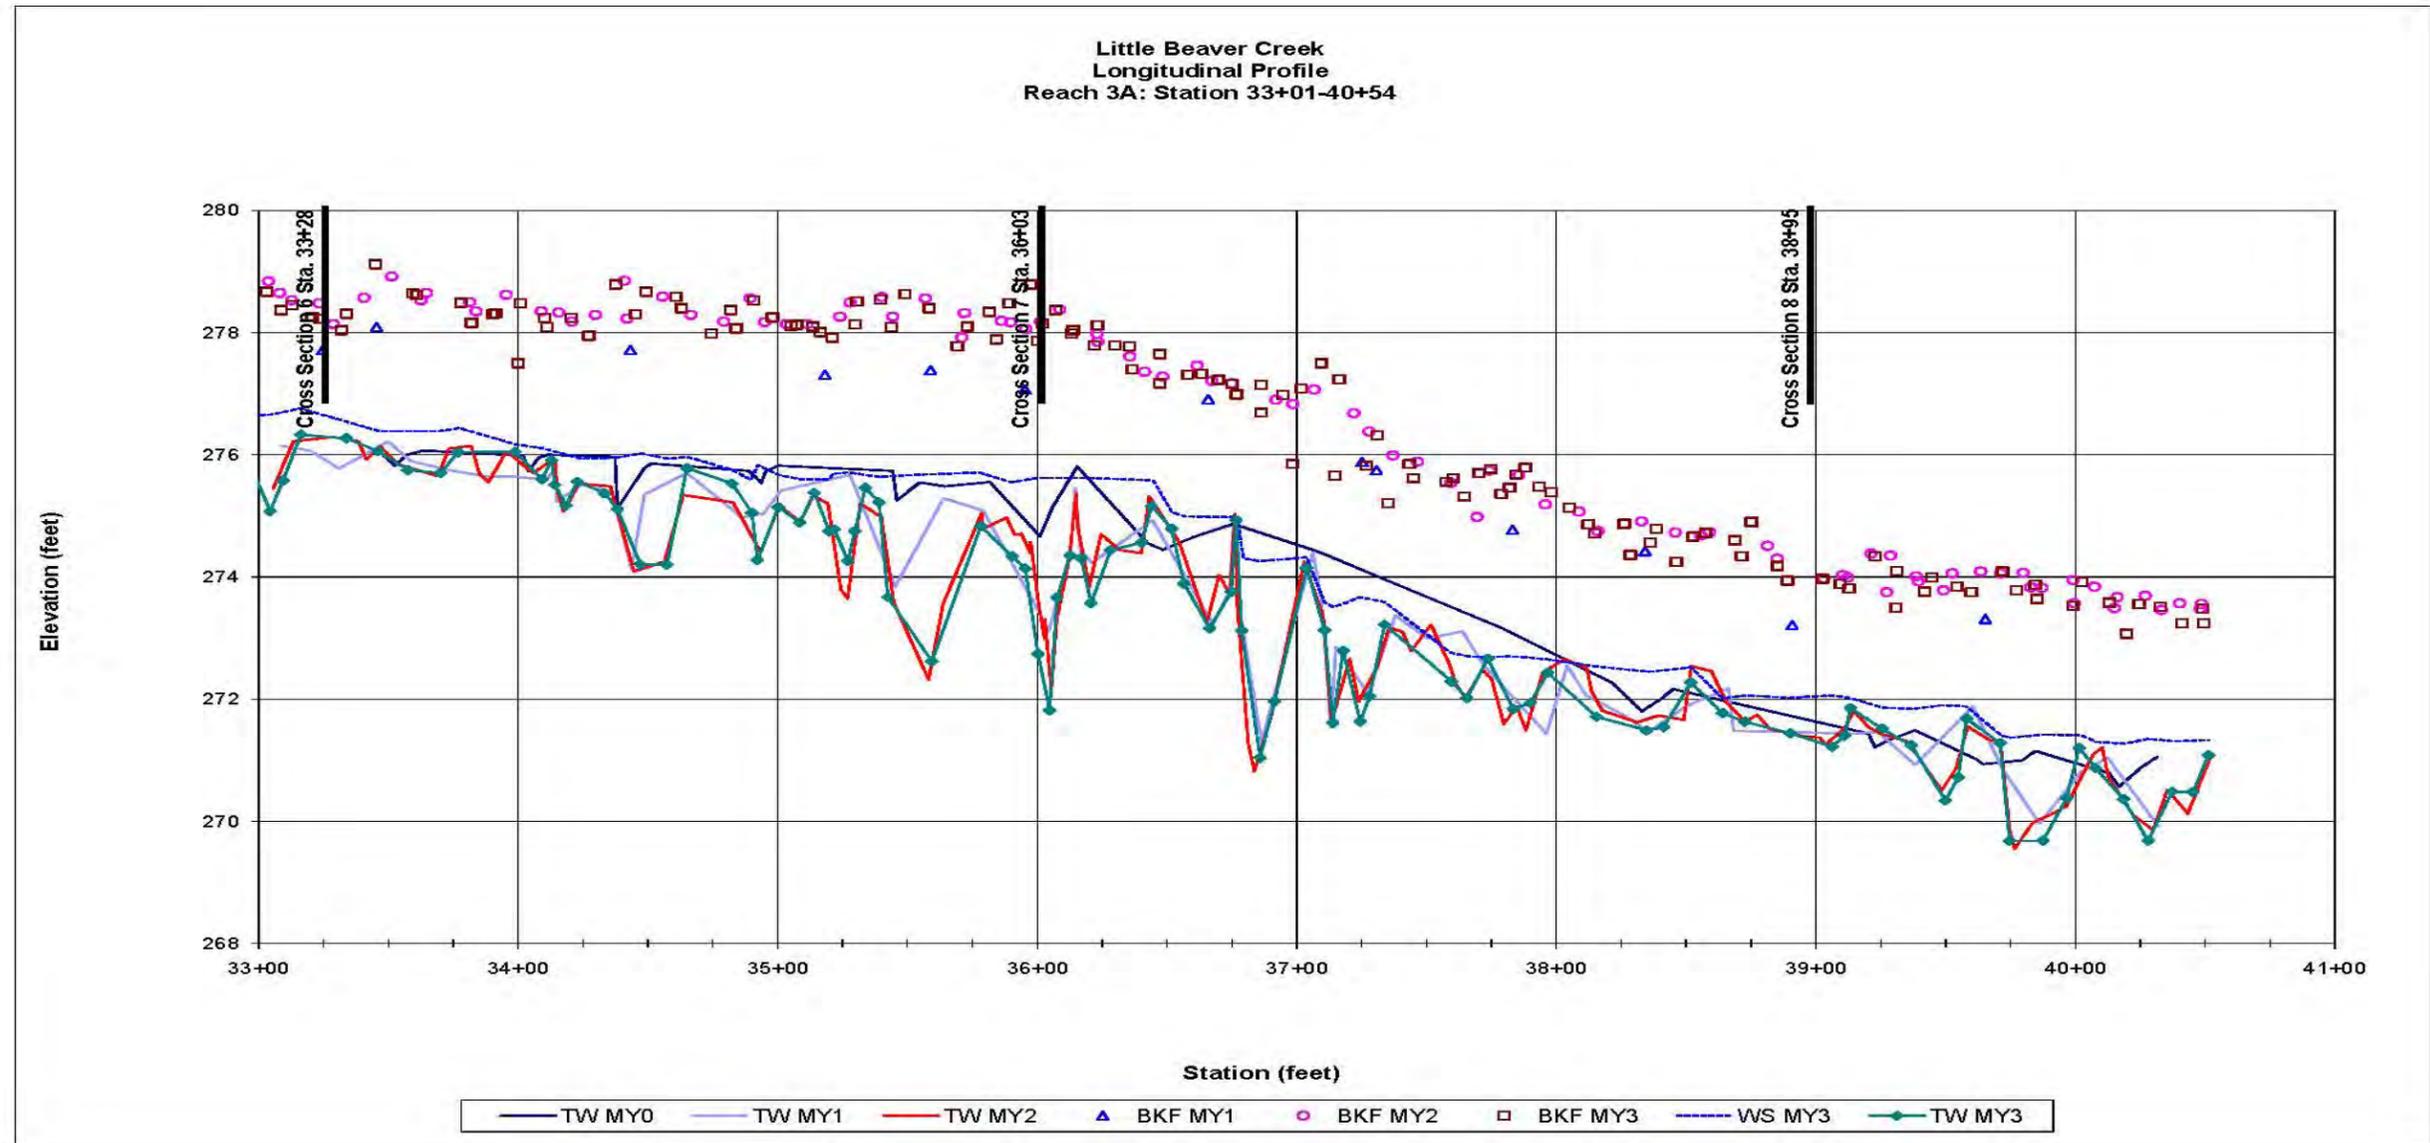


Figure 16. Longitudinal Profile – Main channel Reach T1

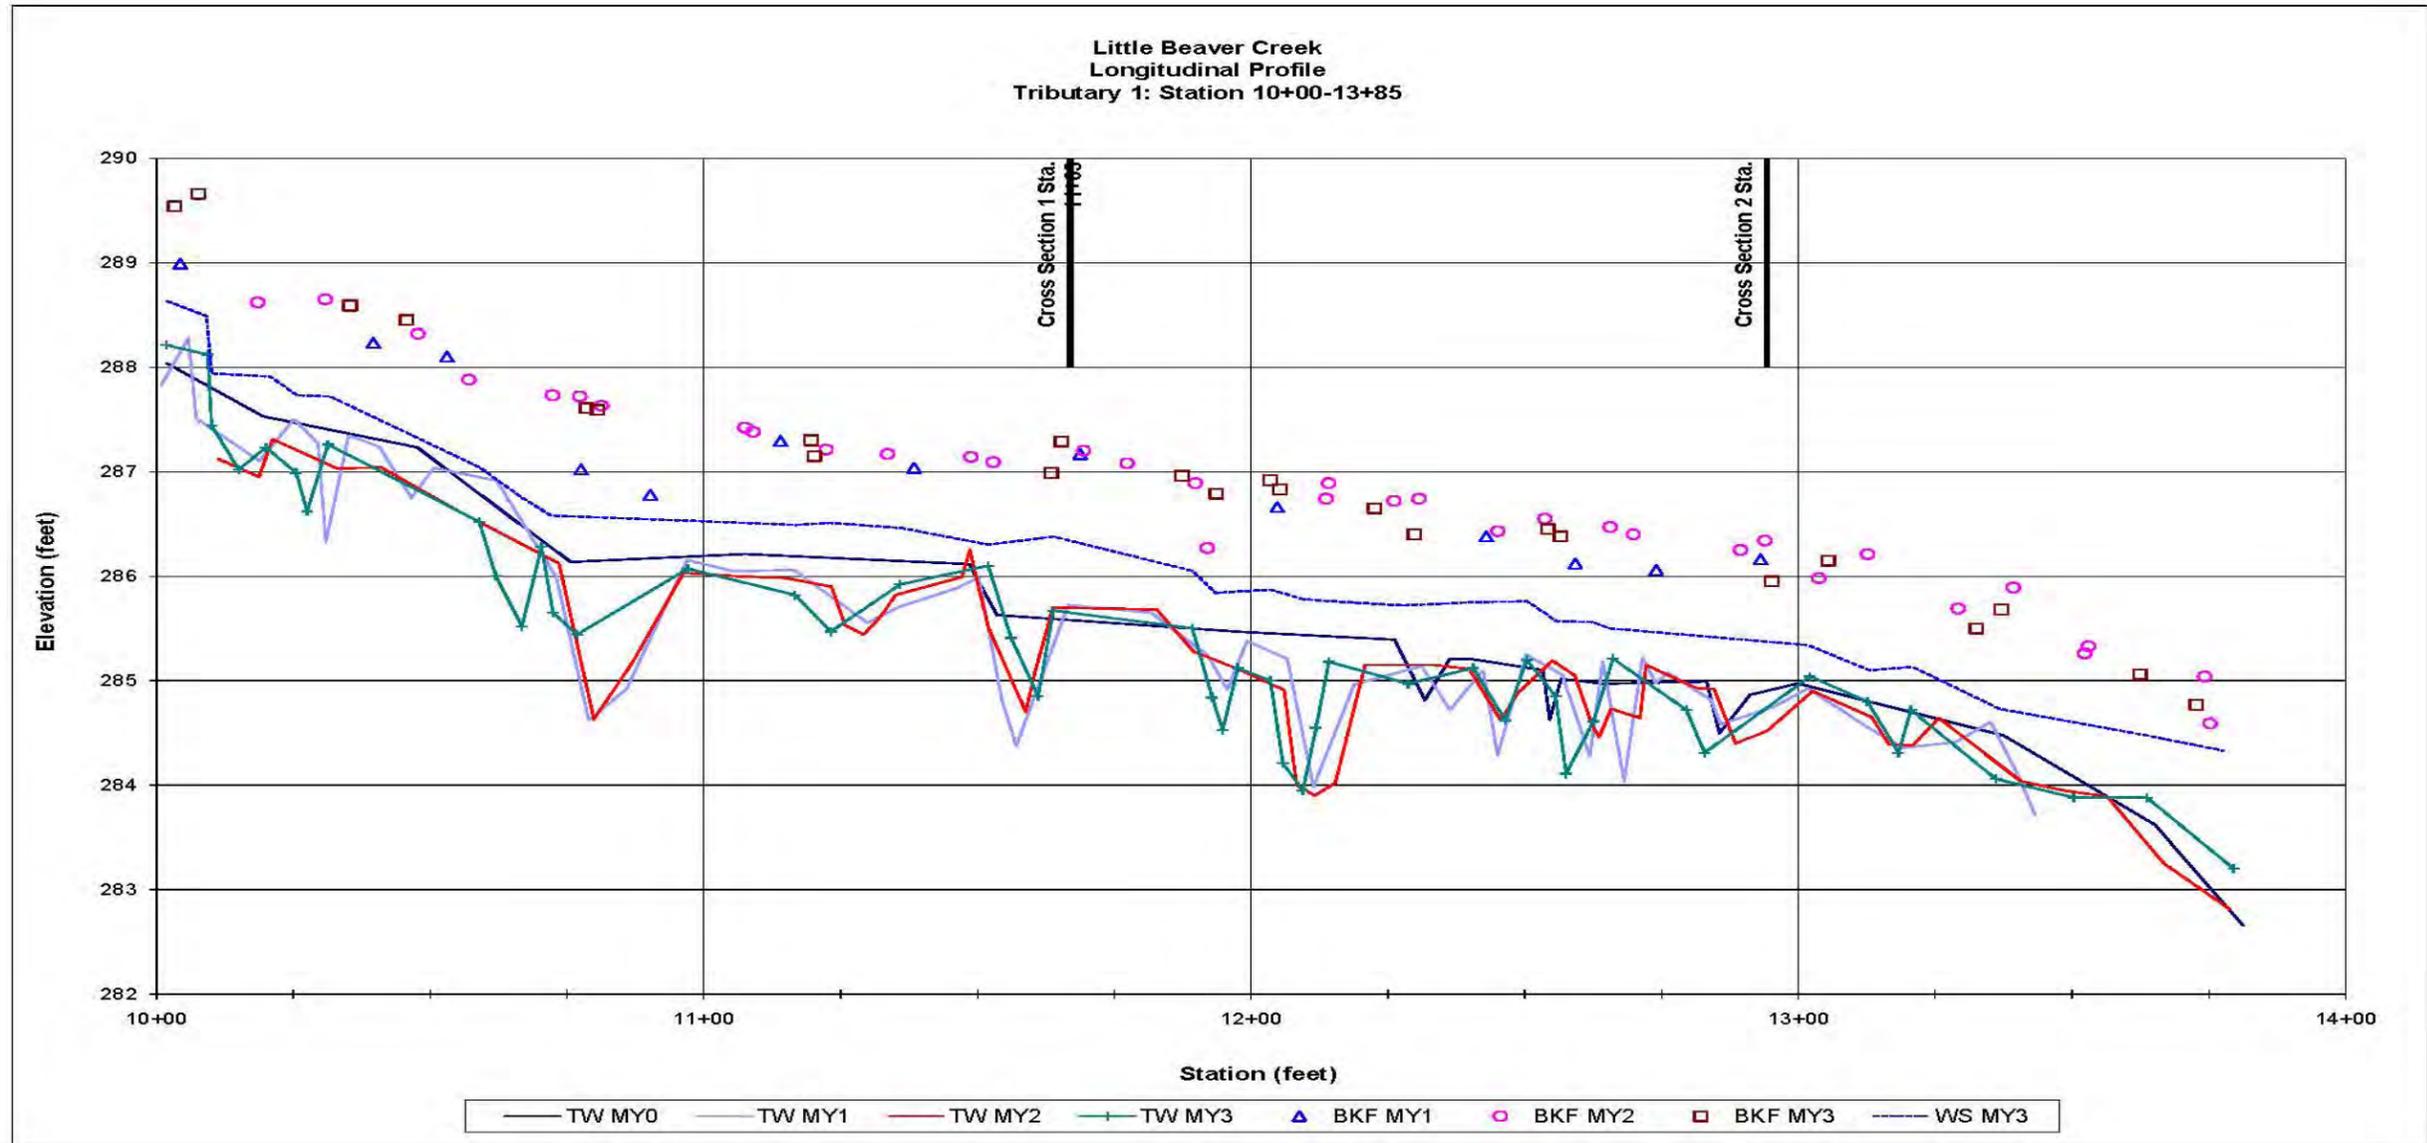


Figure 17. Longitudinal Profile – Main channel Reach T2


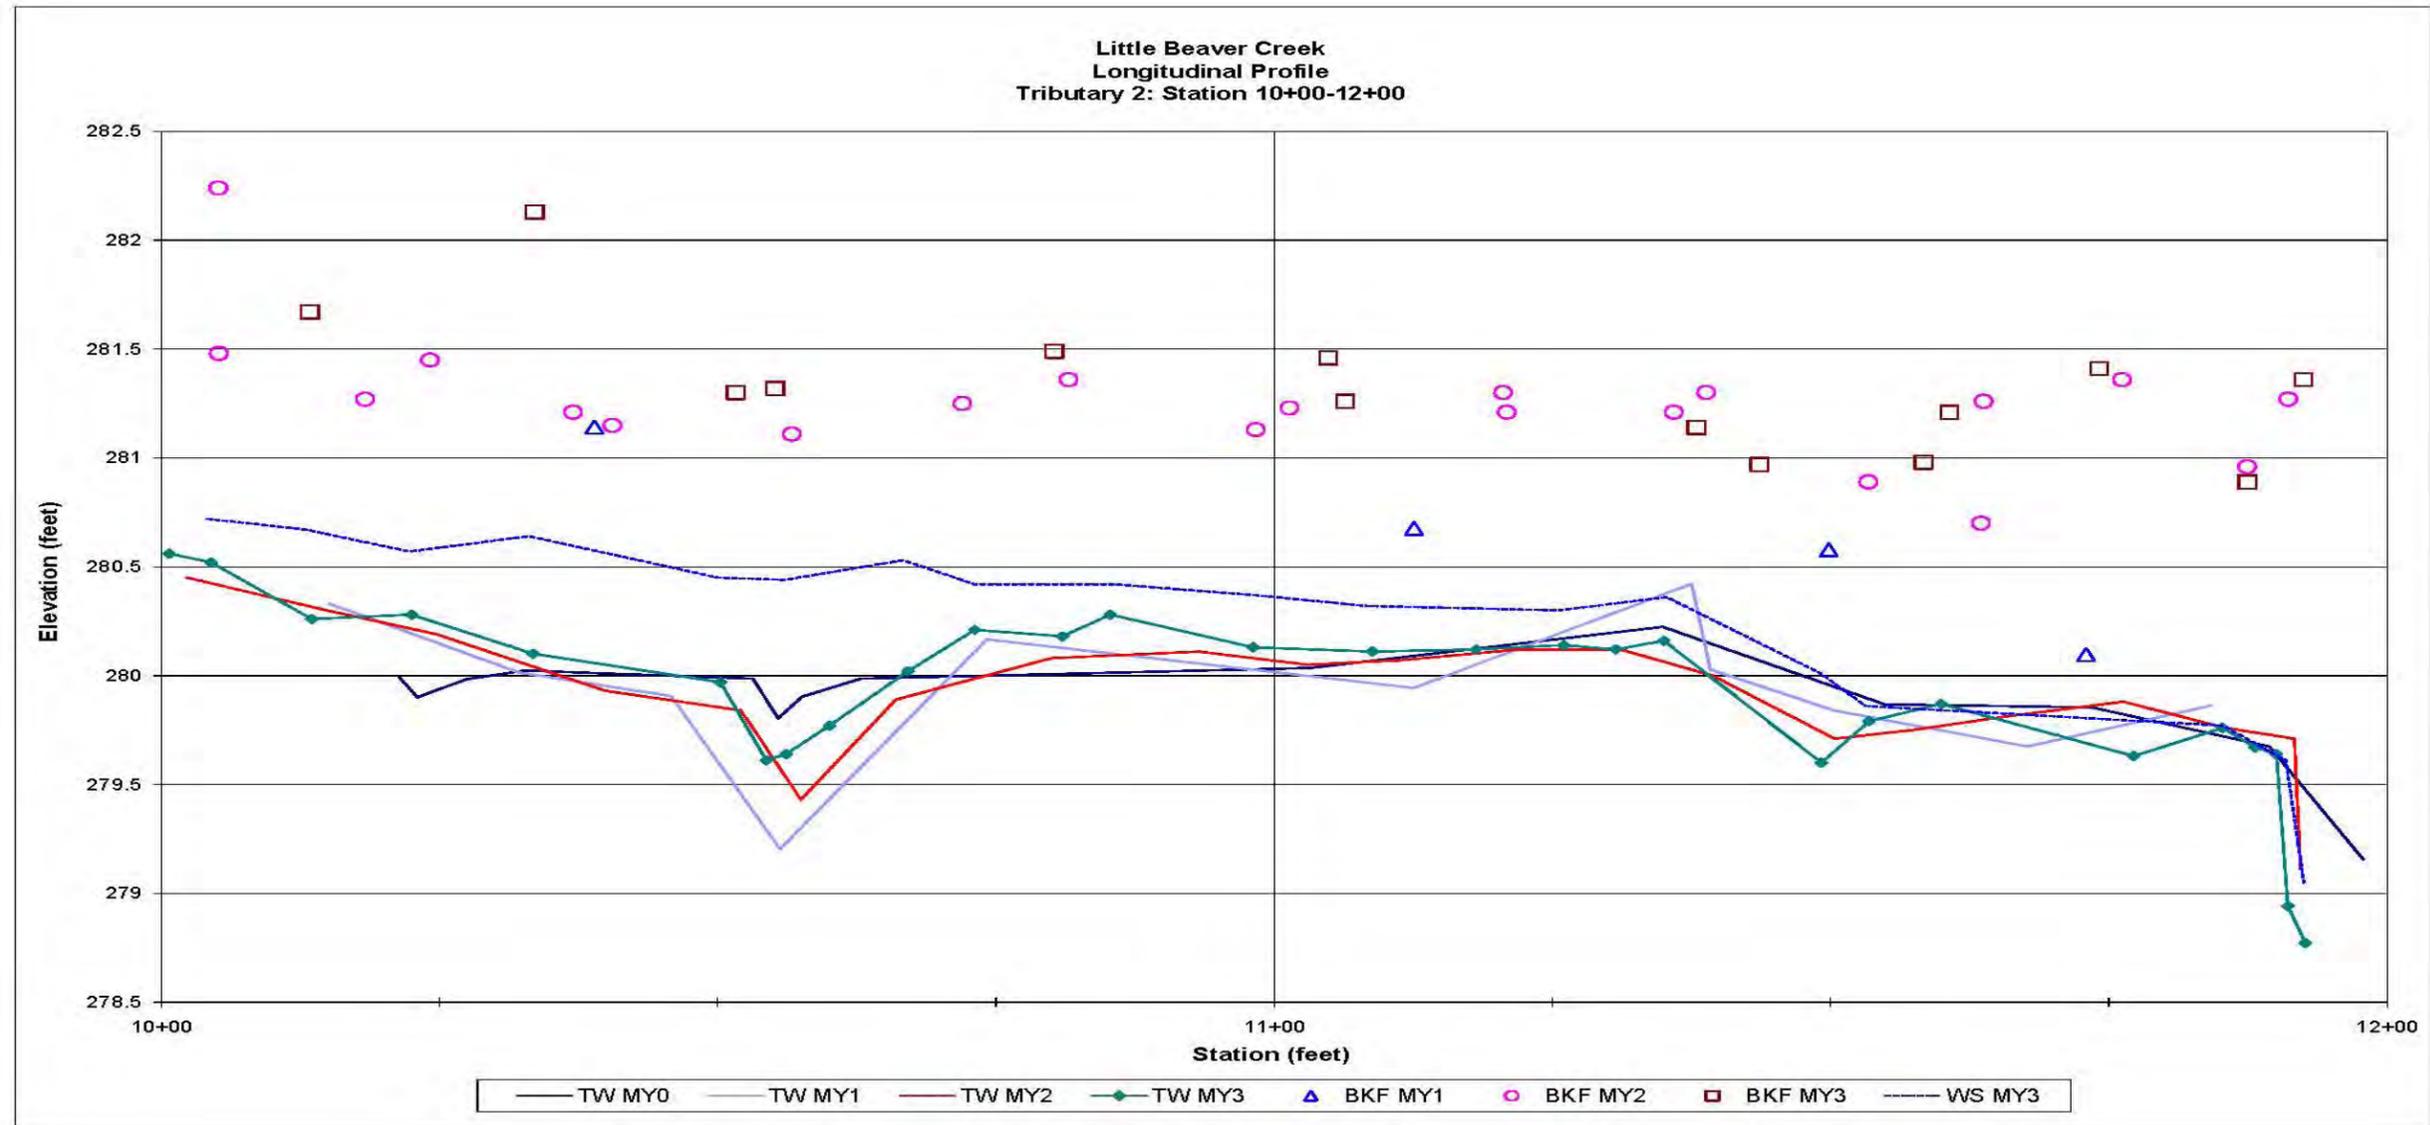


Figure 18. Pebble Count Plots – Little Beaver Creek (EEP)

PEBBLE COUNT								
Project: Little Beaver Creek Monitoring MY-03						Date: 4/8/2010		
Location: Cross Section #1								
Particle Counts								
Inches	Particle	Millimeter	S/C	Riffles	Pools	Total No.	Item %	% Cumulative
	Silt/Clay	< 0.062	S/C	2	0	2	2%	2%
	Very Fine	.062 - .125	S	3	0	3	3%	5%
	Fine	.125 - .25	A	6	0	6	6%	11%
	Medium	.25 - .50	N	30	0	30	29%	40%
	Coarse	.50 - 1.0	D	34	0	34	33%	74%
04 - 08	Very Coarse	1.0 - 2.0	S	21	0	21	21%	94%
08 - 16	Very Fine	2.0 - 4.0		0	0	0	0%	94%
16 - 22	Fine	4.0 - 5.7	G	2	0	2	2%	96%
22 - 31	Fine	5.7 - 8.0	R	0	0	0	0%	96%
31 - 44	Medium	8.0 - 11.3	A	0	0	0	0%	96%
44 - 63	Medium	11.3 - 16.0	V	1	0	1	1%	97%
63 - 89	Coarse	16.0 - 22.6	E	0	0	0	0%	97%
89 - 1.26	Coarse	22.6 - 32.0	L	0	0	0	0%	97%
1.26 - 1.77	Very Coarse	32.0 - 45.0	S	0	0	0	0%	97%
1.77 - 2.5	Very Coarse	45.0 - 64.0		0	0	0	0%	97%
2.5 - 3.5	Small	64 - 90	C	0	0	0	0%	97%
3.5 - 5.0	Small	90 - 128	O	1	0	1	1%	98%
5.0 - 7.1	Large	128 - 180	B	0	0	0	0%	98%
7.1 - 10.1	Large	180 - 256	L	1	0	1	1%	99%
10.1 - 14.3	Small	256 - 362	B	1	0	1	1%	100%
14.3 - 20	Small	362 - 512	L	0	0	0	0%	100%
20 - 40	Medium	512 - 1024	D	0	0	0	0%	100%
40 - 80	Lrg- Very Lrg	1024 - 2048	R	0	0	0	0%	100%
	Bedrock		BDRK		0	0	0%	100%
Totals				102	0	102	100%	100%


d16	d35	d50	d84	d95
0.3	0.5	0.6	1.5	4.9

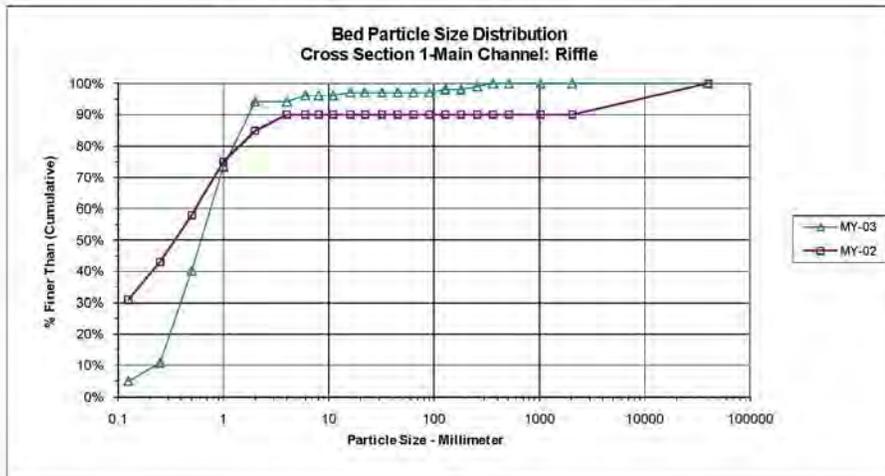

#221)


PEBBLE COUNT								
Project: Little Beaver Creek Monitoring MY-03					Date: 4/8/2010			
Location: Cross Section #3								
Particle Counts								
Inches	Particle	Millimeter	S/C	Riffles	Pools	Total No	Item %	% Cumulative
	Silt/Clay	< 0.062	S/C	25	0	25	25%	25%
.04 - .08	Very Fine	.062 - .125	S	25	0	25	25%	50%
	Fine	.125 - .25	A	15	0	15	15%	65%
	Medium	.25 - .50	N	5	0	5	5%	70%
	Coarse	.50 - 1.0	D	15	0	15	15%	85%
	Very Coarse	1.0 - 2.0	S	8	0	8	8%	93%
.08 - .16	Very Fine	2.0 - 4.0		0	0	0	0%	93%
.16 - .22	Fine	4.0 - 5.7	G	0	0	0	0%	93%
.22 - .31	Fine	5.7 - 8.0	R	2	0	2	2%	95%
.31 - .44	Medium	8.0 - 11.3	A	1	0	1	1%	96%
.44 - .63	Medium	11.3 - 16.0	V	3	0	3	3%	99%
.63 - .89	Coarse	16.0 - 22.6	E	1	0	1	1%	100%
.89 - 1.26	Coarse	22.6 - 32.0	L	0	0	0	0%	100%
1.26 - 1.77	Very Coarse	32.0 - 45.0	S	0	0	0	0%	100%
1.77 - 2.5	Very Coarse	45.0 - 64.0		0	0	0	0%	100%
2.5 - 3.5	Small	64 - 90	C	0	0	0	0%	100%
3.5 - 5.0	Small	90 - 128	O	0	0	0	0%	100%
5.0 - 7.1	Large	128 - 180	B	0	0	0	0%	100%
7.1 - 10.1	Large	180 - 256	L	0	0	0	0%	100%
10.1 - 14.3	Small	256 - 362	B	0	0	0	0%	100%
14.3 - 20	Small	362 - 512	L	0	0	0	0%	100%
20 - 40	Medium	512 - 1024	D	0	0	0	0%	100%
40 - 80	Lrg- Very Lrg	1024 - 2048	R	0	0	0	0%	100%
	Bedrock		BDRK		0	0	0%	100%
Totals				100	0	100	100%	100%

d16	d35	d50	d84	d95
silt/clay	0.05	0.13	1.0	8.0

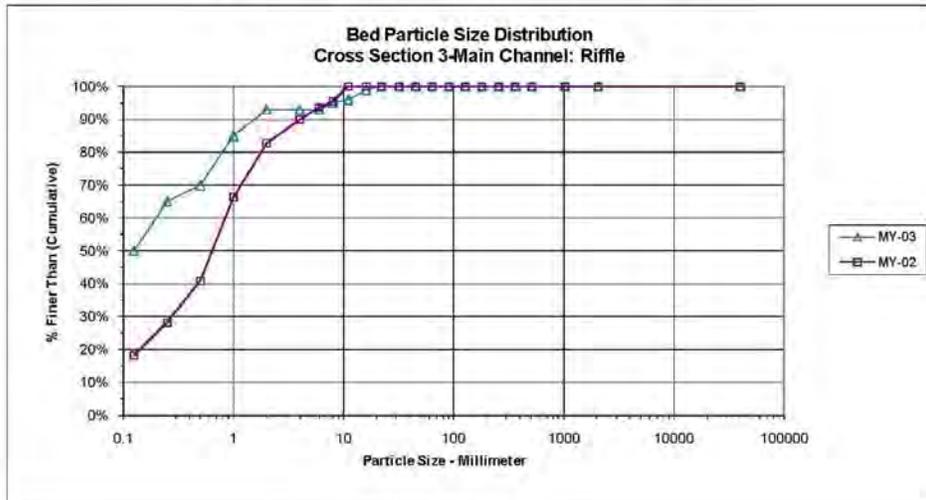


PEBBLE COUNT								
Project: Little Beaver Creek Monitoring MY-03						Date: 4/8/2010		
Location: Cross Section #5								
Particle Counts								
Inches	Particle	Millimeter	S/C	Riffles	Pools	Total No	Item %	% Cumulative
	Silt/Clay	< 0.062	S/C	3	0	3	3%	3%
.04 - .08	Very Fine	.062 - .125	S	0	0	0	0%	3%
	Fine	.125 - .25	A	5	0	5	4%	7%
	Medium	.25 - .50	N	5	0	5	4%	12%
	Coarse	.50 - 1.0	D	16	0	16	14%	26%
	Very Coarse	1.0 - 2.0	S	13	0	13	12%	37%
.08 - .16	Very Fine	2.0 - 4.0		15	0	15	13%	50%
.16 - .22	Fine	4.0 - 5.7	G	3	0	3	3%	53%
.22 - .31	Fine	5.7 - 8.0	R	9	0	9	8%	61%
.31 - .44	Medium	8.0 - 11.3	A	5	0	5	4%	65%
.44 - .63	Medium	11.3 - 16.0	V	7	0	7	6%	72%
.63 - .89	Coarse	16.0 - 22.6	E	9	0	9	8%	80%
.89 - 1.26	Coarse	22.6 - 32.0	L	10	0	10	9%	88%
1.26 - 1.77	Very Coarse	32.0 - 45.0	S	4	0	4	4%	92%
1.77 - 2.5	Very Coarse	45.0 - 64.0		6	0	6	5%	97%
2.5 - 3.5	Small	64 - 90	C	3	0	3	3%	100%
3.5 - 5.0	Small	90 - 128	O	0	0	0	0%	100%
5.0 - 7.1	Large	128 - 180	B	0	0	0	0%	100%
7.1 - 10.1	Large	180 - 256	L	0	0	0	0%	100%
10.1 - 14.3	Small	256 - 362	B	0	0	0	0%	100%
14.3 - 20	Small	362 - 512	L	0	0	0	0%	100%
20 - 40	Medium	512 - 1024	D	0	0	0	0%	100%
40 - 80	Lrg- Very Lrg	1024 - 2048	R	0	0	0	0%	100%
	Bedrock		BDRK		0	0	0%	100%
Totals				113	0	113	100%	100%

	d16	d35	d50	d84	d95
silt/clay	1.81	3.93	26.9	55.6	

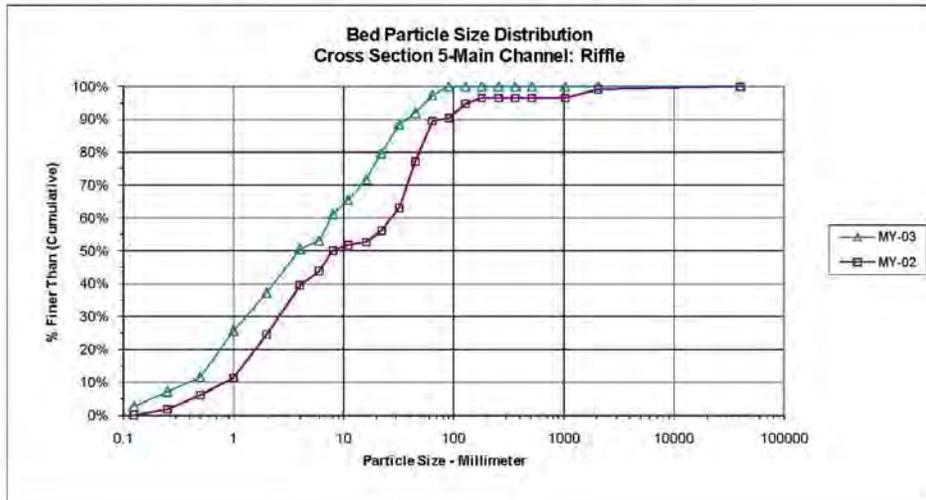


PEBBLE COUNT								
Project: Little Beaver Creek Monitoring MY-03					Date: 4/8/2010			
Location: Cross Section #6								
Particle Counts								
Inches	Particle	Millimeter	S/C	Riffles	Pools	Total No	Item %	% Cumulative
	Silt/Clay	< 0.062	S/C	1	0	1	1%	1%
.04 - .08	Very Fine	.062 - .125	S	1	0	1	1%	2%
	Fine	.125 - .25	A	1	0	1	1%	3%
	Medium	.25 - .50	N	9	0	9	9%	12%
	Coarse	.50 - 1.0	D	2	0	2	2%	14%
	Very Coarse	1.0 - 2.0	S	12	0	12	12%	26%
.08 - .16	Very Fine	2.0 - 4.0		2	0	2	2%	28%
.16 - .22	Fine	4.0 - 5.7	G	1	0	1	1%	29%
.22 - .31	Fine	5.7 - 8.0	R	6	0	6	6%	35%
.31 - .44	Medium	8.0 - 11.3	A	12	0	12	12%	47%
.44 - .63	Medium	11.3 - 16.0	V	20	0	20	20%	66%
.63 - .89	Coarse	16.0 - 22.6	E	21	0	21	21%	87%
.89 - 1.26	Coarse	22.6 - 32.0	L	7	0	7	7%	94%
1.26 - 1.77	Very Coarse	32.0 - 45.0	S	5	0	5	5%	99%
1.77 - 2.5	Very Coarse	45.0 - 64.0		1	0	1	1%	100%
2.5 - 3.5	Small	64 - 90	C	0	0	0	0%	100%
3.5 - 5.0	Small	90 - 128	O	0	0	0	0%	100%
5.0 - 7.1	Large	128 - 180	B	0	0	0	0%	100%
7.1 - 10.1	Large	180 - 256	L	0	0	0	0%	100%
10.1 - 14.3	Small	256 - 362	B	0	0	0	0%	100%
14.3 - 20	Small	362 - 512	L	0	0	0	0%	100%
20 - 40	Medium	512 - 1024	D	0	0	0	0%	100%
40 - 80	Lrg- Very Lrg	1024 - 2048	R	0	0	0	0%	100%
	Bedrock		BDRK	0	0	0	0%	100%
Totals				101	0	101	100%	100%

d16	d35	d50	d84	d95
1.2	6.1	11.9	21.1	34.5

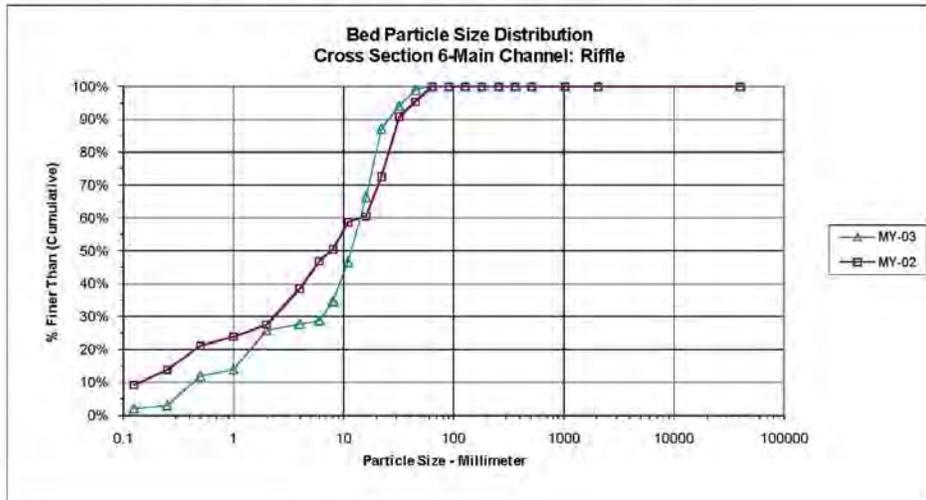


PEBBLE COUNT								
Project: Little Beaver Creek Monitoring MY-03					Date: 4/8/2010			
Location: Cross Section #8								
Particle Counts								
Inches	Particle	Millimeter	S/C	Riffles	Pools	Total No	Item %	% Cumulative
	Silt/Clay	< 0.062	S/C	8	0	8	8%	8%
.04 - .08	Very Fine	.062 - .125	S	8	0	8	8%	16%
	Fine	.125 - .25	A	15	0	15	15%	30%
	Medium	.25 - .50	N	9	0	9	9%	39%
	Coarse	.50 - 1.0	D	6	0	6	6%	45%
	Very Coarse	1.0 - 2.0	S	5	0	5	5%	50%
.08 - .16	Very Fine	2.0 - 4.0		0	0	0	0%	50%
.16 - .22	Fine	4.0 - 5.7	G	0	0	0	0%	50%
.22 - .31	Fine	5.7 - 8.0	R	0	0	0	0%	50%
.31 - .44	Medium	8.0 - 11.3	A	0	0	0	0%	50%
.44 - .63	Medium	11.3 - 16.0	V	2	0	2	2%	51%
.63 - .89	Coarse	16.0 - 22.6	E	0	0	0	0%	51%
.89 - 1.26	Coarse	22.6 - 32.0	L	0	0	0	0%	51%
1.26 - 1.77	Very Coarse	32.0 - 45.0	S	2	0	2	2%	53%
1.77 - 2.5	Very Coarse	45.0 - 64.0		2	0	2	2%	55%
2.5 - 3.5	Small	64 - 90	C	1	0	1	1%	56%
3.5 - 5.0	Small	90 - 128	O	2	0	2	2%	58%
5.0 - 7.1	Large	128 - 180	B	0	0	0	0%	58%
7.1 - 10.1	Large	180 - 256	L	0	0	0	0%	58%
10.1 - 14.3	Small	256 - 362	B	0	0	0	0%	58%
14.3 - 20	Small	362 - 512	L	0	0	0	0%	58%
20 - 40	Medium	512 - 1024	D	0	0	0	0%	58%
40 - 80	Lrg- Very Lrg	1024 - 2048	R	0	0	0	0%	58%
	Bedrock		BDRK	43	0	43	42%	100%
Totals				103	0	103	100%	100%

d16	d35	d50	d84	d95
0.1	0.4	12.3	Bedrock	Bedrock

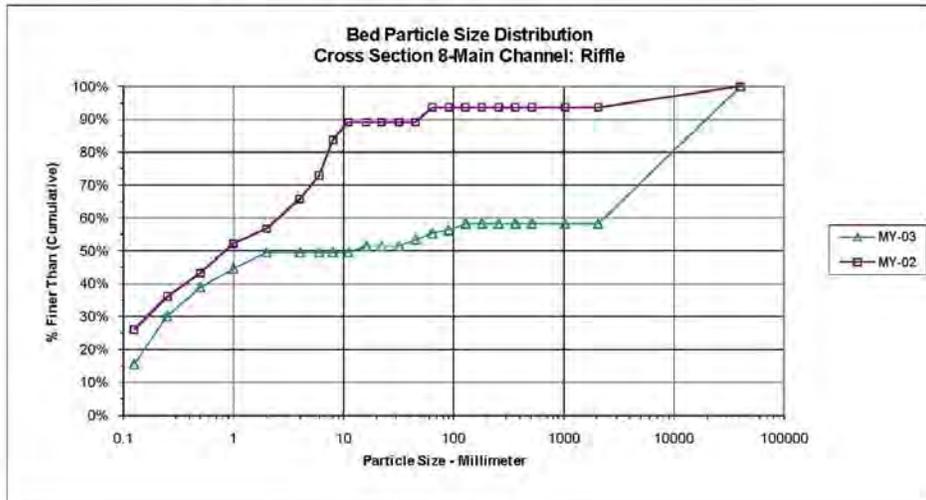


Appendix E. Wetland Assessment


Little Beaver Creek Gauge 2

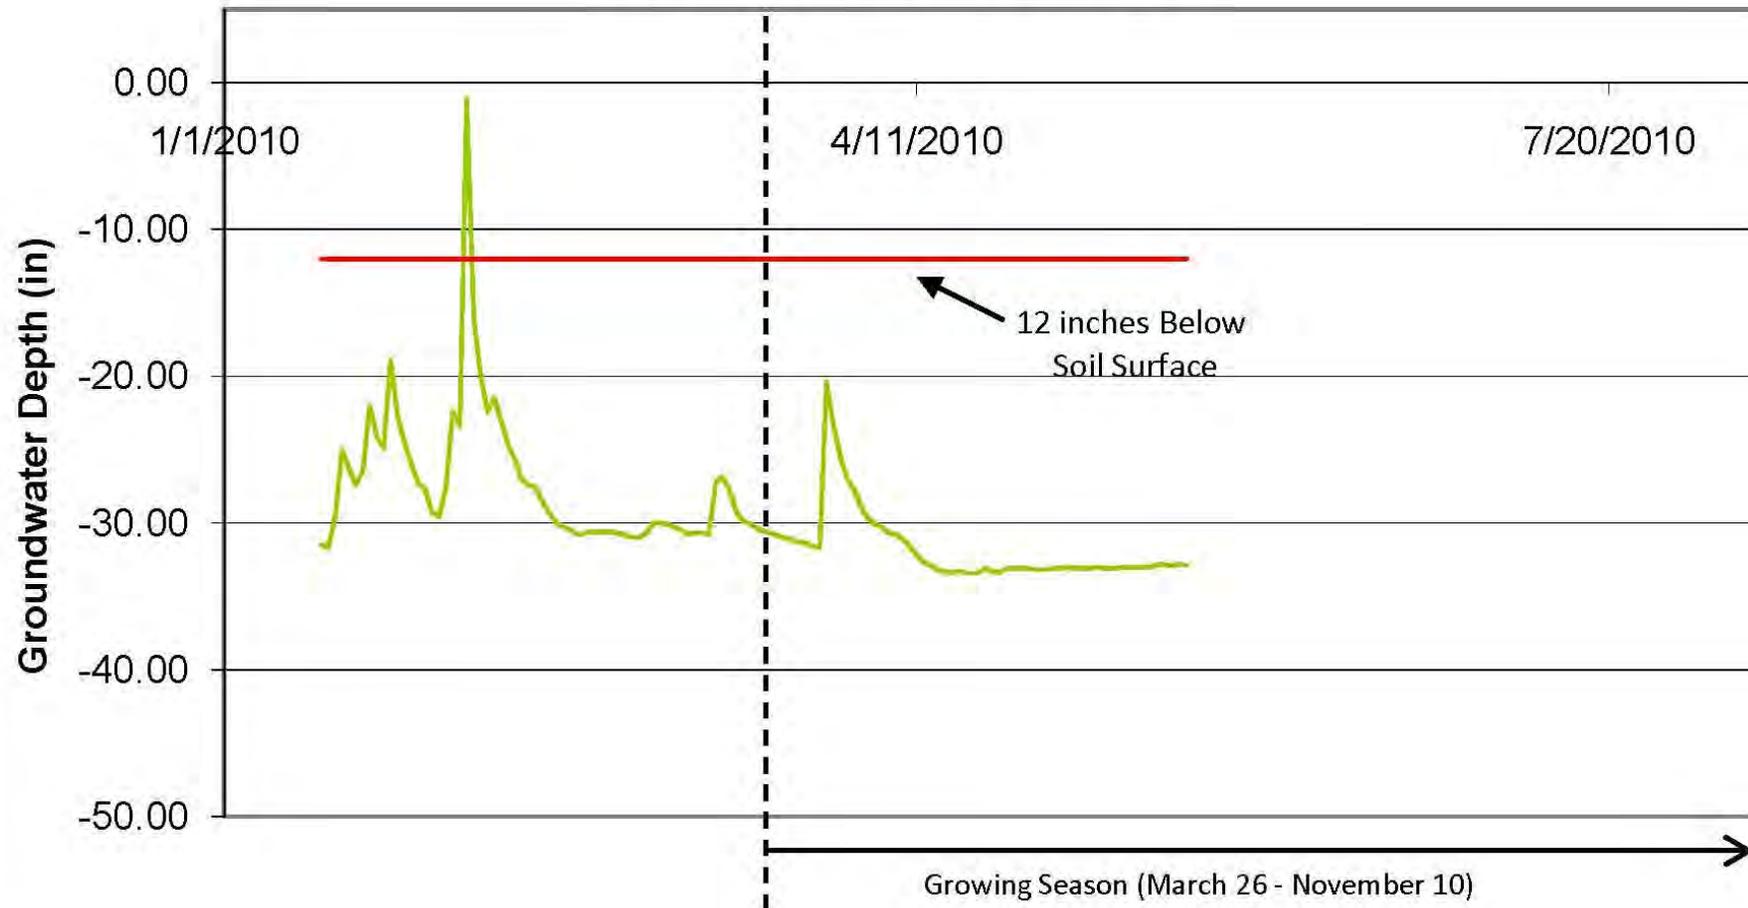


Little Beaver Creek Gauge 3

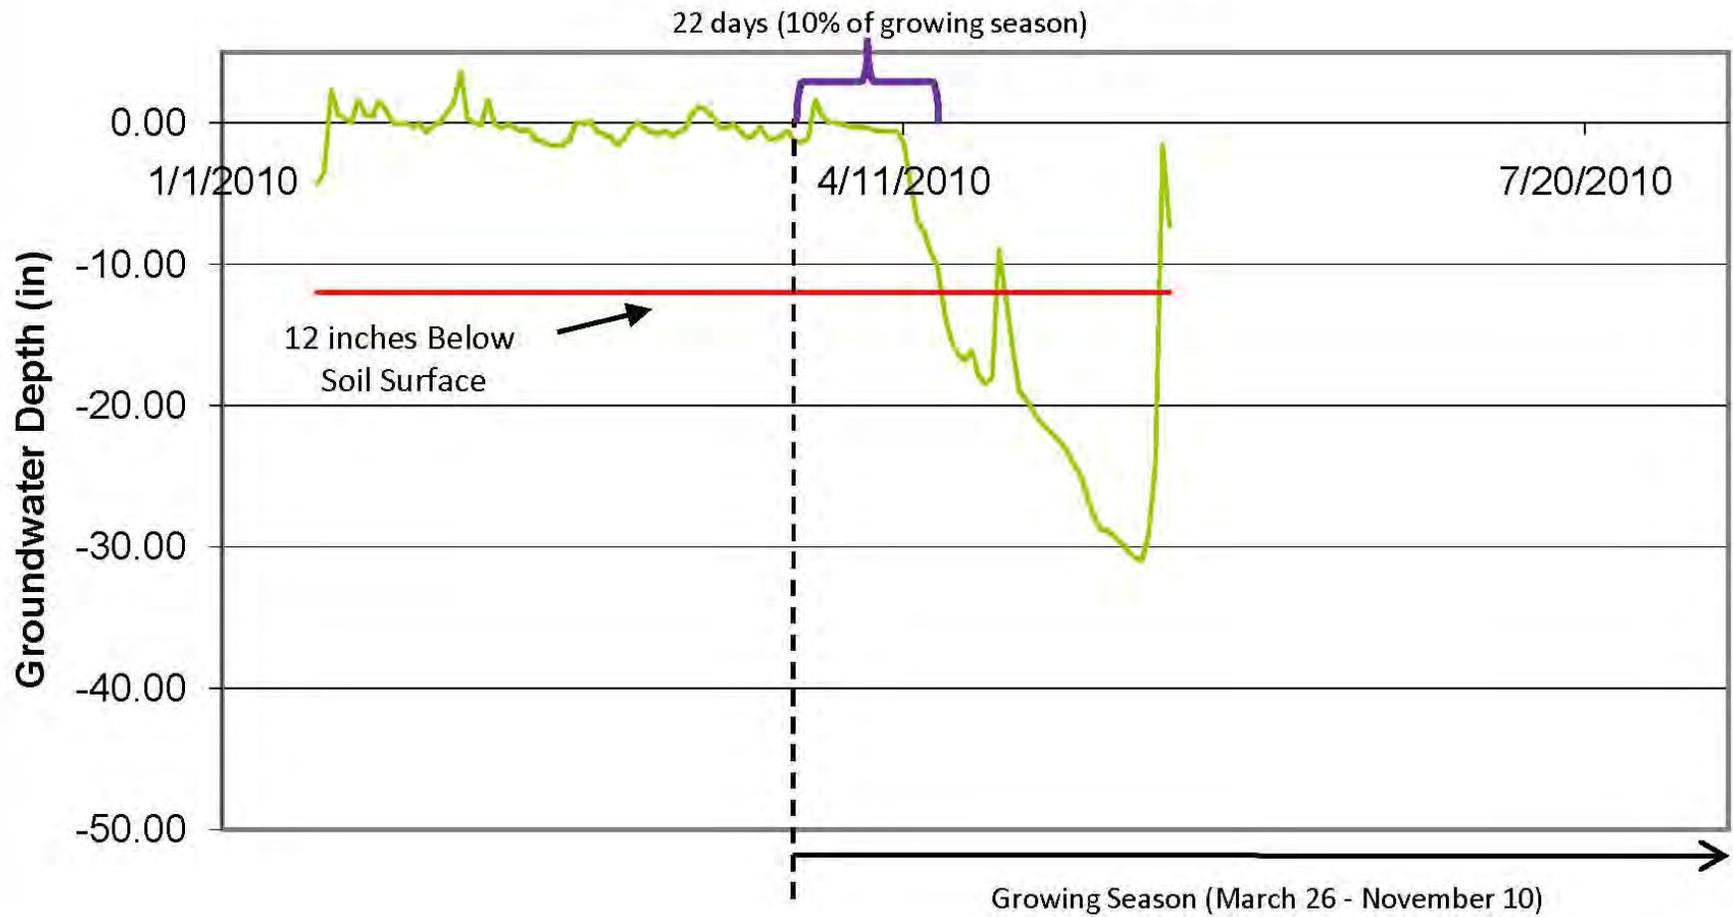


Little Beaver Creek Gauge 4

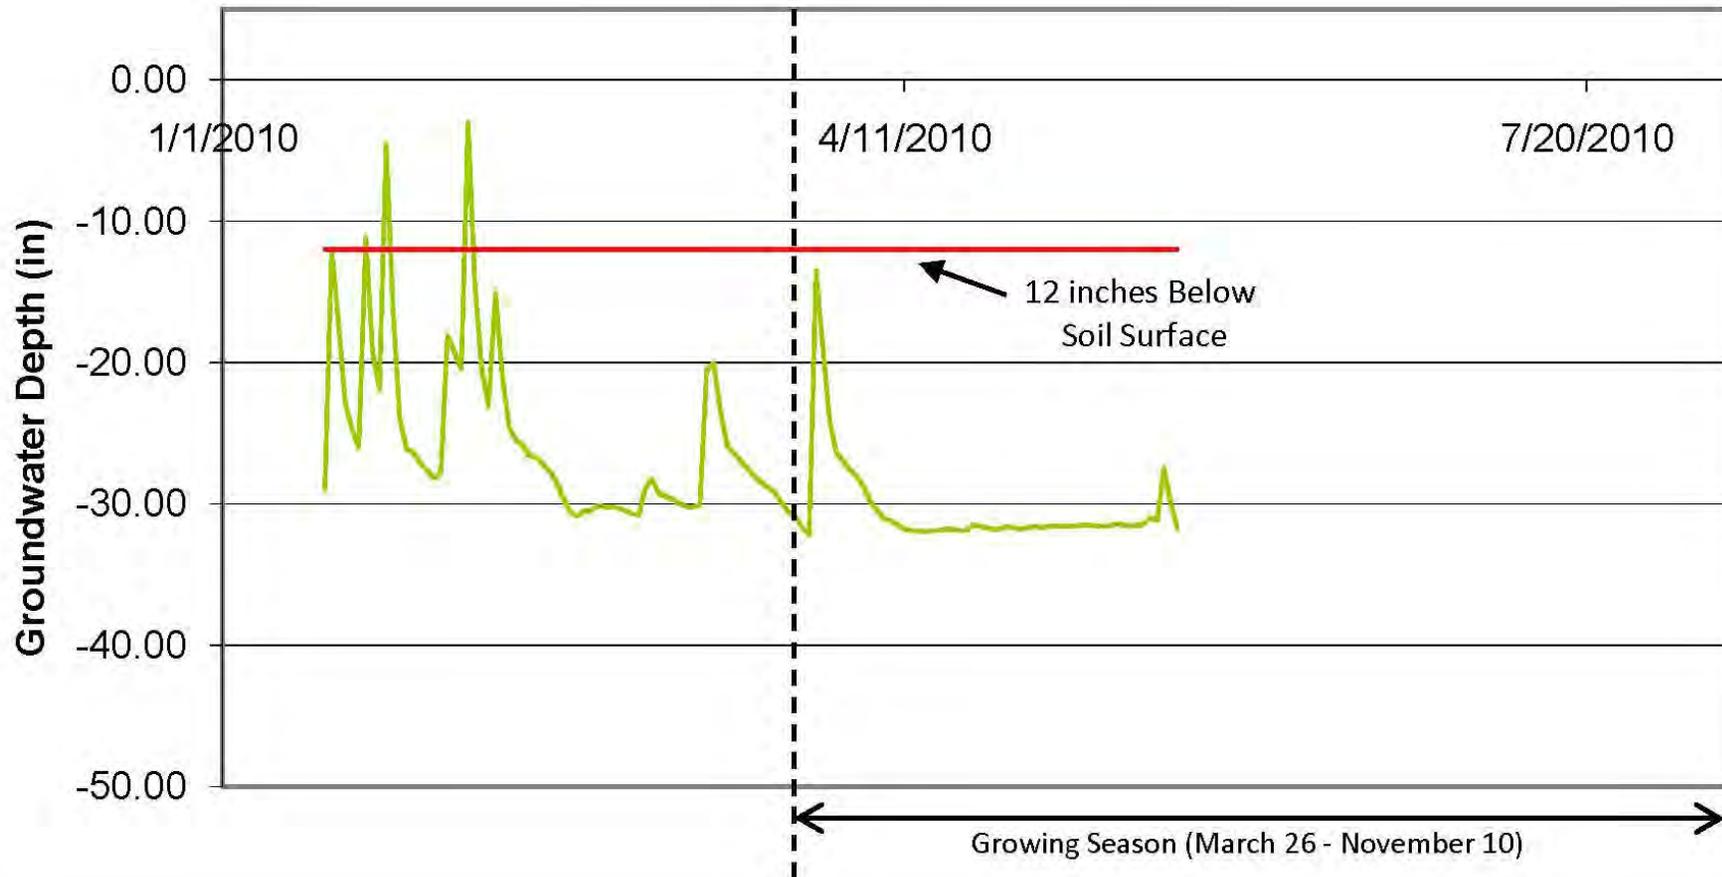


Little Beaver Creek Gauge 5

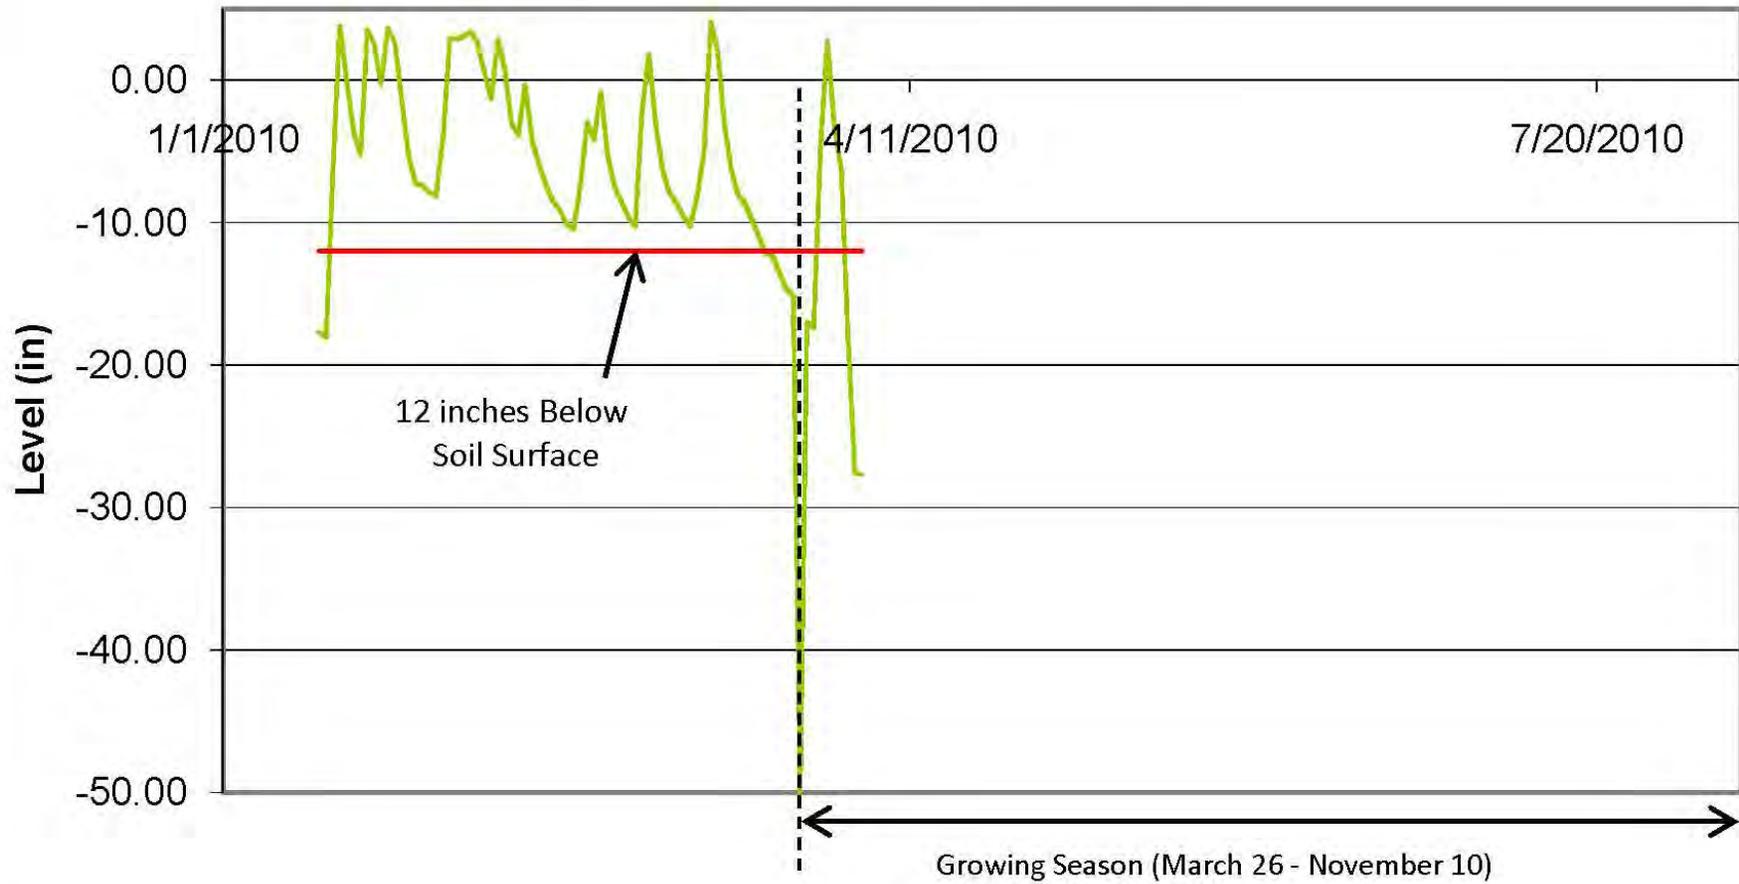


Little Beaver Creek Gauge 6

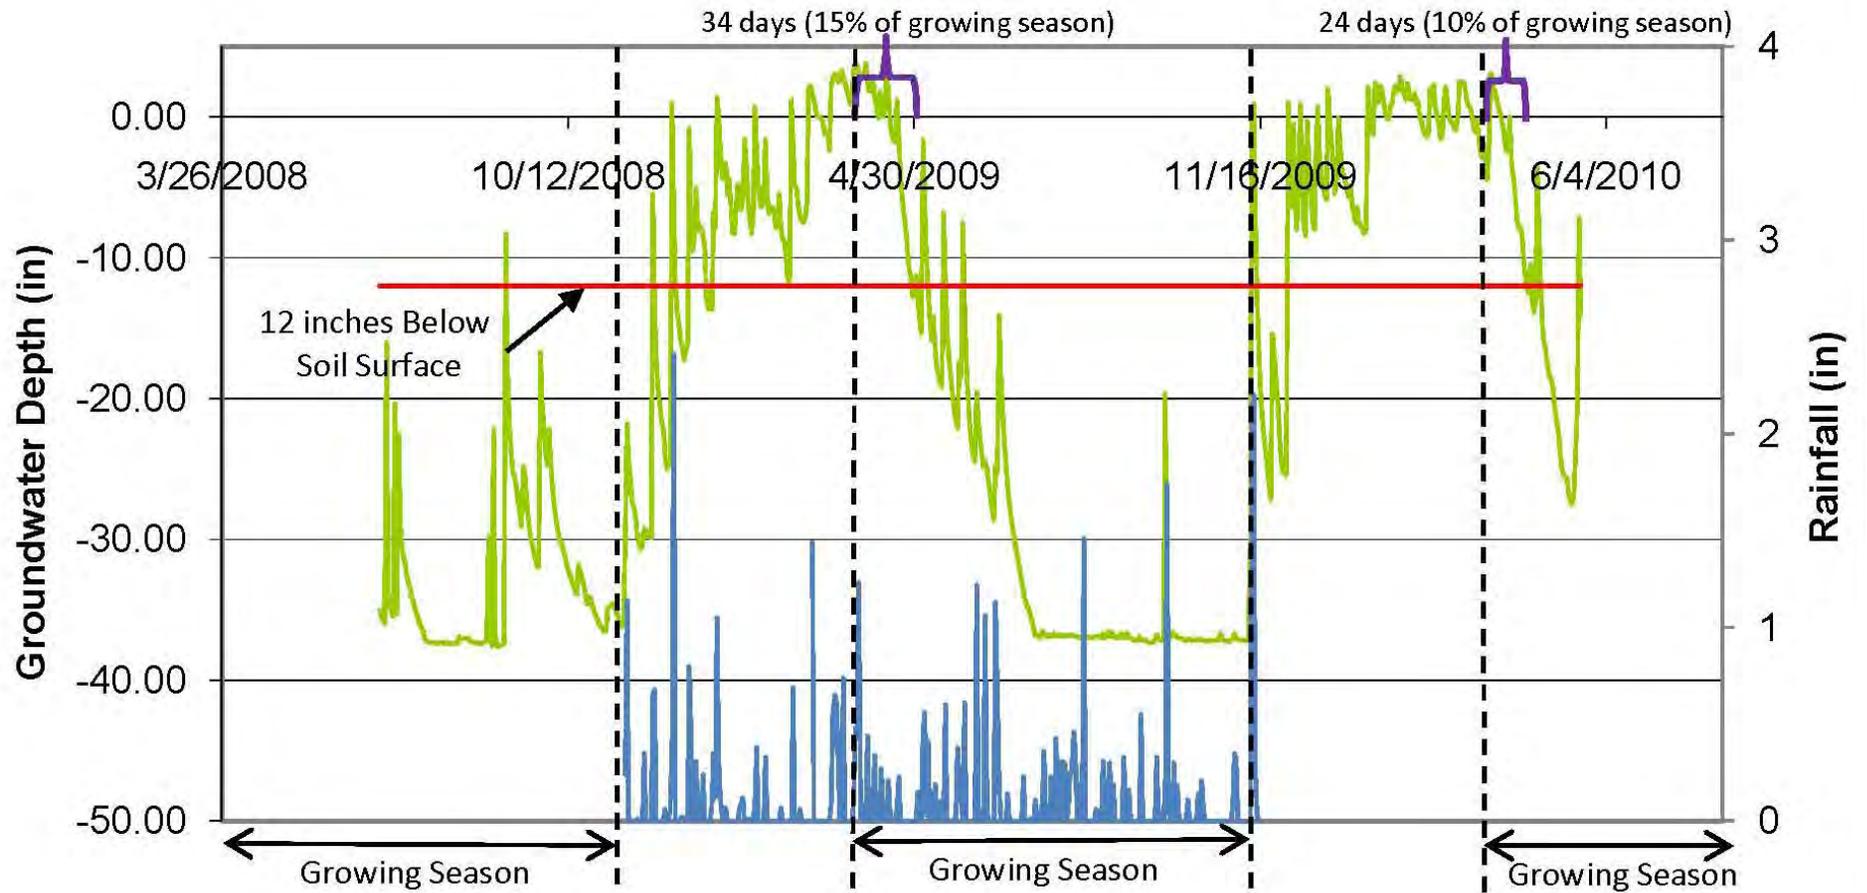


Little Beaver Creek Gauge 7

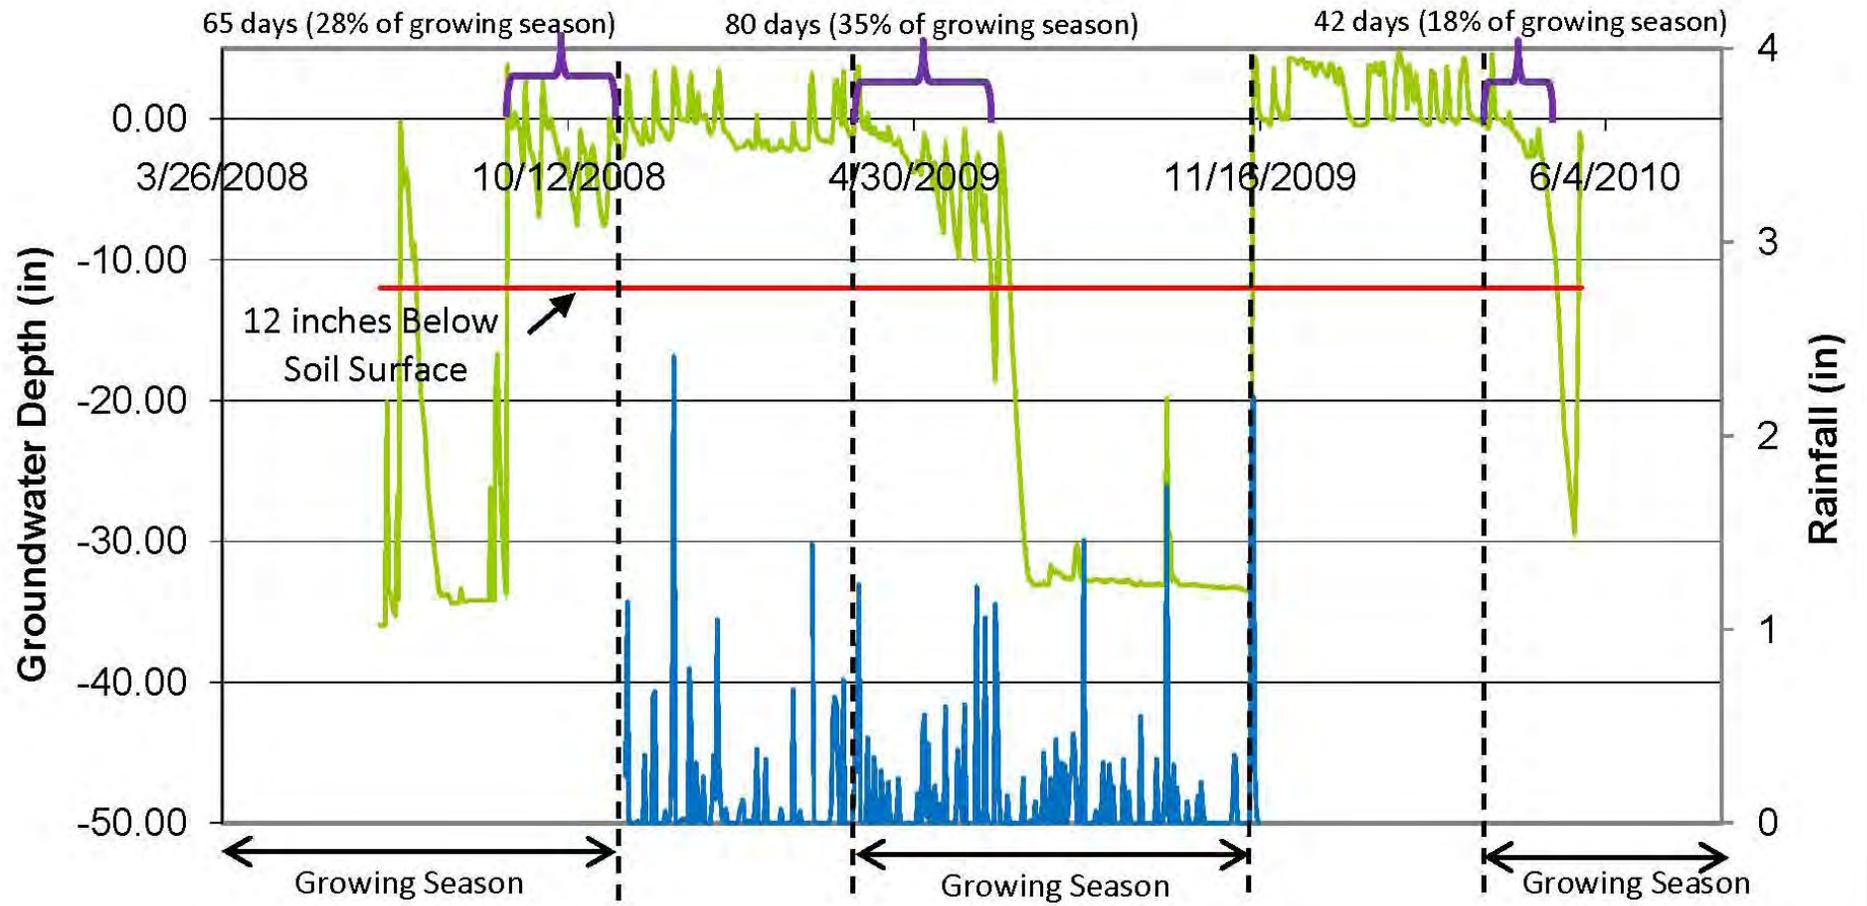

Little Beaver Creek Gauge 8

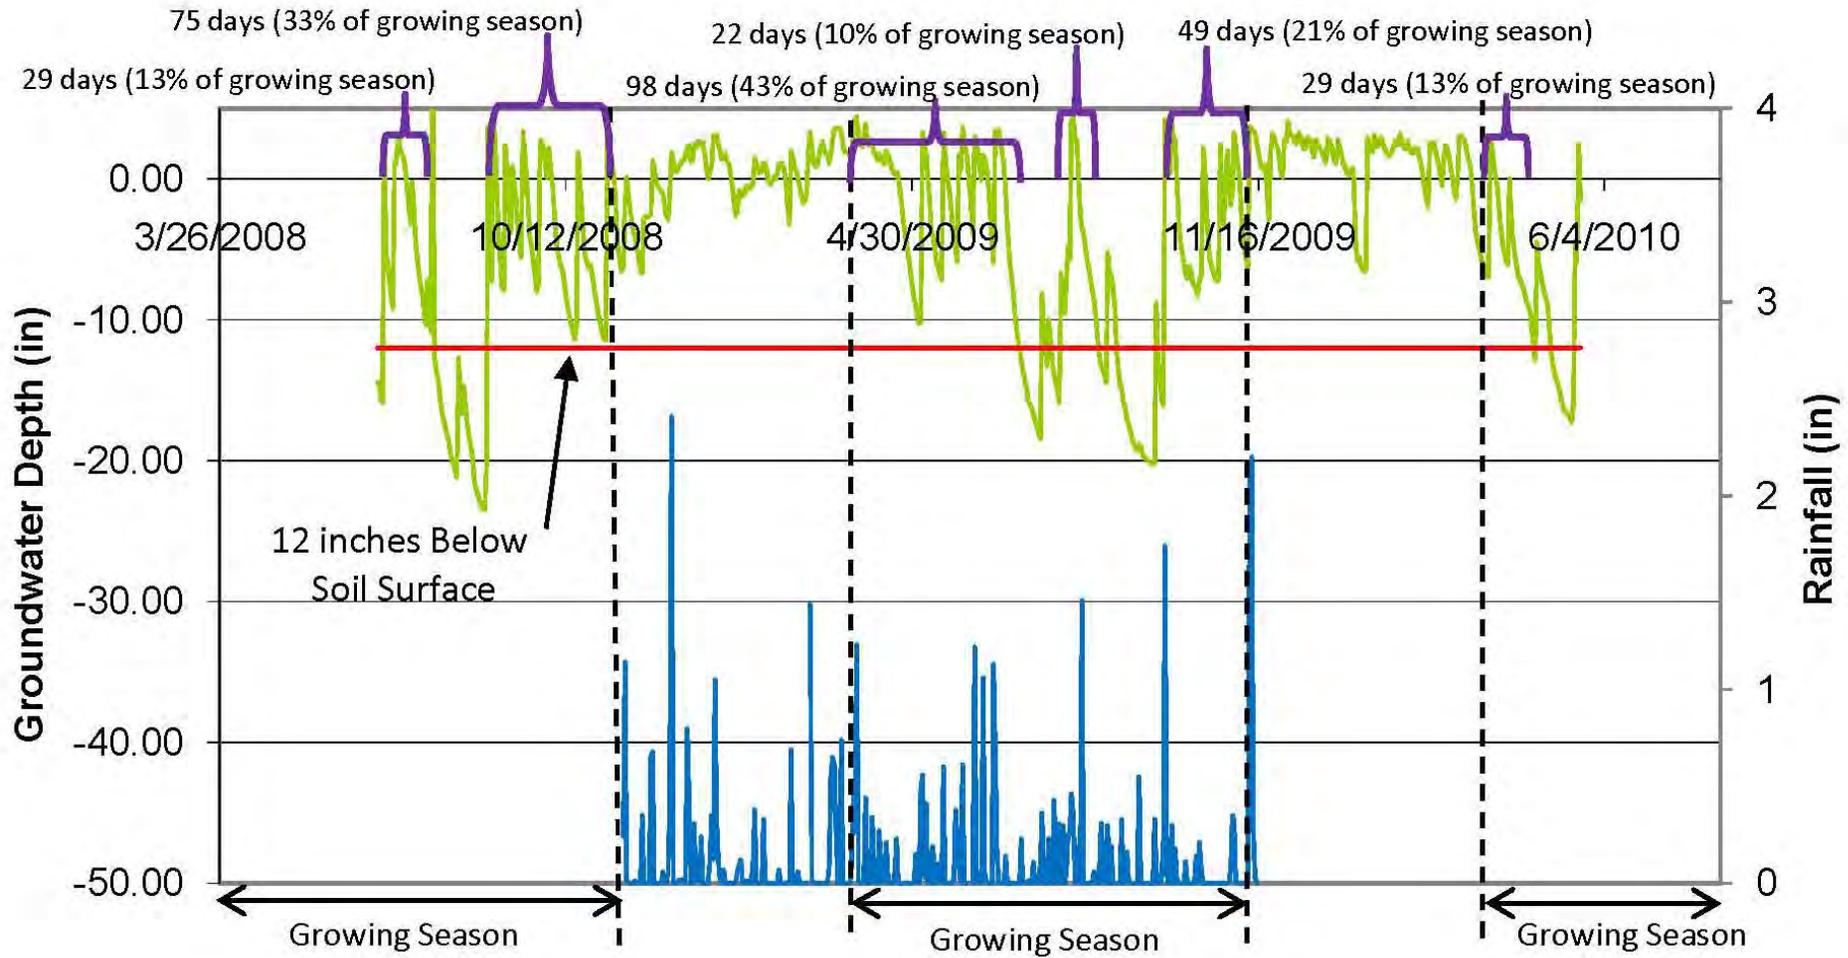

Little Beaver Creek Gauge 9

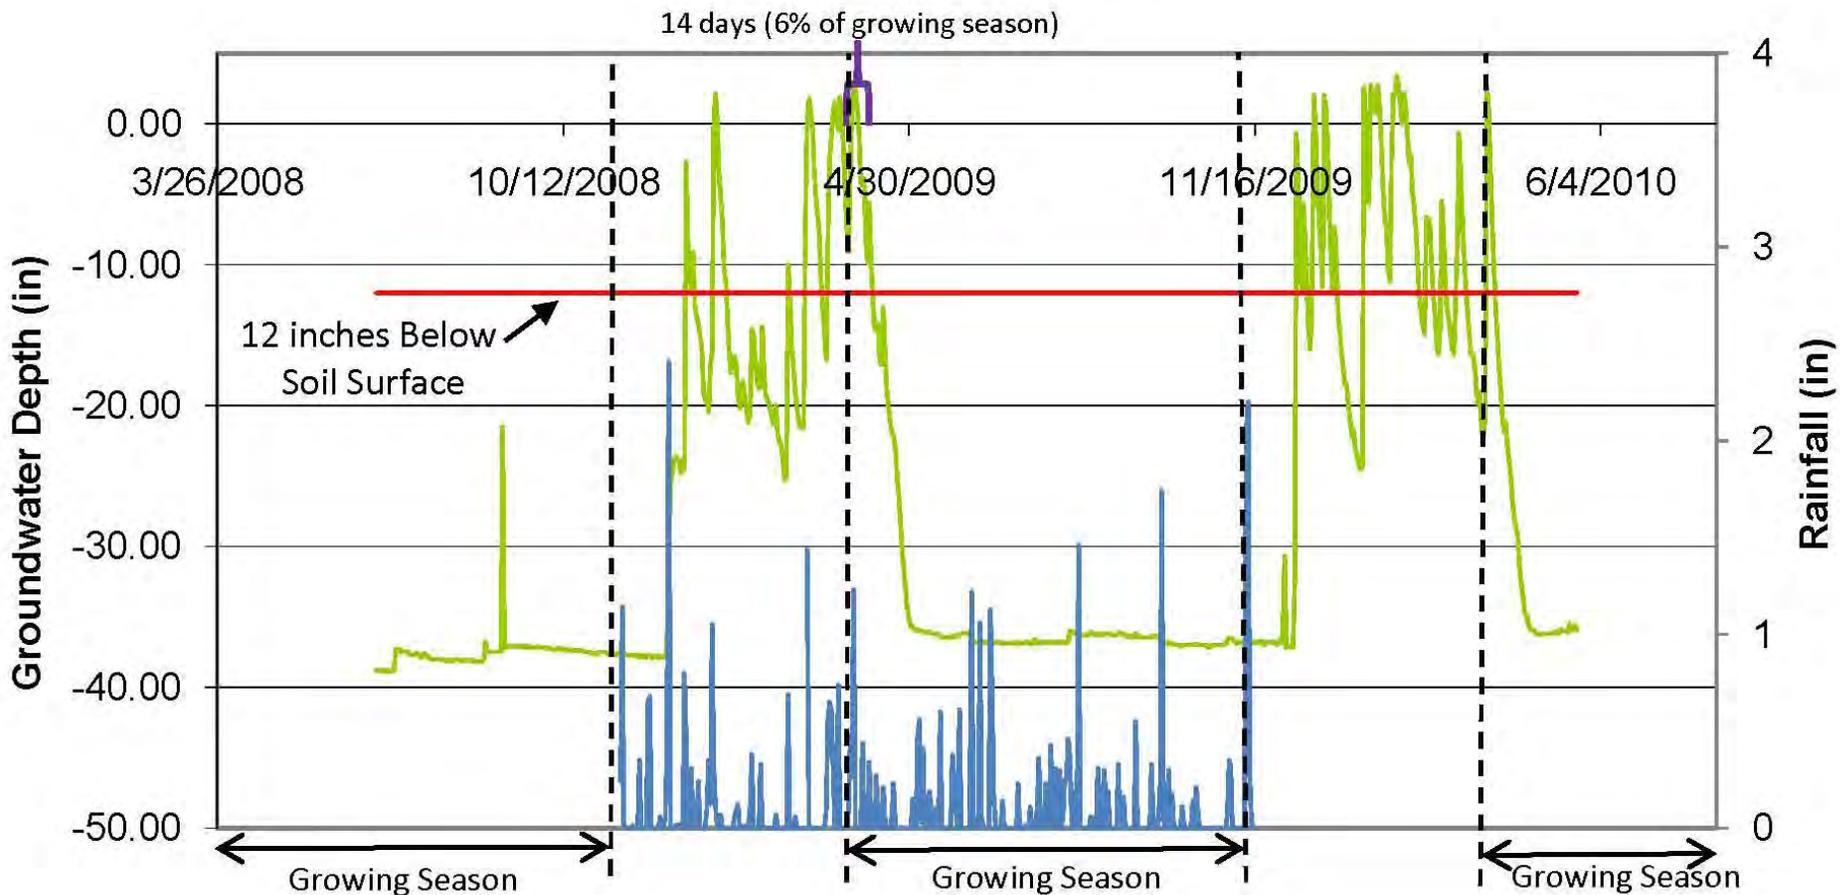

Wetland Gauge Attainment Data Table

Summary of Groundwater Gauge Results for Years 1 through 5					
Gauge	Success Criteria Achieved/Max Consecutive Days During Growing Season (Percentage)				
	Year 1 (2007)	Year 2 (2008)	Year 3 (2009)	Year 4	Year 5
2*	N/A	N/A	No-IP		
3*	N/A	N/A	Yes/22 days (10%)-IP		
4*	N/A	N/A	No-IP		
5*	N/A	N/A	No-IP		
6	Yes/28 days (12%)	N/A	Yes/ 34 days (15%)		
7	Yes/ >29 days (>12.5%)	Yes/28 days (65%)	Yes/80 days (35%)		
8	Yes/ >29 days (>12.5%)	Yes/75 days (33%)	Yes/98 days (43%)		
9	No	N/A	Yes/14 days (6%)		

N/A-Insufficient data or not available

*-Gauges installed 1/15/10, incomplete growing season data set

IP-Growing Season Data collection in progress