

STATE PROJECT: 020594002A

STATE OF NORTH CAROLINA
ECOSYSTEM ENHANCEMENT PROGRAM

STATE	STATE PROJECT NUMBER	SHEET NO.	TOTAL SHEETS
N.C.	020594002A	1	9

NO.	DESCRIPTION	DATE	APPROVED
REVISIONS			


RANDOLPH COUNTY

**LOCATION: McCAIN PROPERTY, UNNAMED TRIBUTARY TO BACK CREEK
SOPHIA, NORTH CAROLINA**

TYPE OF WORK: STREAM RESTORATION



VICINITY MAP
NOT TO SCALE

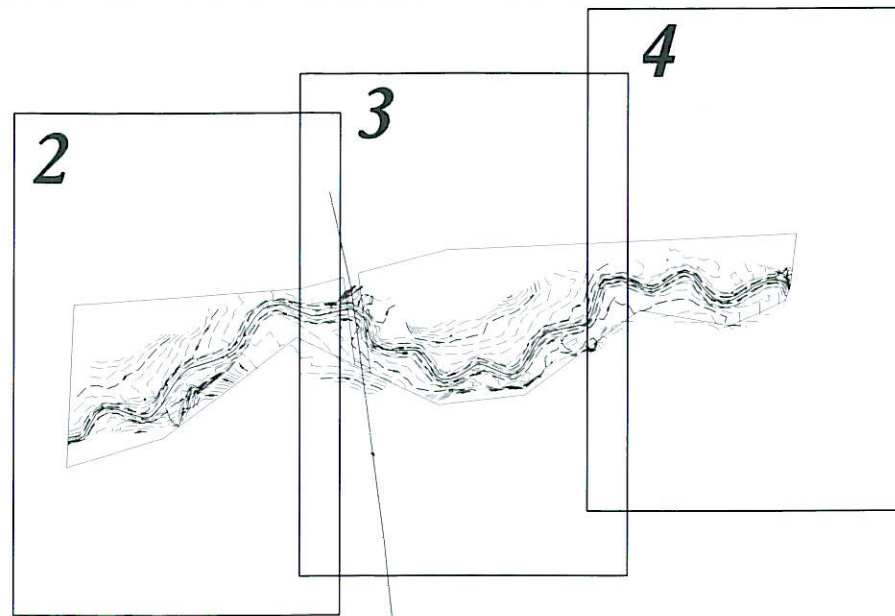

INDEX OF SHEETS

- | | |
|----------|-------------------------|
| 1 | TITLE SHEET |
| 1-A | LEGEND AND SITE CONTROL |
| 2 THRU 4 | STREAM PLANFORM |
| 5 THRU 7 | PLANTING PLAN |
| 8 | SURVEYOR AS-BUILT |

ACCESS AT LAKE LUCAS ROAD

LAKE LUCAS ROAD

RECORD DRAWINGS


GRAPHIC SCALE



PROJECT LENGTH

PROPOSED RESTORATION LENGTH = 2,470 FEET

Prepared In the Office of:

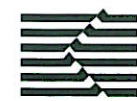

KCI Associates
of North Carolina, P.A.
SUITE 220 LANDMARK CENTER II, 4601 SIX FORKS RD., RALEIGH NC
ENGINEERS • PLANNERS • ECOLOGISTS

CONSTRUCTION
COMPLETION DATE:

MARCH 2009

GARY M. MRYNCZA, P.E.
PROJECT ENGINEER

ADAM SPILLER / ALEX FRENCH
NATURAL CHANNEL DESIGN

PROJECT ENGINEER 06.15.09



SIGNATURE:

Prepared for:



MELONIE ALLEN
NCEEP CONTACT