

**Mill Branch Stream Restoration Project  
Columbus County  
North Carolina**

**CU: 03040206  
SCO# 020611301A  
EEP Project No. 251**



**3rd Year Monitoring Report  
November 15, 2009**

Prepared for:



North Carolina Department of Environment and Natural Resources  
Ecosystem Enhancement Program  
Parker Lincoln Building  
2728 Capital Boulevard, Suite 1H-103  
Raleigh, NC 27606

**Mill Branch Stream Restoration Project  
Columbus County  
North Carolina**

**CU: 03040206  
SCO# 020611301A  
EEP Project No. 251**

**3rd Year Monitoring Report  
November 15, 2009**

Prepared by:



Rummel, Klepper & Kahl, LLP  
900 Ridgefield Drive  
Suite 350  
Raleigh, NC 27609

## **2.0 Table of Contents**

1.0 Title Page .....	i
2.0 Table of Contents.....	ii
3.0 Executive Summary/Project Abstract.....	1
4.0 Methodology .....	2
5.0 References .....	3
6.0 Project Condition and Monitoring Data Appendices .....	4

Appendix A. General Figures and Plan Views

Appendix B. General Project Tables

Appendix C. Vegetation Assessment Data

Appendix D. Stream Assessment Data

### **3.0 Executive Summary/Project Abstract**

Project goals and objectives for the Mill Branch stream restoration project included:

- Improving water quality;
- Providing wildlife habitat through the creation of a riparian zone;
- Improving aquatic habitat with the use of natural material stabilization structures and a riparian buffer;
- Excluding cattle from the stream;
- Reducing nutrient loads from entering the stream via the buffer acting as a filter exclusion of cattle;
- Increasing the stream's access to its floodplain;
- Reducing erosion and sedimentation; and
- Protecting floral and biotic diversity via preservation.

Four (four) permanent vegetation plots were established and used in annual vegetation monitoring. Overall, the site is exceeding the minimum success requirements. As per the mitigation plan, the vegetative success criteria are based on the US Army Corps of Engineers Stream Mitigation Guidelines (USACE, 2003). The final vegetative success criteria will be the survival of 320 5-year old planted woody stems per acre at the end of the year 5 monitoring period. Monitoring for 2009 revealed that vegetation plots VP2 and VP3 fall below the minimum success requirements. Vegetation plots VP1 and VP4 meet or exceed minimum success requirements. Vegetation plot locations are identified in Appendix C.

Overall, the stream is functioning well and holding grade, however, the stream has areas of that are of concern. Channel dimension and pattern are similar to as-built conditions and currently meeting monitoring minimum success requirement thresholds. The channel profile appears to be holding grade and maintaining some bedform features. Since project construction, North Carolina has been in a moderate to severe drought. The drought has caused low flow periods resulting in vegetation growing within the stream channel. The vegetation has cause disruption of sediment transport resulting in aggradation on parts of the project.

Wetland restoration or enhancement was not a part of the East Tarboro Canal Stream Restoration Site therefore no wetland monitoring is required.

Summary information/data related to the occurrence of items such as beaver or encroachment and statistics related to performance of various project and monitoring elements can be found in the tables and figures in the report appendices. Narrative background and supporting information formerly found in these reports can be found in the mitigation and restoration plan documents available on EEP's website. All raw data supporting the tables and figures in the appendices is available from EEP upon request.

## **4.0      Methodology**

Vegetative sample plots were quantitatively monitored during the growing season. Four 100m<sup>2</sup> plots were established for site monitoring. Species composition, density, vigor and survival were all monitored. Each plot corner is permanently located with rebar. Year 3 vegetation monitoring was completed in October 2009 utilizing the Carolina Vegetation Survey (CVS) – EEP protocol Level 1 (version 4.1).

Stream monitoring was completed by utilizing total station survey along with Rosgen Level II techniques to determine stream stability and performance. The annual cross-sectional survey included points surveyed at all breaks in slope, including top of bank, bankfull, inner berm, edge of water, and thalweg, if the features were present. Longitudinal profile survey was conducted for the entire length of the restored channel for stream reaches. Measurements included thalweg, water surface, and bankfull. Existing onsite benchmarks were used for survey control.

Photo monitoring was conducted by walking each stream reach and taking photos at each predetermined photo point location using a digital camera.

## **5.0      References**

Harrelson, C.C., C.L. Rawlins and J.P. Potyondy. 1994. Stream Channel Reference Sites: An Illustrated Guide to Field Technique. United States Department of Agriculture, Fort Collins, CO.

NCEEP. 2006. Content, Format and Data Requirements for EEP Monitoring Reports. North Carolina Department of Environment and Natural Resources, Ecosystem Enhancement Program. Raleigh, NC. Version 1.2 November 16, 2006.

Rosgen, D. 1996. Applied River Morphology. Wildland Hydrology, Pagosa Springs, CO.

## **6.0 Project Condition and Monitoring Data Appendices**

## ***APPENDIX A***

**Figure 1**

**Location Map**

Mill Branch  
Stream Restoration Project  
EEP No. 0251  
Columbus County, North Carolina

Monitoring Report  
November 2009

0 1 2 3 Miles


**Legend**

- Highways
- Railroad
- Roads
- Streams
- Waterbodies
- Municipalities
- Project\_boundary

Lat\ Long: 34.2222N, 78.7496W




Directions to Mill Branch Stream Restoration Site:  
From Raleigh, take I-95 South to Exit 20 (NC 211). At the end of the ramp turn left to go east on NC 211. Stay on road as it becomes NC-72, follow for about 12 miles, then turn left onto US-74. In Whiteville, take US-701 Bypass south and follow for approximately 10 miles. Turn left onto Lebanon Church Road (SR 1141). The gated entrance into the pasture surrounding the project site is on the left just past Lebanon United Methodist Chruch.

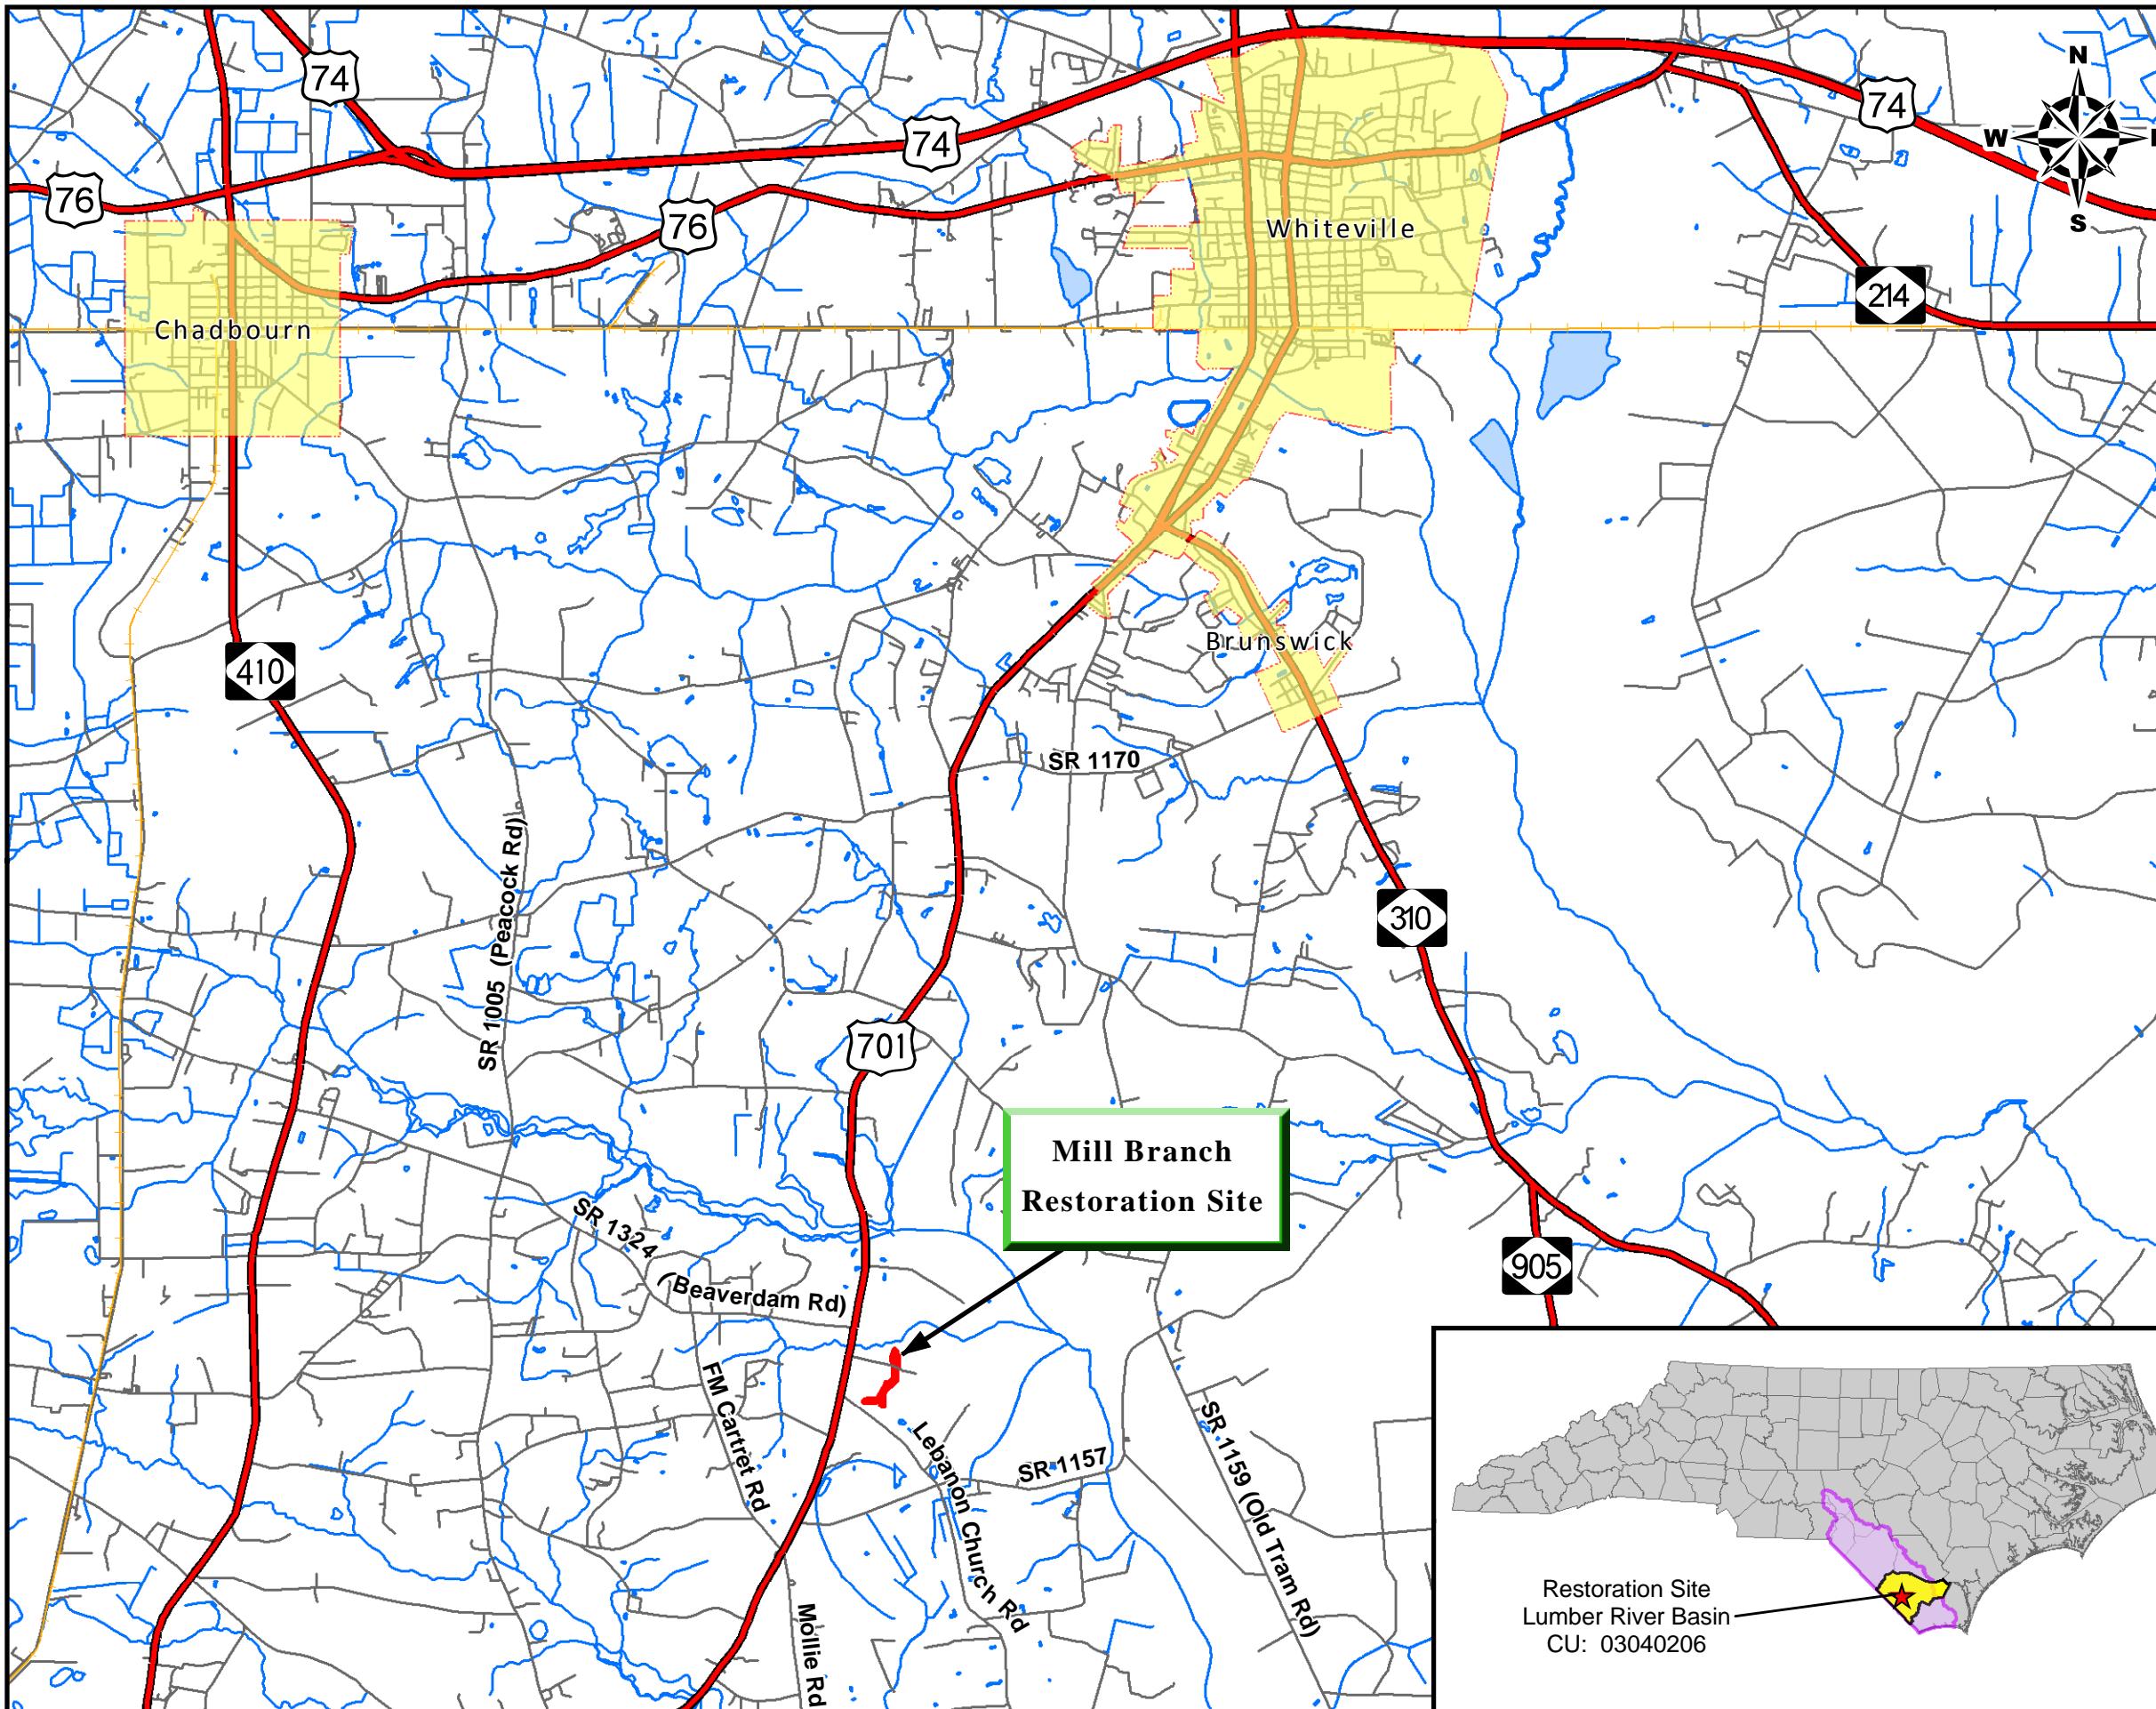

**FIGURE 2a**

Mill Branch  
Stream Restoration Site

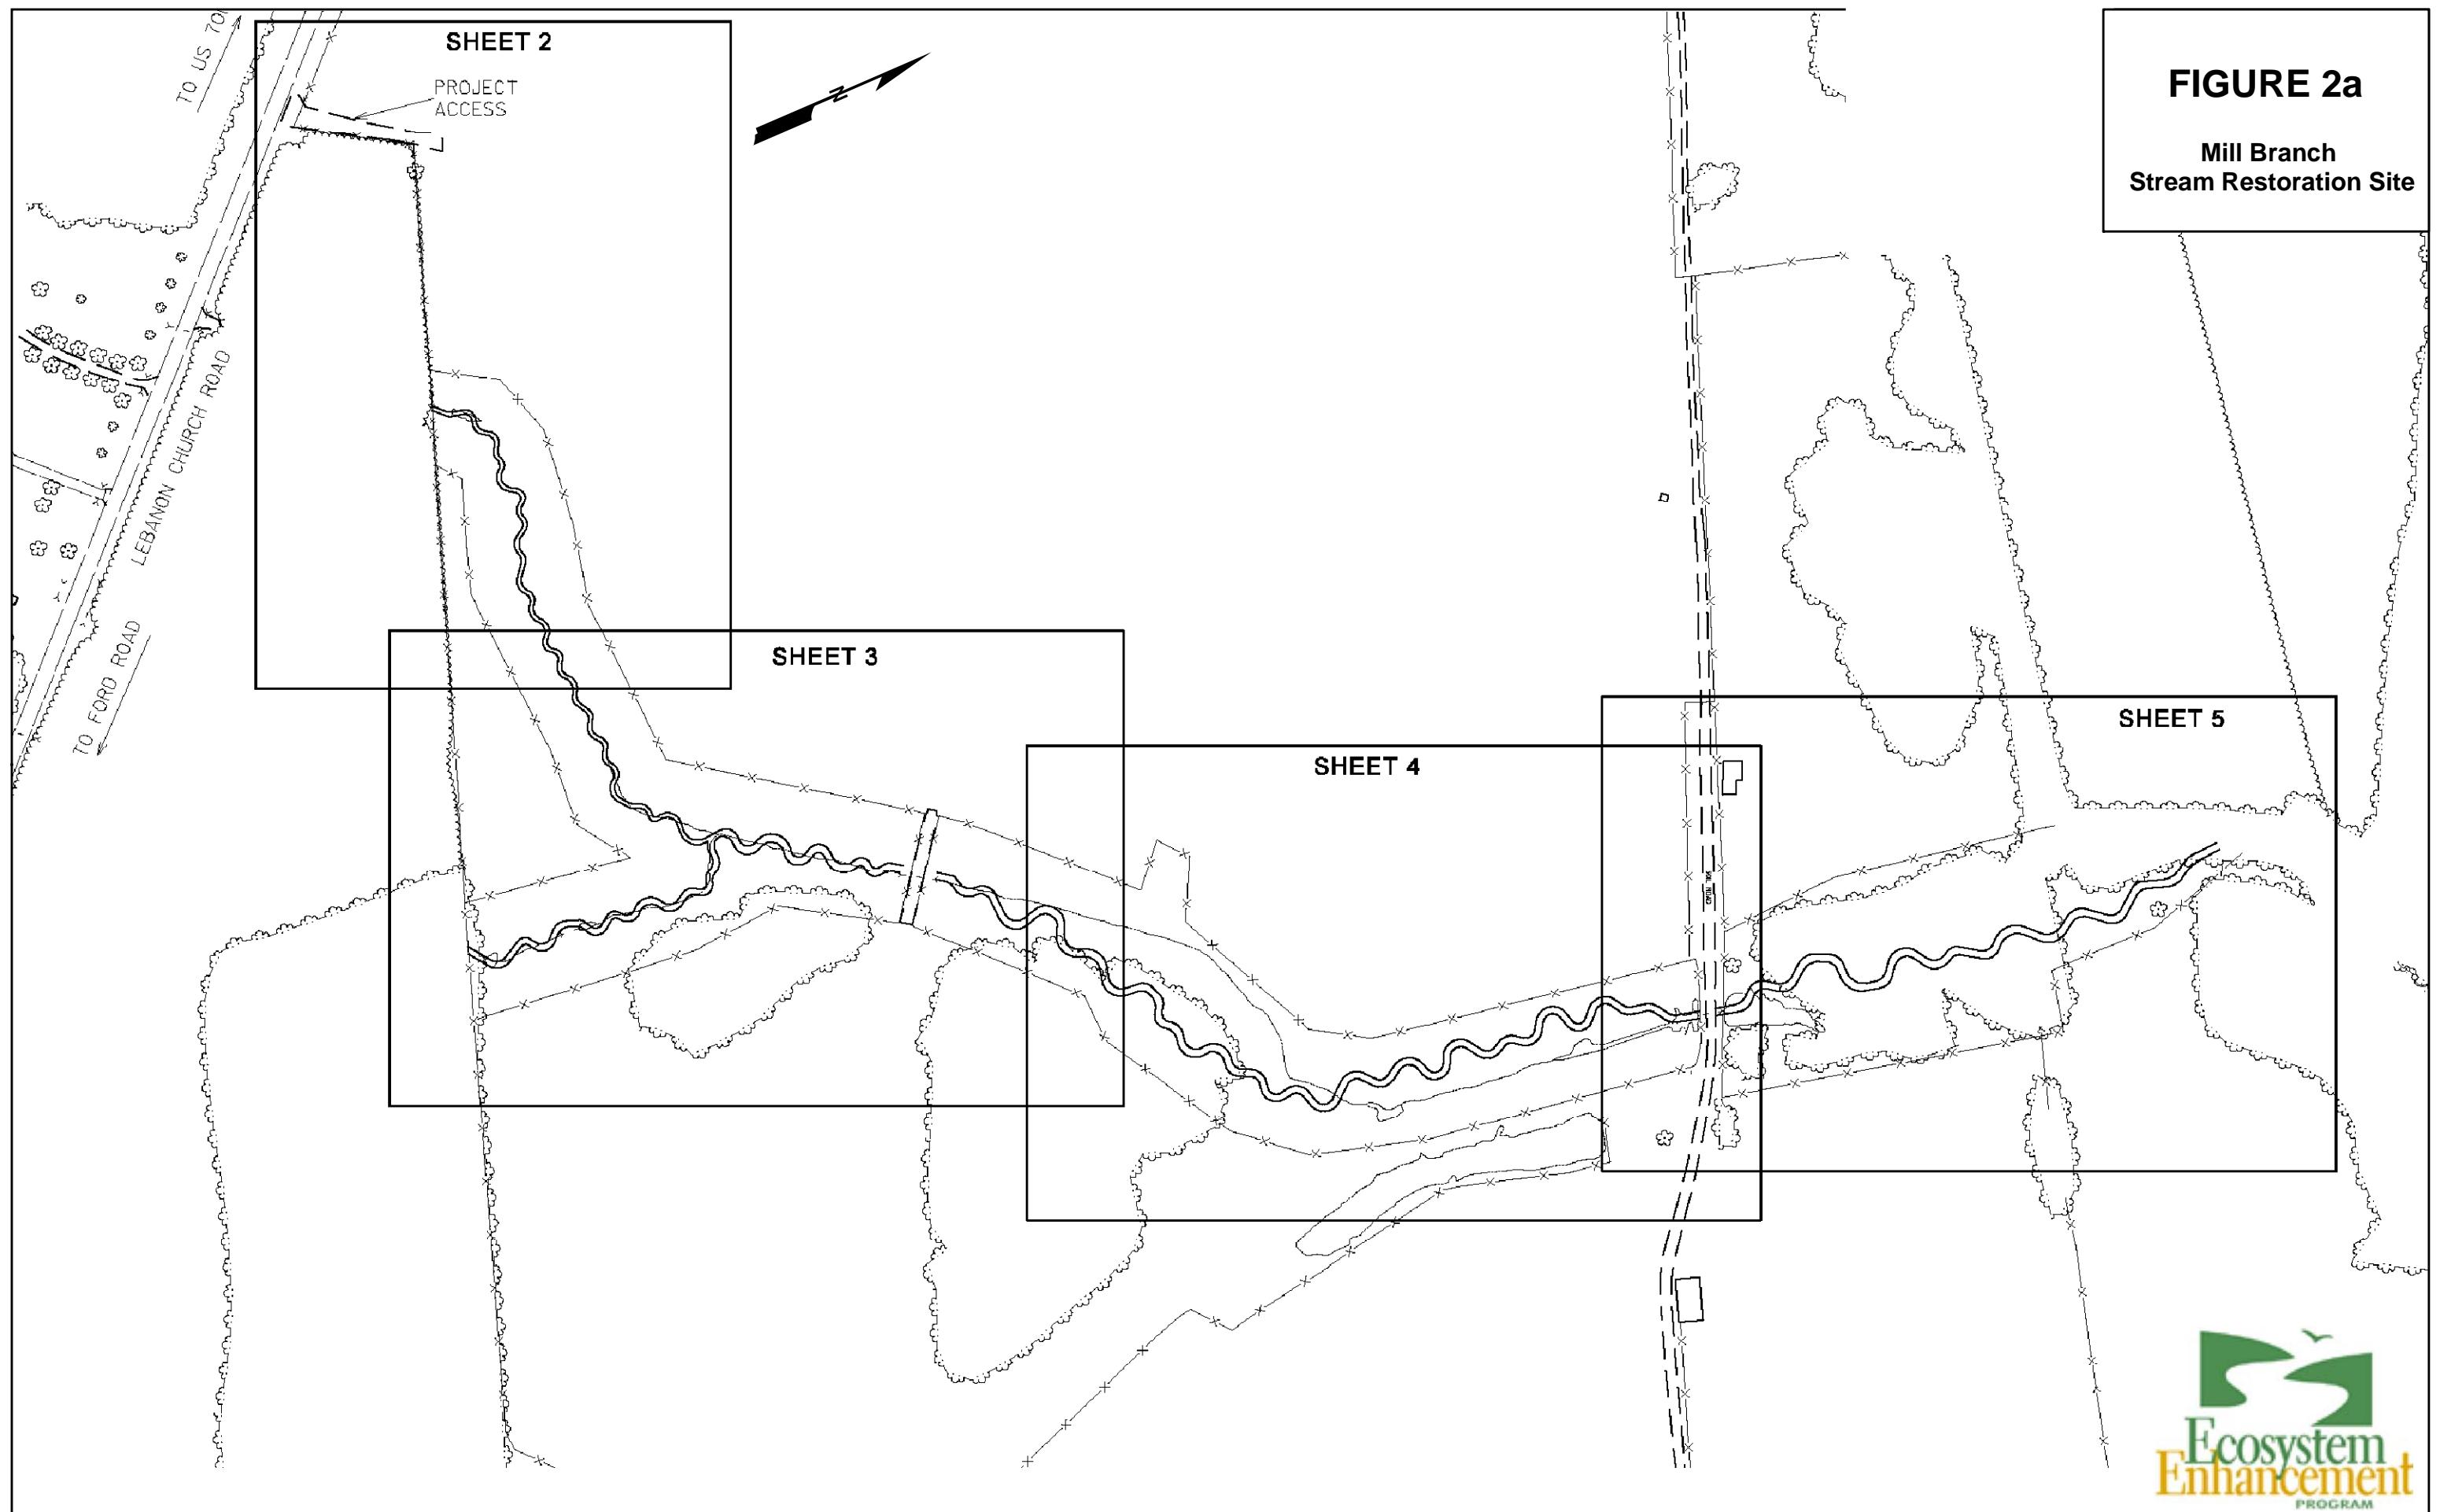

PROJECT NO.	SHEET NO.
SCO# 02-06113-01A	2

**FIGURE 2b**  
Mill Branch  
Stream Restoration Site

NC GRID  
NAD 83/2001


VEG PLOT PIN COORDINATES		
PIN	X	Y
VP-1A	2074939.6552	170768.7832
VP-1B	2074937.5346	170815.1208

CROSS-SECTION	LEFT		RIGHT	
	X	Y	X	Y
RIFFLE 1	2074779.4700	170816.2415	2074797.4519	170719.8073
POOL 2	2074810.1552	170807.4965	2074817.6790	170719.7804

NOTE: ALL STATIONS REFERENCE THALWEG LOCATED FOR AS-BUILT SURVEY

### Problem Areas


- AGGRADATION
- CATTAILS
- BARE GROUND
- RILL EROSION

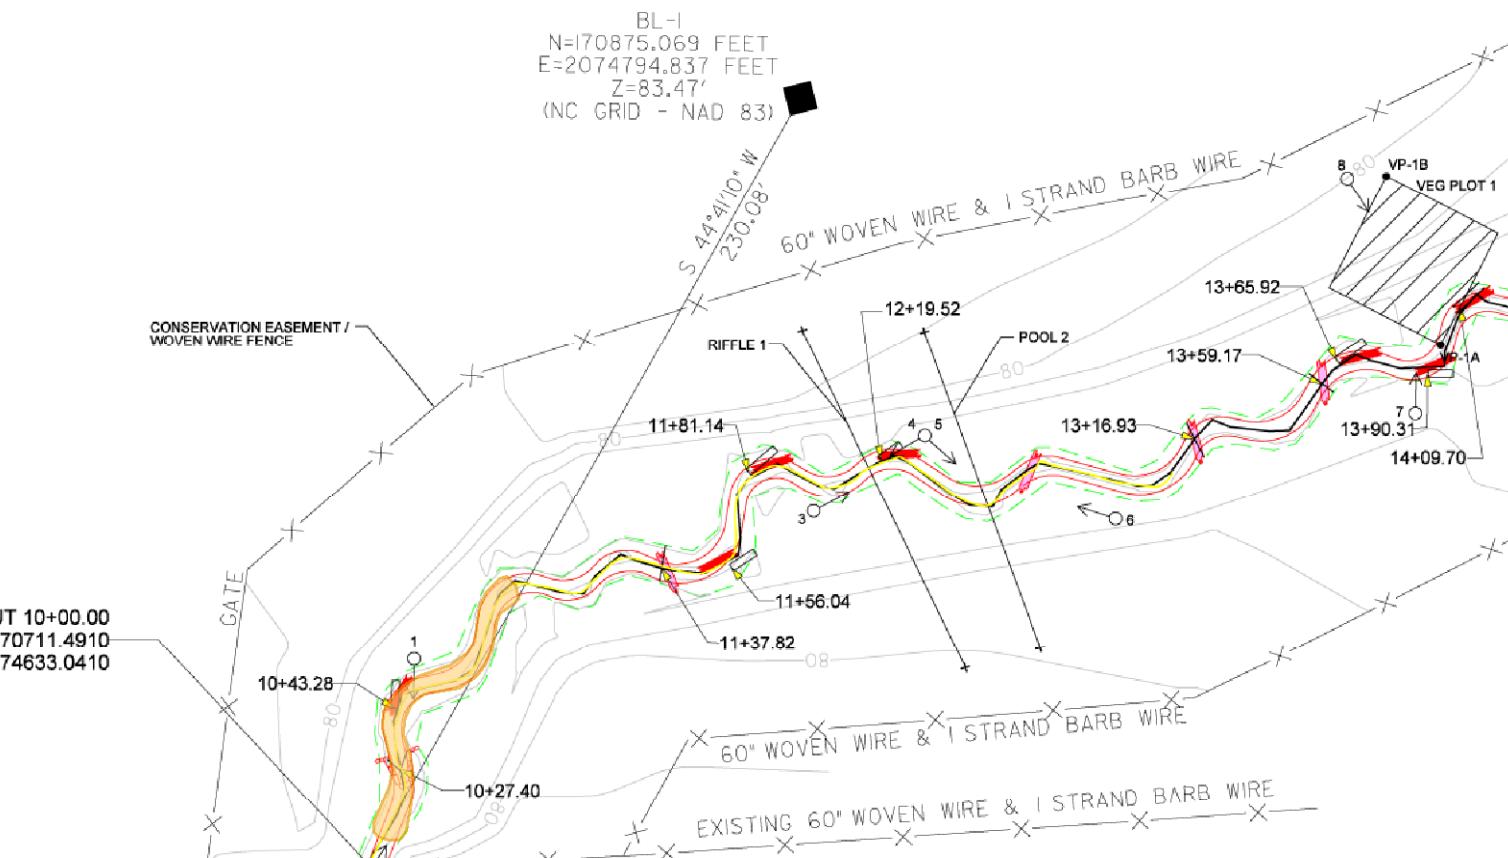

### LEGEND


- |  |                                  |  |                        |
|--|----------------------------------|--|------------------------|
|  | AS-BUILT ROCK CROSS VANE         |  | DESIGN ROCK CROSS VANE |
|  | AS-BUILT LOG VANE WITH ROCK SILL |  | DESIGN LOG VANE        |
|  | AS-BUILT LOG SILL                |  | DESIGN LOG SILL        |
|  | AS-BUILT THALWEG                 |  | INVERT                 |
|  | AS-BUILT BANKFULL                |  | FENCE LINE             |
|  | DESIGN BANKFULL                  |  | LIMITS OF DISTURBANCE  |
|  | MONITORING LONGITUDINAL PROFILE  |  | VEG PLOT PINS          |
|  |                                  |  | VEG PLOTS              |
|  |                                  |  | CROSS-SECTIONS         |
|  |                                  |  | PHOTO POINTS           |

MATCH LINE - SEE SHEET 3

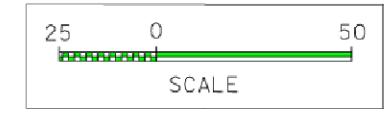

LOCATION:	SITE LOCATED OFF HIGHWAY 701 AND LEBANON CHURCH ROAD SOUTH OF WHITEVILLE	
PROJECT NO.	SCO# 02-06113-01A	COUNTY: COLUMBUS
DRAWN BY:	CGM	DATE:
CHECKED BY:	NEI	


**FIGURE 2c**  
**Mill Branch**  
**Stream Restoration Site**

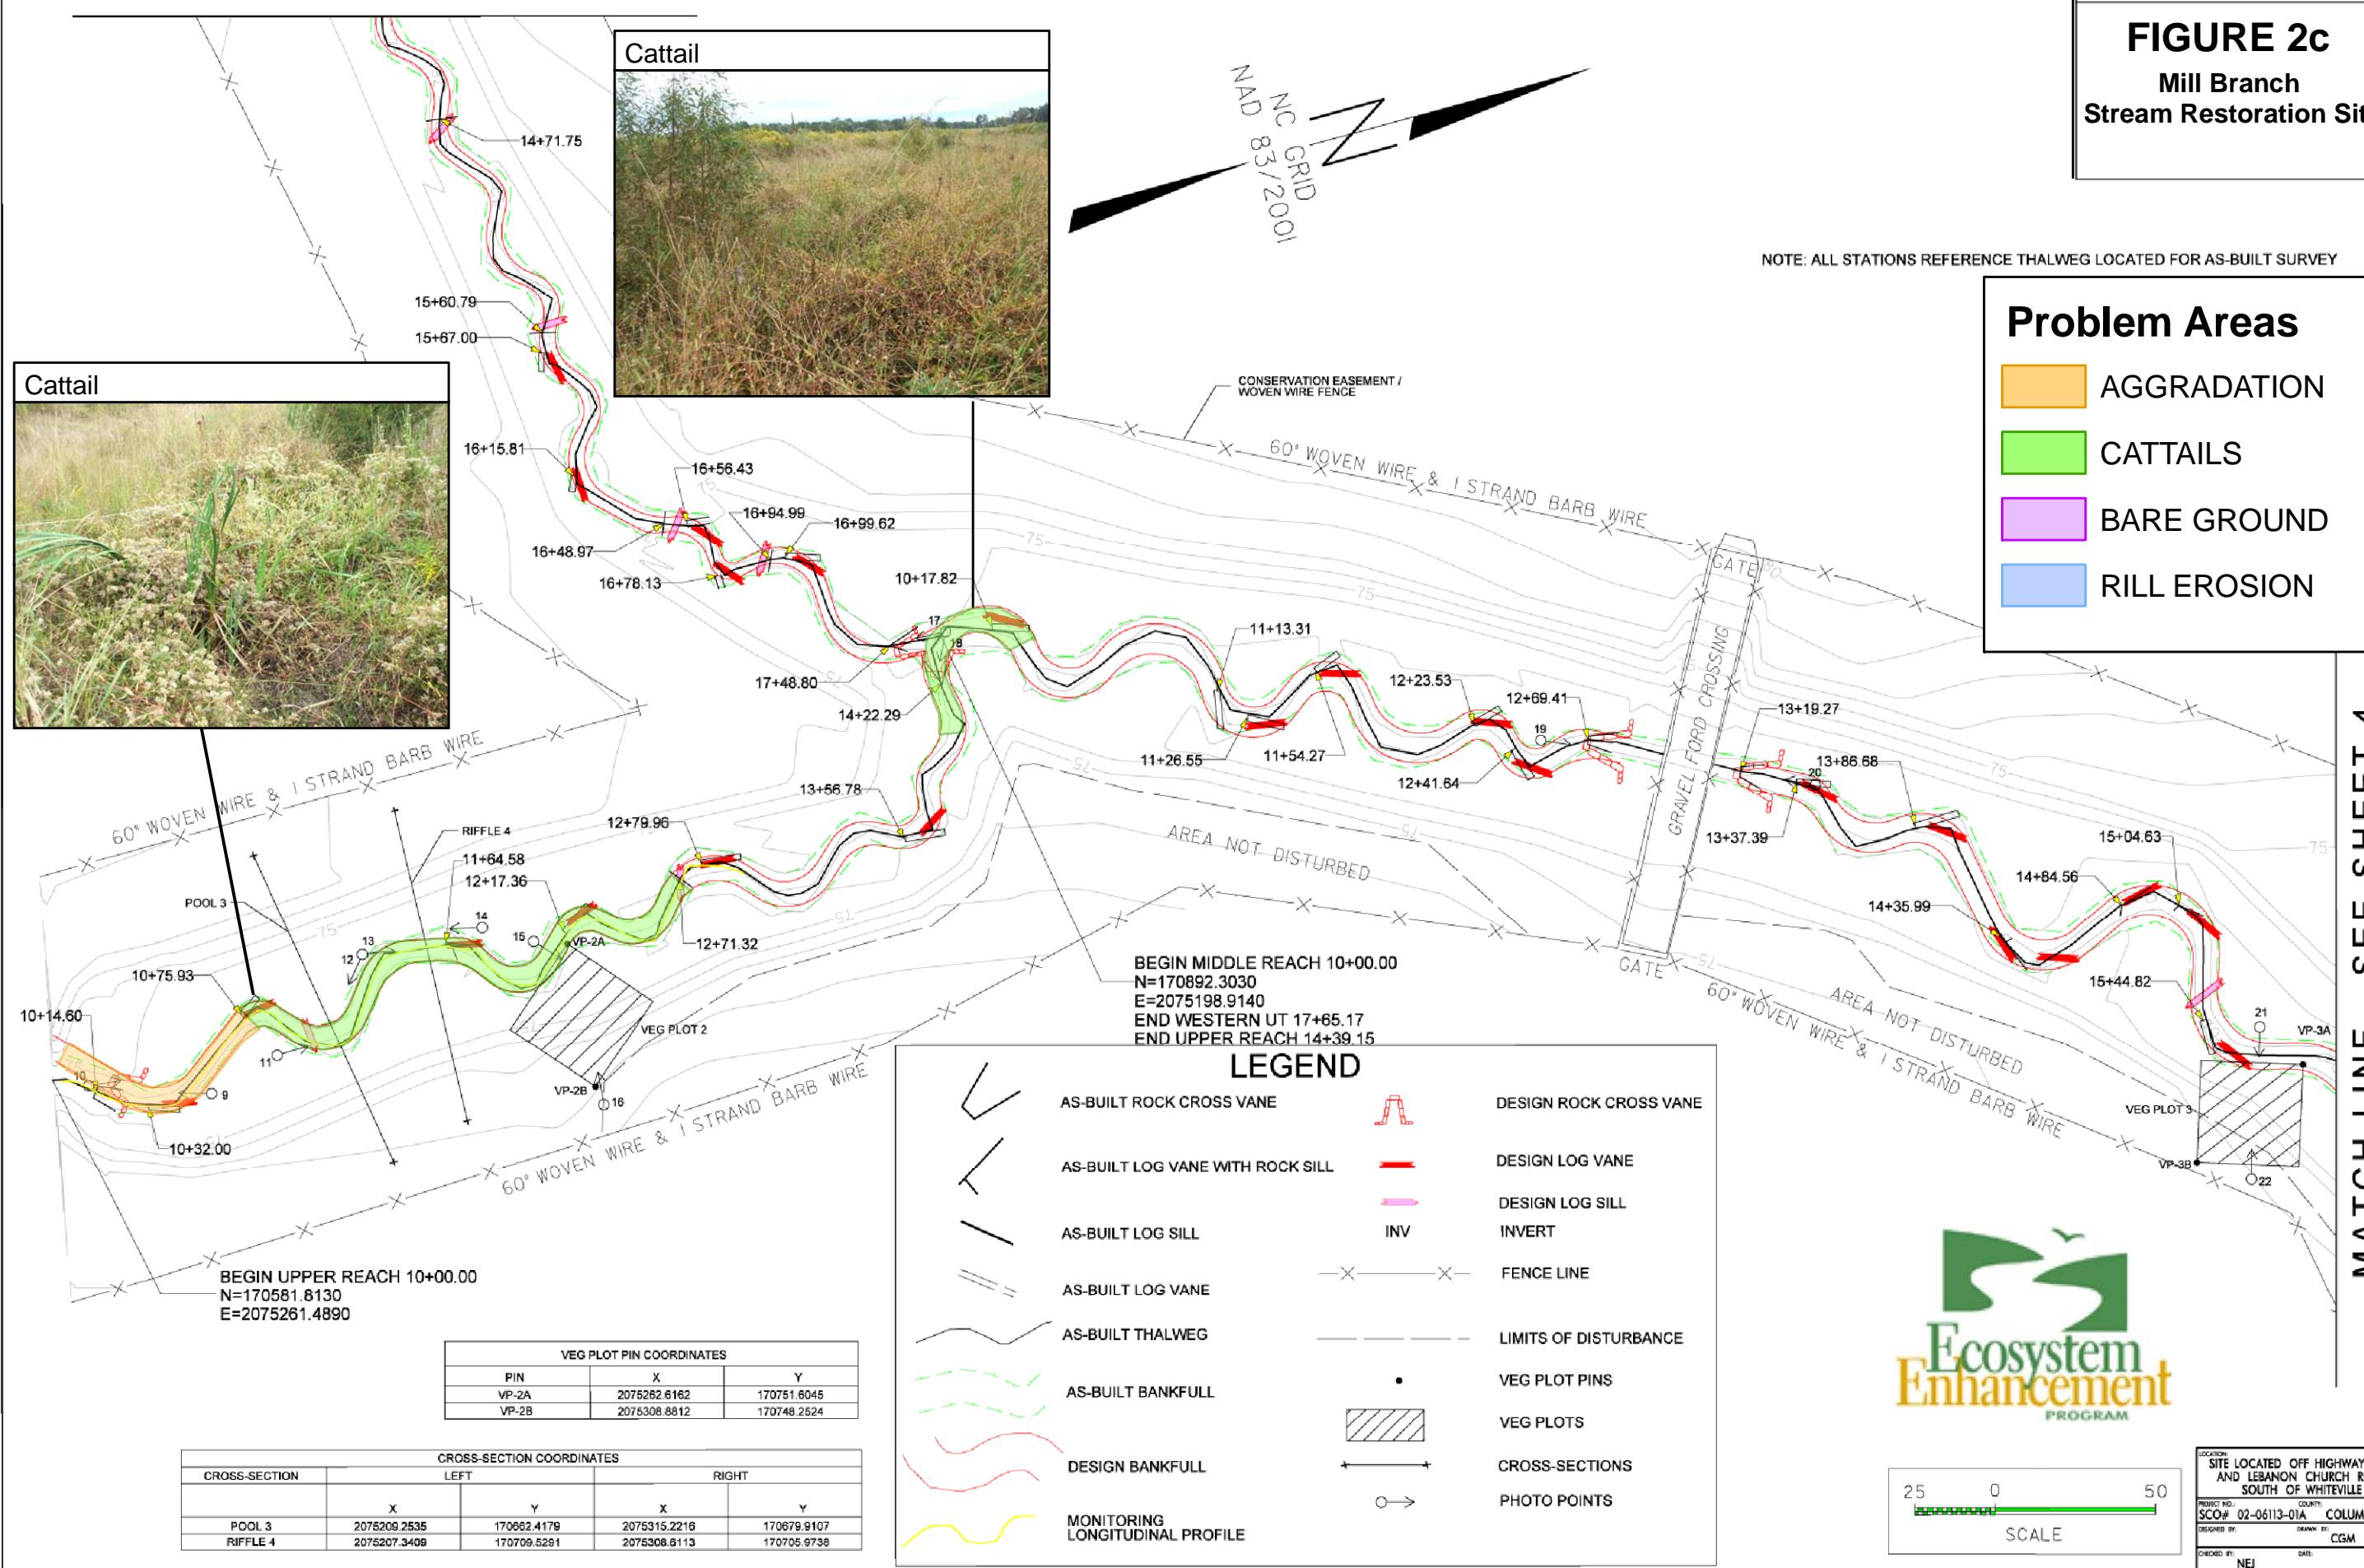

**MATCH LINE - SEE SHEET 4**

NOTE: ALL STATIONS REFERENCE THALWEG LOCATED FOR AS-BUILT SURVEY

<b>Problem Areas</b>	
AGGRADATION	
CATTAILS	
BARE GROUND	
RILL EROSION	


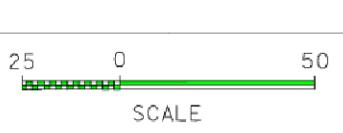


LOCATION: SITE LOCATED OFF HIGHWAY 701 AND LEBANON CHURCH ROAD SOUTH OF WHITEVILLE  
COUNTY: COLUMBUS  
PROJECT NO.: SC# 02-06113-01A  
DRAWN BY: CGM  
DESIGNED BY: DATE:  
CHECKED BY: DATE:  
NEJ

## FIGURE 2d

**Mill Branch  
Stream Restoration Site**


MATCH LINE - SEE SHEET 3

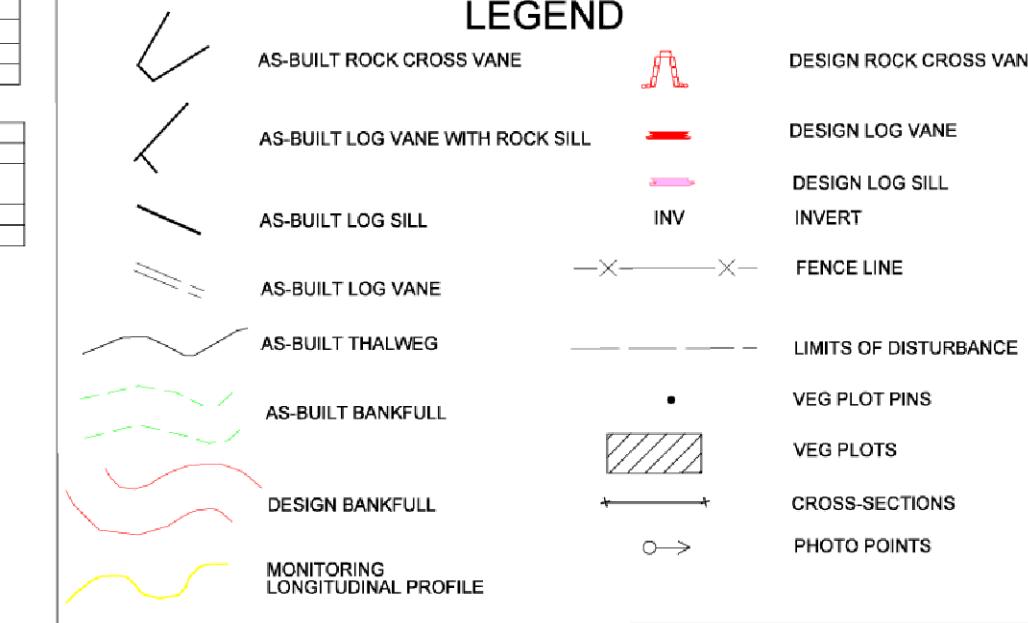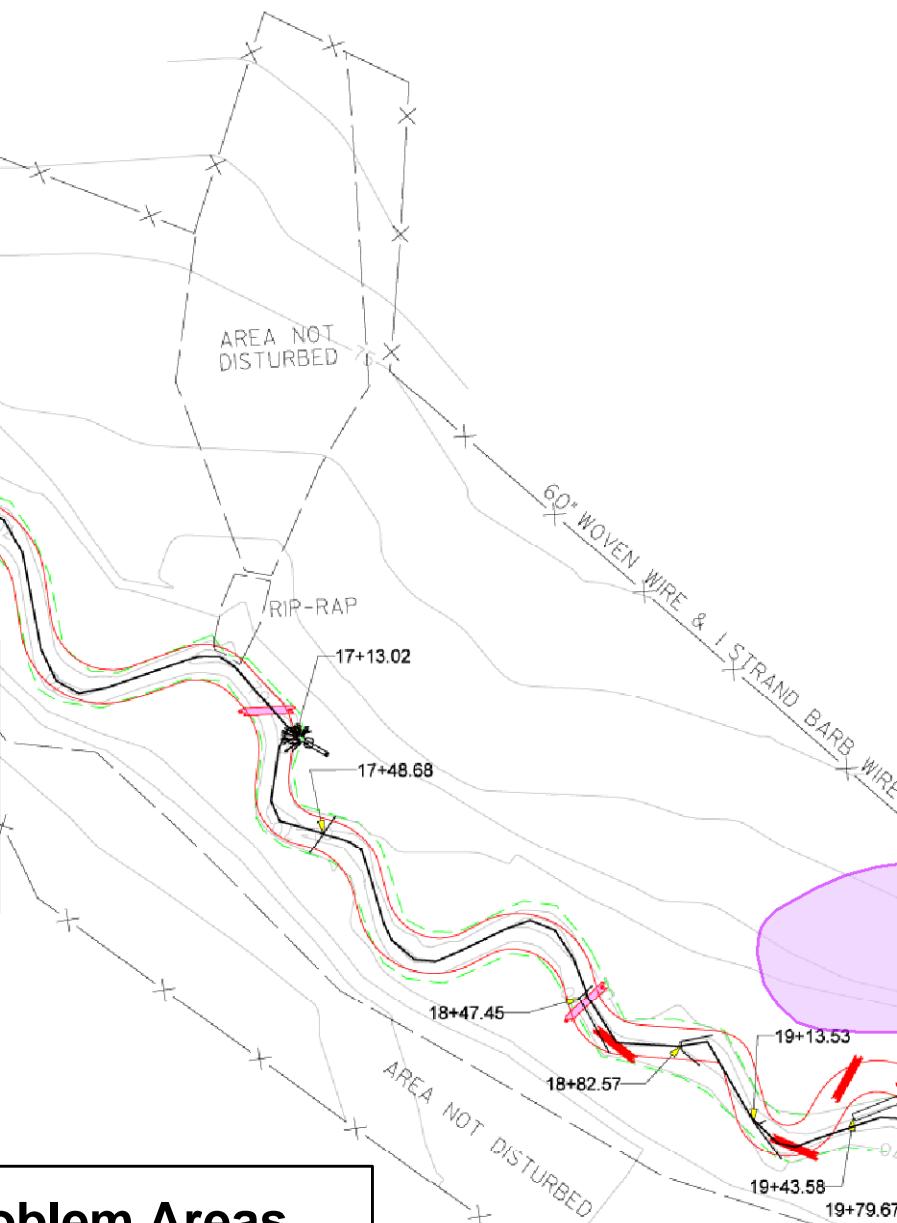

NAD  
NC  
83/2001  
GRID

A scale bar showing distances from 0 to 100 feet, with major ticks at 25, 50, and 75.

MATCH LINE - SEE SHEET 5

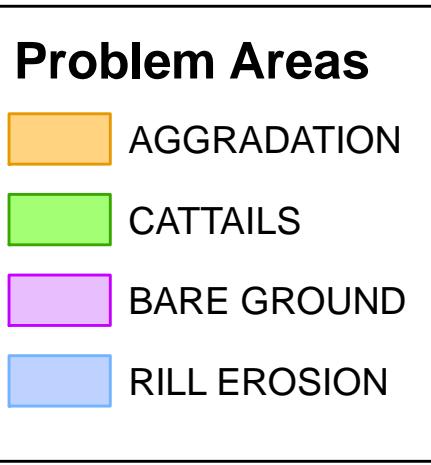

NOTE: ALL STATIONS REFERENCE THALWEG LOCATED FOR AS-BUILT SURVEY



LOCATION: SITE LOCATED OFF HIGHWAY 701  
AND LEBANON CHURCH ROAD  
SOUTH OF WHITEVILLE  
PROJECT NO.: SCO# 02-06113-01A  
COUNTRY: COUNTY  
DRAWN BY: CGM  
DESIGNED BY: DRAWN BY: CGM  
CHECKED BY: DATE: NEJ

**FIGURE 2e**  
Mill Branch  
Stream Restoration Site


## Problem Areas

- AGGRADATION
- CATTAILS
- BARE GROUND
- RILL EROSION

NAD  
NC  
83 / 2001  
GRID


NOTE: ALL STATIONS REFERENCE THALWEG LOCATED FOR AS-BUILT SURVEY

MATCH LINE - SEE SHEET 4

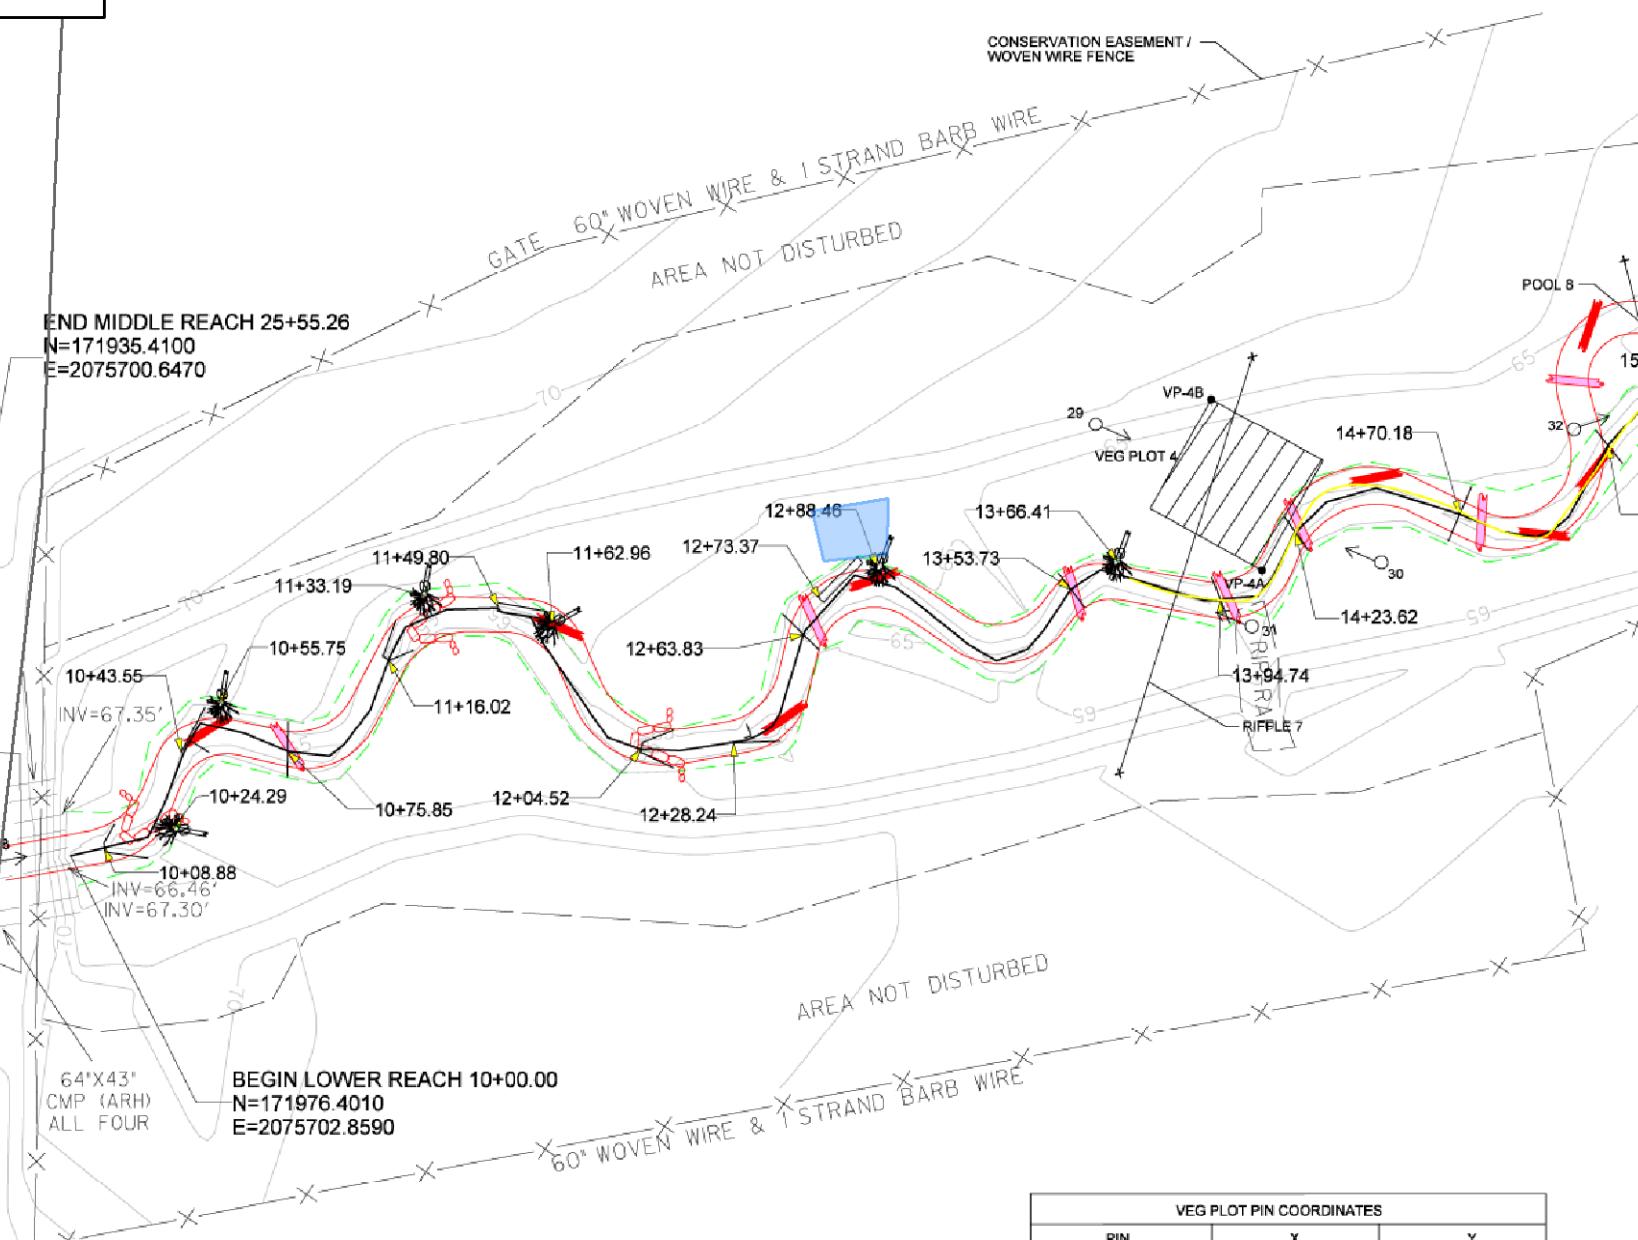

VEG PLOT PIN COORDINATES		
PIN	X	Y
VP-4A	2075668.9960	172287.9660
VP-4B	2075712.6850	172288.9580

CROSS-SECTION	LEFT		RIGHT	
	X	Y	X	Y
RIFFLE 7	2075659.3700	172300.9220	2075753.1770	172240.1770
POOL 8	2075660.5760	172399.0200	2075740.8880	172397.2830

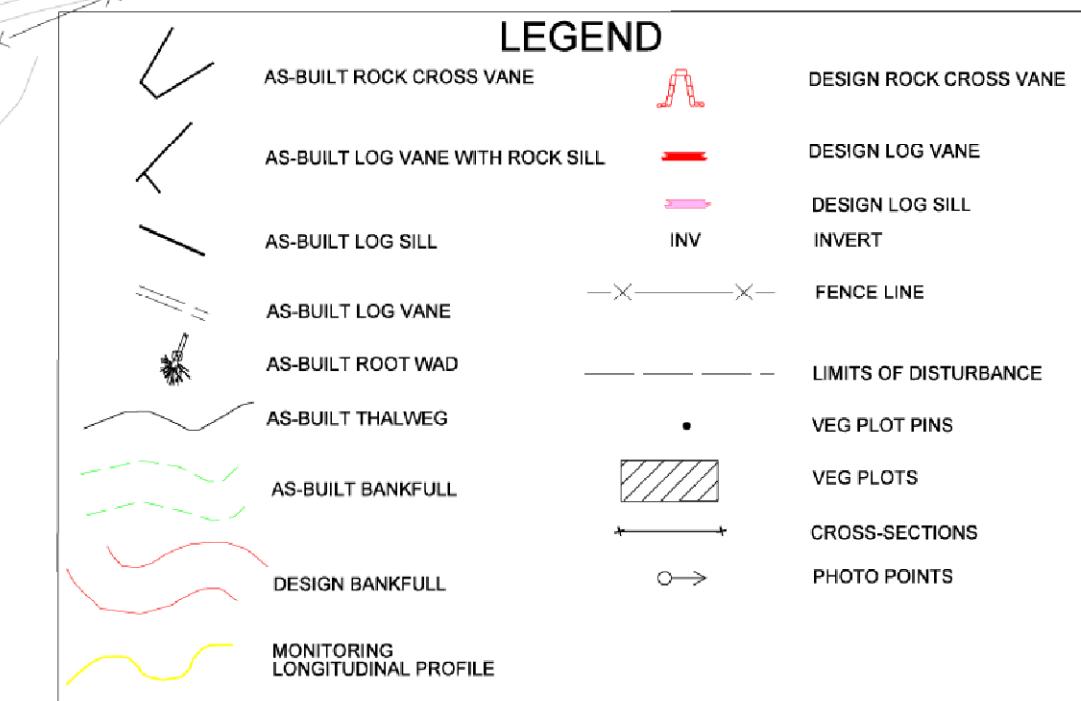

LOCATION  
SITE LOCATED OFF HIGHWAY 701  
AND LEBANON CHURCH ROAD  
SOUTH OF WHITEVILLE  
PROJECT NO.  
SCO# 02-06113-01A COUNTY  
DESIGNED BY DRAWN BY  
CGM DATE  
CHECKED BY NEJ DATE

## ***APPENDIX B***

## Appendix B – General Project Tables

<b>Table 1. Project Restoration Components</b> <b>Mill Branch Stream Restoration Project (EEP 0251)</b>								
<b>Reach ID</b>	<b>Existing Feet/Acres</b>	<b>Type</b>	<b>Approach</b>	<b>Footage or Acreage</b>	<b>Mitigation Ratio</b>	<b>Mitigation Units</b>	<b>Stationing</b>	<b>Comment</b>
Western	660	R	P2	765.2	1.0	765.2	10+00.0 to 17+65.2	Smaller tributary
Upper	340	R	P2	439.2	1.0	439.2	10+00.0 to 14+39.2	Above confluence with trib
Middle	1265	R	P2	1555.3	1.0	1555.3	10+00.0 to 25+55.3	Between confluence and road crossing (includes ford crossing)
Lower	670	R	P2	747.8	1.0	747.8	10+00.0 to 17+47.8	Below road crossing
<i>Restoration Summary</i>	2935			3507.5				
Mill Branch	1750	P	-	1750.0	5.0	350.0		Downstream of restoration project
Riparian Wetlands	35.8	P	-	35.8	5.0	7.2		Downstream of restoration project
Non-Riparian Wetlands	1.5	P	-	1.5	5.0	0.3		Downstream of restoration project
<b>Mitigation Unit Summations</b>								
Stream (lf)	Riparian Wetland (ac)	Nonriparian Wetland (ac)		Total Wetland (ac)		Buffer (ac)	Comment	
<b>3857.5</b>	<b>7.2</b>	<b>0.3</b>		<b>7.5</b>		0.0		

R = Restoration

P2 = Priority 2

P = Preservation

**Table 2. Project Activity and Reporting History**  
**Mill Branch Stream Restoration - EEP Project No. 251**

<b>Activity or Report</b>	<b>Data Collection Complete</b>	<b>Actual Completion or Delivery</b>
Restoration Plan	NA	Jan 2005
Final Design - 90%	NA	Sept 2005
Construction	Jan 2007	Jan 2007
Temporary S&E mix applied to entire project area	Jan 2007	Jan 2007
Permanent seed mix applied to entire project area	Jan 2007	Jan 2007
Containerized and B&B plantings	Jan 2007	Jan 2007
Mitigation Plan / As-built (Year 0 Monitoring - baseline)	April 2007	June 2007
Year 1 Monitoring	Nov 2007	Dec 2007
Year 2 Monitoring	Nov 2008	Jan 2009
Year 3 Monitoring	Nov 2009	NA
Year 4 Monitoring	NA	NA
Year 5 Monitoring	NA	NA

**Table 3. Project Contacts Table**  
**Mill Branch Stream Restoration - EEP Project No. 251**

<b>Designer</b>	Stantec Consulting Services, Inc. 801 Jones Franklin Road Suite 300 Raleigh, NC 27606 Brad Fairley, (919) 851-6866
Primary project design POC	
<b>Construction Contractor</b>	North State Environmental, Inc 2889 Lowery St. Suite B Winston-Salem, NC 27101 Darrell Westmoreland (336) 725-2405
Construction contractor POC	
<b>Planting Contractor</b>	North State Environmental, Inc 2889 Lowery St. Suite B Winston-Salem, NC 27101 Darrell Westmoreland (336) 725-2405
Planting Contractor POC	
<b>Seeding Contractor</b>	North State Environmental, Inc 2889 Lowery St. Suite B Winston-Salem, NC 27101 Darrell Westmoreland (336) 725-2405
Seeding Contractor POC	
Seed Mix Sources	contact North State Environmental, Inc
Nursery Stock Suppliers	Dykes & Son Nursery 825 Maude Etter Rd McMinnville, TN 37110  North State Environmental, Inc 2889 Lowery St. Suite B Winston-Salem, NC 27101 Stephen C. Joyce (336) 725-2405
<b>Monitoring Performers (Year 3)</b>	Rummel, Klepper, and Kahl, LLP 900 Ridgefield Drive Suite 250 Raleigh, NC 27609
Stream Monitoring POC	Pete Stafford (919)878-9560
Vegetation Monitoring POC	Pete Stafford (919)878-9560
Wetland Monitoring POC	NA

**Table 4. Project Attribute Table**  
**Mill Branch Stream Restoration Site/EEP Project No. 0251**

Project County	Columbus
Drainage Area	178 acres
Drainage impervious cover estimate (%)	< 1 percent
Stream Order (from Soil Survey)	1 <sup>st</sup> order: Western & Upper Reaches 2 <sup>nd</sup> order: Middle & Lower Reaches
Physiographic Region	Coastal Plain
Ecoregion	Atlantic Southern Loam Plains (65l)
Rosgen Classification of As-built	C
Cowardin Classification	Preservation Areas: PFO4/1A; PFO1C; PFO1A; PSS1/3A
Dominant soil types	Muckalee: Lower, Middle, and Western Reaches Goldsboro, Wagram: Upper Reach
Reference site ID	UT to Hog Swamp, UT to Ironhill Branch, Muddy Creek, Mill Creek
USGS HUC for Project	03040206060020
USGS HUC for Reference	UT to Hog Swamp: 03040203180030 UT to Ironhill Branch: 03040206060040 Muddy Creek: 03030004080090 Mill Creek: 03030004070060
NCDWQ Subbasin for Project	03-07-57
NCDWQ Subbasin for Reference	UT to Hog Swamp: 03-07-54 UT to Ironhill Branch: 03-07-57 Muddy Creek: 03-06-14 Mill Creek: 03-06-14
NCDWQ Classification for Project	C SW
NCDWQ Classification for Reference	C - Muddy Creek C SW - UT to Hog Swamp; UT to Ironhill Branch WS-III - Mill Creek
Any portion of any project segment 303d listed?	No
Any portion of any project segment upstream of a 303d listed segment?	No
Reasons for 303d listing or stressor	No
Percent of project easement fenced	100%

## ***APPENDIX C***

## **Appendix C – Vegetation Assessment Data**

**Table 5. Vegetation Plot Mitigation Success Summary Table**

<b>Tract</b>	<b>Vegetation Plot ID</b>	<b>Vegetation Survival Threshold Met?</b>	<b>Tract Mean</b>
Reach 1	VP1	Y	50%
Reach 2	VP2	N	
Reach 3	VP3	N	
Reach 4	VP4	Y	

**Appendix C – Vegetation Monitoring Plot Photos** (all photos recorded on October 1, 2009)



Vegetation Plot 1



Vegetation Plot 2

**All photos recorded on October 1, 2009**



Vegetation Plot 3



Vegetation Plot 4

All photos recorded on October 1, 2009

## Appendix C – Vegetation Metadata

**Table 6. Vegetation Metadata Table  
Mill Branch Restoration Site  
EEP No: 251**

Report Prepared By	William (Pete) Stafford
Date Prepared	11/6/2009 10:47
Database Name	cvs-eep-entrytool-v2.2.6.mdb
Database Location	C:\Documents and Settings\pstafford\Desktop\CVS Veg Data
Computer Name	STAFFORDP
<b>Description Worksheets In This Document</b>	
Metadata	This worksheet, which is a summary of the project data.
Planted	Each project is listed with its PLANTED stems, for each year. This excludes live stakes and lists stems per acre.
Total Stems	Each Project is listed with its total stems for each year. This includes live stakes, all planted stems, and all natural/volunteer stems. Listed in stems per acre.
Plots	List of Plots surveyed
Vigor	Frequency distribution of vigor classes
Vigor by Species	Frequency distribution of vigor classes listed by species
Damage	List of most frequent damage classes with number of occurrences and percent of total stems impacted by each
Damage by Species	Damage values tallied by type for each species
Damage by Plot	Damage values tallied by type for each plot
Planted Stems by Plot	Count of planted living stems of each species for each plot; dead and missing stems are excluded
<b>Project Summary</b>	
EEP Project Number	251
Project Name	Mill Branch
Description	Stream Restoration
River Basin	Lumber
Length (ft)	
Stream to Edge width (ft)	
Area (sq. m)	
Required Plots (calculated)	
Sampled Plots	4

### Appendix C - Stem Count Total and Planted Species by Plot and Species

Scientific Name	Common Name	Type	CURRENT DATA (MY3 2009)								ANNUAL MEANS									
			Plot 1		Plot 2		Plot 3		Plot 4		Current Mean		MY2 (2008)		MY1 (2007)		AB (2007)			
P	T	P	T	P	T	P	T	P	T	P	T	P	T	P	T	P	T	P	T	
<i>Betula nigra</i>	River Birch	T	1	1	1	1	1			3	2	3	2	3	3	3	3	3	3	3
<i>Carpinus caroliniana var. caroliniana</i>	American Hornbeam	T	2		1				2	1	5	1	5	2	5	5	5	5	5	5
<i>Cephalanthus occidentalis</i>	Buttonbush	S								1	0	1	0	1	0	0	0	0	0	0
<i>Cornus amomum</i>	Silky Dogwood	T	1		2	1	4	2	1	8	3	8	5	8	8	8	8	8	8	8
<i>Liriodendron tulipifera var. tulipifera</i>	Tulip Poplar	T	2	2						2	2	2	2	2	2	2	2	2	2	2
<i>Platanus occidentalis var. occidentalis</i>	Sycamore	T	1	1	1	1	1	1	1	4	3	4	3	4	4	4	4	4	4	4
<i>Quercus lyrata</i>	Overcup Oak	T	1	1	3	2	1	2		5	5	5	4	5	5	5	5	5	5	5
<i>Quercus pagoda</i>	Cherrybark Oak	T							1	1	1	1	1	1	1	1	1	1	1	1
<i>Quercus phellos</i>	Willow Oak	T	2	2			1		3	3	6	5	6	6	6	6	6	6	6	6
<i>Quercus nigra</i>	Water Oak	T							1		1	0	1	1	1	1	1	1	1	1
<i>Salix sericea</i>	Willow	T			3		1	1	4	2	8	3	8	4	8	8	8	8	8	8
*No baseline data for this project Type = Tree or Shrub P = Planted, T = Total			Plot Area		0.025 acre		0.025 acre		0.025 acre		0.025 acre									
			Species Count		5		4		4		5		10		11		11		11	
			Stem Count		7		5		6		8		26		31		43		43	
			Stems/Acre		280		200		240		320		260		310		430		430	

**Appendix C – Vegetation Problem Areas Photos** (photos recorded on 10/1/09)



VPA 1 – Cattail – Throughout the project site

**All pictures recorded on 10/1/09**

**Appendix C – Vegetation Problem Area inventory Table**

	<b>Species</b>	<b>Total Planted Stems</b>	<b># plots</b>	<b>Avg # stems</b>	<b>VP2</b>	<b>VP3</b>
	<i>Betula nigra</i>	1	1	1	1	
	<i>Carpinus caroliniana</i> var. <i>caroliniana</i>					
	<i>Cephalanthus occidentalis</i>					
	<i>Cornus amomum</i>	3	2	1.5	1	2
	<i>Liriodendron tulipifera</i> var. <i>tulipifera</i>					
	<i>Platanus occidentalis</i> var. <i>occidentalis</i>	2	2	1	1	1
	<i>Quercus lyrata</i>	4	2	2	2	2
	<i>Quercus pagoda</i>					
	<i>Quercus phellos</i>					
	<i>Salix sericea</i>	1	1	0.5		1
<b>TOT:</b>	<b>10</b>	<b>11</b>	<b>8</b>	<b>3</b>	<b>5</b>	<b>6</b>

## ***APPENDIX D***

**Appendix D - Stream Photo Station Photos** (all photos recorded on October 1, 2009)



Photo Station 1. Beginning of Western Reach – Upstream



Photo Station 2. Beginning of Western Reach – Downstream

**All photos recorded on October 1, 2009**



Photo Station 3. Riffle Cross-section 1 – Downstream – Western Reach



Photo Station 4 Riffle Cross-section 1 – Upstream – Western Reach

All photos recorded on October 1, 2009



Photo Station 5. Pool Cross-section 2 - Downstream – Western Reach



Photo Station 6. Pool Cross-section – Upstream – Western Reach

All photos recorded on October 1, 2009



Photo Station 9. Beginning of Upper Reach – Upstream



Photo Station 10. Beginning of Upper Reach – Downstream

All photos recorded on October 1, 2009



Photo Station 11. Pool Cross-section 3 – Downstream – Upper Reach



Photo Station 12. Pool Cross-section 3 – Upstream – Upper Reach

All photos recorded on October 1, 2009



Photo Station 13. Riffle Cross-section 4 – Downstream – Upper Reach



Photo Station 14. Riffle Cross-section 4 – Upstream – Upper Reach

All photos recorded on October 1, 2009



Photo Station 17. Confluence of Western and Upper Reaches – Western Reach



Photo Station 18. Confluence of Western and Upper Reaches – Upper Reach

**All photos recorded on October 1, 2009**



Photo Station 19. Ford Crossing – Downstream – Middle Reach



Photo Station 20. Ford Crossing – Upstream – Middle Reach

All photos recorded on October 1, 2009



Photo Station 23. Riffle Cross-section 5 - Downstream – Middle Reach



Photo Station 24. Riffle Cross-section 5 - Upstream – Middle Reach

**All photos recorded on October 1, 2009**



Photo Station 25. Pool Cross-section 6 - Downstream – Middle Reach



Photo Station 26. Pool Cross-section 6 - Upstream – Middle Reach

All photos recorded on October 1, 2009



Photo Station 31. Riffle Cross-section 7 – Upstream – Lower Reach



Photo Station 32. Riffle Cross-section 7 – Downstream – Lower Reach

**All photos recorded on October 1, 2009**



Photo Station 33. Pool Cross-Section 8 – Upstream – Lower Reach



Photo Station 34. End of Project – Upstream – Lower Reach

**All photos recorded on October 1, 2009**

**Table 8A. Visual Morphological Stability Assessment  
Mill Branch Stream Restoration Site/EEP Project No. 0251  
Western Reach**

Feature Category	Metric (per As-built and reference baselines)	(# Stable) Number Performing as Intended	Total Number per As-built	Total Number/Feet in Unstable State	% Perform in Stable Condition	Feature Perform. Mean or Total
A. Riffles	1. Present?	29	29	0.00	100.00	
	2. Armor stable (eg no displacement?)	NA	NA	NA	NA	
	3. Facet grade appears stable?	29	29	0.00	100.00	
	4. Minimal evidence of embedding/fining?	29	29	0.00	100.00	
	5. Length appropriate?	29	29	0.00	100.00	100
B. Pools	1. Present? (e.g. not subject to severe aggrad. or migrat.?)	30	30	0.00	100.00	
	2. Sufficiently deep (Max Pool D:Mean Bkf > 1.6?)	30	30	0.00	100.00	
	3. Length appropriate?	30	30	0.00	100.00	100
C. Thalweg	1. Upstream of meander bend (run/inflection) centering?	NA	NA	NA		
	2. Downstream of meander (glide/inflection) centering?	NA	NA	NA		NA
D. Meanders	1. Outer bend in state of limited/controlled erosion?	30	30	0.00	100.00	
	2. Of those eroding, # w/concomitant point bar formation?	30	30	0.00	100.00	
	3. Apparent Rc within spec?	30	30	0.00	100.00	
	4. Sufficient floodplain access and relief?	30	30	0.00	100.00	100
E. Bed General	1. General channel bed aggradation areas (bar formation)	1765	1765	0.00	100.00	
	2. Channel bed degradation - areas of increasing down-cutting or head-cutting?	1765	1765	0.00	100.00	0
F. Bank	1. Actively eroding, wasting, or slumping bank?	1765	1765	0.00	100.00	0
G. Vanes	1. Free of back or arm scour?	8	8	0.00	100.00	
	2. Height appropriate?	8	8	0.00	100.00	
	3. Angle and geometry appear appropriate?	8	8	0.00	100.00	
	4. Free of piping or other structural failures?	8	8	0.00	100.00	100
H. Wads/Boulders	1. Free of scour?	NA	NA	NA	NA	
	2. Footing stable?	NA	NA	NA	NA	NA

**Table 8B. Visual Morphological Stability Assessment**  
**Mill Branch Stream Restoration Site/EEP Project No. 0251**

**Upper Reach**

Feature Category	Metric (per As-built and reference baselines)	(# Stable) Number Performing as Intended	Total Number per As-built	Total Number/Feet in Unstable State	% Perform in Stable Condition	Feature Perform. Mean or Total
A. Riffles	1. Present?	15	15	0.00	100.00	
	2. Armor stable (eg no displacement?)	NA	NA	0.00	NA	
	3. Facet grade appears stable?	15	15	0.00	100.00	
	4. Minimal evidence of embedding/fining?	15	15	0.00	100.00	
	5. Length appropriate?	15	15	0.00	100.00	100
B. Pools	1. Present? (e.g. not subject to severe aggrad. or migrat.?)	15	15	0.00	100.00	
	2. Sufficiently deep (Max Pool D:Mean Bkf > 1.6?)	15	15	0.00	100.00	
	3. Length appropriate?	15	15	0.00	100.00	100
C. Thalweg	1. Upstream of meander bend (run/inflection) centering?	NA	NA	NA		
	2. Downstream of meander (glide/inflection) centering?	NA	NA	NA		NA
D. Meanders	1. Outer bend in state of limited/controlled erosion?	15	15	0.00	100.00	
	2. Of those eroding, # w/concomitant point bar formation?	15	15	0.00	100.00	
	3. Apparent Rc within spec?	15	15	0.00	100.00	
	4. Sufficient floodplain access and relief?	15	15	0.00	100.00	100
E. Bed General	1. General channel bed aggradation areas (bar formation)	1439	1439	0.00	100.00	
	2. Channel bed degradation - areas of increasing down-cutting or head-cutting?	1439	1439	0.00	100.00	100
F. Bank	1. Actively eroding, wasting, or slumping bank?	1439	1439	0.00	100.00	100
G. Vanes	1. Free of back or arm scour?	7	7	0.00	100.00	
	2. Height appropriate?	7	7	0.00	100.00	
	3. Angle and geometry appear appropriate?	7	7	0.00	100.00	
	4. Free of piping or other structural failures?	7	7	0.00	100.00	100
H. Wads/Boulders	1. Free of scour?	NA	NA	NA	NA	
	2. Footing stable?	NA	NA	NA	NA	NA

**Table 8C. Visual Morphological Stability Assessment**  
**Mill Branch Stream Restoration Site/EEP Project No. 0251**  
**Middle Reach**

Feature Category	Metric (per As-built and reference baselines)	(# Stable) Number Performing as Intended	Total Number per As-built	Total Number/Feet in Unstable State	% Perform in Stable Condition	Feature Perform. Mean or Total
A. Riffles	1. Present?	42	42	0 NA 0 0 0	100.00	
	2. Armor stable (eg no displacement?)	NA	NA		NA	
	3. Facet grade appears stable?	42	42		100.00	
	4. Minimal evidence of embedding/fining?	42	42		100.00	
	5. Length appropriate?	42	42		100.00	100
B. Pools	1. Present? (e.g. not subject to severe aggrad. or migrat.?)	41	42	1 1 0	97.62	
	2. Sufficiently deep (Max Pool D:Mean Bkf > 1.6?)	41	42		97.62	
	3. Length appropriate?	42	42		100.00	98
C. Thalweg	1. Upstream of meander bend (run/inflection) centering?	NA	NA	NA NA		
	2. Downstream of meander (glide/inflection) centering?	NA	NA			NA
D. Meanders	1. Outer bend in state of limited/controlled erosion?	41	42	1 1 0 3	97.62	
	2. Of those eroding, # w/concomitant point bar formation?	41	42		97.62	
	3. Apparent Rc within spec?	42	42		100.00	
	4. Sufficient floodplain access and relief?	39	42		92.86	97
E. Bed General	1. General channel bed aggradation areas (bar formation)	2535	2555	20 15	99.22	
	2. Channel bed degradation - areas of increasing down-cutting or head-cutting?	2540	2555		99.41	99
F. Bank	1. Actively eroding, wasting, or slumping bank?	2545	2555	10	99.61	100
G. Vanes	1. Free of back or arm scour?	19	20	1 2 2 3	95.00	
	2. Height appropriate?	18	20		90.00	
	3. Angle and geometry appear appropriate?	18	20		90.00	
	4. Free of piping or other structural failures?	17	20		85.00	90
H. Wads/Boulders	1. Free of scour?	1	1	0 0	100.00	
	2. Footing stable?	1	1		100.00	100

**Table 8D. Visual Morphological Stability Assessment**  
**Mill Branch Stream Restoration Site/EEP Project No. 0251**  
**Lower Reach**

Feature Category	Metric (per As-built and reference baselines)	(# Stable) Number Performing as Intended	Total Number per As-built	Total Number/Feet in Unstable State	% Perform in Stable Condition	Feature Perform. Mean or Total
A. Riffles	1. Present?	19	19	0	100.00	
	2. Armor stable (eg no displacement?)	NA	NA	NA	NA	
	3. Facet grade appears stable?	19	19	0	100.00	
	4. Minimal evidence of embedding/fining?	19	19	0	100.00	
	5. Length appropriate?	19	19	0	100.00	100
B. Pools	1. Present? (e.g. not subject to severe aggrad. or migrat.?)	18	18	0	100.00	
	2. Sufficiently deep (Max Pool D:Mean Bkf > 1.6?)	18	18	0	100.00	
	3. Length appropriate?	18	18	0	100.00	100
C. Thalweg	1. Upstream of meander bend (run/inflection) centering?	NA	NA	NA		
	2. Downstream of meander (glide/inflection) centering?	NA	NA	NA		NA
D. Meanders	1. Outer bend in state of limited/controlled erosion?	17	18	1	94.44	
	2. Of those eroding, # w/concomitant point bar formation?	18	18	0	100.00	
	3. Apparent Rc within spec?	18	18	0	100.00	
	4. Sufficient floodplain access and relief?	16	18	2	88.89	96
E. Bed General	1. General channel bed aggradation areas (bar formation)	1748	1748	0	100.00	
	2. Channel bed degradation - areas of increasing down-cutting or head-cutting?	1748	1748	0	100.00	100
F. Bank	1. Actively eroding, wasting, or slumping bank?	1728	1748	20	98.86	99
G. Vanes	1. Free of back or arm scour?	16	17	1	94.12	
	2. Height appropriate?	15	17	2	88.24	
	3. Angle and geometry appear appropriate?	15	17	2	88.24	
	4. Free of piping or other structural failures?	17	17	0	100.00	93
H. Wads/Boulders	1. Free of scour?	1	1	0	100.00	
	2. Footing stable?	1	1	0	100.00	100

## **Appendix D – Verification of Bankfull Events**

**Table 9. Verification of Bankfull Events  
East Tarboro Canal Stream Restoration Site - EEP Project No. 123**

<b>Date of Data Collection</b>	<b>Date of Occurrence</b>	<b>Method</b>	<b>Photo</b>
October 1, 2009	September/October 2009	Visual Observation	Stream Photos 33

Project Name	Mill Branch		
Cross Section	Cross-Section 1 - Western Reach		
Feature	Riffle		
Date	8/1/09		
Crew	Tutt, Stafford		
Year 5 - 2012 2012 Survey	Station	Year 4 - 2011 2011 Survey	Station
	Station	Elevation	Notes

Year 3 - 2009 2009 Survey			Year 2 - 2008 2008 Survey			Year 1 2007 Survey			AS-BUILT 2007 AS-BUILT Survey		
Station	Elevation	Notes	Station	Elevation	Notes	Station	Elevation	Notes	Station	Elevation	Notes
20	81.223		37.2	81.5		20.64	81.50		8.1	81.9	
39.72	80.6988		34.4	80.8		22.12	81.51		22.0	81.5	LPIN
46.69	78.9918		38.8	80.2		30.12	81.16		30.6	81.03	
51.21	77.869		45.7	78.1		40.13	80.63		39.9	80.6	
55.58	77.6746		49.0	77.9		50.7	77.8		45.1	79.3	
57						57.01	77.7		50.6	77.9	
59.49	77.1795		53.2	77.8		58.64	77.46		56.1	77.7	
59.92	77.1808		56.2	77.2		60.3	77.06		58.9	77.5	LBKF
60.25	77.0541		56.5	77.2		61.85	76.92		60.3	77.2	
61.55	77.0577		61.4	76.6		63.6	77.26		61.4	76.9	
62.75	77.314		64.2	77.3		64.88	77.39		62.7	77.1	
65.86	77.5454		66.8	77.6		67.97	77.54		64.8	77.5	RBKF
66.28	77.7664		67.9	77.7		77.23	77.43		69.1	77.6	
76.98	77.5233		70.8	77.8		85.63	77.5		79.1	77.5	
86.11	77.5823		86.1	77.6		93.42	78.79		86.9	77.8	
96.84	79.2929		97.8	79.3		97.04	79.18		95.2	79.1	
120.24	79.8711		120.5	80.0		108.31	79.4		108.4	79.33	RPIN
						118.85	79.77		120.1	79.9	
						120.29	79.98				
						124.16	79.96		133.0	80.4	

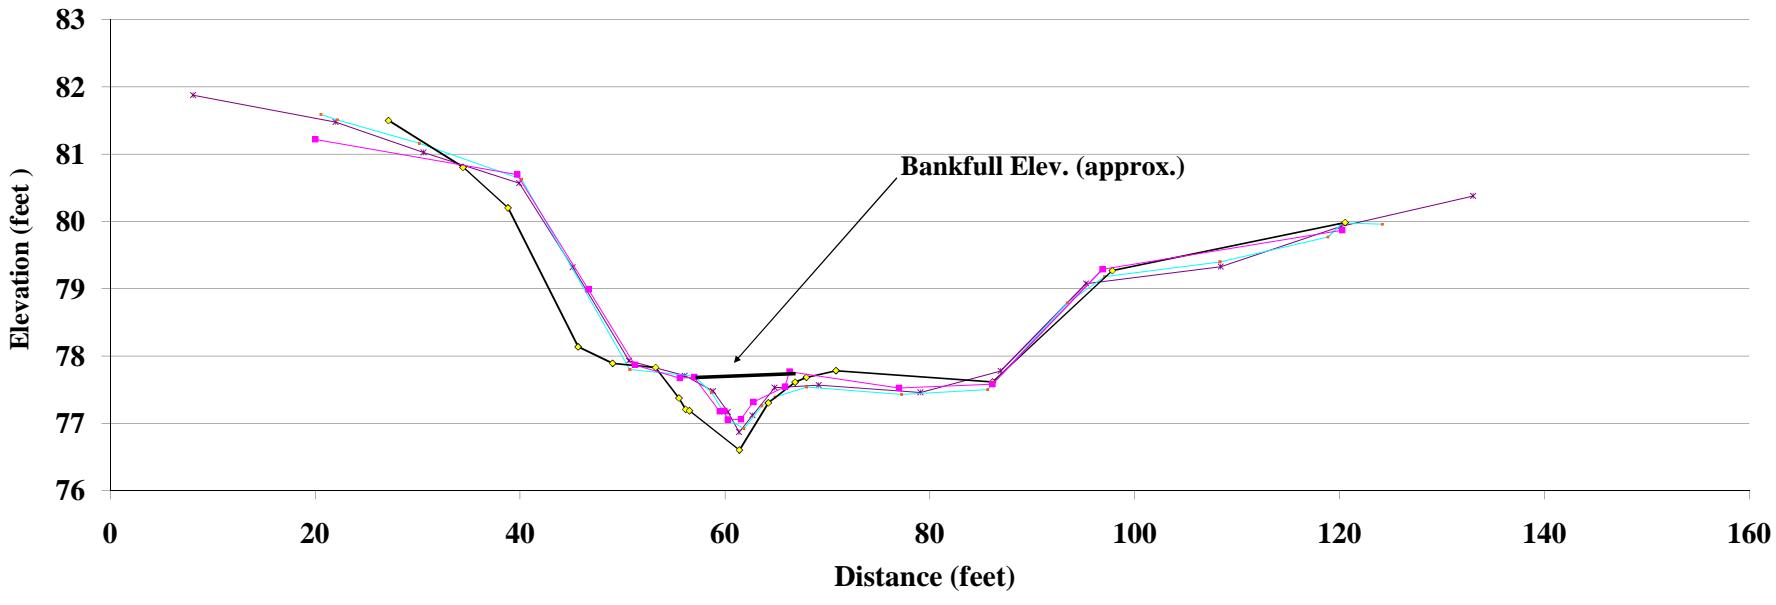


Photo of Cross-Section 1 - Looking Downstream @ STA 2+15

Area	Year 5 - 2012	Year 4 - 2011	Year 3 - 2009	Year 2 - 2008	Year 1	AS-BUILT 2007
Width			4.1	4.0	2.3	1.8
Mean Depth			23.4	19.5	8.7	6.0
Max Depth			0.2	0.2	0.3	0.3
W/D			0.6	1.1	0.6	0.6
			133.0	96.0	33.5	19.8

## Mill Branch 2009 - Riffle

### Cross Section 1- Western Reach STA: 2+15




Project Name	Mill Branch			
Cross Section	Cross-Section 2 - Western Reach			
Feature	Riffle			
Date	8/1/09			
Crew	Tutt, Stafford			
Year 5 - 2011 2011 Survey	Station	Year 4 - 2010 2010 Survey	Station	
Station	Elevation	Notes	Elevation	Notes

Year 3 - 2009 2009 Survey			Year 2 - 2008 2008 Survey			Year 1 2007 Survey			AS-BUILT 2007 AS-BUILT Survey		
Station	Elevation	Notes	Station	Elevation	Notes	Station	Elevation	Notes	Station	Elevation	Notes
44	80.8123		55.10	80.71		43.66	80.78		22.5	81.7	
59.09	80.1417		61.79	79.88		49.95	80.64		46.1	80.8	LPIN
71.59	77.5265		71.05	77.53		59.14	80.31		52.6	80.56	
78.17	77.2856		80.99	77.31		63.79	79.44		61.2	80.2	
84.7	77.3397		84.05	77.32		70.9	77.49		71.8	77.3	
90.13	77.1907		87.63	77.22		75.34	77.4		82.3	77.3	LBKF
94.53	75.9317		90.42	76.67		82.81	77.45		86.7	77.3	
98.08	77.2774		94.20	75.83		87.69	77.22		89.5	77.1	
101.98	77.2239		97.23	76.85		90.87	76.77		90.9	76.6	
103.17	77.4473		97.99	77.34		92.02	75.99		92.0	76.1	
115.44	79.0432		102.41	77.34		93.64	76.04		92.9	75.6	
134.15	79.6761		111.29	78.67		95.07	76.07		94.2	75.6	
			116.92	79.02		95.93	76.6		95.8	76.2	
			132.86	79.57		98.1	77.37		97.4	77.1	
			102.53	77.32		102.53	77.32		98.7	77.3	
			107.26	78.03		101.6	77.31		101.6	77.31	RBKF
			113.67	79.09		110.0	78.4		110.0	78.4	
			125.03	79.19		118.9	79.1		118.9	79.1	
			134.13	79.7		134.2	79.6		134.2	79.6	
			136.53	79.76		150.8	80.1		150.8	80.1	RPIN



Photo of Cross-Section 2 - Looking Upstream @ STA 2+50

Area	Year 5 - 2011	Year 4 - 2010	Year 3 - 2009	Year 2 - 2008	Year 1	AS-BUILT 2007
Width			6.7	8.2	7.5	8.7
Mean Depth			23.7	17.4	11.2	11.7
Max Depth			0.3	0.5	0.7	0.7
W/D			1.4	1.3	1.3	1.7
			83.2	37.1	16.7	15.7

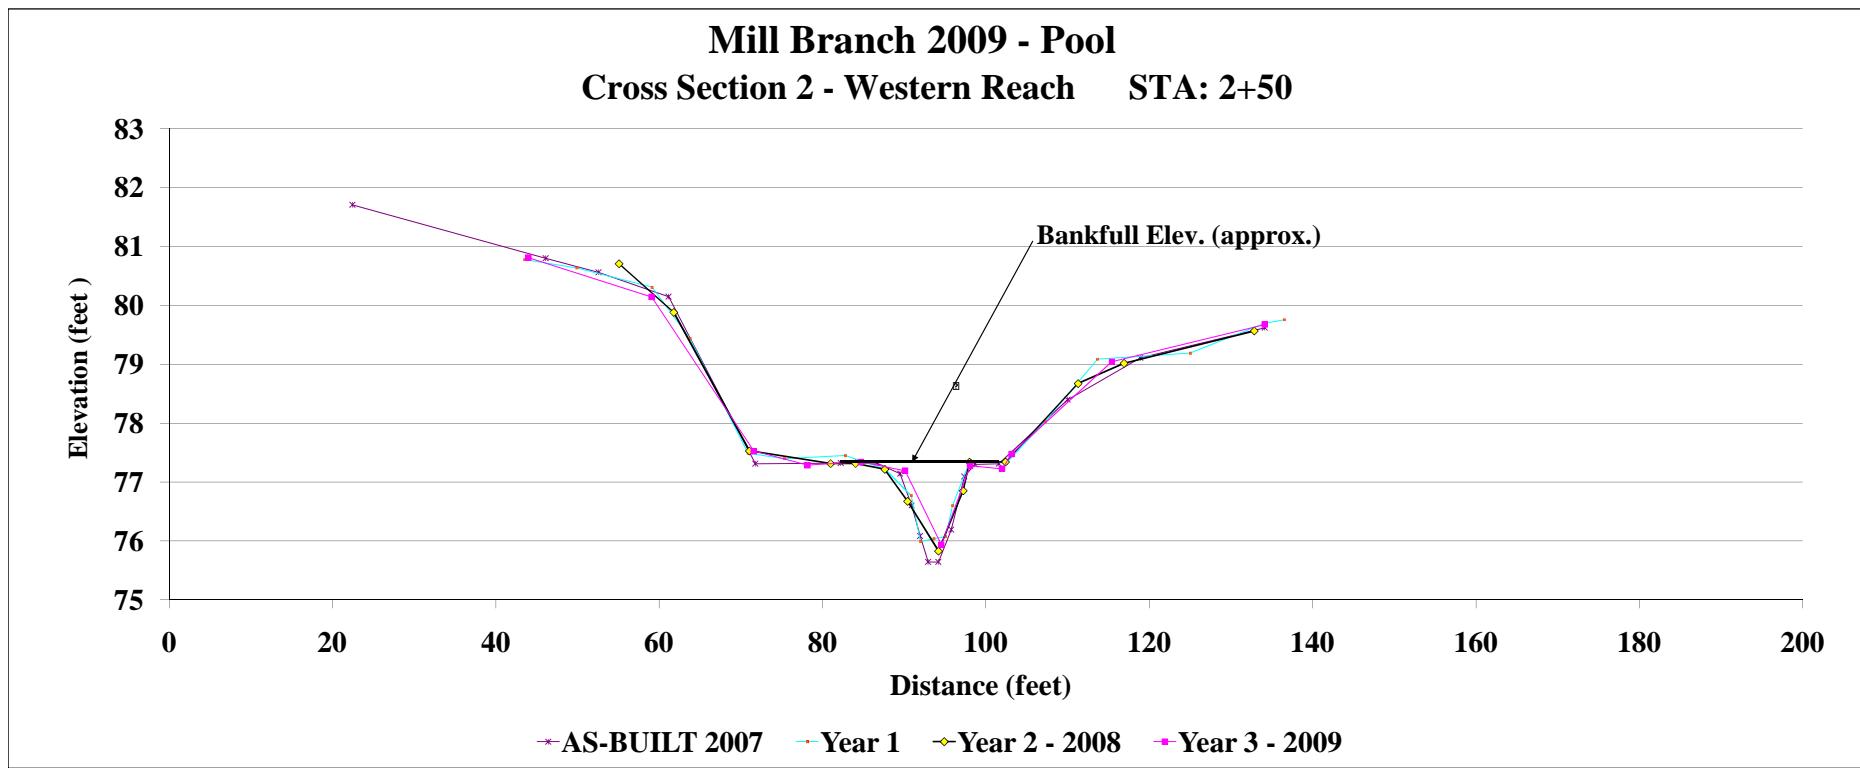


Project Name	Mill Branch			
Cross Section	Cross-Section 3 - Upper Reach			
Feature	Pool			
Date	Aug-09			
Crew	Tutt, Stafford			
Year 5 - 2011 2011 Survey	Station	Year 4 - 2010 2010 Survey	Station	
Station	Elevation	Notes	Elevation	Notes

Year 3 - 2009 2009 Survey			Year 2 - 2008 2008 Survey			Year 1 2007 Survey			AS-BUILT 2007 AS-BUILT Survey		
Station	Elevation	Notes	Station	Elevation	Notes	Station	Elevation	Notes	Station	Elevation	Notes
32	78.2458		10.25	78.46		16.37	78.26		5.0	78.6	
53.03	74.3698		31.88	78.12		16.57	78.46		16.5	78.4	LPIN
67.89	74.027		47.44	74.74		24.25	78.43		32.1	77.97	
78.2	73.7915		56.58	74.13		33.02	77.87		44.7	75.5	
82.83	73.1871		68.91	74.01		43.29	75.93		55.6	74.0	
86.07	73.8822		76.96	73.85		54.4	74.09		74.8	73.9	LBKF
86.92	74.1171		78.67	73.37		64.66	74.02		77.4	73.3	
95.02	74.4213		79.76	73.09		71.46	73.93		79.9	72.7	
99.58	75.1633		83.12	73.02		75.54	73.89		82.0	72.4	
108.39	77.6479		84.69	73.60		78.79	73.49		84.8	73.3	
122.55	77.8251		85.72	74.00		79.85	73.33		88.3	74.1	RBKF
			89.58	73.95		81.23	72.99		92.8	74.2	
			98.49	75.09		82.8	72.82		112.2	77.4	
			83.89	72.92		83.89	72.92		123.9	77.9	RPIN
			84.85	73.49		85.92	73.92		136.4	78.2	
			92.18	74.12		99.48	75.67				
			106.77	77.28		115.33	77.39				
			122.93	77.61		123.83	77.97				
			128.35	77.94							
			107.4	77.3		107.90	77.46				



Photo of Cross-Section 3 - Looking Downstream @ STA 1+07

Area	Year 5 - 2011	Year 4 - 2010	Year 3 - 2009	Year 2 - 2008	Year 1	AS-BUILT 2007
Width			2.6	2.0	5.8	9.8
Mean Depth			8.4	7.3	11.1	12.7
Max Depth			0.3	0.3	0.5	0.8
W/D			0.8	1.0	1.1	1.5
			27.6	26.9	21.2	16.6

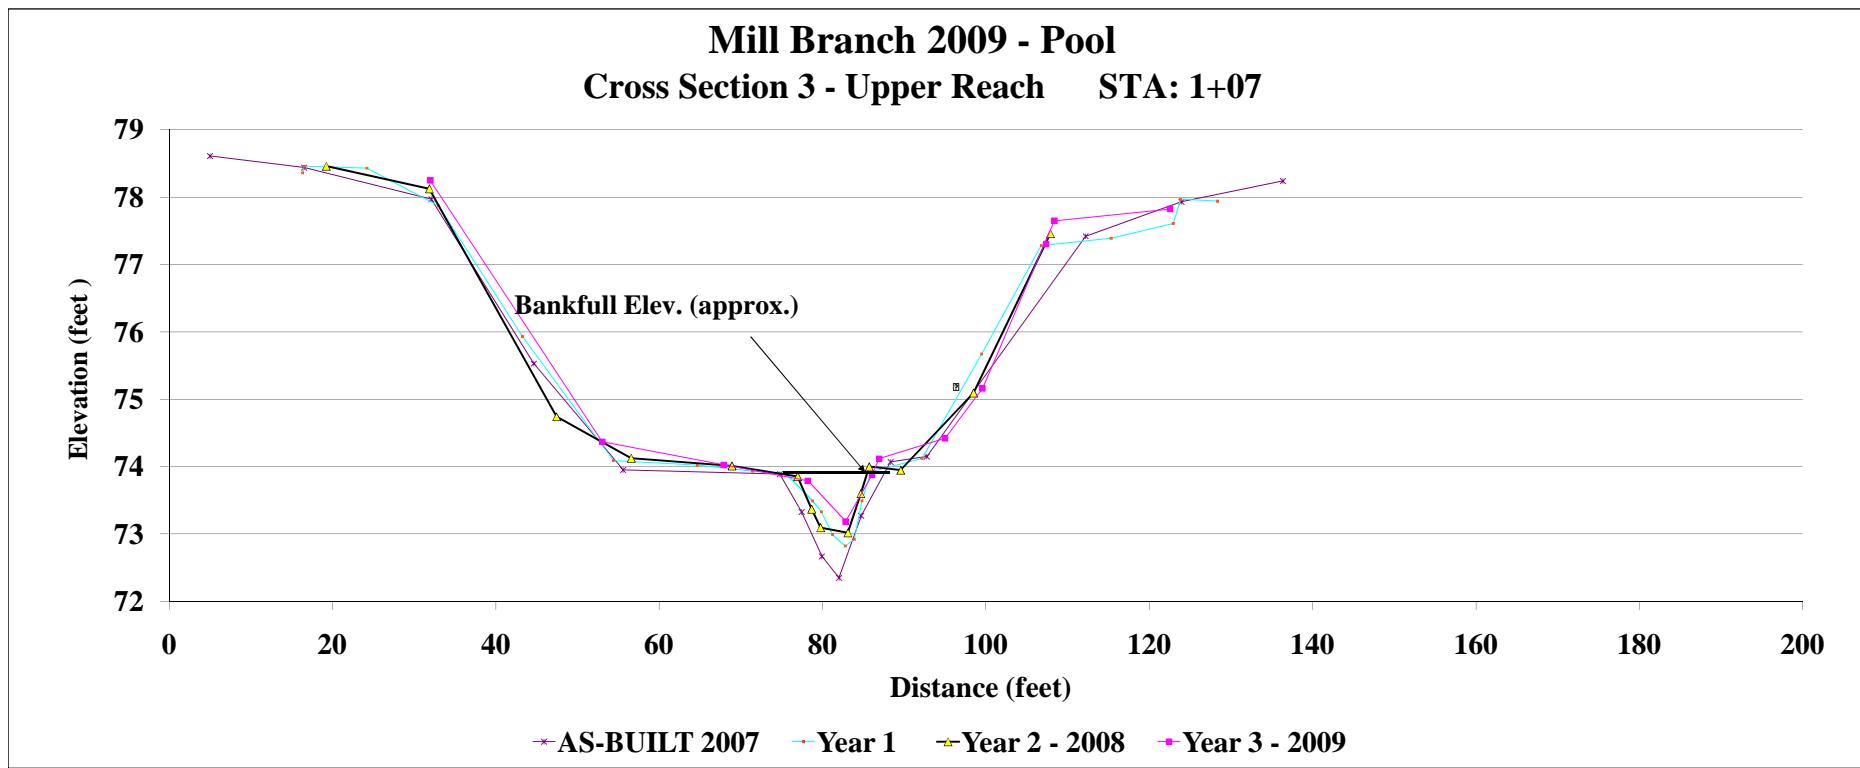

Project Name	Mill Branch
Cross Section	Cross-Section 4 - Upper Reach
Feature	Riffle
Date	Aug-09
Crew	Tutt Stafford
Year 5 - 2011 2011 Survey	Year 4 - 2010 2010 Survey
Station Elevation Notes	Station Elevation Notes


Year 3 - 2009 2009 Survey			Year 2 - 2008 2008 Survey			Year 1 2007 Survey			AS-BUILT 2007 AS-BUILT Survey		
Station	Elevation	Notes	Station	Elevation	Notes	Station	Elevation	Notes	Station	Elevation	Notes
21	77.6216		20.00	77.53		15.71	77.26		8.63	77.21	
34.31	77.2356		34.38	77.49		15.74	77.25		18.00	77.43	LPIN
49.14	74.4418		45.71	74.73		17.97	77.34		33.76	77.15	
54.39	74.0989		52.87	73.55		20.51	77.16		43.99	75.20	
58.22	74.0938		57.74	73.85		27.45	77.25		52.83	73.92	
60.25	73.6464		58.36	73.65		34.71	77.05		58.36	73.97	LBKF
62.34	73.3414		59.89	73.17		43.48	75.29		61.09	73.58	
63.73	73.8989		61.62	72.61		51.28	74.02		61.89	73.26	
64.36	74.0738		64.14	73.33		55.19	73.97		62.82	73.23	
69.53	74.1309		66.74	73.78		59.44	73.85		64.17	73.39	
88.85	74.0824		67.52	73.92		60.02	73.63		66.74	74.03	RBKF
94.5	74.8464		72.80	73.92		61.39	73.46		80.08	73.87	
107.4	77.3		91.46	74.06		62.01	73.21		91.55	74.01	
118.5	77.2		106.47	77.15		62.76	73.04		105.64	76.96	
			118.51	77.19		64.31	73.33		119.34	77.34	RPIN
						65.45	73.77		137.60	77.95	
						67.1	73.98				
						68.7	74.11				
						71.52	73.96				
						79.67	73.93				
						90.3	74.0				
						97.1	75.30				
						104.9	76.9				
						111.2	77.1				
						119.5	77.4				
						120.4	77.3				



Photo of Cross-Section 1 - Looking Downstream @ STA 1+53

Area	Year 5 - 2011	Year 4 - 2010	Year 3 - 2009	Year 2 - 2008	Year 1	AS-BUILT 2007
Width			1.7	2.4	3.7	3.2
Mean Depth			6.7	8.5	8.4	8.1
Max Depth			0.3	0.3	0.4	0.4
W/D			0.8	1.3	0.9	0.7
			26.8	30.6	18.9	20.6

### Mill Branch 2009 - Riffle Cross Section 4 - Upper Reach STA: 1+53

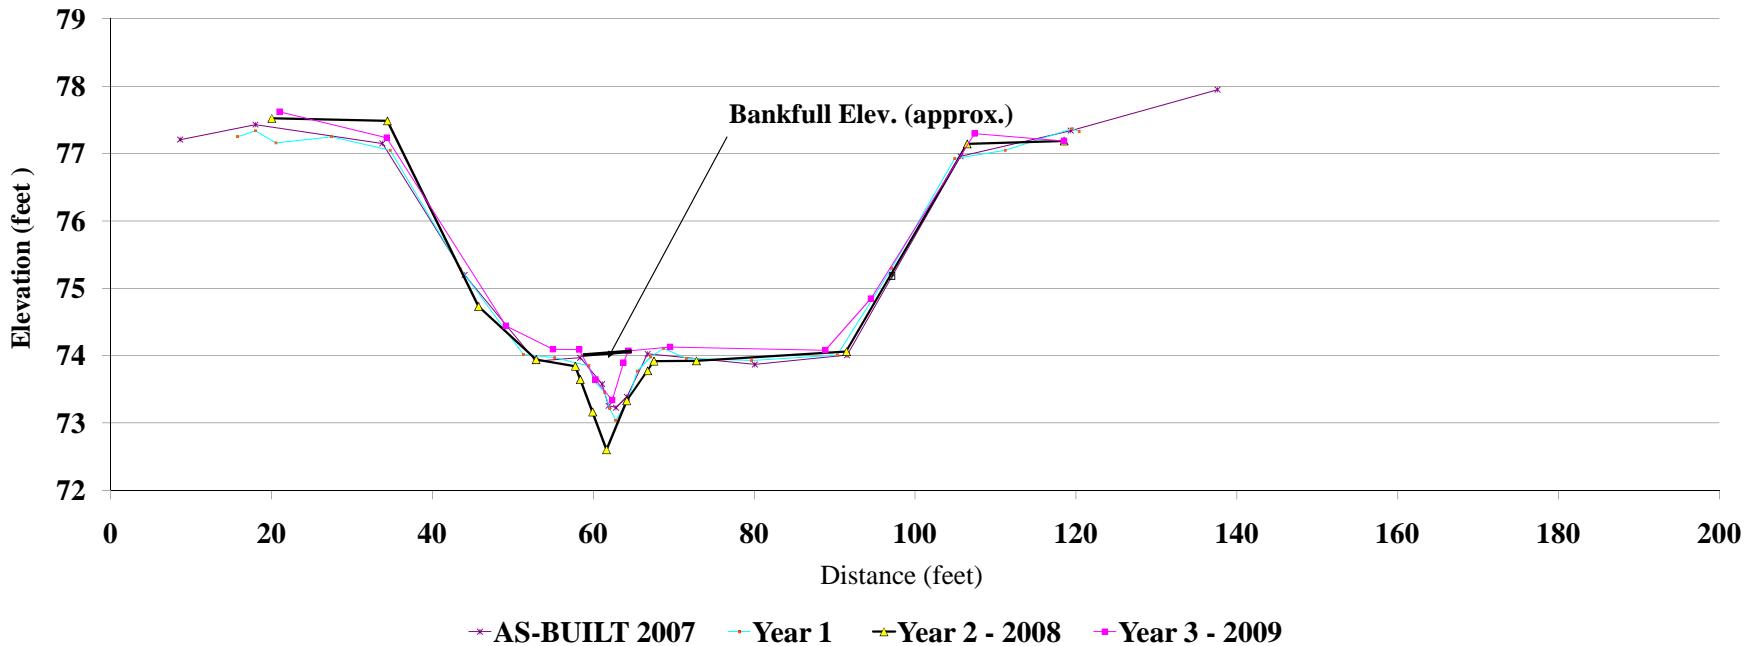


Project Name	Mill Branch
Cross Section	Cross-Section 5 - Middle Reach
Feature	Riffle
Date	Aug-09
Crew	Tutt, Stafford
Year 5 - 2011 2011 Survey	Year 4 - 2010 2010 Survey
Station	Station
Elevation	Elevation
Notes	Notes

Year 3 - 2009 2009 Survey			Year 2 - 2008 2008 Survey			Year 1 2007 Survey			AS-BUILT 2007 AS-BUILT Survey		
Station	Elevation	Notes	Station	Elevation	Notes	Station	Elevation	Notes	Station	Elevation	Notes
31	72.473		29.70	72.52		26.63	72.99		7.0	75.2	
43.4	70.2199		31.08	72.52		30.9	72.68		13.1	75.0	
69.2	69.919		42.94	70.39		34.38	71.95		19.3	74.0	
71.15	69.741		60	70.01		41.58	70.4		25.8	73.2	
72.6	69.5243		70.22	69.88		48.12	70.07		29.7	72.6	
74.01	69.352		71.95	69.54		59.86	69.99		30.9	72.7	LPIN
75.51	68.8994		72.63	69.25		68.98	69.89		37.0	71.4	
76.19	68.9999		73.55	69.10		70.44	69.7		44.2	70.1	
76.61	69.3021		74.69	68.91		72.13	69.1		52.9	70.1	
80.02	69.9571		76.15	69.59		73.93	68.8		61.1	70.0	
85.32	69.9822		76.65	69.30		75.27	69.02		66.9	70.0	
104.81	69.8731		77.27	69.42		76.9	69.68		69.0	70.0	LBKF
114.0	70.1		78.72	69.78		79.08	69.97		69.7	69.6	
118.9	70.1		81.18	69.96		82.45	70.06		70.9	69.4	
122.6	71.2		88.29	70.00		88.6	69.88		71.6	69.1	
131.7	72.8		115.81	70.14		99.81	69.77		71.8	69.1	
145.8	74.0		119	70.25		110.3	69.83		72.6	68.9	
			123.58	71.15		117.95	70.05		73.0	68.9	
			132.88	72.95		125.31	70.42		73.4	68.9	
			146.38	73.85		131.5	71.48		74.3	68.9	
						136.29	72.85		74.8	69.1	
						142.21	73.56		75.4	69.3	
						147.31	73.69		76.1	69.5	
						152.59	73.56		76.7	69.7	
						153.1	73.76		78.5	69.9	RBKF
									81.3	69.9	
									84.0	69.9	
									92.6	69.8	
									103.3	69.8	
									115.1	70.1	
									124.6	71.0	
									133.9	72.8	
									145.4	73.7	
									152.6	73.8	RPIN
									161.7	73.6	



Photo of Cross-Section 5 - Looking Downstream @ STA 0+94

Area	Year 5 - 2011	Year 4 - 2010	Year 3 - 2009	Year 2 - 2008	Year 1	AS-BUILT 2007
Width			4.0	3.9	5.1	5.2
Mean Depth			15.8	8.6	9.7	9.5
Max Depth			0.3	0.5	0.5	0.6
W/D			1.0	1.0	1.0	1.0
			61.9	19.0	18.8	17.2

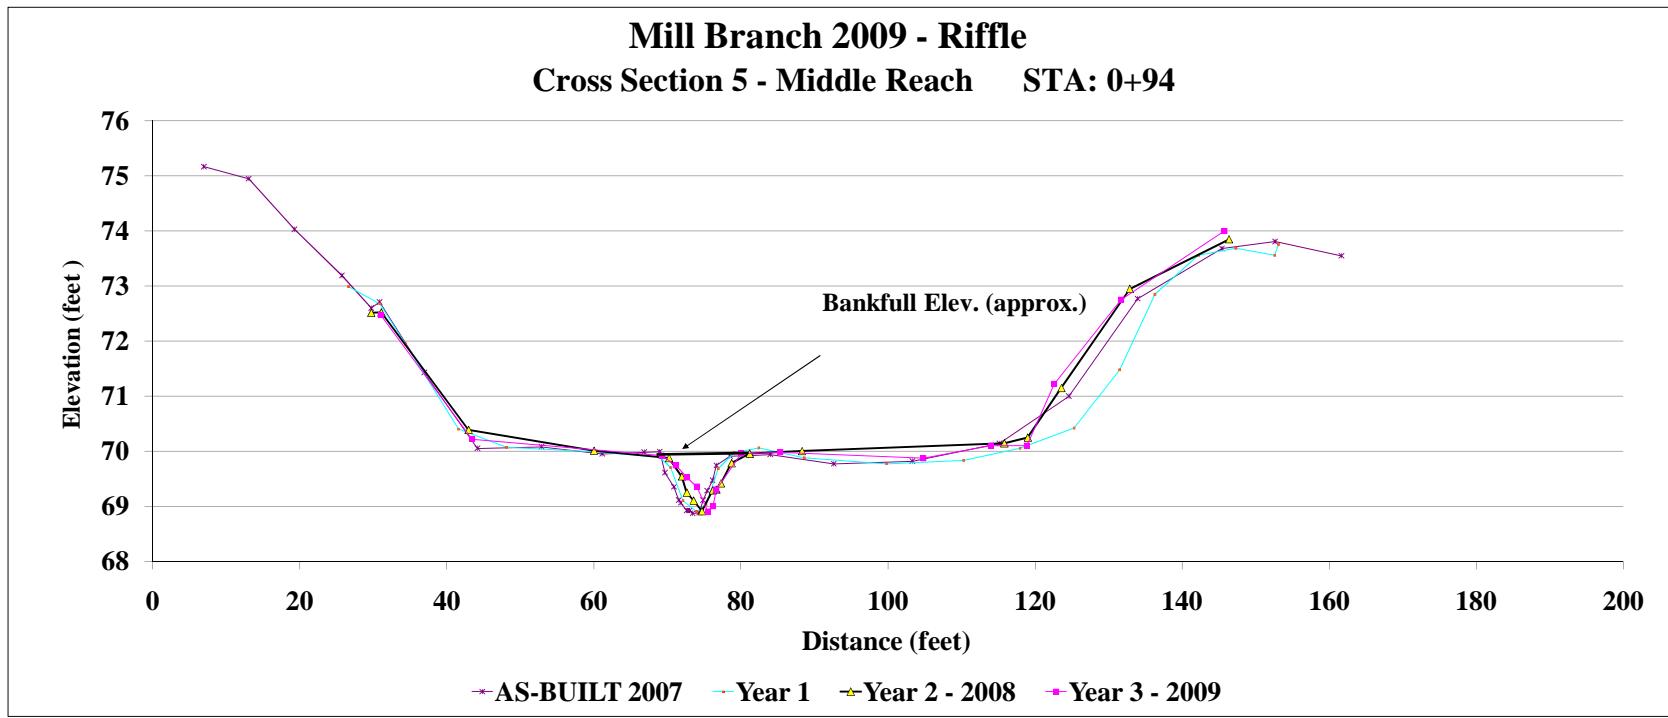


Project Name	Mill Branch
Cross Section	Cross-Section 6 - Middle Reach
Feature	Pool
Date	Aug-09
Crew	Tutt, Stafford
Year 5 - 2011 2011 Survey	Year 4 - 2010 2010 Survey
Station	Station
Elevation	Elevation
Notes	Notes

Year 3 - 2009 2009 Survey			Year 2 - 2008 2008 Survey			Year 1 2007 Survey			AS-BUILT 2007 AS-BUILT Survey		
Station	Elevation	Notes	Station	Elevation	Notes	Station	Elevation	Notes	Station	Elevation	Notes
10	73.119		9.90	73.21		7.23	74.17		7.1	74.24	
23.38	70.0153		11.37	73.25		10.15	73.44		9.9	73.52	LPIN
28.16	69.6893		22.34	70.93		12.22	73.02		15.8	72.07	
30.61	69.5584		23.60	70.17		19.78	71.05		22.7	70.38	
32.38	67.7646		29.84	69.84		24.65	70.05		27.3	69.84	
38.1	68.8541		30.42	69.59		30.36	69.77		29.4	70.01	LBKF
40.14	69.0907		32.19	67.85		31.75	68.63		30.2	69.63	
42.75	69.7453		33.39	67.66		33.25	67.99		31.3	69.13	
45.63	70.1485		39.12	68.72		34.99	67.92		31.8	68.63	
68.55	69.6246		40.12	69.04		35.82	67.85		32.6	68.01	
80.09	69.7603		43.68	69.85		37.55	68.39		33.4	67.78	
87.65	70.983		46.44	70.14		38.81	69.02		34.2	67.67	
98.7	73.1		48.24	70.45		42.08	69.66		35.1	67.78	
102.3	73.1		79.56	70.01		44.99	70.3		35.7	68.13	
			88.20	71.60		49.3	70.36		36.4	68.31	
			93.65	72.80		58.47	70.07		37.4	68.70	
			101.50	73.20		70.35	69.79		38.2	68.78	
						79.29	69.78		39.0	69.29	
						85.54	70.71		40.2	69.45	
						91.02	71.81		41.5	69.80	
						95.76	72.58		43.1	69.94	
						102.06	73.17		44.1	70.32	
						102.23	73.01		47.5	70.32	
									62.1	69.91	
									79.9	70.13	
									89.2	71.57	
									95.7	72.82	
									101.5	73.16	
									102.5	73.10	
									106.9	73.14	
									116.0	73.15	



Photo of Cross-Section 6 - Looking Downstream @ STA 2+06

Area	Year 5 - 2011	Year 4 - 2010	Year 3 - 2009	Year 2 - 2008	Year 1	AS-BUILT 2007
Width			11.0	14.8	16.6	15.5
Mean Depth			20.6	19.0	14.2	13.7
Max Depth			0.5	0.8	1.2	1.1
W/D			2.2	2.5	2.2	2.3
			38.6	24.4	12.2	12.1

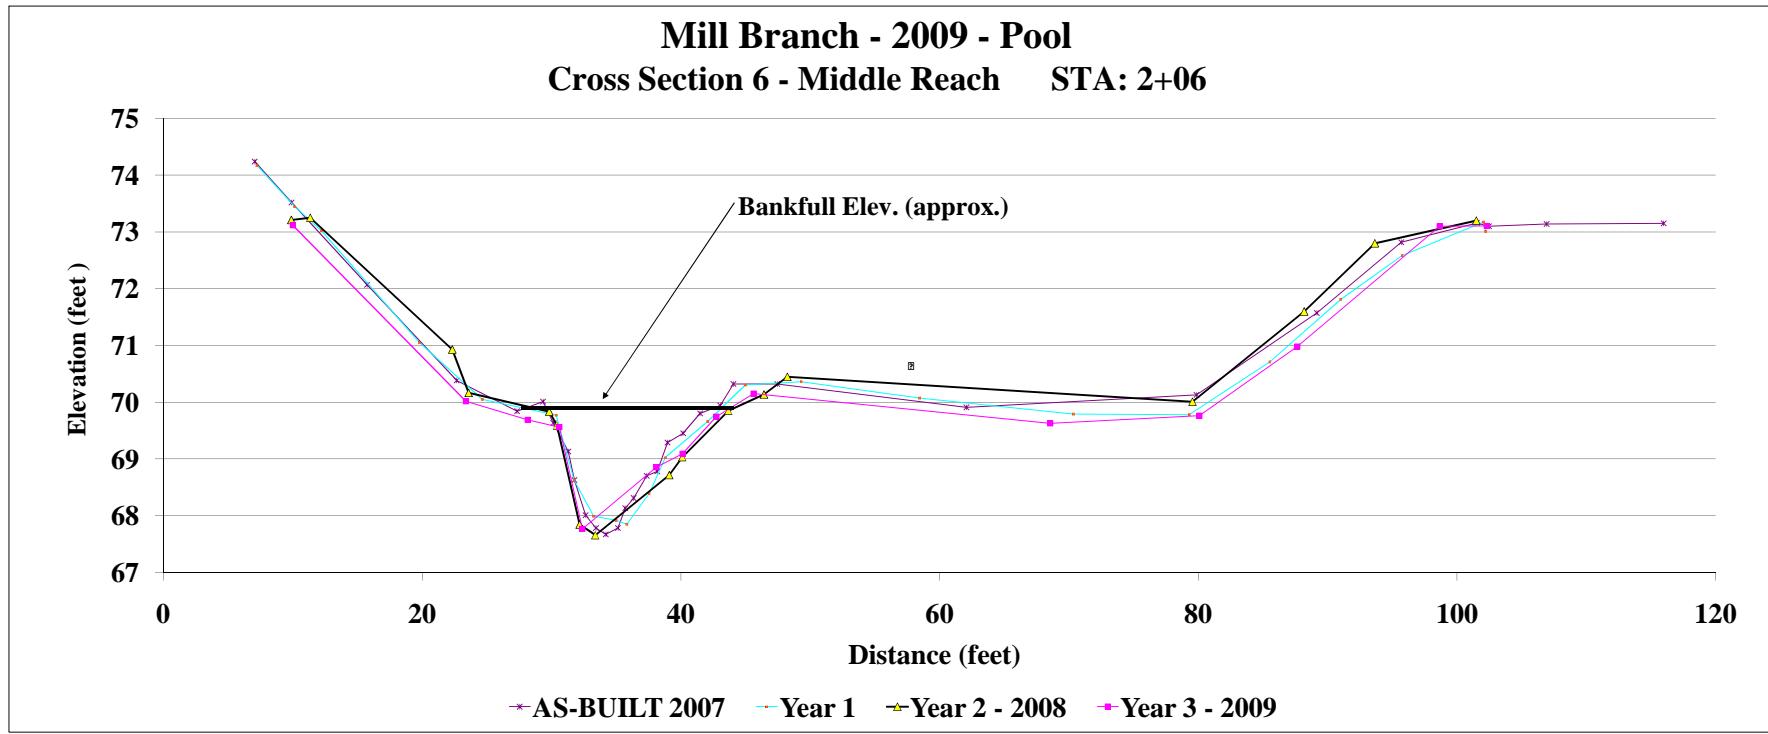


Project Name	Mill Branch
Cross Section	Cross-Section 7 - Lower Reach
Feature	Riffle
Date	Aug-09
Crew	Tun, Stafford
Year 5 - 2011 2011 Survey	Year 4 - 2010 2010 Survey
Station	Station
Elevation	Elevation
Notes	Notes

Year 3 - 2009 2009 Survey			Year 2 - 2008 2008 Survey			Year 1 2007 Survey			AS-BUILT 2007 AS-BUILT Survey		
Station	Elevation	Notes	Station	Elevation	Notes	Station	Elevation	Notes	Station	Elevation	Notes
36.40	66.85		38.40	66.85		28.01	67.23		15.7	67.5	
52.22	64.08		49.36	66.21		31.77	67.31		31.2	67.4	LPIN
86.33	65.01		72.83	64.91		37.21	66.93		37.28	65.72	
88.89	64.5312		83.97	64.95		43.28	65.93		48.8	65.3	
90.72	64.287		87.54	65.08		50.94	65.1		57.6	64.8	
92.28	64.066		88.83	64.51		59.6	64.88		64.9	64.9	
93.34	63.932		91.22	64.51		66.87	64.89		72.4	64.9	
94.88	63.0065		91.70	64.06		76.08	64.9		81.7	65.0	
96.84	64.0023		92.57	63.95		84.71	65		86.6	65.0	
98.77	64.2934		94.80	62.93		88.86	64.93		88.7	65.1	
101.17	64.6467		96.06	64.12		90.3	64.45		89.7	64.8	
109.28	64.8596		96.88	64.32		93.6	64.08		91.0	64.4	
120.74	64.9239		97.28	64.51		94.34	63.13		92.9	64.2	LBKF
121.58	65.39		98.90	64.65		95.31	63.18		93.4	64.0	
133.62	67.66		100.16	64.97		96.29	63.24		93.6	63.2	
142.05	68.05		105.74	64.95		97.89	64.41		94.4	63.08	
			118.90	65.13		100.96	64.9		94.5	63.1	
			122.66	65.27		105.06	65		95.1	63.4	
			133.88	67.75		112.02	65.02		95.9	63.4	
			141.91	68.45		121.33	65.14		96.5	63.6	
						125.49	65.94		96.7	63.6	
						131.95	67.02		97.0	63.9	
						137.94	68.29		97.0	64.2	RBKF
						143.52	68.58		98.1	64.4	
						144.78	68.58		101.0	64.9	
									103.7	64.8	
									113.9	65.0	
									121.9	65.1	
									124.0	65.8	
									130.3	66.9	
									136.8	68.1	
									143.0	68.7	
									146.6	68.5	
									154.6	68.8	RPIN



Photo of Cross-Section 7 - Looking Upstream @ STA 0+12

Area	Year 5 - 2011	Year 4 - 2010	Year 3 - 2009	Year 2 - 2008	Year 1	AS-BUILT 2007
Width						
Mean Depth						
Max Depth						
W/D						

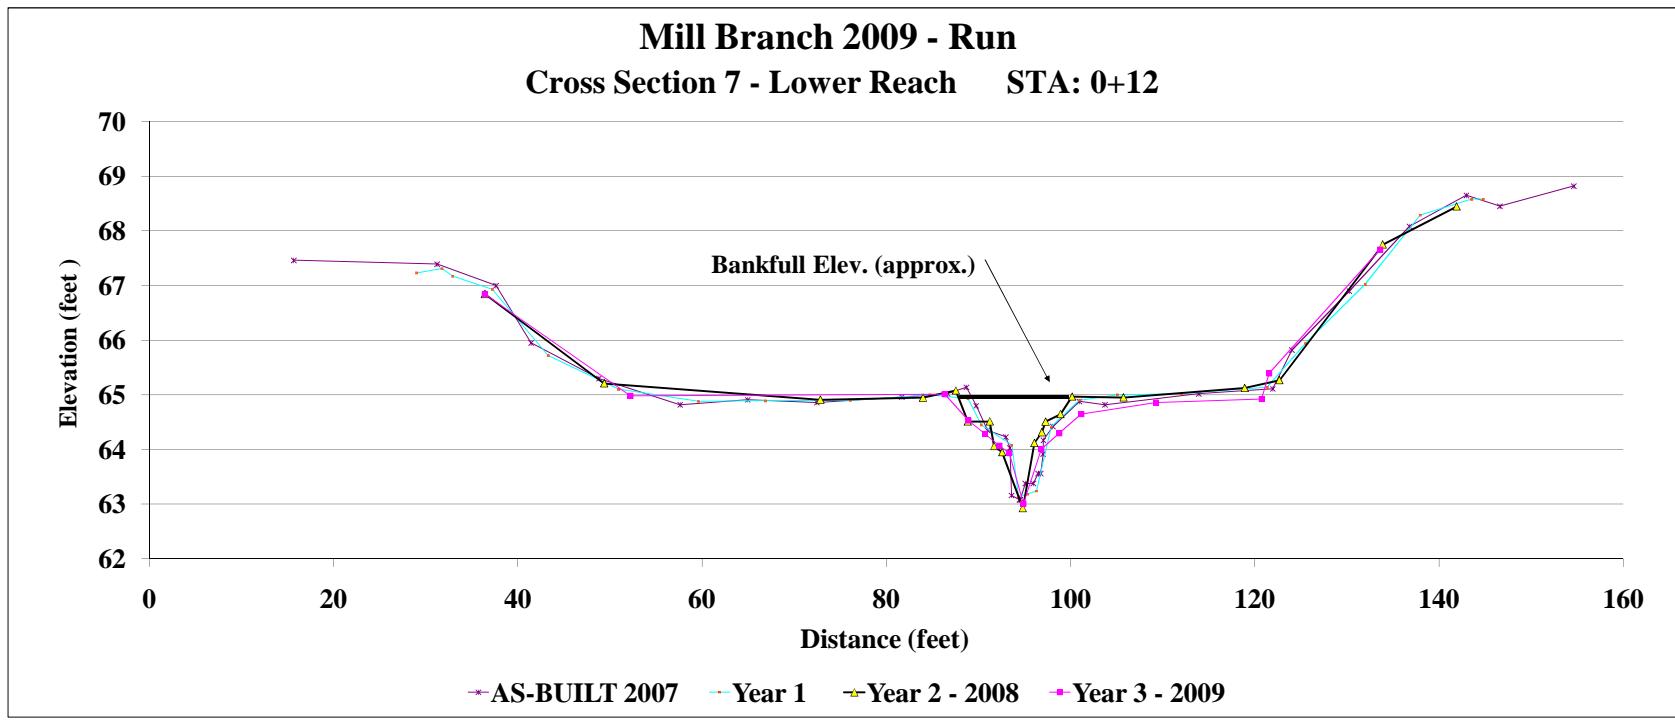


Project Name	Mill Branch
Cross Section	Cross-Section 8 - Lower Reach
Feature	Pool
Date	Aug-09
Crew	Tutt, Stafford
Year 5 - 2011 2011 Survey	Year 4 - 2010 2010 Survey
Station	Station
Elevation	Elevation
Notes	Notes

Year 3 - 2009 2009 Survey			Year 2 - 2008 2008 Survey			Year 1 2007 Survey			AS-BUILT 2007 AS-BUILT Survey		
Station	Elevation	Notes	Station	Elevation	Notes	Station	Elevation	Notes	Station	Elevation	Notes
35	64.8848		22.90	65.79		14.25	65.94		8.7	66.1	
43.87	64.0722		39.58	64.33		20.74	65.64		22.9	66.0	LPIN
52.26	64.3871		49.89	64.26		23.03	65.82		31.1	65.58	
55.28	64.0994		51.26	64.47		29	65.43		41.4	64.3	
56.82	63.4339		53.84	64.47		33.14	65.31		47.7	64.2	
60.1	62.1274		54.93	64.10		38	64.8		51.1	64.5	
62.66	63.6054		55.66	63.89		41.35	64.23		53.3	64.5	
65.51	63.7403		57.08	63.52		46.47	64.25		55.1	64.0	
67.98	64.0635		59.33	61.95		51.39	64.47		56.4	63.5	LBKF
83.44	64.4916		62.79	61.87		54.54	64.25		57.8	63.3	
99.31	65.1068		68.17	64.04		57.52	63.55		58.1	62.8	
101.8	65.9112		71.86	64.15		58.51	62.78		58.3	62.7	
			81.13	64.38		59.77	62.03		58.4	62.6	
			100.46	64.98		61.13	62.17		58.6	62.4	
			104.15	65.91		63	63.17		60.2	62.0	
						64.09	63.53		60.8	62.31	
						64.67	63.93		61.5	62.7	
						67.97	63.98		62.1	63.0	
						72.93	64.16		63.5	63.7	RBKF
						77.92	64.26		64.1	63.9	
						83.14	64.32		65.4	63.7	
						88.51	64.59		68.7	64.0	
						93.85	64.84		71.6	64.2	
						99.97	64.99		73.8	64.2	
						103.26	66.04		79.7	64.3	
						104.2	66.03		86.0	64.6	
						107.95	66.85		92.7	64.8	
									99.8	65.0	
									103.2	66.1	RPIN
									111.1	67.7	




Photo of Cross-Section 8 - Looking Downstream @ STA 1+71


Area Width	Year 5 - 2011	Year 4 - 2010	Year 3 - 2009	Year 2 - 2008	Year 1	AS-BUILT 2007
Mean Depth						
Max Depth					0.5	0.7
W/D					2.3	2.2
					34.0	22.8
					14.5	22.9

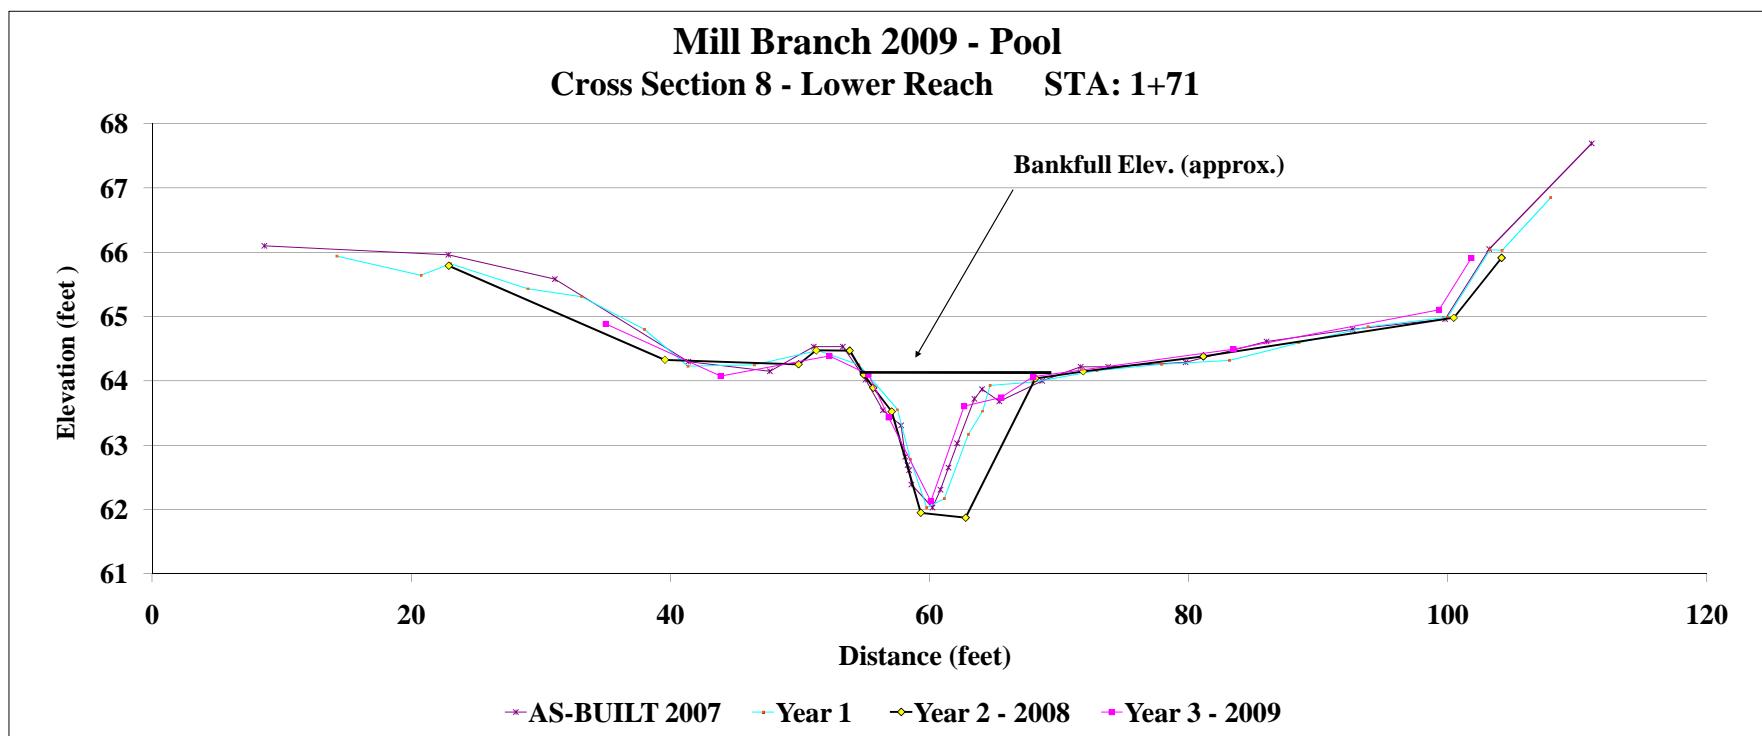


**MILL BRANCH  
LONG PROFILE  
REACH 1 - Western Reach  
STA: 0+00 THRU STA: 3+05  
2009 MONITORING**

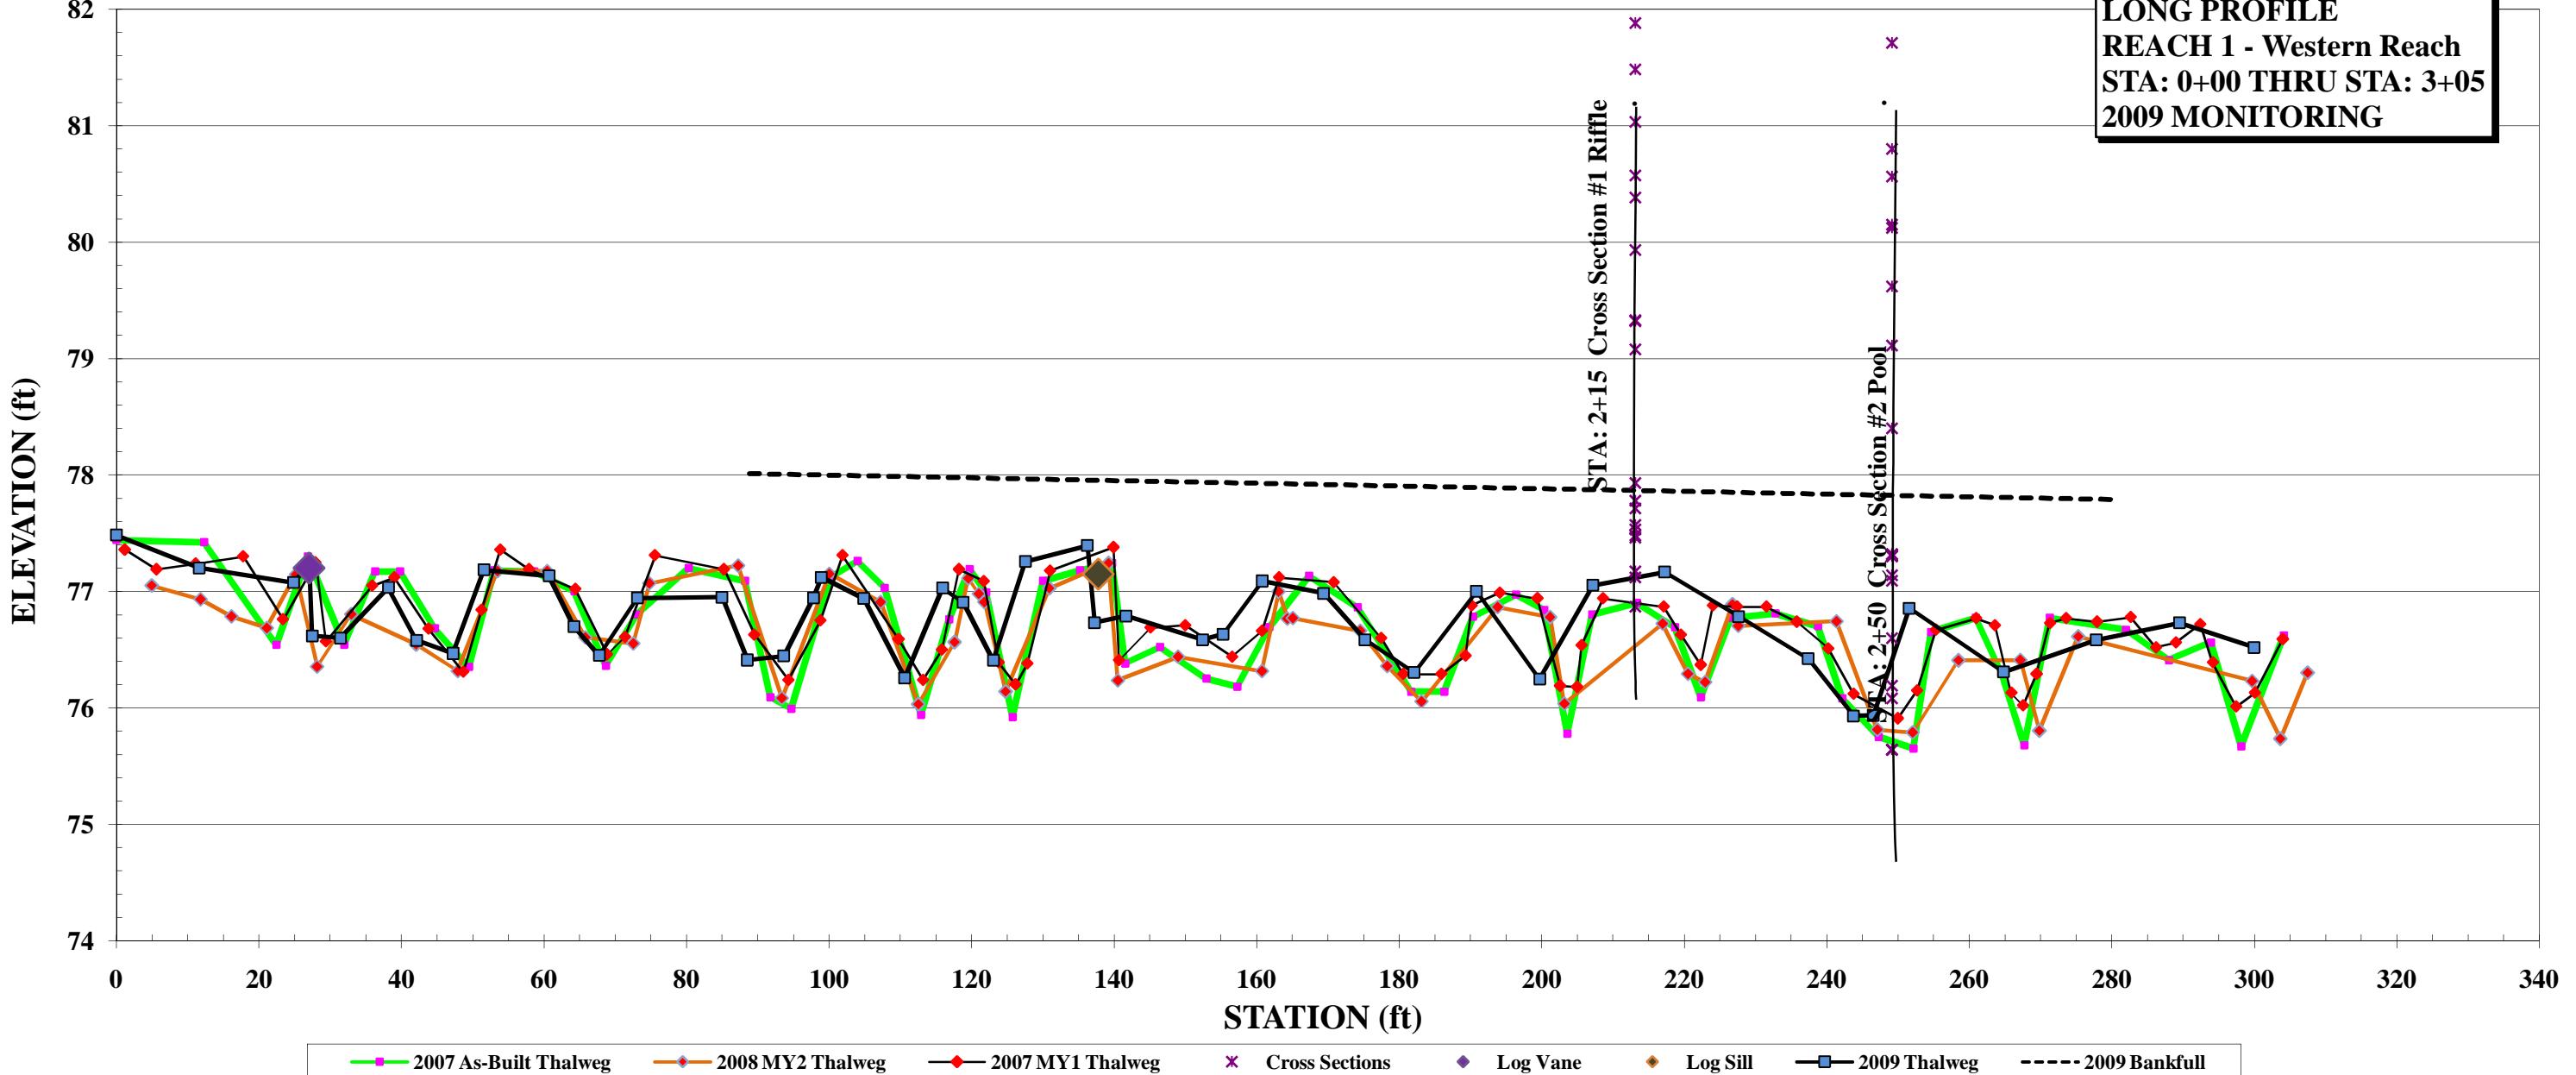


**MILL BRANCH  
LONG PROFILE  
REACH 2 - Upper Reach  
STA: 0+00 THRU STA: 2+90  
2009 MONITORING**

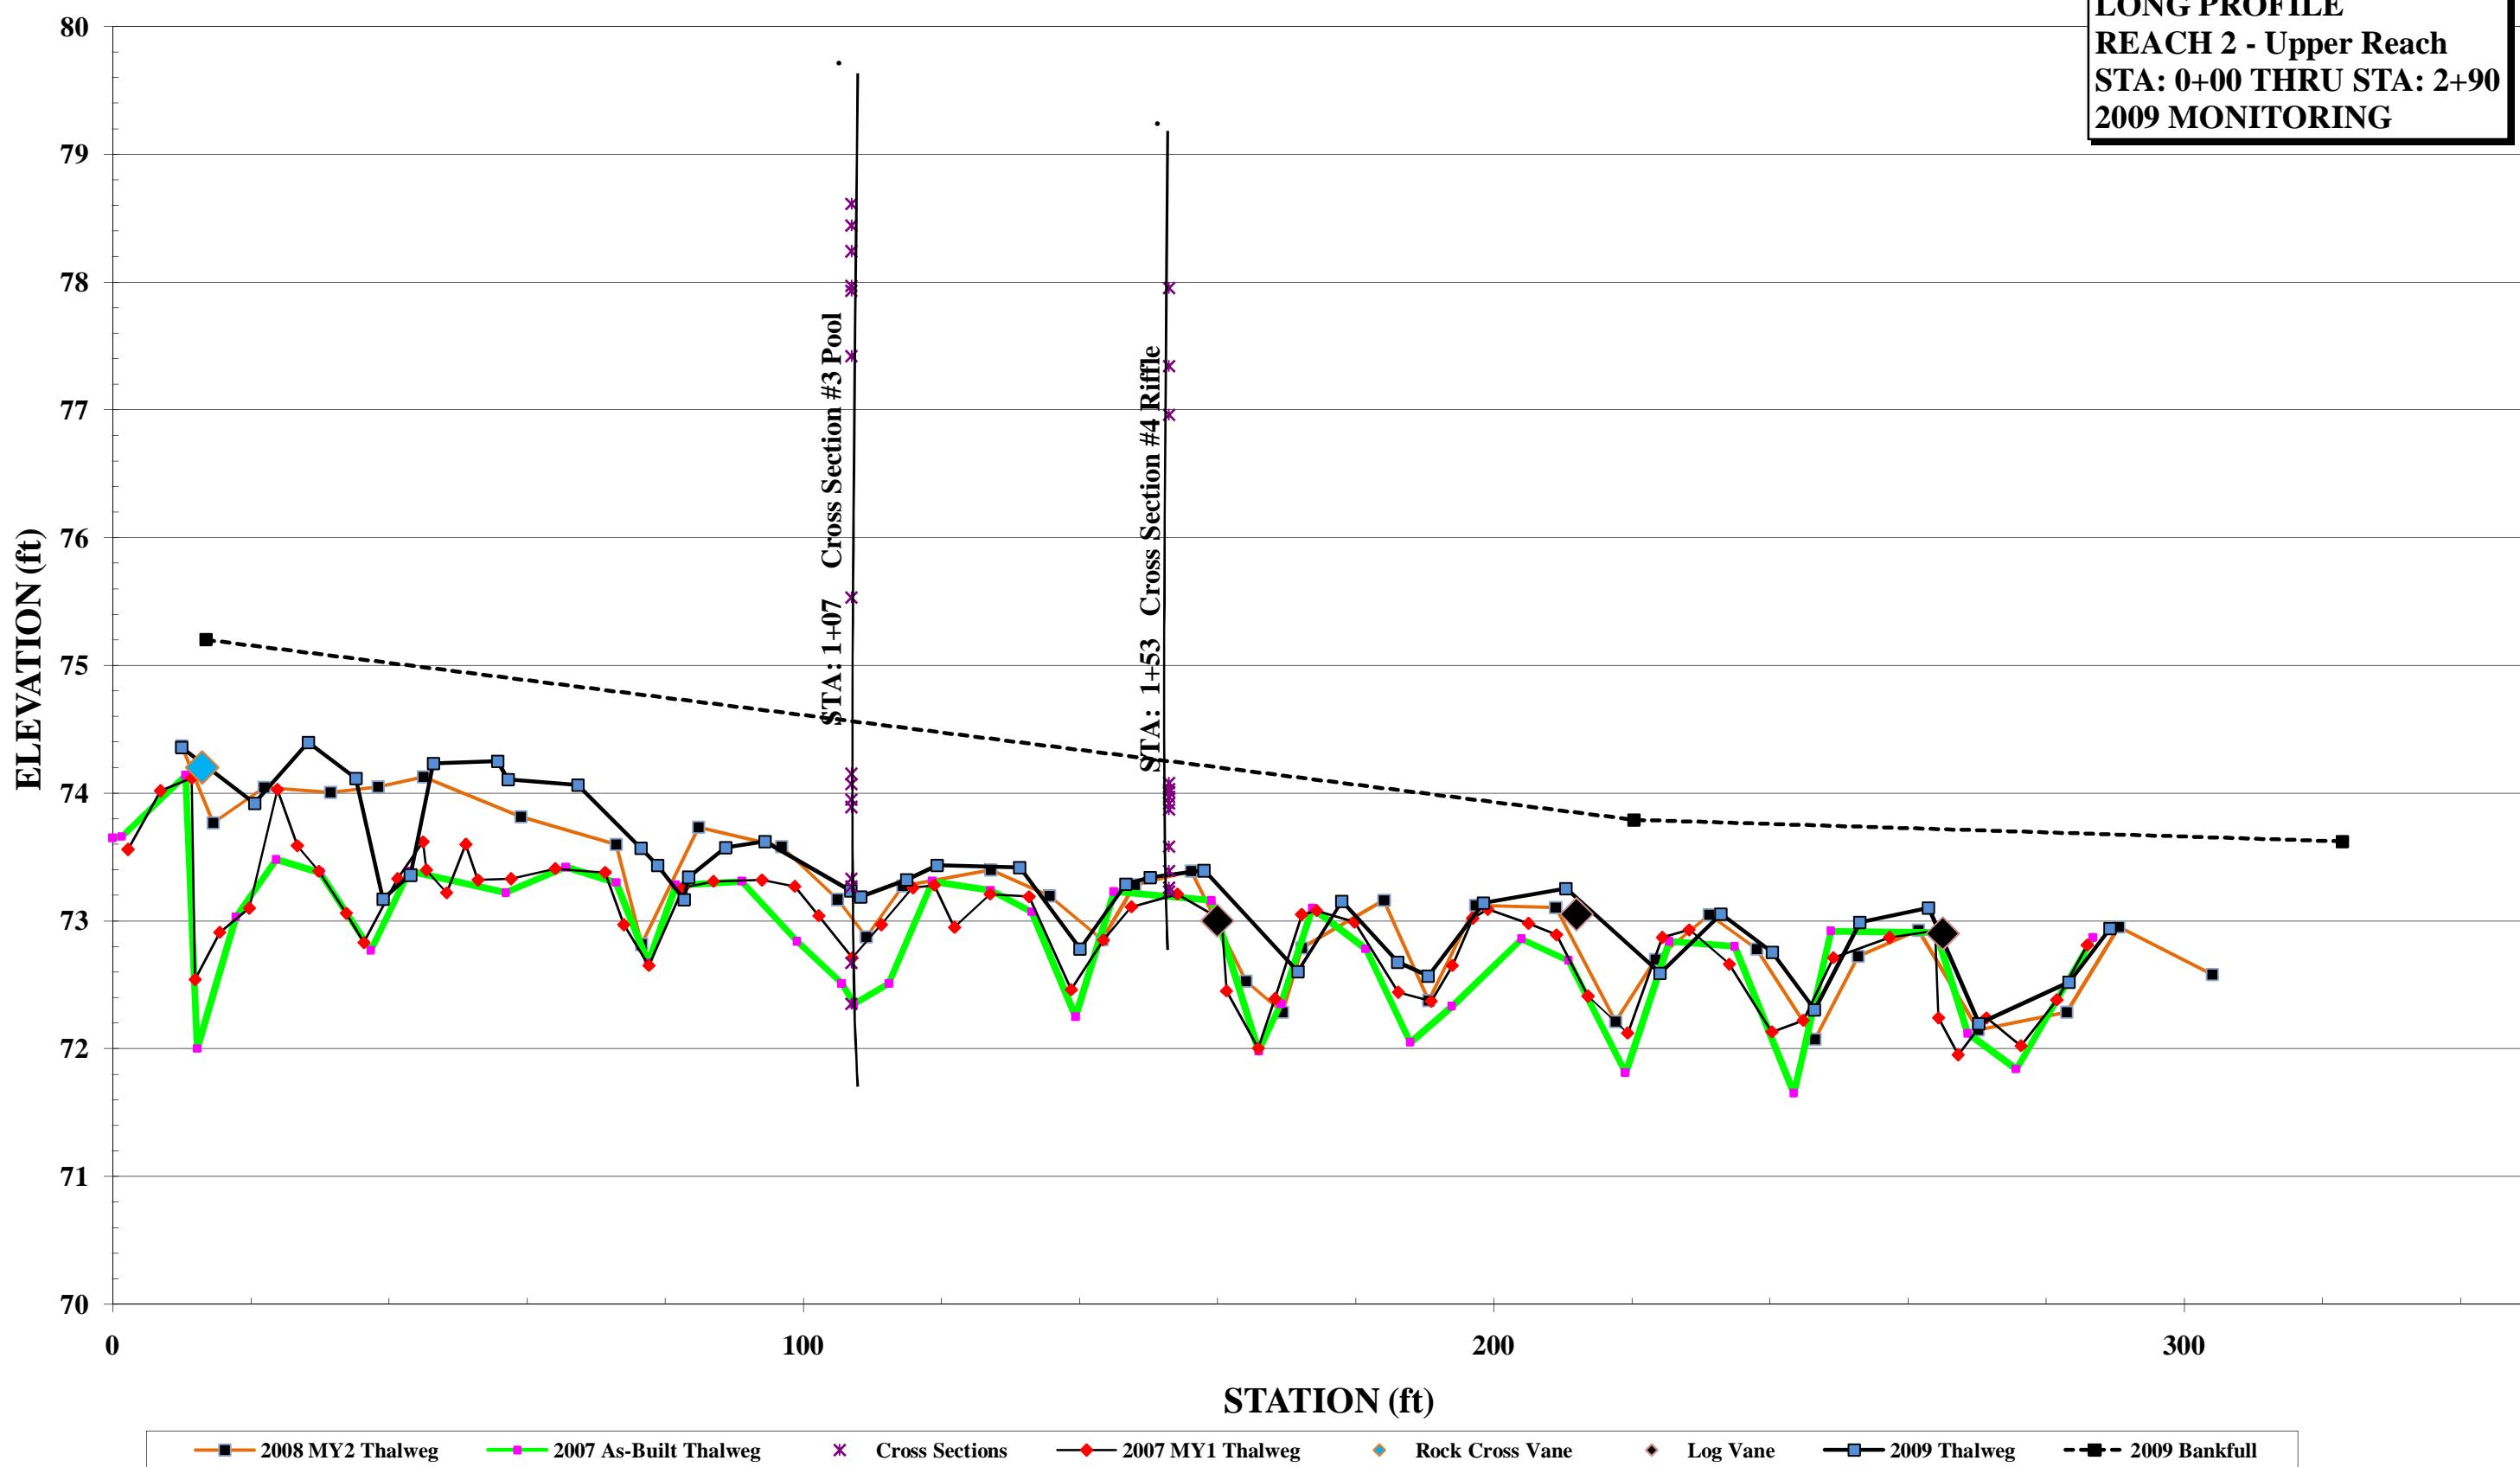

**MILL BRANCH  
LONG PROFILE  
REACH 3 - Middle Reach  
STA: 0+00 THRU STA: 3+00  
2009 MONITORING**

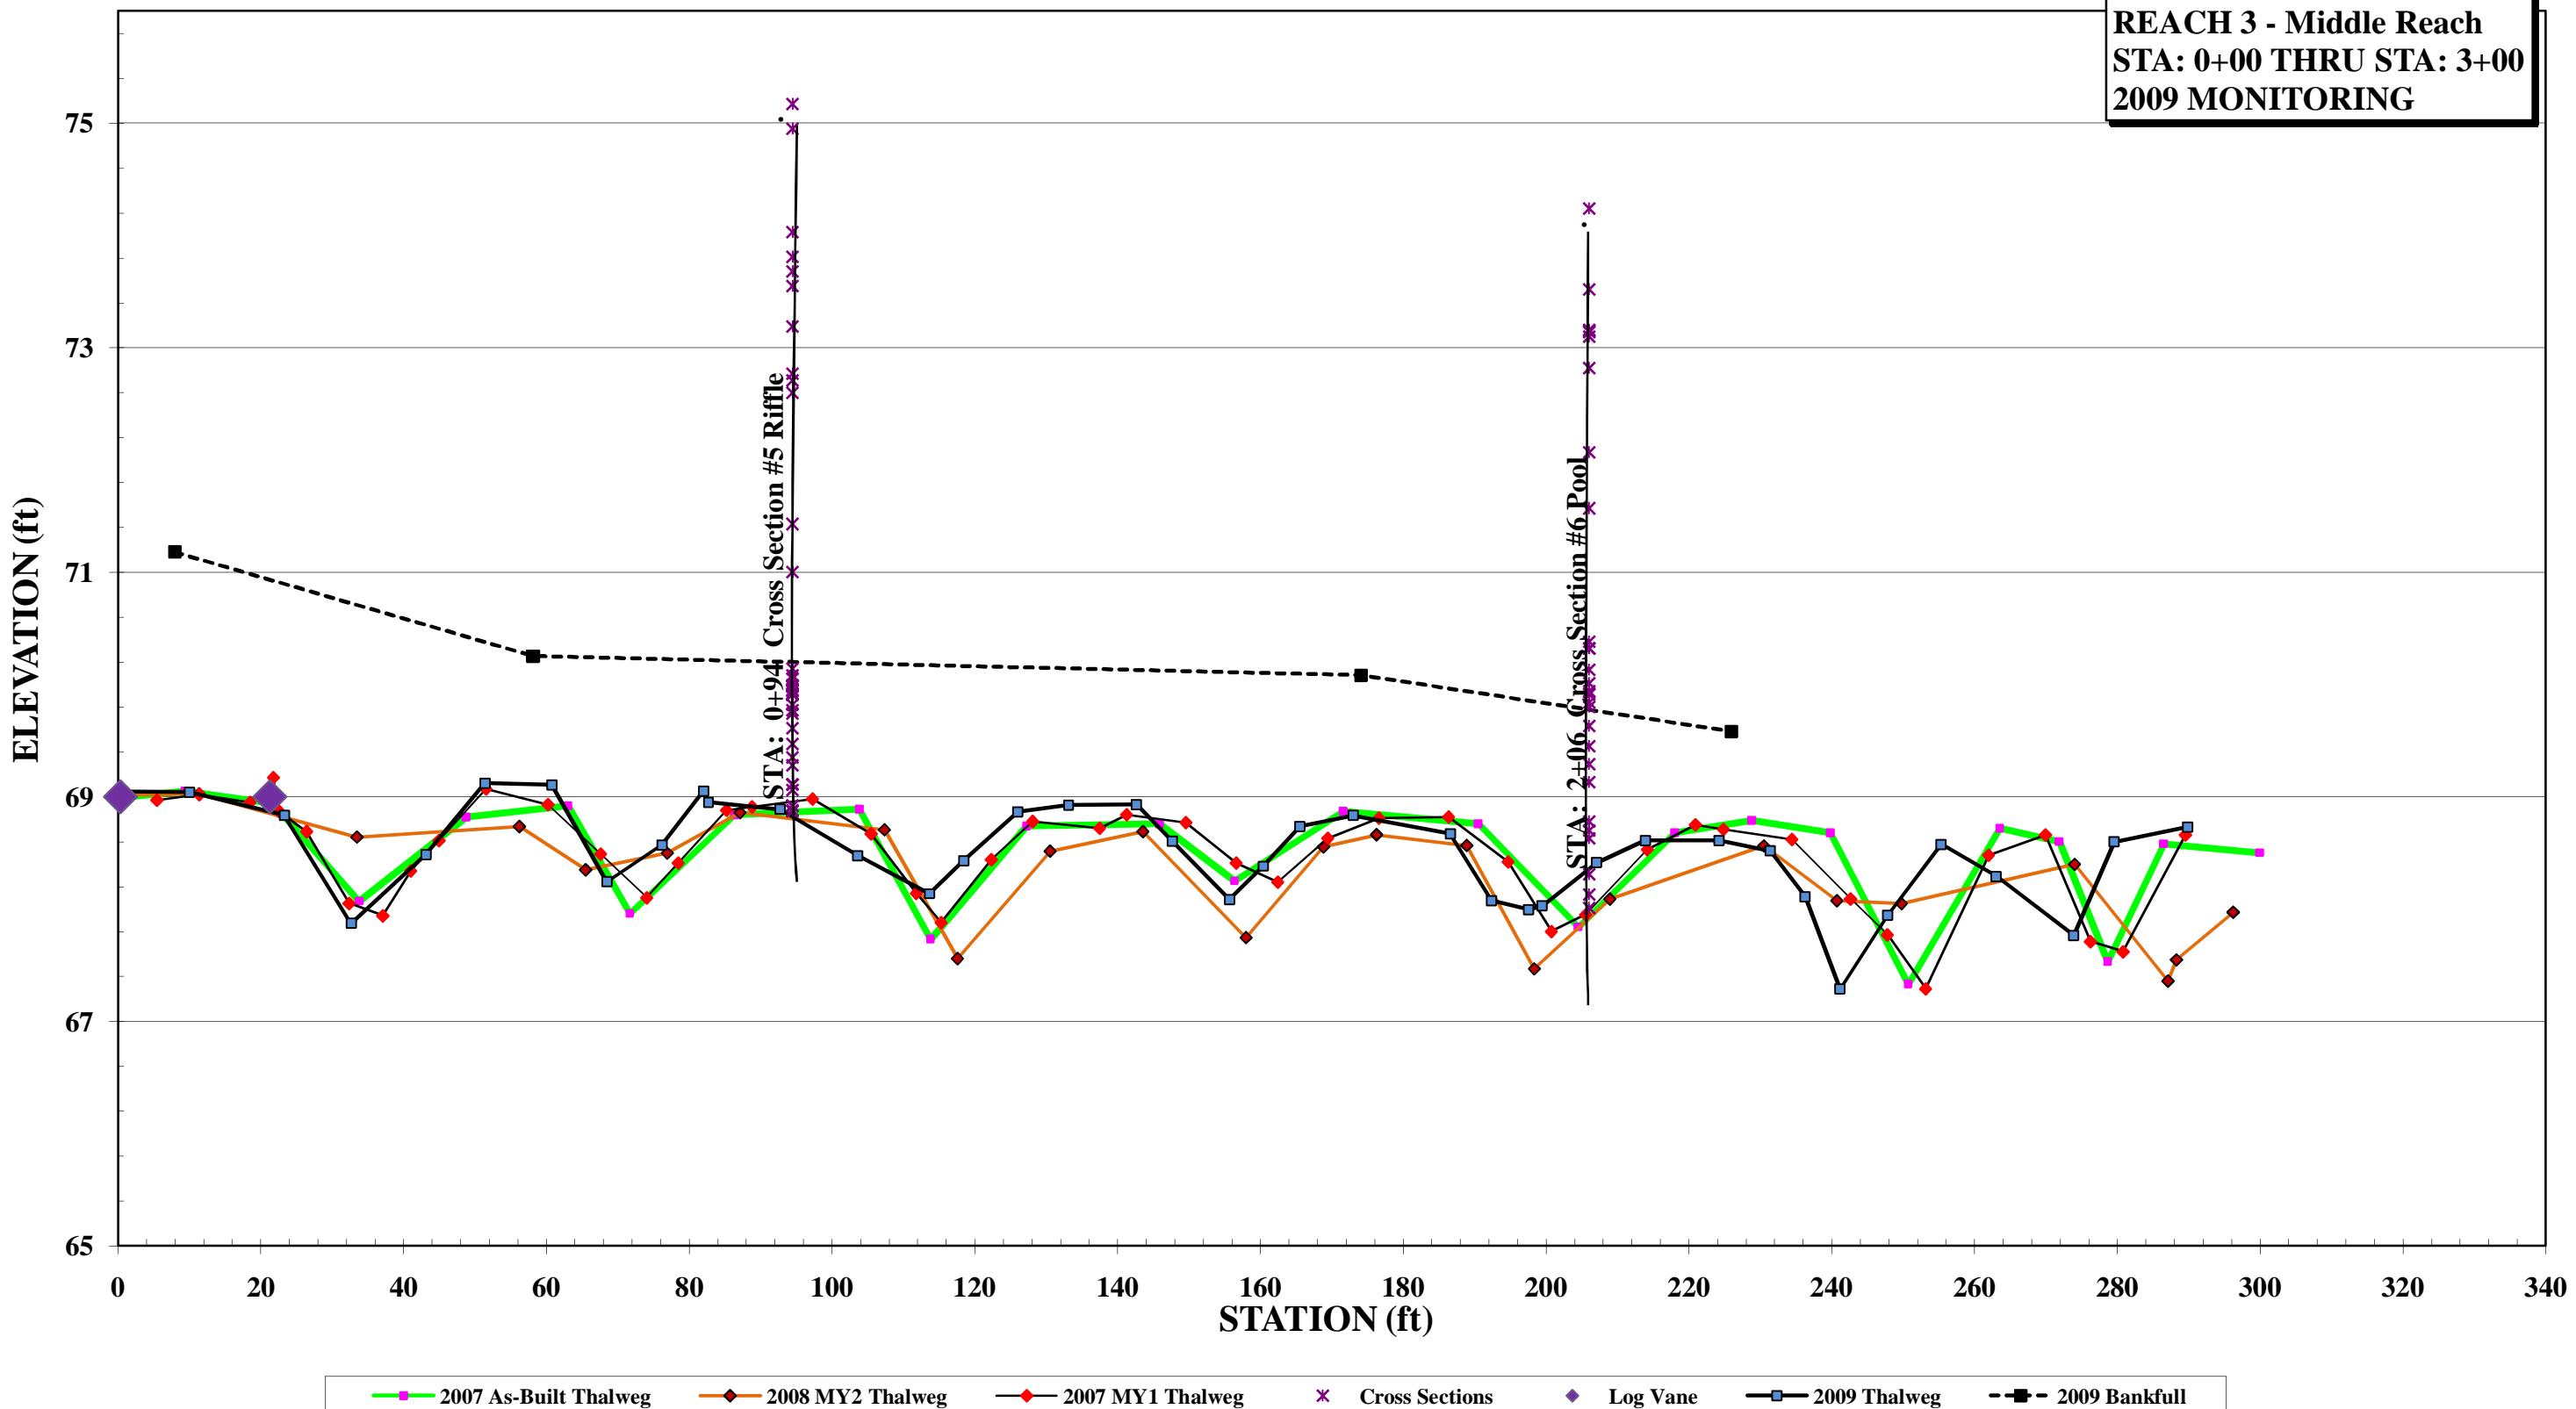

**MILL BRANCH  
LONG PROFILE  
REACH 4 -Lower Reach  
STA: 0+00 THRU STA: 2+45  
2009 MONITORING**

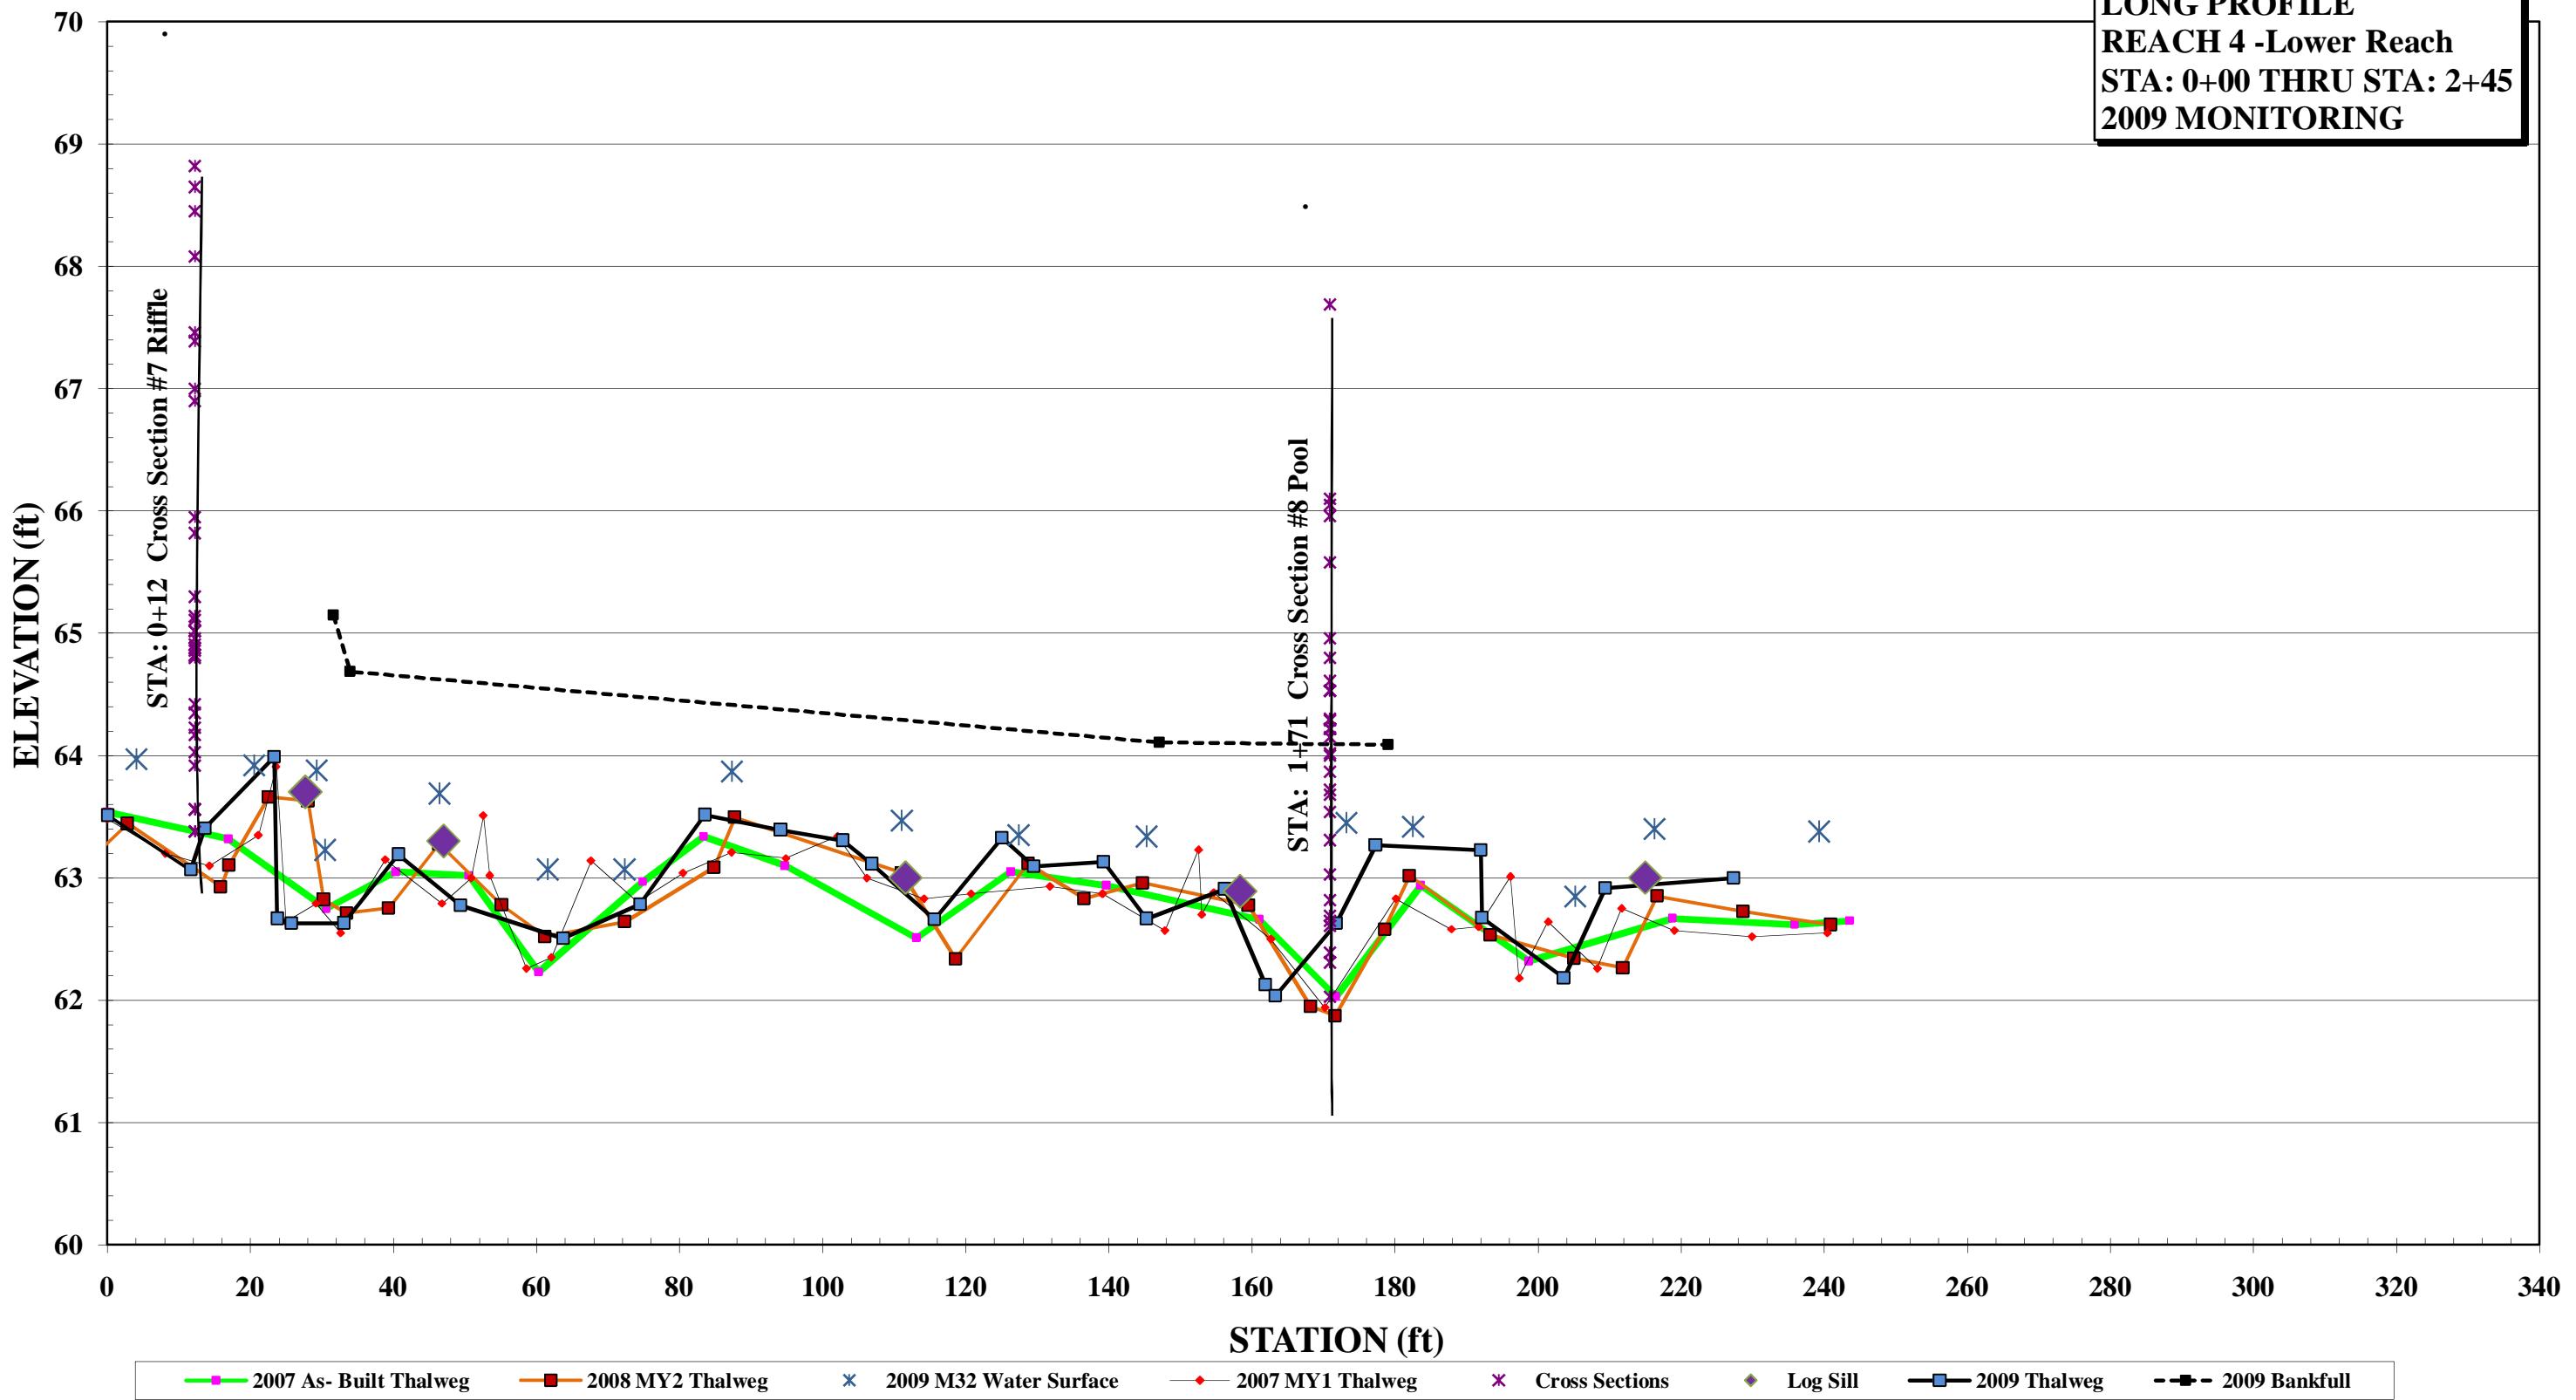

**Morphology and Hydraulic Monitoring Summary**  
**Mill Branch Stream Restoration Site/EEP Project No. 0251**  
**Western Reach**

Parameter	Cross Section 1				Cross Section 2																		
	MY0	MY1	MY2	MY3	MY0	MY1	MY2	MY3															
Dimension	MY0	MY1	MY2	MY3	MY0	MY1	MY2	MY3															
BF Width (ft)	6	8.7	28.1	23.4	11.7	11.2	17.4	23.7															
Floodprone Width (ft) (approx)	45	4.5	47	39.5	52	43	45.6	46															
BF Cross Sectional Area (ft <sup>2</sup> )	1.8	2.3	6.5	4.1	8.7	7.5	8.2	6.7															
BF Mean Depth (ft)	0.3	0.3	0.2	0.2	0.7	0.7	0.5	0.3															
BF Max Depth (ft)	0.6	0.6	1.2	0.6	1.7	1.3	1.4	1.4															
Width/Depth Ratio	33.5	19.80	121.8	133	15.7	16.7	37.1	83.2															
Entrenchment Ratio	7.5	5.2	1.7	1.7	4.4	3.8	2.6	1.9															
Wetted Perimeter (ft)	-	-	28.5	23.6	-	-	17.9	24.1															
Hydraulic radius (ft)	-	-	0.2	0.2	-	-	0.5	0.3															
Substrate																							
d50 (mm)		0.12	0.11	0.18		0.12	0.11	0.18															
d84 (mm)		0.26	0.28	0.67		0.26	0.28	0.67															
Parameter	MY-00 (2007)			MY-01 (2007)			MY-02 (2008)			MY-03 (2009)			MY-04 (2010)			MY-05 (2011)							
Pattern	Min	Max	Med	Min	Max	Med	Min	Max	Med	Min	Max	Med	Min	Max	Med	Min	Max	Med	Min	Max	Med		
Channel Beltwidth (ft)	16	26	20	15	25	19	14	27	20	14	28	21											
Radius of Curvature (ft)	8	15	11.3	7	16	11	7	17	12	7	17	13											
Meander Wavelength (ft)	32	42	36	31	44	37	32	44	38	32	44	38											
Meander Width Ratio	5.37	7.12	6.30	-	-	4.20	-	-	4.8	-	-	4.8											
Profile																							
Riffle Length (ft)	4	10	6	-	-	-																	
Riffle Slope (ft)				-	-	-																	
Pool Length (ft)	8	23	12	-	-	-																	
Pool Spacing (ft)	19	40	27	18	40	25	17	40	18	17	40	18											
Additional Reach Parameters																							
Valley Length (ft)																							
Channel Length (ft)	304																						
Sinosity	1.20																						
Water Surface Slope (ft/ft)																							
BF Slope (ft/ft)																							
Rosgen Classification	C5																						
*Habitat Index																							
*Macrobenthos																							

**Exhibit Table IXB. Morphology and Hydraulic Monitoring Summary**  
**Mill Branch Stream Restoration Site/EEP Project No. 0251**  
**Upper Reach**

Parameter	Cross Section 3				Cross Section 4															
Dimension	MY0	MY1	MY2	MY3	MY0	MY1	MY2	MY3												
BF Width (ft)	12.7	11.1	7.3	8.4	8.10	8.40	4.5	6.7												
Floodprone Width (ft) (approx)	57	48	23.1	24.8	47	45	23.8	14.1												
BF Cross Sectional Area (ft <sup>2</sup> )	9.8	5.8	2.0	2.6	3.2	8.7	3.7	2.2	1.7											
BF Mean Depth (ft)	0.8	0.5	0.3	0.3	0.4	0.4	0.5	0.3												
BF Max Depth (ft)	1.50	1.10	1.0	0.8	0.7	0.9	1.3	0.8												
Width/Depth Ratio	16.6	21.2	26.9	27.6	20.3	18.9	9.0	26.8												
Entrenchment Ratio	4.5	4.30	6.2	2.9	5.8	5.4	5.3	2.1												
Wetted Perimeter (ft)	-	-	8.2	8.7	-	-	5.5	7.1												
Hydraulic radius (ft)	-	-	0.2	0.3	-	-	0.4	0.2												
Substrate																				
d50 (mm)		0.10	0.07			0.10	0.07	.086												
d84 (mm)		0.23	0.26			0.23	0.062	.2												
Parameter	<b>MY-00 (2007)</b>			<b>MY-01 (2007)</b>			<b>MY-02 (2008)</b>			<b>MY-03 (2009)</b>			<b>MY-04 (2010)</b>			<b>MY-05 (2011)</b>				
Pattern	Min	Max	Med	Min	Max	Med	Min	Max	Med	Min	Max	Med	Min	Max	Med	Min	Max	Med	Min	Max
Channel Beltwidth (ft)	23	29	26	22	28	26	21	27	25	20	27	24								
Radius of Curvature (ft)	11	18	14	11	19	13	11	18	13	11	18	14								
Meander Wavelength (ft)	39	59	46	40	59	45	38	59	45	38	59	45								
Meander Width Ratio	2.94	3.72	3	-	-	5.38	-	-	4.9	-	-	4.9								
Profile																				
Riffle Length (ft)	5	14	9	-	-	-	-	-	-	-	-	-								
Riffle Slope (ft)	0.001	0.013	0.005	-	-	-	-	-	-	-	-	-								
Pool Length (ft)	5	21	13	-	-	-	-	-	-	-	-	-								
Pool Spacing (ft)	23	40	29	22	38	31	20	28	30	20	28	30								
Additional Reach Parameters																				
Valley Length (ft)	233			233																
Channel Length (ft)	286			286																
Sinuosity	1.23			1.23																
Water Surface Slope (ft/ft)	0.00260			n/a																
BF Slope (ft/ft)	0.0027			0.0033																
Rosgen Classification	C5			C5																
*Habitat Index																				
*Macrobenthos																				

**Exhibit Table IXC. Morphology and Hydraulic Monitoring Summary**  
**Mill Branch Stream Restoration Site/EEP Project No. 0251**  
**Middle Reach**

Parameter	Cross Section 5				Cross Section 6															
Dimension	MY0	MY1	MY2	MY3	MY0	MY1	MY2	MY3												
BF Width (ft)	9.50	9.70	15.1	15.8	13.7	14.2	19	20.6												
Floodprone Width (ft) (approx)	88	93	79.5	61.9	77	75	31.5	28.5												
BF Cross Sectional Area (ft <sup>2</sup> )	5.20	5.10	4.8	4.0	15.5	16.6	14.8	11												
BF Mean Depth (ft)	0.60	0.50	0.3	0.3	1.1	1.2	0.8	0.5												
BF Max Depth (ft)	1.00	1.00	1.0	1.0	2.2	2.3	2.5	2.2												
Width/Depth Ratio	17.2	18.8	47.9	61.9	12.2	12.1	24.4	38.6												
Entrenchment Ratio	9.10	9.80	5.3	3.9	4.5	5.4	1.7	1.4												
Wetted Perimeter (ft)	-	-	15.4	16.1	-	-	21.1	22.5												
Hydraulic radius (ft)	-	-	0.3	0.3	-	-	0.7	0.5												
Substrate																				
d50 (mm)		0.09	0.062	.18		0.09	0.0622	.18												
d84 (mm)		0.20	0.2	.5		0.20	0.2	.5												
Parameter	MY-00 (2007)			MY-01 (2007)			MY-02 (2008)			MY-03 (2009)			MY-04 (2010)			MY-05 (2011)				
Pattern	Min	Max	Med	Min	Max	Med	Min	Max	Med	Min	Max	Med	Min	Max	Med	Min	Max	Med		
Channel Beltwidth (ft)	31	41	36	28	39	35	28	40	35	28	40	35								
Radius of Curvature (ft)	15	20	17	13	19	18	13	21	18	13	21	18								
Meander Wavelength (ft)	60	68	64	58	69	64	58	68	64	58	68	64								
Meander Width Ratio	8	4	6	-	-	7	-	-	7	-	-	7								
Profile																				
Riffle Length (ft)	7	17	13	-	-	-	-	-	-	-	-	-								
Riffle Slope (ft)	0.00	0.00	0.00	-	-	-	-	-	-	-	-	-								
Pool Length (ft)	10	23	18	-	-	-	-	-	-	-	-	-								
Pool Spacing (ft)	28	48	41	28	47	41	29	49	42	29	49	42								
Additional Reach Parameters																				
Valley Length (ft)	234			234																
Channel Length (ft)	299			299																
Sinosity	1.28			1.28																
Water Surface Slope (ft/ft)	0.0011			n/a																
BF Slope (ft/ft)	0.0011			0.0006																
Rosgen Classification	C5			C5																
*Habitat Index																				
*Macrofauna																				

Exhibit Table IXD. Morphology and Hydraulic Monitoring Summary Mill Branch Stream Restoration Site/EEP Project No. 0251 Lower Reach																
Parameter	Cross Section 7				Cross Section 8											
Dimension																
BF Width (ft)	10.8	11.8	18.3	10.3	17	16.9	11.2	15.4								
Floodprone Width (ft) (approx)	84	84	92.7	72.3	-	-	17.5	26.8								
BF Cross Sectional Area (ft <sup>2</sup> )	8.9	8.9	8.5	5.2	12.6	12.5	8.7	7								
BF Mean Depth (ft)	0.8	0.8	0.5	0.5	0.7	0.7	0.8	.5								
BF Max Depth (ft)	1.8	1.7	2.0	1.5	2.2	2.2	2.6	2.3								
Width/Depth Ratio	13.6	15.6	39.4	20.4	22.9	22.8	14.5	34								
Entrenchment Ratio	7.8	7.2	5.1	7	-	-	1.5	1.7								
Wetted Perimeter (ft)	-	-	19.4	10.9	-	-	15.3	17.3								
Hydraulic radius (ft)	-	-	0.4	0.5	-	-	0.6	.4								
Substrate																
d50 (mm)		0.10	0.067	.1		0.10	0.067	.1								
d84 (mm)		0.23	0.21	.25		0.23	0.21	.25								
Parameter	MY-00 (2007)			MY-01 (2007)			MY-02 (2008)			MY-03 (2009)			MY-04 (2010)			MY-05 (2011)
Pattern	Min	Max	Med	Min	Max	Med	Min	Max	Med	Min	Max	Med	Min	Max	Med	Min
Channel Beltwidth (ft)	37	37	37	35	39	38	35	38	37	35	38	37				
Radius of Curvature (ft)	17	24	20	17	24	20	17	23	19	18	23	19				
Meander Wavelength (ft)	77	86	82	75	85	82	75	85	82	75	85	82				
Meander Width Ratio	7.1	8.1	7.6	-	-	7	-	-	7	-	-	7				
Profile																
Riffle Length (ft)	4	11	8	-	-	-	-	-	-	-	-	-				
Riffle Slope (ft)	0.00	0.01	0.00	-	-	-	-	-	-	-	-	-				
Pool Length (ft)	28	53	41	-	-	-	-	-	-	-	-	-				
Pool Spacing (ft)	18	20	19	17	24	20	16	23	17	16	23	17				
Additional Reach Parameters																
Valley Length (ft)	201			201												
Channel Length (ft)	243			243												
Sinosity	1.21			1.21												
Water Surface Slope (ft/ft)	0.0036			-												
BF Slope (ft/ft)	0.0042			0.0042												
Rosgen Classification	C5			C5												
*Habitat Index																
*Macrobenthos																

**Appendix D – Stream Problem Area Photos (all photos recorder on 10/1/09)**



SPA 1 - Dry stream bed. Western Reach and Lower Reach



SPA 2 - Cattail – Throughout project site

**All pictures recorded on 10/1/09**



SPA 3 - Vegetation growing in the channel bed. Throughout the project site

## **Appendix D – Stream Problem Areas Inventory Table**

<b>Exhibit Table B.1 Stream Problem Areas Mill Branch Stream Restoration Site EEP Project No. 251</b>				
<b>Feature Issue</b>	<b>Reach</b>	<b>Station Number</b>	<b>Suspected Cause</b>	<b>Photo Number</b>
Aggradation	Western	10+00 to 13+50	N/A	*
	Upper	10+00 to 12+50	N/A	*
Cattails	All	Throughout	Dry Conditions	SPA 2
Vegetation Growth in channel bed	All	Throughout	Dry Conditions	SPA 3

*\*Pictures for aggradation areas were not taken due to vegetation growing in the channel and blocking the view*